

AS-BUILT PLAN - SHELTER ELECTRICAL SITE PLAN

NOT TO SCALE

PARTIAL BASEMENT FLOOR PLAN -
ADMIN./VISITORS CENTER
N.T.S.

NOTES:


- 1. RECONNECT EXISTING ELECTRICAL POWER SUPPLY.
- 2. REUSE EXISTING WRM METER AND ELECTRIC SERVICE FOR DEMOLISHED RED CROSS BUILDING FOR ELECTRICAL POWER SUPPLY TO NEW COMMUNITAL SHELTER.
- 3. ALL SITE WIRING & DEVICES TO BE INSTALLED ADJACENT TO ROADWAYS - OUTSIDE OF EXISTING APPROVED BURIAL AREAS.
- 4. ALL CROSSING OF ELECTRIC, COMMUNICATIONS AND GAS LINES UNDER EXISTING PAVED AREAS SHALL BE DIRECTIONAL BORED.
- 5. NEW GAS LINE SHALL BE DIRECTIONAL BORED UNDER ALL EXISTING PAVEMENT.
- 6. EXISTING UTILITY POLE WITH POLE MOUNTED TRANSFORMER FOR EXISTING ELECTRICAL SERVICE TO EXISTING RED CROSS BUILDING.
- 7. EXISTING UNDERGROUND ELECTRICAL SERVICE TO DEMOLISHED RED CROSS BUILDING, RE-USE FOR NEW SHELTER #5. COORDINATE WITH LOCAL UTILITY COMPANY. SEE DRAWING E-8 FOR CONTRADICTIONS.
- 8. EXISTING UNDERGROUND PRIMARY ELECTRICAL SERVICE TO REMAIN AS PRESENTLY INSTALLED AND REUSE.
- 9. ALTERNATE E-2: REMOVE EXISTING UTILITY POLE AND TRANSFORMER. REPLACE WITH NEW PAD AND PAD MOUNTED TRANSFORMER. RE-USE EXISTING UNDERGROUND 120/240V-1Ø FEEDER AND EXISTING UNDERGROUND PRIMARY FEEDER. COORDINATE ALL DEMOLITION AND NEW INSTALLATION WITH LOCAL UTILITY COMPANY.
- 10. GAS LINE FROM METER INTO BUILDINGS SHALL BE BY MECHANICAL CONTRACTOR.
- 11. REMOVE EXISTING OIL TANK AND ALL ASSOCIATED PIPING. VERIFY EXACT LOCATION OF TANK IN FIELD. REMOVAL AND DISPOSAL MUST BE IN ACCORDANCE WITH ALL MISSOURI AND FEDERAL TANK REMOVAL REGULATIONS.

CONTRACTOR TO COORDINATE AND SCHEDULE THE INSTALLATION OF NEW GAS MAINS WITH THE LOCAL GAS COMPANY (LACLES) AS NECESSARY TO MEET CONSTRUCTION SCHEDULE.

VERIFY ALL DIMENSIONS AND EXISTING JOB CONDITIONS, AND REPORT TO THE ENGINEER ANY DISCREPANCIES AND/OR OMISSIONS WHICH WOULD INTERFERE WITH THE SATISFACTORY INSTALLATION OF WORK BEFORE SUBMISSION OF BIDS AND DURING CONSTRUCTION PERIOD.




Revision	Date

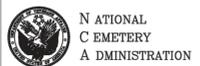

Drawing Title	SITE PLAN
Approved: Director, Technical Support Service	JJR
Approved: Chief, Architect & Engineering Division	BAH

Project Title	JEFFERSON BARRACKS NATIONAL CEMETERY ST. LOUIS, MISSOURI
Date	06/13/02
Project No.	882-026
Drawn By	JJR
Checked By	BAH
Drawn No.	EHP-3
Checked No.	148 of 181

Revisions	Date

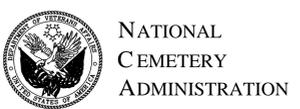

FINAL FOR CONSTRUCTION

Drawing Title	AS-BUILT PLAN - SHELTER ELECTRICAL SITE PLAN	Project Title	REPAIR ELECTRICAL SERVICE TO SHELTERS 2, 3 & 5	Date	10/18/2016
Approved: Division Chief	JJR	Building Number		Project No.	852-17-103
Approved: Service Director		Checked	RNE	Drawn	RNE
		Location	JEFFERSON BARRACKS NATIONAL CEMETERY	Drawing No.	L-1
				Dwg.	1 Of 3