


three inches = one foot
 one and one-half inches = one foot
 one inch = one foot
 three-quarters inch = one foot
 one-half inch = one foot
 three-eighths inch = one foot
 one-quarter inch = one foot
 one-eighth inch = one foot

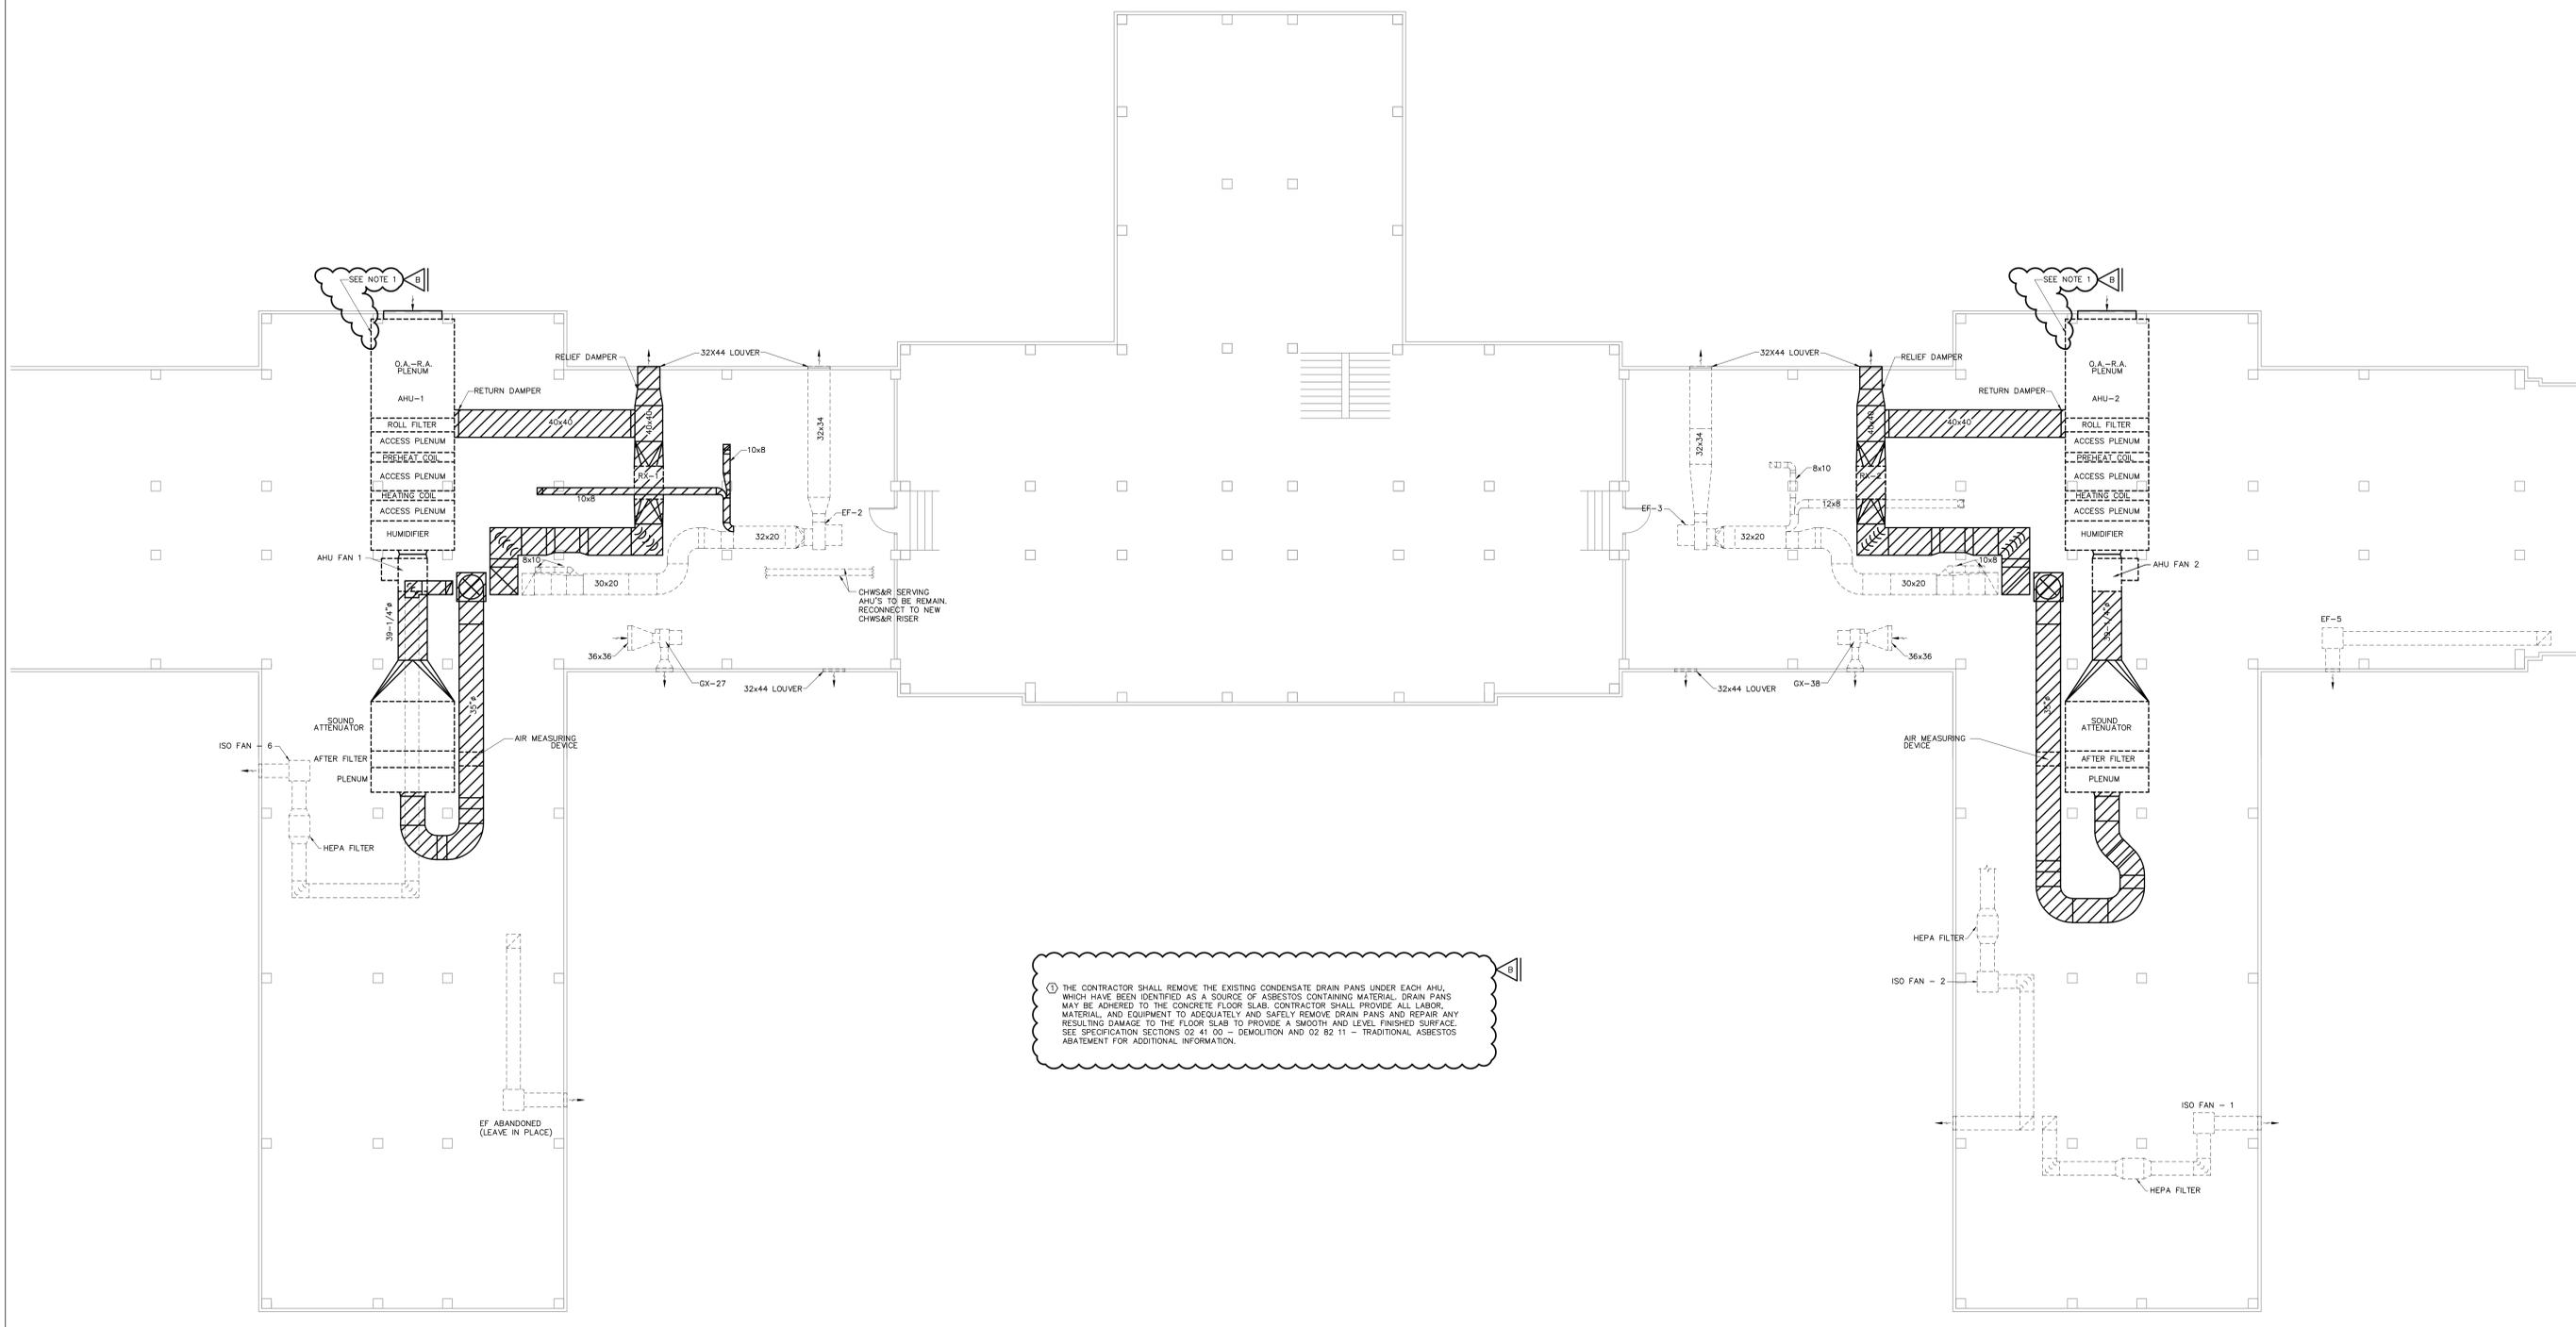

① THE CONTRACTOR SHALL REMOVE THE EXISTING CONDENSATE DRAIN PANS UNDER EACH AHU, WHICH HAVE BEEN IDENTIFIED AS A SOURCE OF ASBESTOS CONTAINING MATERIAL. DRAIN PANS MAY BE ADHERED TO THE CONCRETE FLOOR SLAB. CONTRACTOR SHALL PROVIDE ALL LABOR, MATERIAL, AND EQUIPMENT TO ADEQUATELY AND SAFELY REMOVE DRAIN PANS AND REPAIR ANY RESULTING DAMAGE TO THE FLOOR SLAB TO PROVIDE A SMOOTH AND LEVEL FINISHED SURFACE. SEE SPECIFICATION SECTIONS 02 41 00 - DEMOLITION AND 02 82 11 - TRADITIONAL ASBESTOS ABATEMENT FOR ADDITIONAL INFORMATION.

ATTIC FLOOR PLAN
 MECHANICAL - DEMOLITION
 0 2 4 6 8 16
 GRAPHIC SCALE (FEET)



CONSTRUCTION DOCUMENTS

REVISION B - ADDENDUM NO. 2 - 4/23/12
 REVISION A - ADDENDUM NO. 1 - 3/21/12

Revisions	Date
-----------	------

Tennessee Valley Healthcare System

MURFREESBORO CAMPUS

Approved: --	Drawing Title DEMOLITION FLOOR PLAN		Project Title REPLACE ATTIC AHU'S BUILDING 1		Date 01/20/2012
	Approved: Facility Manager		Building Number 1	Checked TCT	Drawn SNP
Approved: --	Approved: Director		Location TVHS - YORK CAMPUS		Project No. 626A4-11-203
					Drawn SNP
			DRAWING NO. 1-M2		FILE NAME 11026M01

Veterans Administration