


AHU - 1 RISER  
MECHANICAL - NEW WORK  
0 1 2 3 4 8  
GRAPHIC SCALE (FEET)

DRAWING NOTES:


1. INSTALL NEW CHILLED WATER SUPPLY AND RETURN PIPING AND INSULATE. REPAIR EXISTING RETURN PIPING AND INSULATE. REPAIR EXISTING CONDENSATE RETURN PIPING PER SPECIFICATION SECTION 23 07 11.

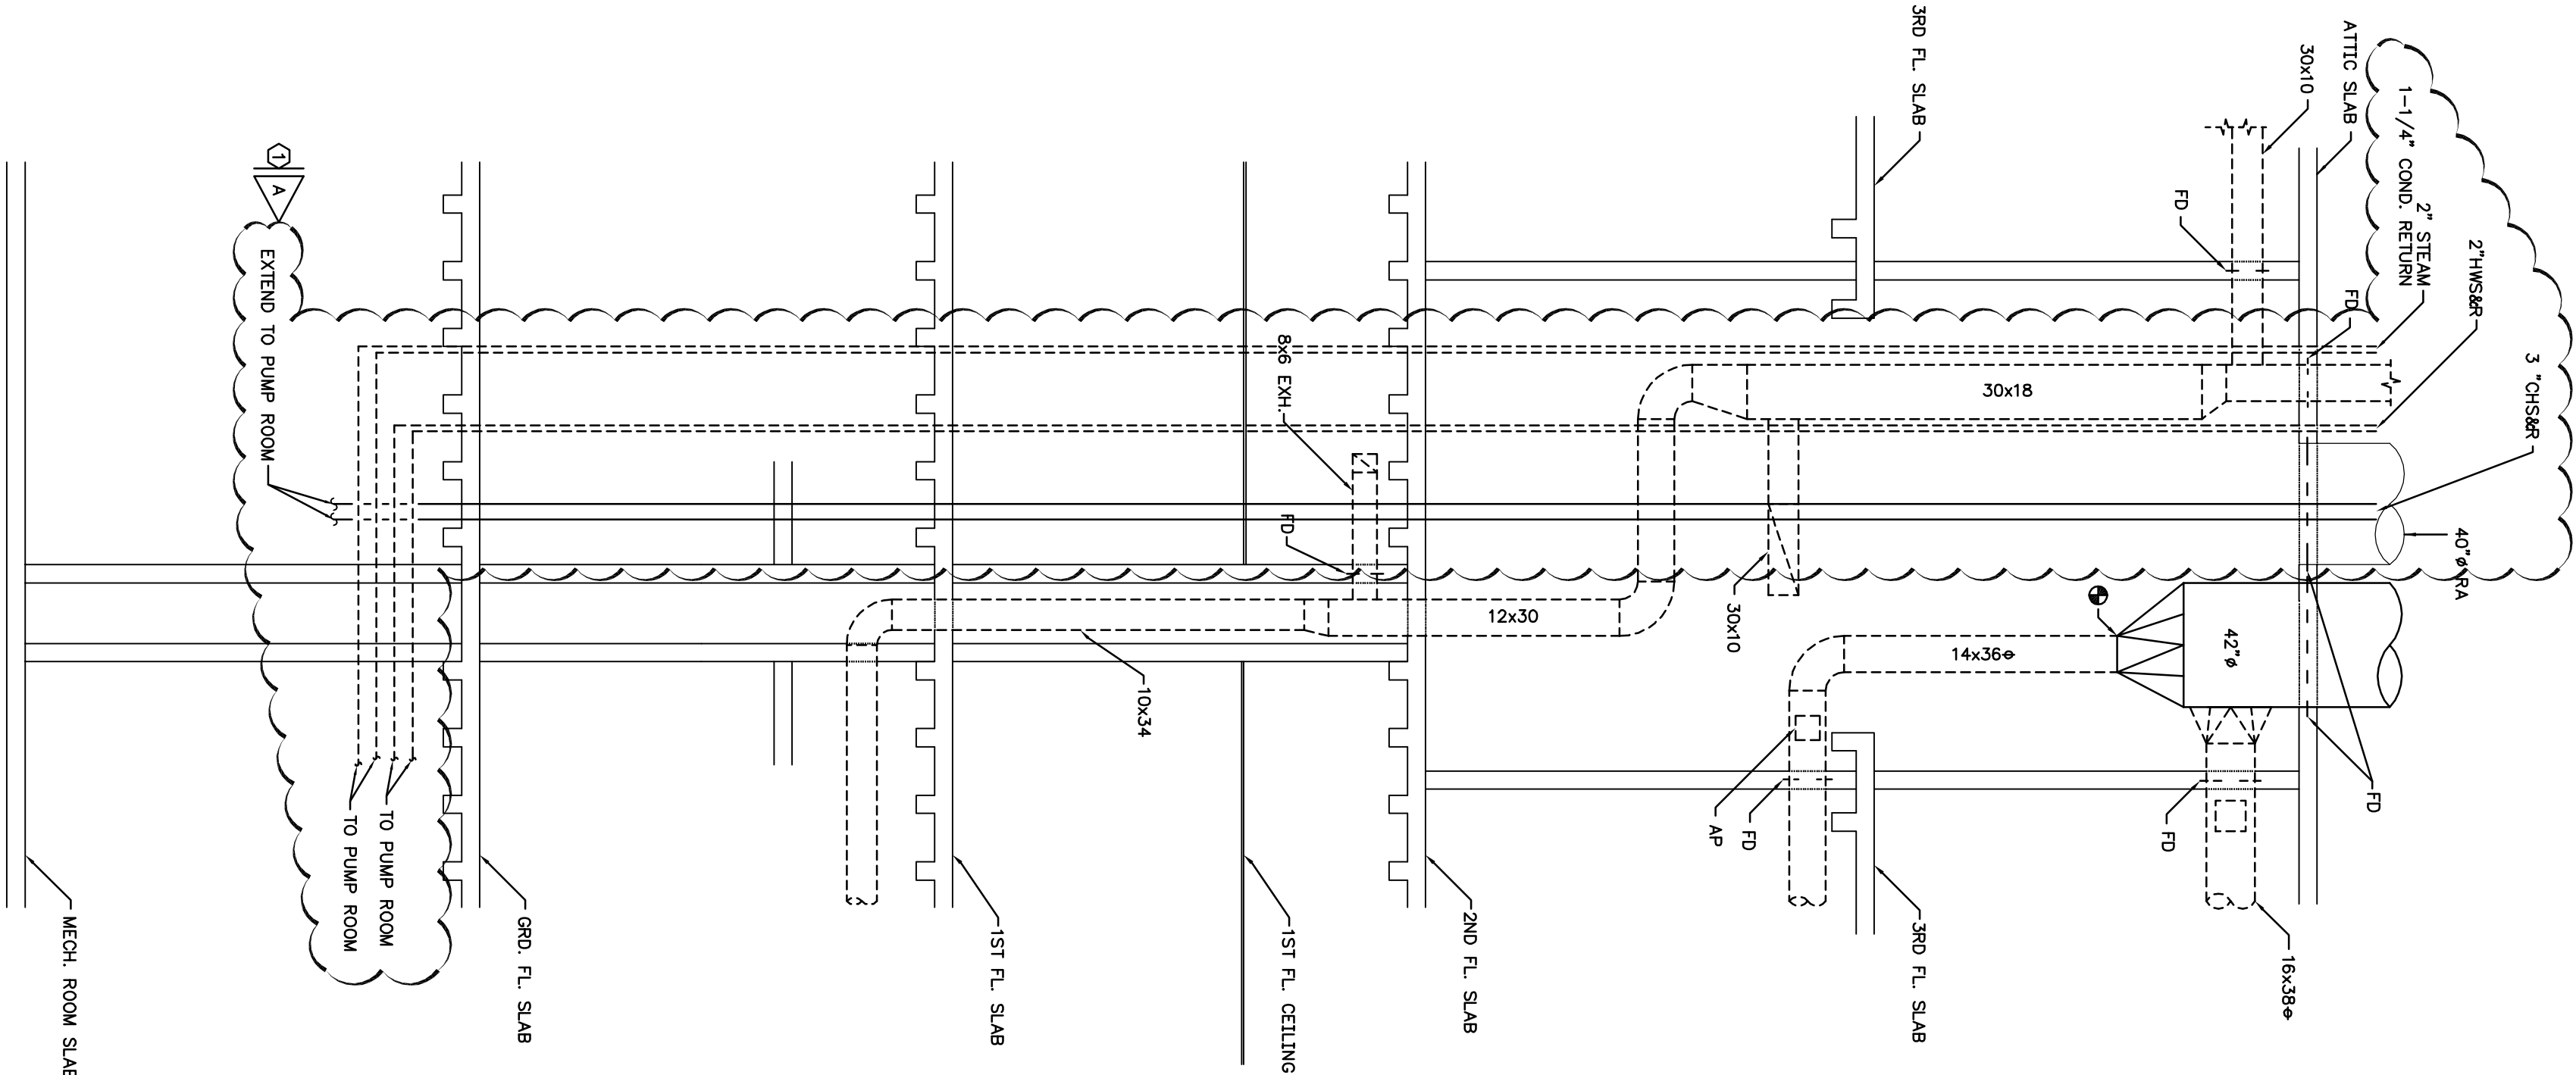


AHU - 2 RISER  
MECHANICAL - NEW WORK  
0 1 2 3 4 8  
GRAPHIC SCALE (FEET)

REVISION A - ADDENDUM NO. 2 - 4/23/12

Revisions	Date

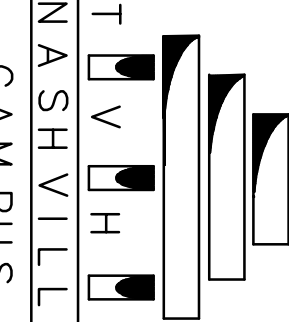

Tennessee Valley Healthcare System  
NASHVILLE  
CAMPU S

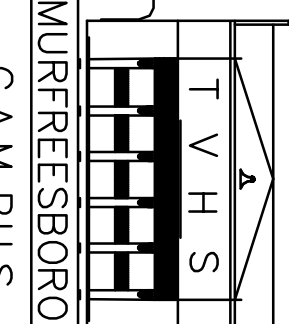

CAMPU S

Tennessee Valley Healthcare System

Approved: --	Drawing Title MECHANICAL RISER NEW WORK	Project Title REPLACE ATTIC AHUS BUILDING 1	Date 01/20/2012
Approved: --	Approved: Facility Manager	Building Number 1	Project No. 625A4-11-203
Approved: --	Approved: Director	Checked TCI	Drawing No. 1-M 8
		Drawn SP	FILE NAME M25A02
		Location TWIS - YORK CAMPUS	

Veterans Administration

CONSTRUCTION DOCUMENTS

