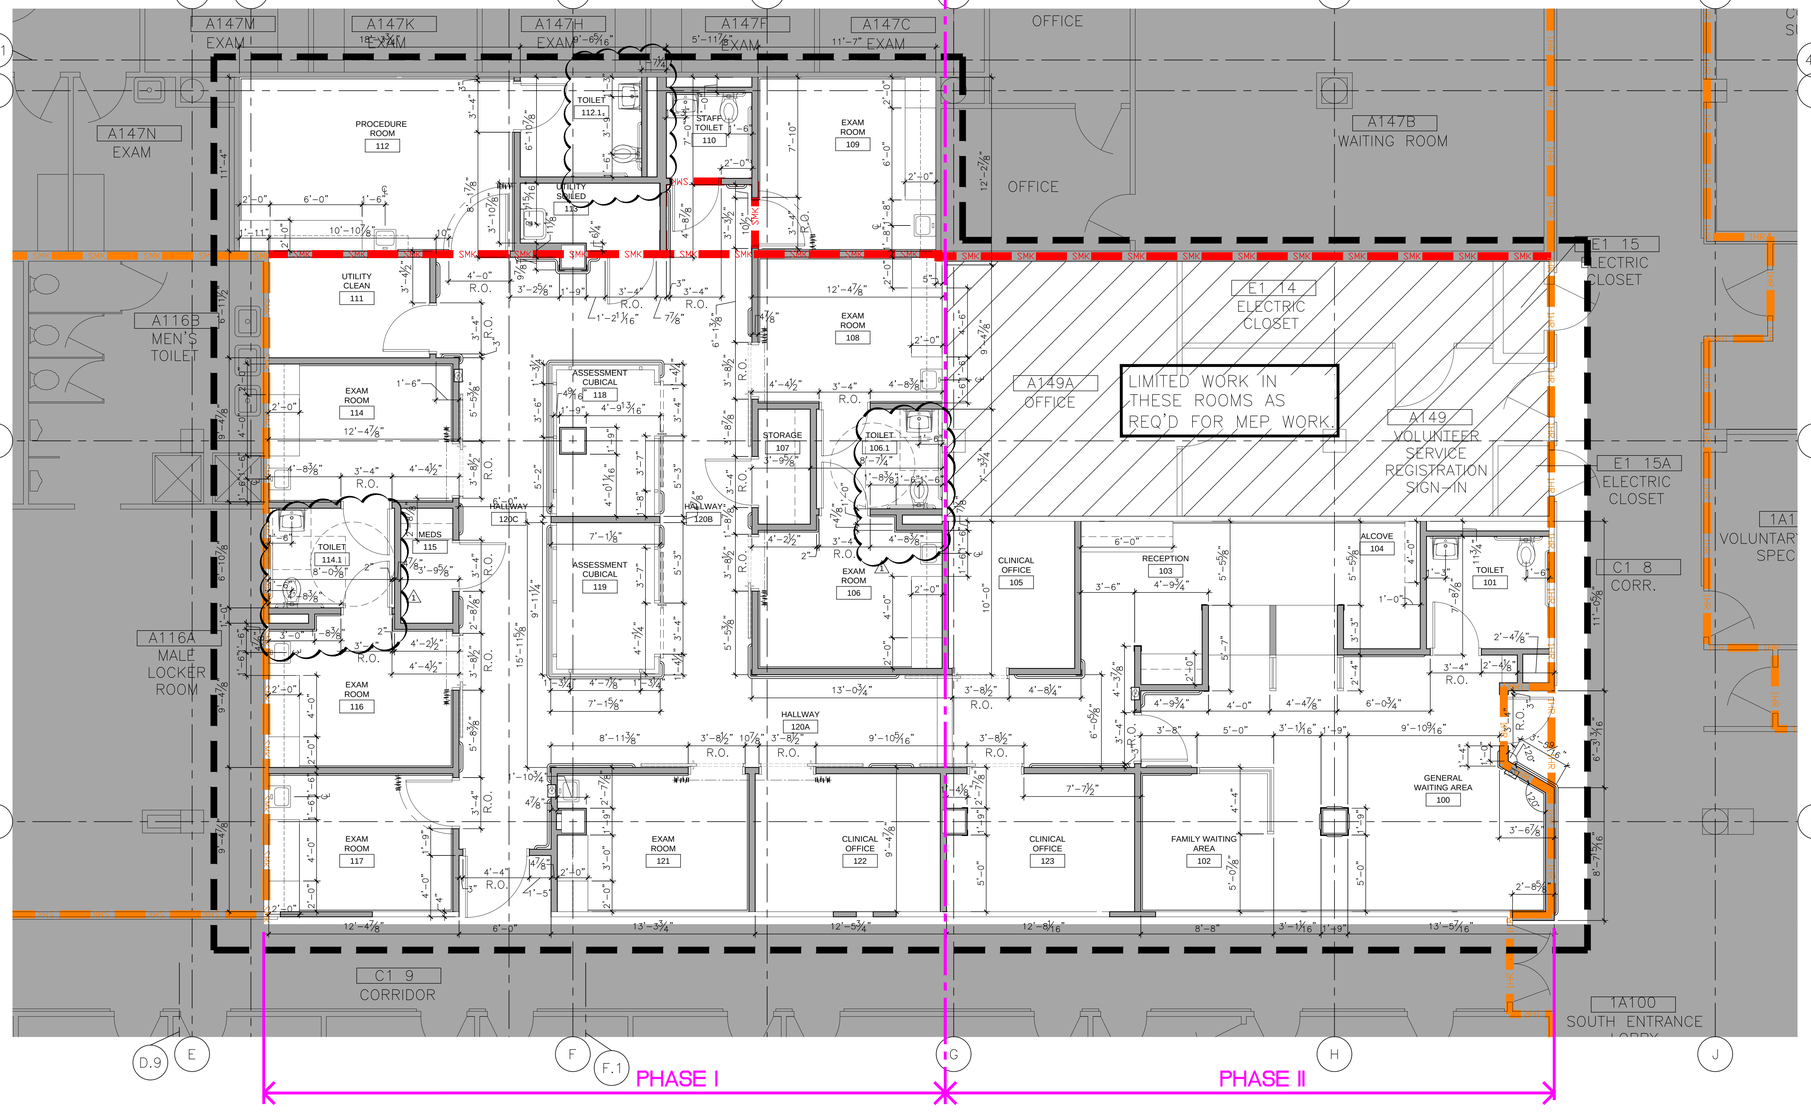

1 A-102 PARTIAL FIRST FLOOR PLAN - RENOV. - DIMENSIONED

1/4" = 1'-0"

REFERENCED

PLAN LEGEND

- AREA OF RENOVATION
- NO WORK IN THIS AREA
- LIMITED WORK IN THESE ROOMS AS REQUIRED FOR MEP WORK. REFER TO MEP DRAWINGS.
- EXISTING WALL TO REMAIN.
- EXISTING DOOR, FRAME, AND HARDWARE TO REMAIN.
- NEW WALL CONSTRUCTION
- NEW DOOR, FRAME, AND HARDWARE
- EXISTING WALL SHALL BE REMOVED.
- EXISTING DOOR, FRAME, AND HARDWARE SHALL BE REMOVED.
- TEMPORARY DUST PROOF WALL AND DOOR.
- SMK — 30-MIN. RATED SMOKE BARRIER
- 2HR — 2-HOUR. RATED WALL CONSTRUCTION

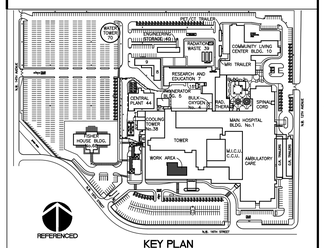

REFERENCED

KEY PLAN N.T.S.

FINAL SUBMITTAL

CHANGES FOR AMENDMENT	2/07/2017
-	-
-	-
-	-
-	-
-	-
-	-
-	-
-	-
Revisions:	Date

CONSULTANTS:

STATE OF FLORIDA — J. PAUL STROLLO — NO.5105 — REGISTERED ARCHITECT — 2/7/17

ARCHITECT/ENGINEERS:

DEANE + STROLLO, LLC
718 Virginia Drive
Orlando, FL. 32803
T: (407) 423-5355 F: (407) 422-5994

ENGLEY - BROOKS ENGINEERING
1324 E. 24th Street - Sanford, FL. 32771
T: (407) 808-8344 F: (407) 540-9403

Drawing Title: PARTIAL FIRST FLOOR PLAN - RENOVATION - DIMENSIONED

Approved: Project Director

Project Title: REPURPOSE EXISTING SPACE TO EXPAND WOMEN'S CLINIC FIRST FLOOR BLDG 1

Location: 1201 NW 16th ST, MIAMI, FL.

Project Number: 546-15-105

Building Number: 1

Drawing Number: A-102

Dwg. 8 of -

Date: JUNE 28, 2016 | Checked: JS, KS | Drawn: GC, YS

Office of Construction and Facilities Management

Department of Veterans Affairs

VA FORM 08-6231