



**B4 MED INTENSIVE CARE UNIT ABATEMENT**  
1/4" = 1'-0"

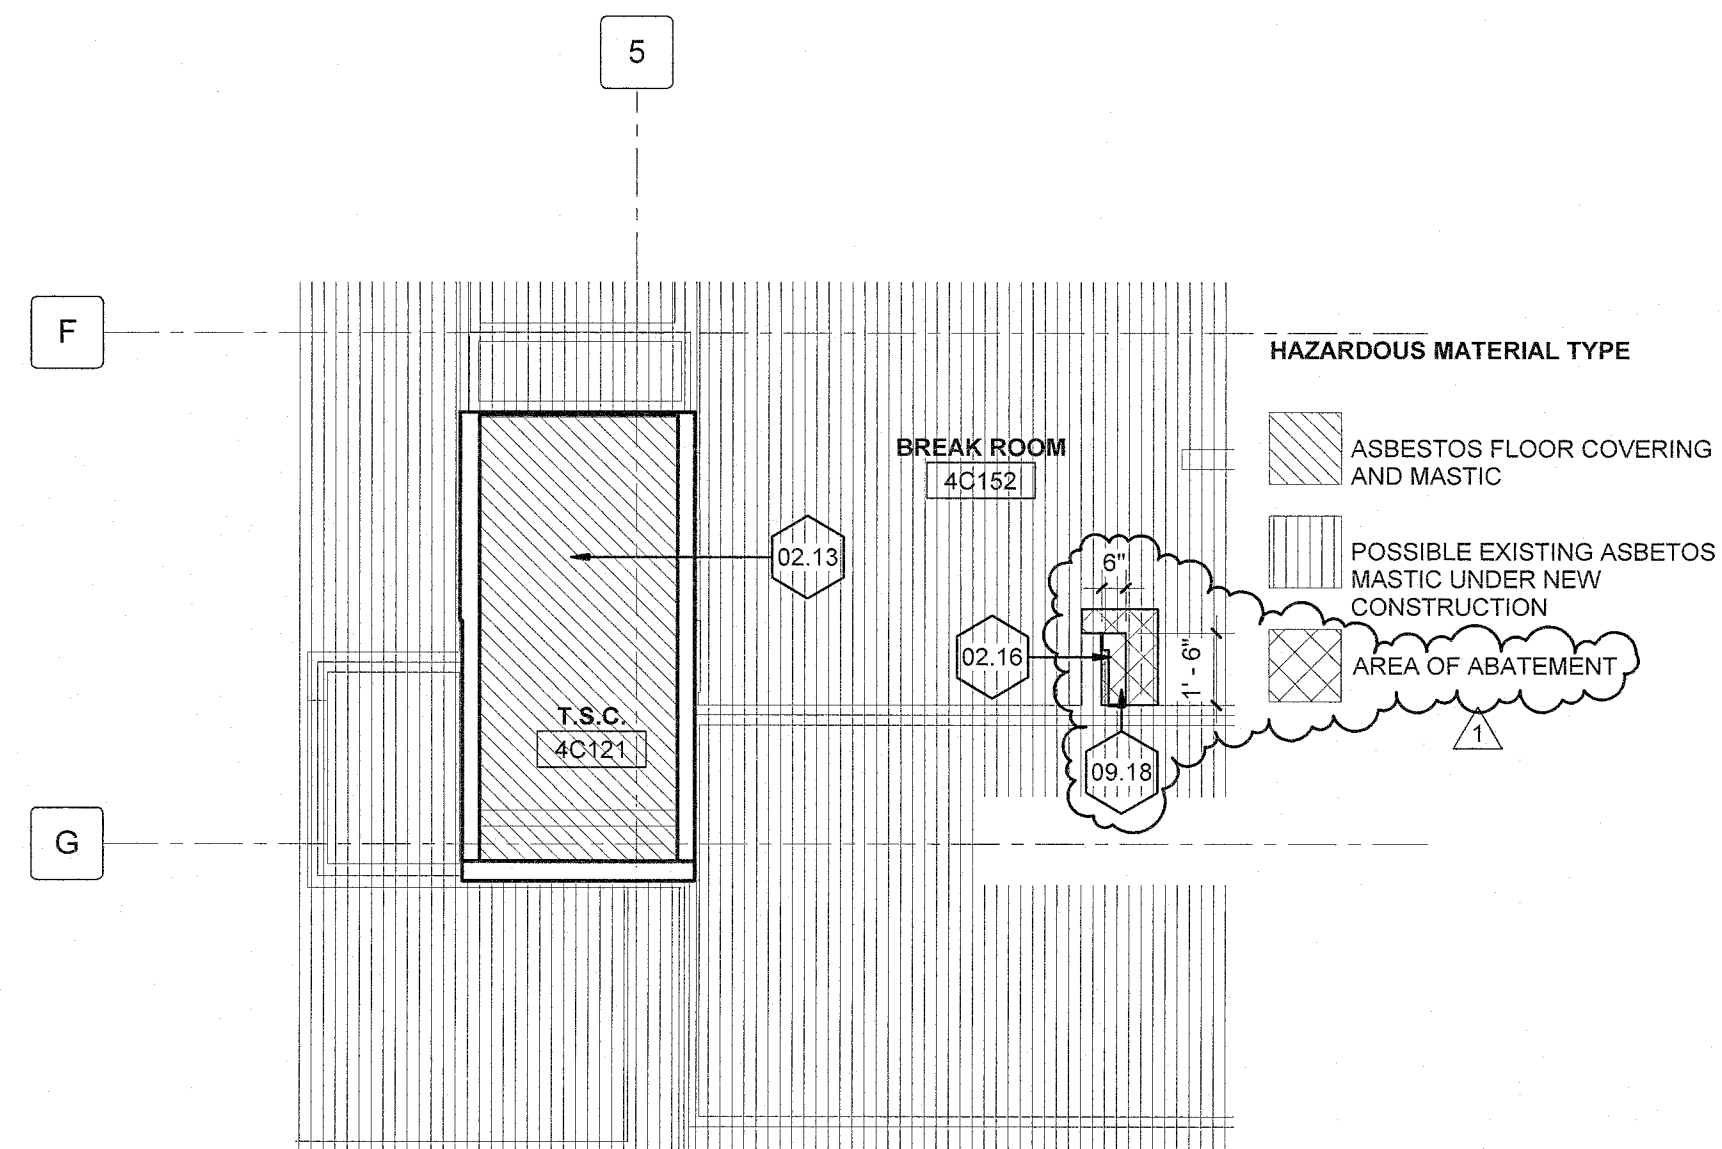

**C4 BREAK ROOM 4C152 ABATEMENT**  
1/4" = 1'-0"

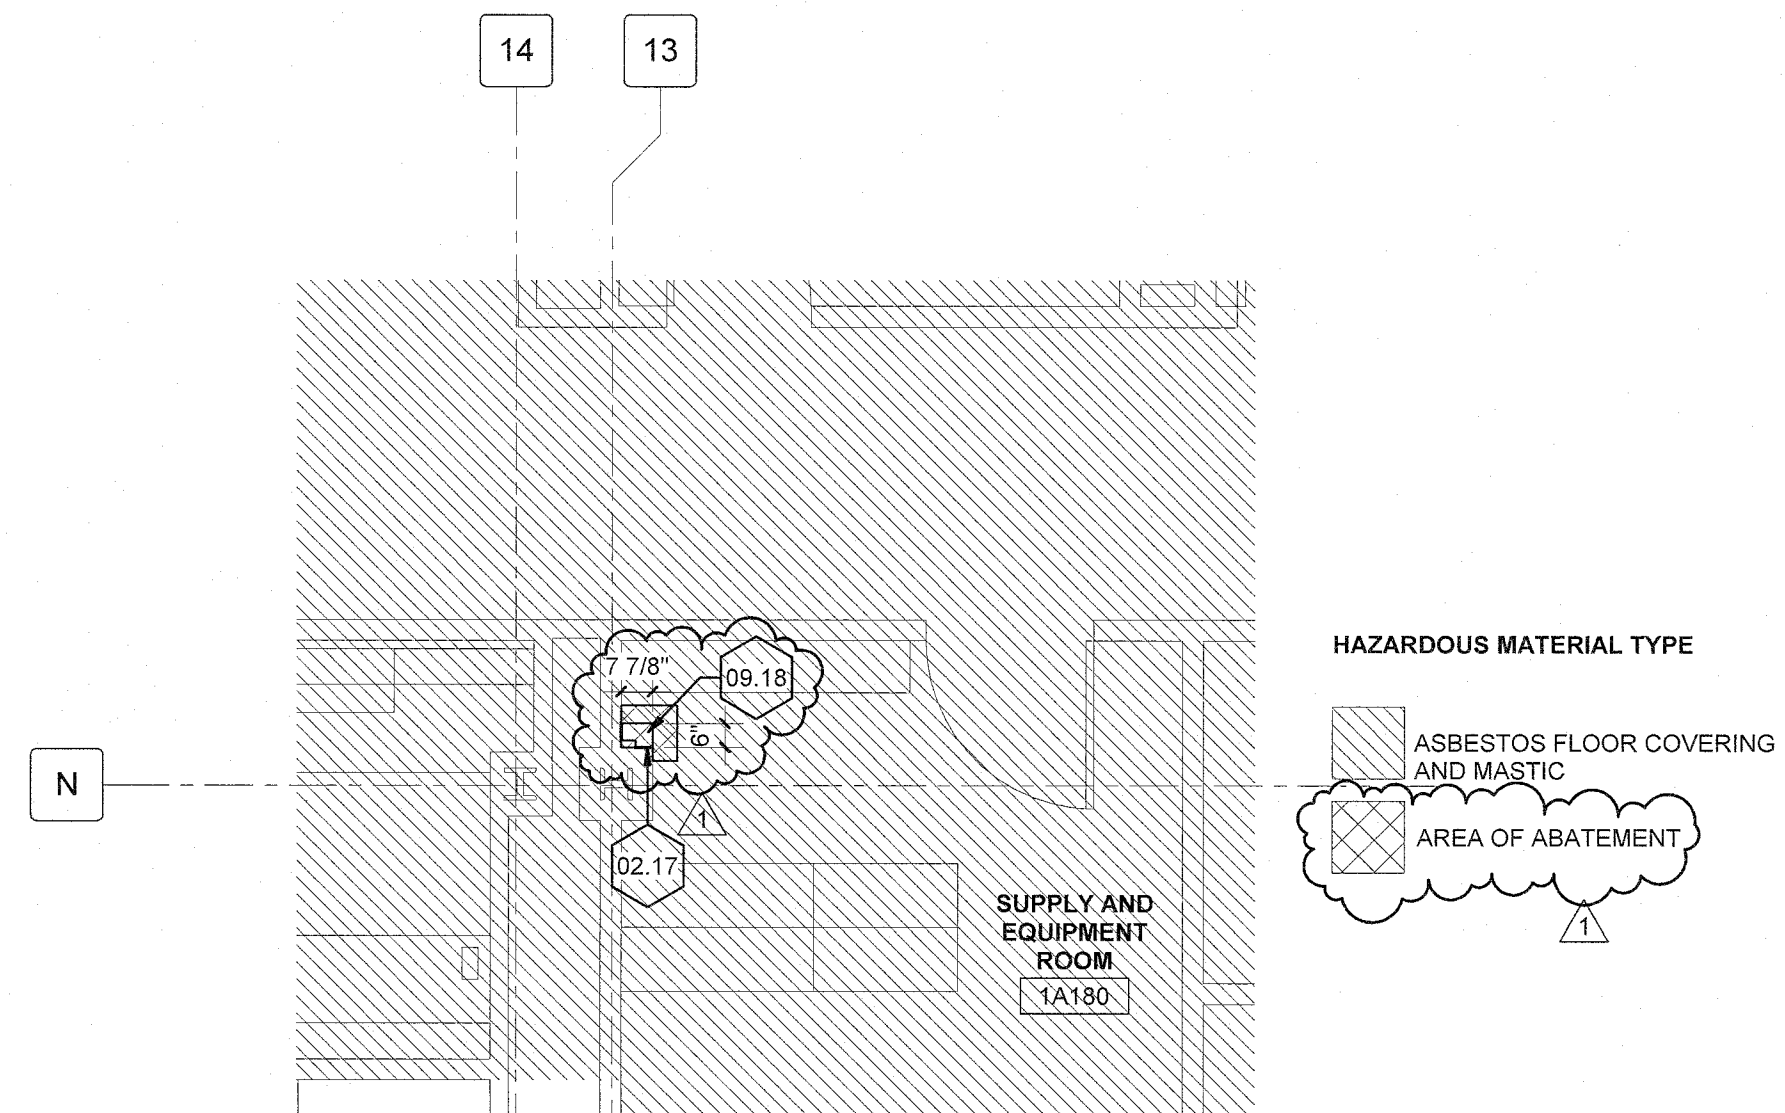


**D4 1A180 SUPPLY AND EQUIPMENT ROOM ABATEMENT**  
1/4" = 1'-0"

**SHEET KEYNOTES**

- 02.13 DUCTS TO BE DEMOLISHED IN THIS ROOM CONTAIN ASBESTOS  
02.16 ABATE ASBESTOS CONTAINING MASTIC UNDER NEW FLOORING IN DIMENSIONED AREA FOR NEW CHASE AS WELL AS MASTIC UNDER ADJACENT PARTIAL AND ONE ADDITIONAL FULL FLOOR TILE OF THE SURROUNDING AREA. REPLACE FLOORING PER NEW CHASE DETAIL C2/G1002.  
02.17 ABATE ASBESTOS CONTAINING FLOOR COVERING AND MASTIC IN DIMENSIONED AREA FOR NEW CHASE AS WELL AS MASTIC UNDER ADJACENT PARTIAL AND ONE ADDITIONAL FULL FLOOR TILE OF THE SURROUNDING AREA. REPLACE FLOORING PER NEW CHASE DETAIL C2/G1002.  
09.18 NEW REFRIGERANT PIPE CHASE. FORM WITH PARTITION TYPE A3. PAINT CHASE AND ADJACENT WALLS TO MATCH EXISTING.


**WALL RATINGS**

- ■ ■ FIRE WALL - 1 HR  
■ ■ ■ FIRE WALL - 2 HR  
■ ■ ■ 1 HR SMOKE/FIRE WALL  
■ ■ ■ 2 HR SMOKE/FIRE WALL  
★ ★ ★ ★ ★ HAZARDOUS

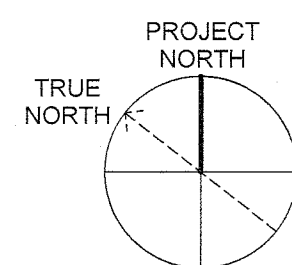

Revisions:		
No.	Description	Date
1	AMMENDMENT 000	1/23/17

**VA** U.S. Department of Veterans Affairs  
**WILLIAM JENNINGS BRYAN DORN VA MEDICAL CENTER**  
6439 GARNERS FERRY ROAD, COLUMBIA, SC 29209

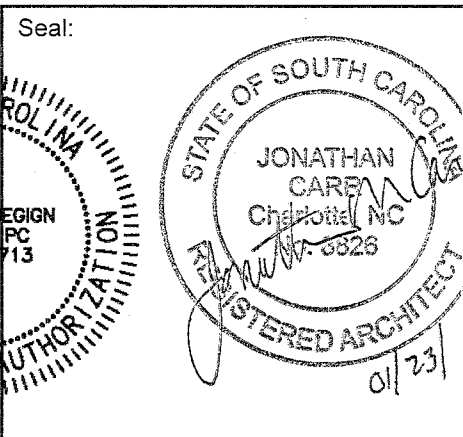

Architect / Engineer Address:  
**HARRELL** DESIGN GROUP, P.C.  
formerly HARRELL, SALTRICK & HOPPER, P.C.  
8018 TOWER POINT DRIVE CHARLOTTE, NC 28227 P 704.814.1320 F 704.321.0933  
HDG PROJECT: 13028

Recommended Approvals:	
1.	6.
2.	7.
3.	8.
4.	9.
5.	10.

Drawing Title:  
**ENLARGED ABATEMENT VIEWS**

Project Phase:  
**100% CONSTRUCTION DOCUMENTS**

**FULLY SPRINKLERED**

Project Title:  
**UPGRADE INFORMATION MANAGEMENT CLOSETS FOR SECURITY**

Drawn: TMC  
Checked:

Building Number: 100  
Reviewed:

File Name:  
Const. Contract No.:

Date:  
**MARCH 25, 2016**

Project Number:  
**544-14-101**

Drawing No.:  
**HA401**  
SHEET \_\_\_\_ OF 88

