

KEYED NOTES

1

REMOVE EXISTING PUMPS AS SHOWN DASHED. COORDINATE POWER DISCONNECTION WITH ELECTRICAL CONTRACTOR. TURN OVER TO OWNER.

2

BALANCE EXISTING SNOW MELT LOOP TO FLOW NOTED ON SCHEDULE.

3

FIELD VERIFY FINAL MANIFOLD LOCATION WITH LANDSCAPING PLAN.

4


REMOVE EXISTING HX AS SHOWN DASHED. NEW HX TO BE MOUNTED IN SAME LOCATION. SEE 2/M101 FOR NEW PLAN. TURN OVER TO OWNER.

5


REMOVE EXISTING TEKMAR 665 SINGLE ZONE CONTROLLER AND TURN OVER TO OWNER. REPLACE WITH NEW TEKMAR 664 TWO ZONE CONTROLLER.

6

REMOVE AND RELOCATE EXISTING CONTROL VALVE AS SHOWN DASHED.

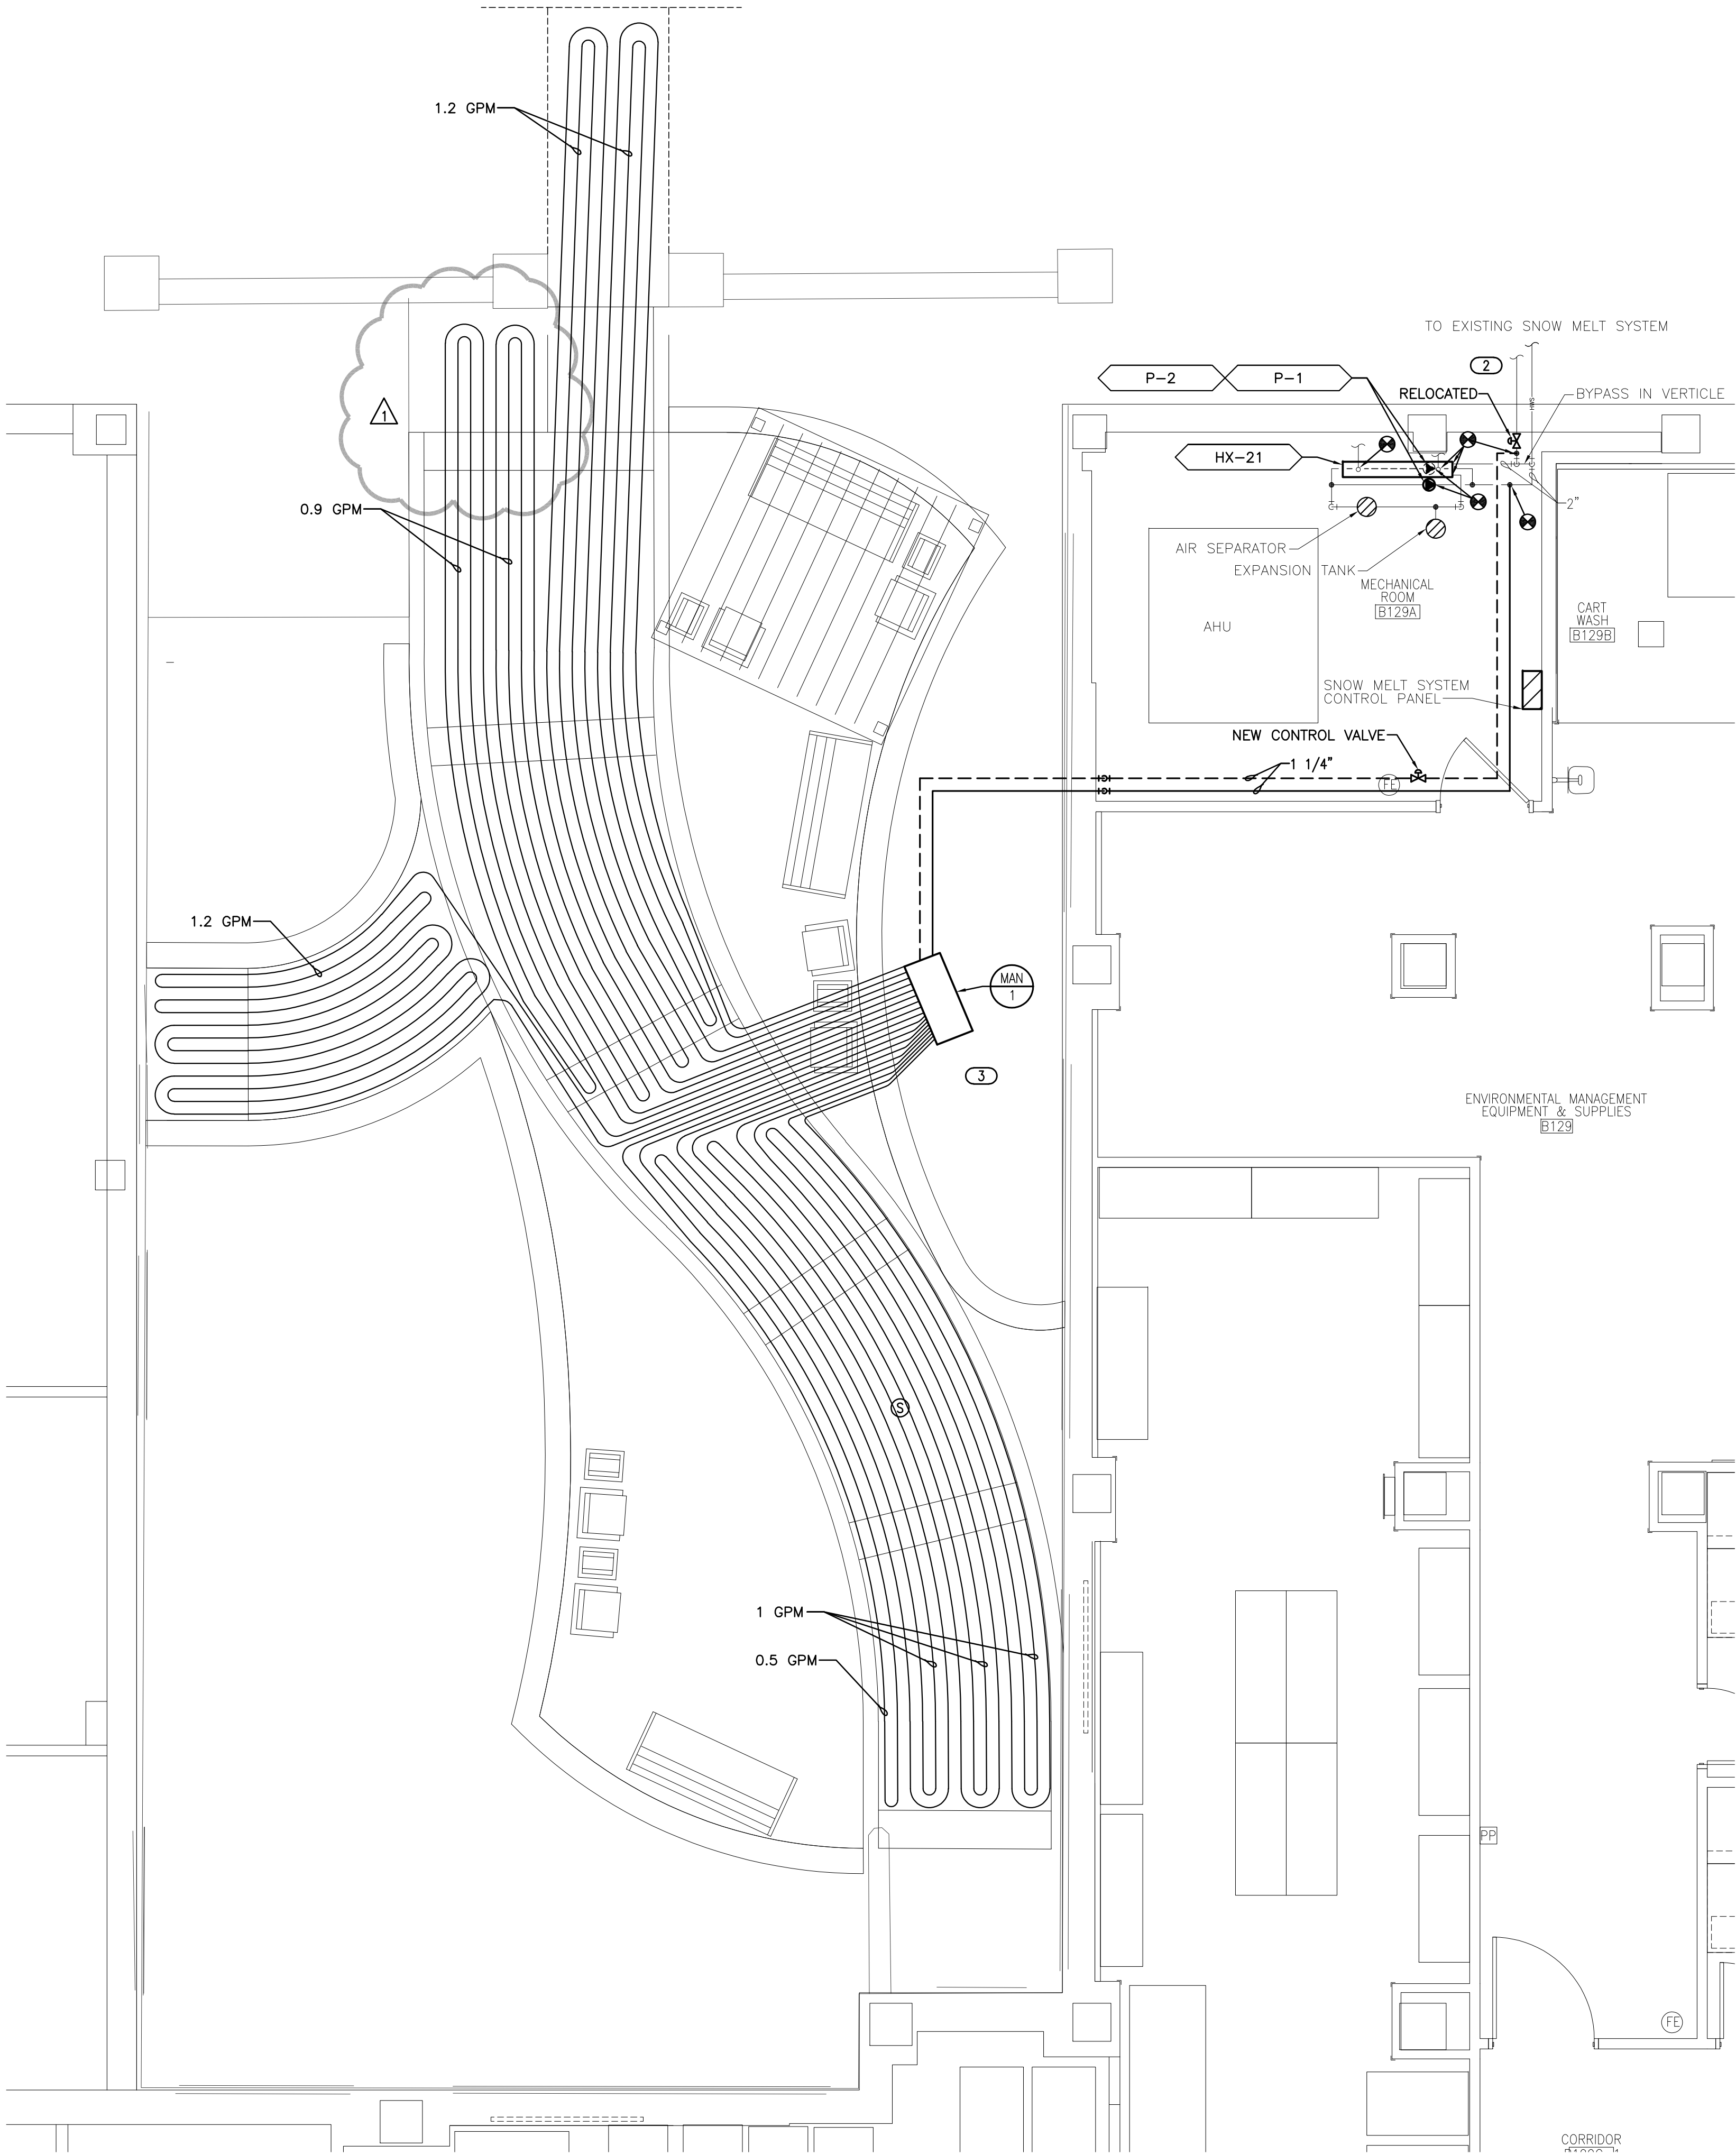

2 MECHANICAL PLAN

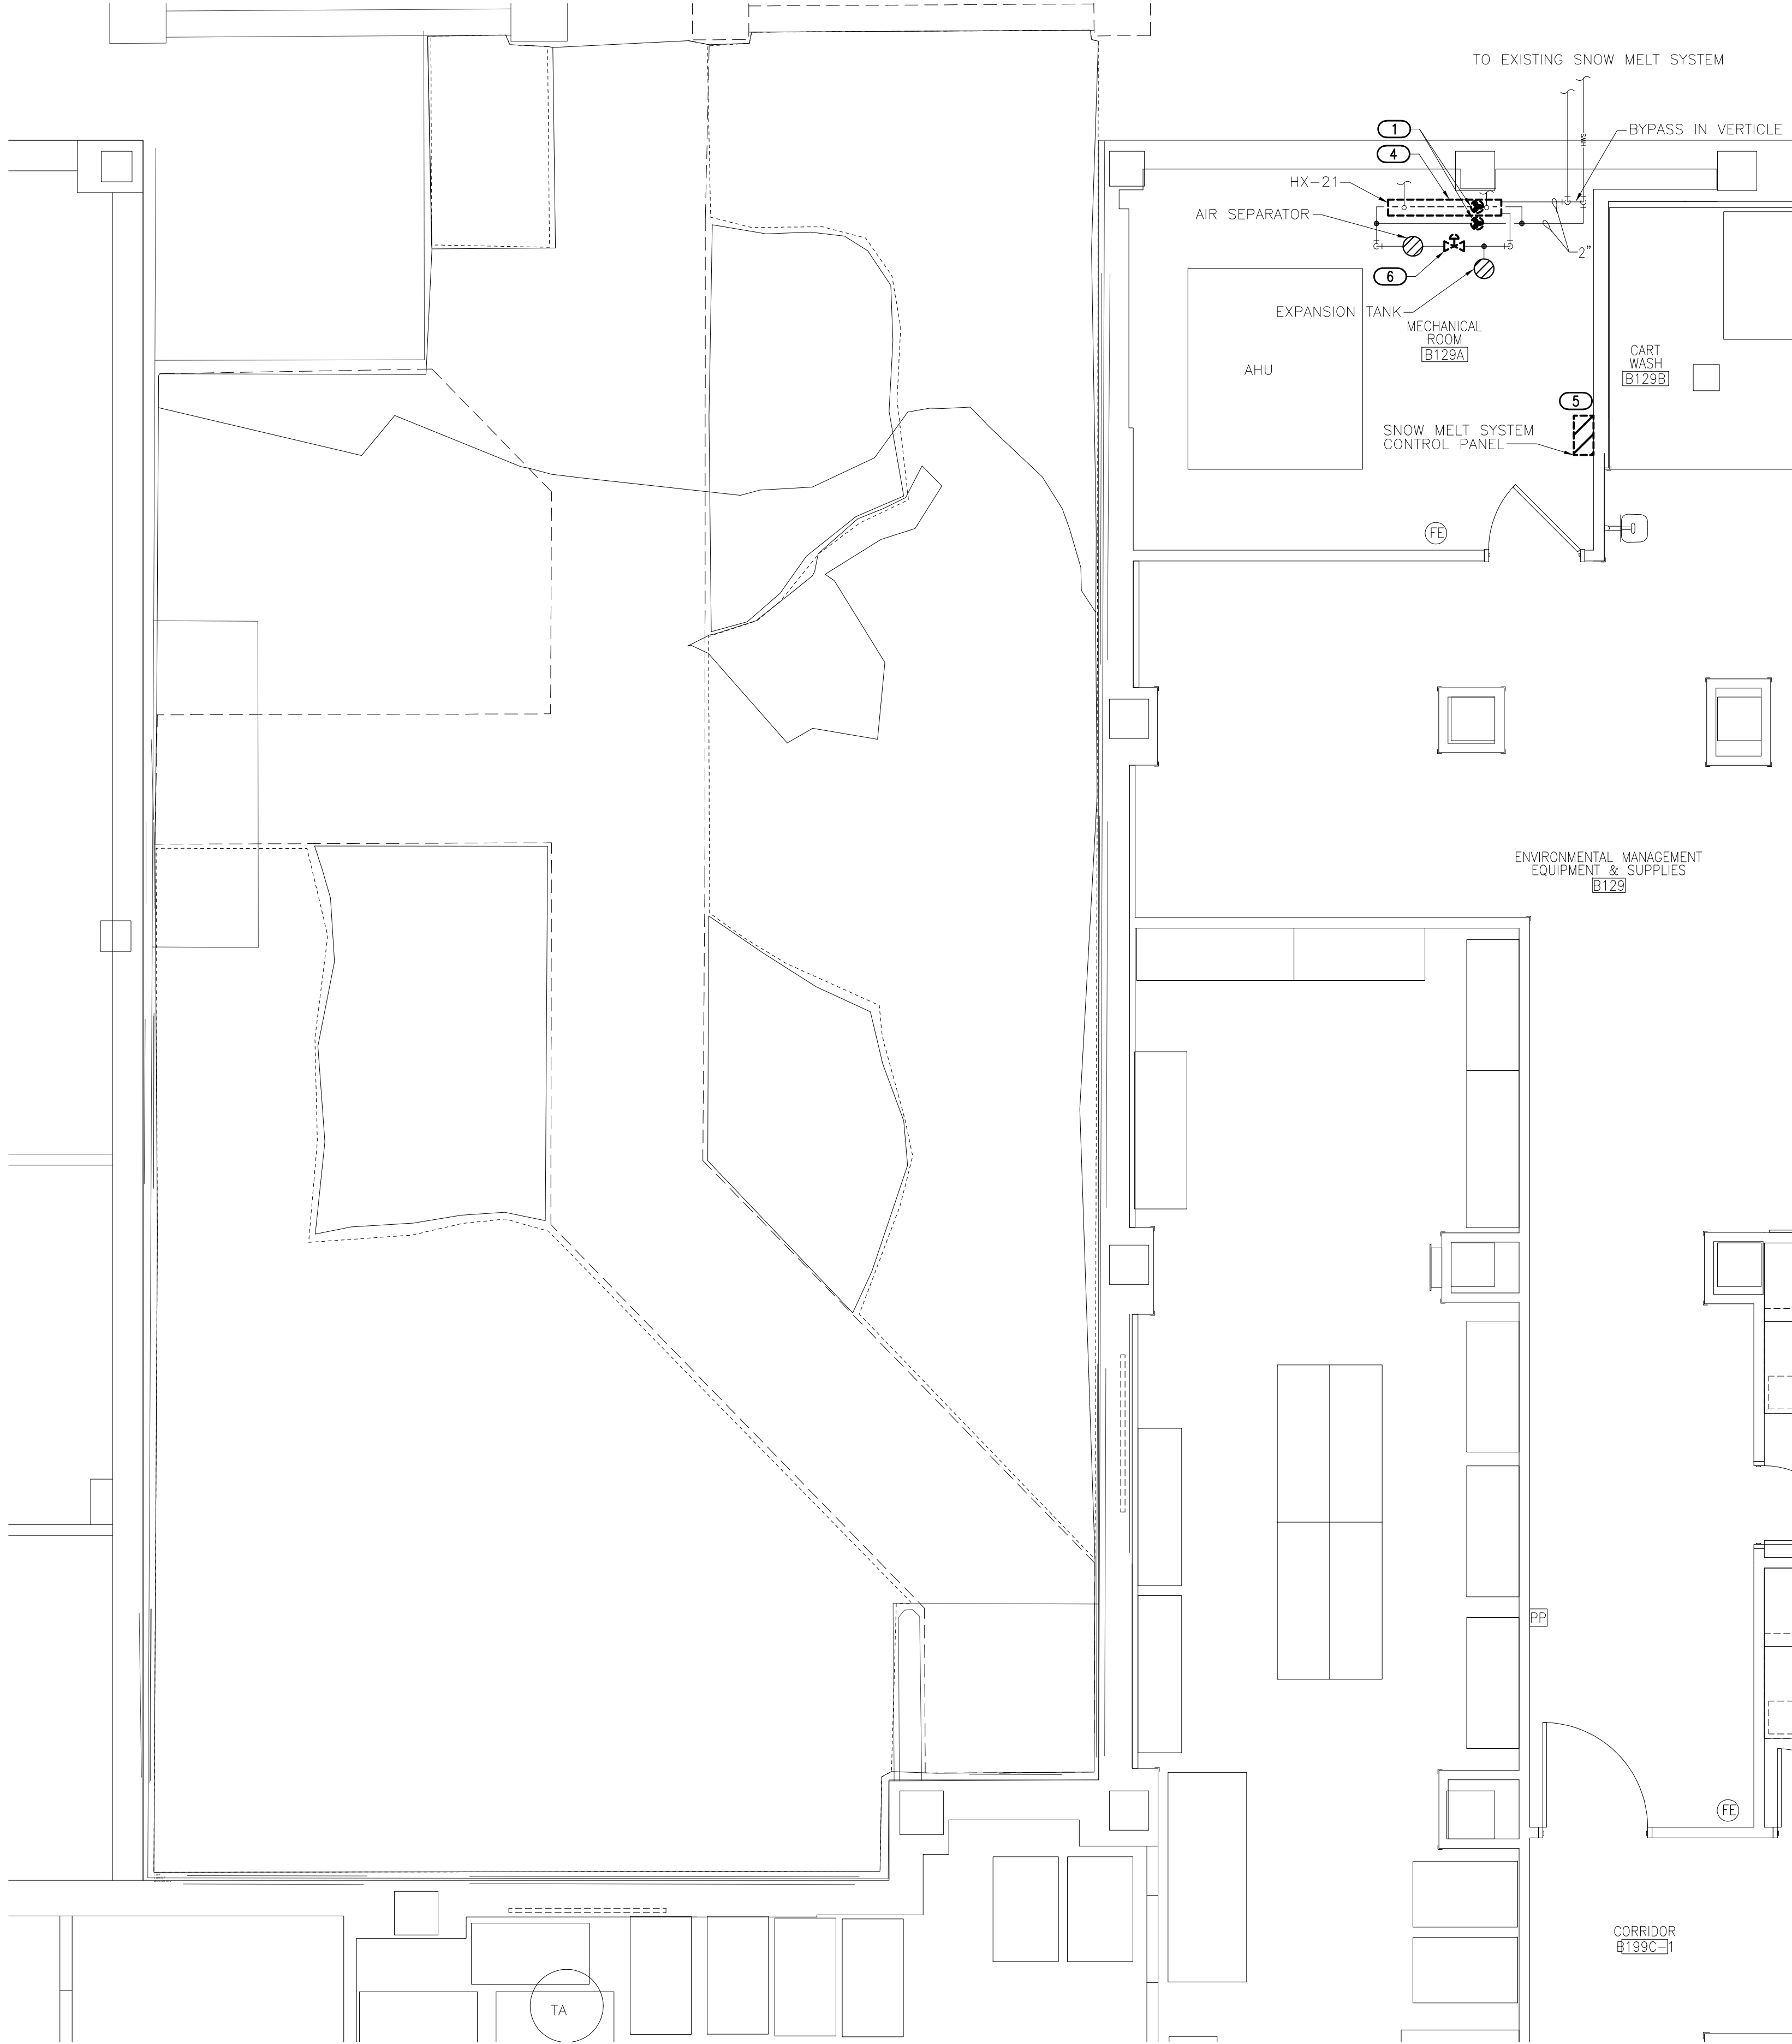

1 BASEMENT DEMOLITION PLAN

		CONSULTANTS:		ARCHITECT/ENGINEERS:		Drawing Title MECHANICAL PLANS	Project Title REPAIR CLC COURTYARD	Project Number 585-16-105	Office of Construction and Facilities Management	
						Approved: Project Director	Location IRON MOUNTAIN, MICHIGAN	Building Number 1		
							Date JANUARY 7, 2017	Checked KSP	Drawn AMD	Drawing Number M101 Dwg. 14 of 19
									Department of Veterans Affairs	