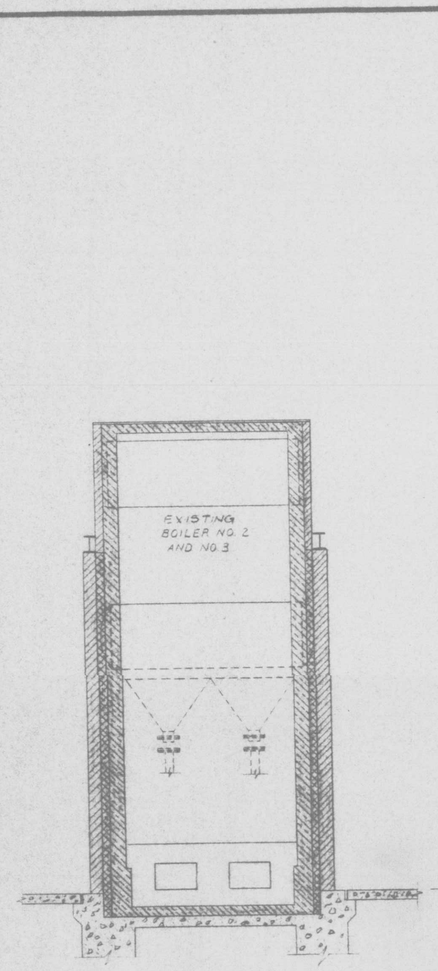

A SECTION G-2 | G-3
SCALE 1/4"=1'-0"

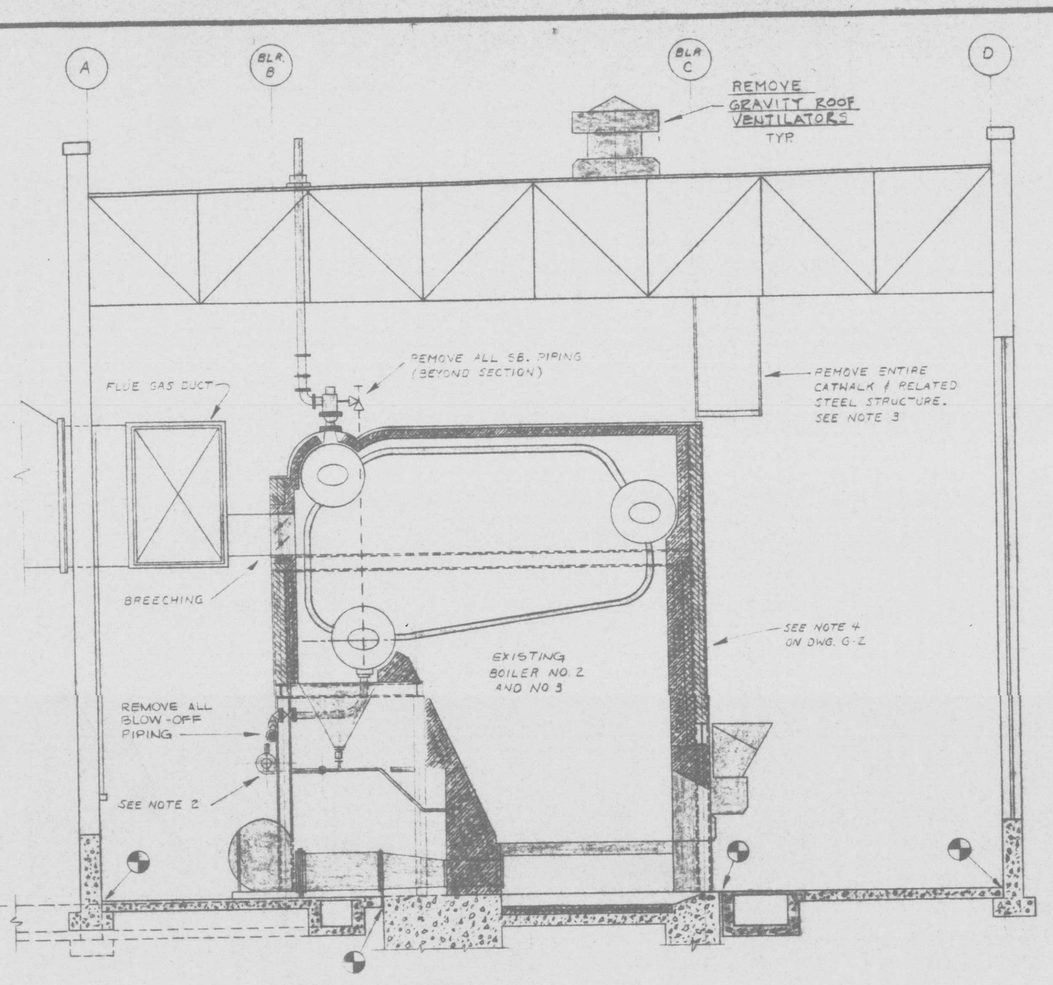

B SECTION G-2 | G-3
SCALE 1/4"=1'-0"
SEE NOTE 4 DWG. G-2

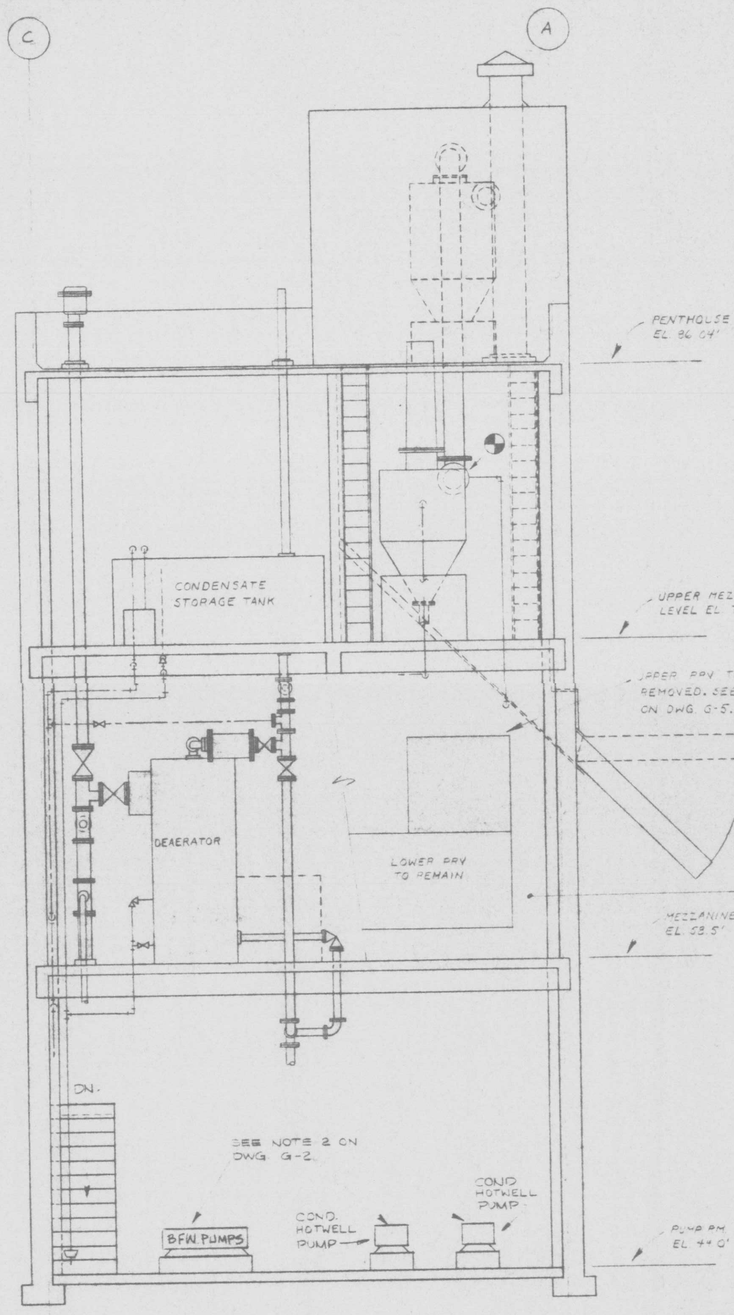

C SECTION G-2 | G-3
SCALE 1/4"=1'-0"

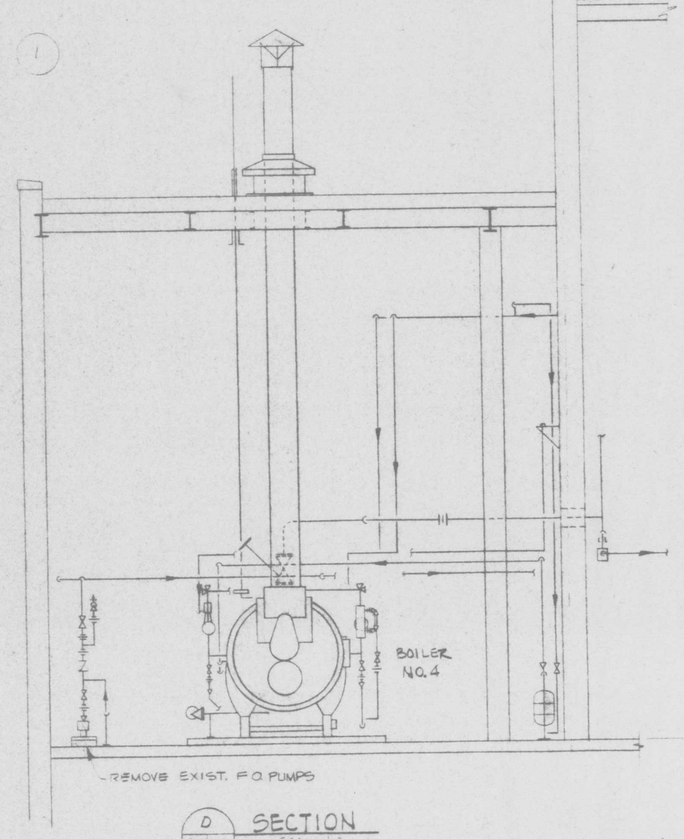

D SECTION G-2 | G-3
SCALE 1/4"=1'-0"

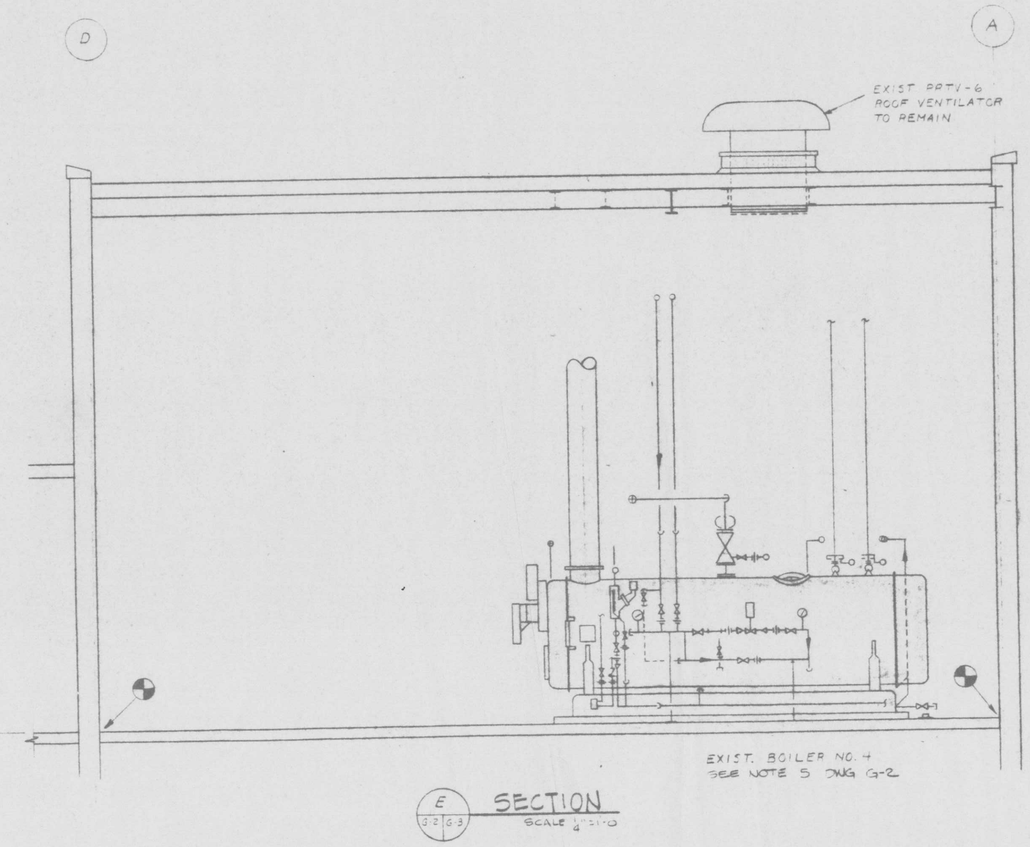

E SECTION G-2 | G-3
SCALE 1/4"=1'-0"

NOTES

1. SEE DWG. G-2 FOR LEGEND & NOTES.
2. REMOVE D/A FAN AND ALL RELATED PIPING TO BOTTOM OF EXIST. HOPPERS. SEE NOTE 4 ON DWG. G-2.
3. REMOVE ALL EXISTING CATWALKS, PLATFORMS AND LADDERS.

LEGEND

EQUIPMENT, FACILITY AND AREAS TO BE REMOVED.

AS-BUILT

Revisions	Date
AS-BUILT, NO CHANGE TO DWG.	10-6-86

Smiley Associates Inc
Philadelphia, Pennsylvania

Drawing Title: DEMOLITION SECTIONS AND ELEVATIONS		Project Title: BOILER PLANT MODIFICATION	Date: 26 NOV. 84
Approved: Division Chief	Drawn: J BEAL III	Building Number: 90	Project No.: 666-80-119
Approved: Service Director	Checked: RCB	Location: SHERIDAN, WYOMING	DRAWING No.: G-3 Dwg. Of

Veterans Administration

VA FORM 08-6231, OCT 1978