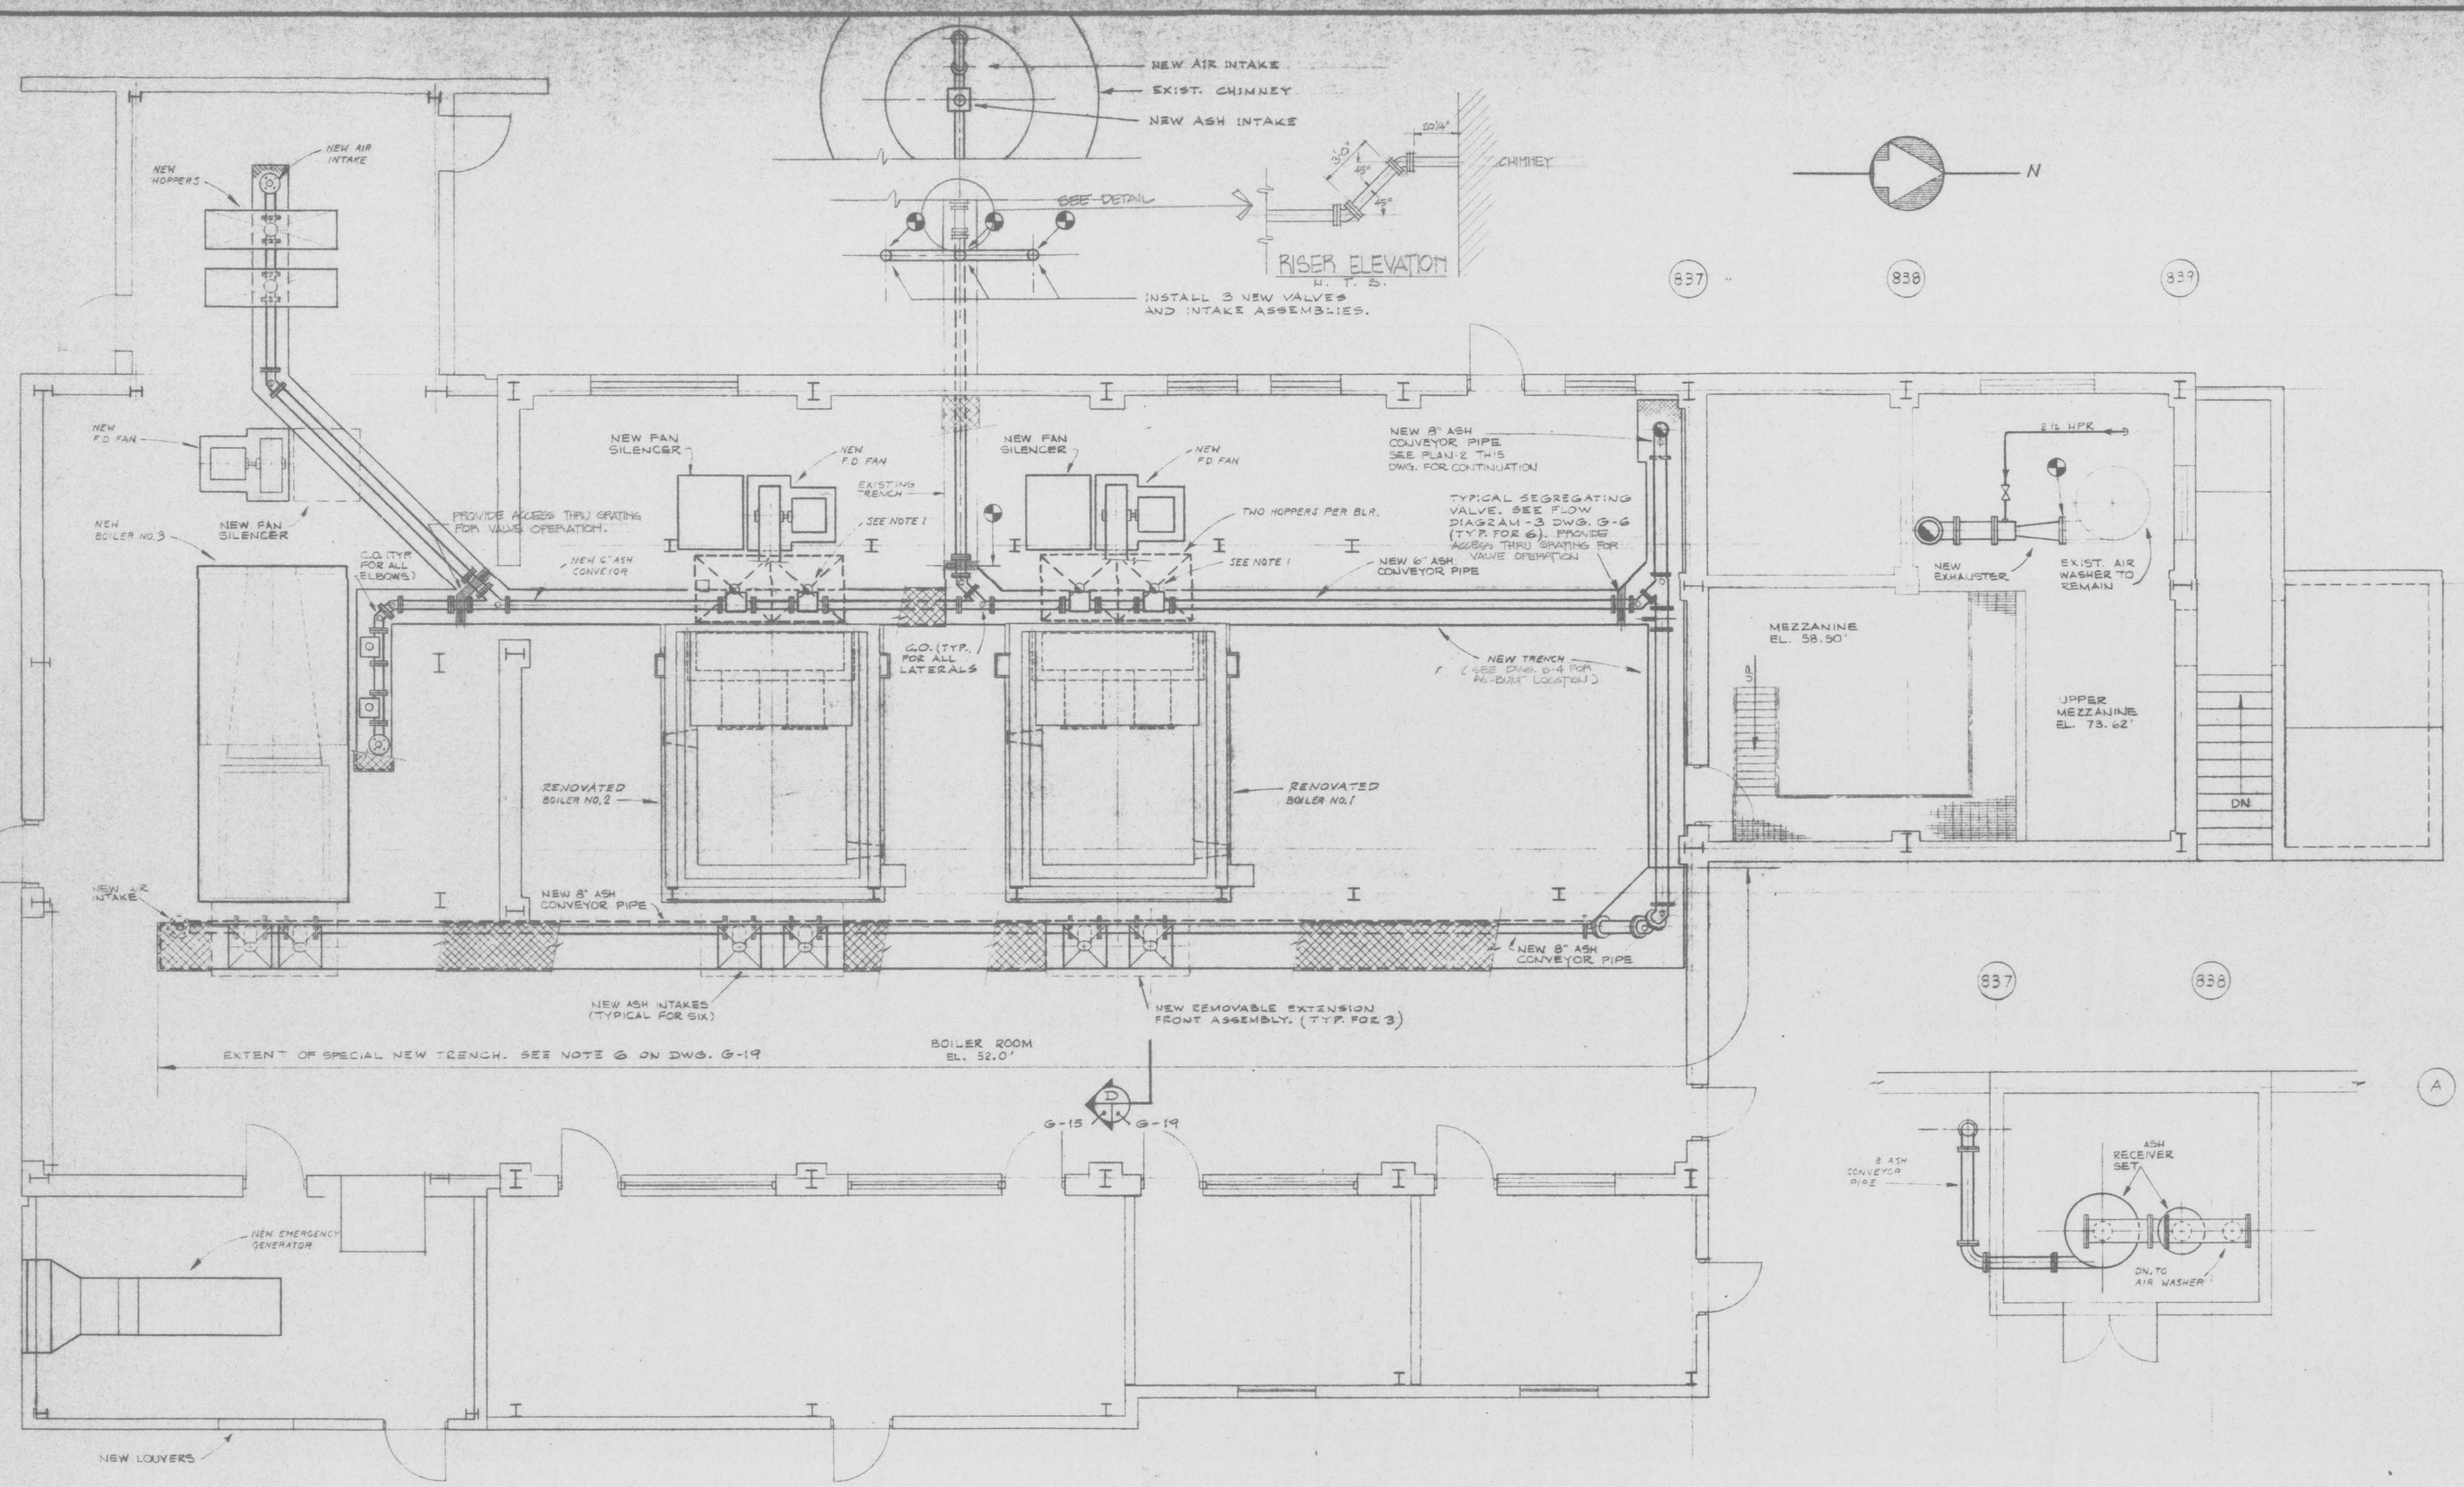

NOTES

1. LOCATE ASH INLETS TO CLEAR F.D. FAN EVASE DUCT IN MIDDLE OF BLR. (TYP. FOR TWO).
2. INSTALL NEW ASH CONVEYOR PIPING IN ENTIRE BOILER ROOM AND OUTSIDE AREAS TO POINTS AS INDICATED.

1 (G-15 & G-19) PLAN - ASH CONVEYOR PIPING (BLR. ROOM)
1/4" = 1'-0"

2 (G-18 & G-15) PLAN - ASH CONVEYOR PIPING (PENTHOUSE)
1/4" = 1'-0"

FOLEY CO.

AS BUILT DRAWING

Revisions	Date
AS-BUILT, ADDED RISER DETAIL, GRATING	10-8-86

AS-BUILT

Smiley Associates Inc
Philadelphia, Pennsylvania

Drawing Title: PLAN - BOILER ROOM ASH CONVEYOR PIPING		Project Title: BOILER PLANT MODIFICATION	Date: 26 NOV. 84
Approved: Division Chief	Drawn: J BEAL III	Building Number: 90	Project No: 666-80-119
Approved: Service Director	Checked: RCB	Location: SHERIDAN, WY	DRAWING No. G-15 Dwg. Of

Veterans Administration

VA FORM 08-6231, OCT 1978