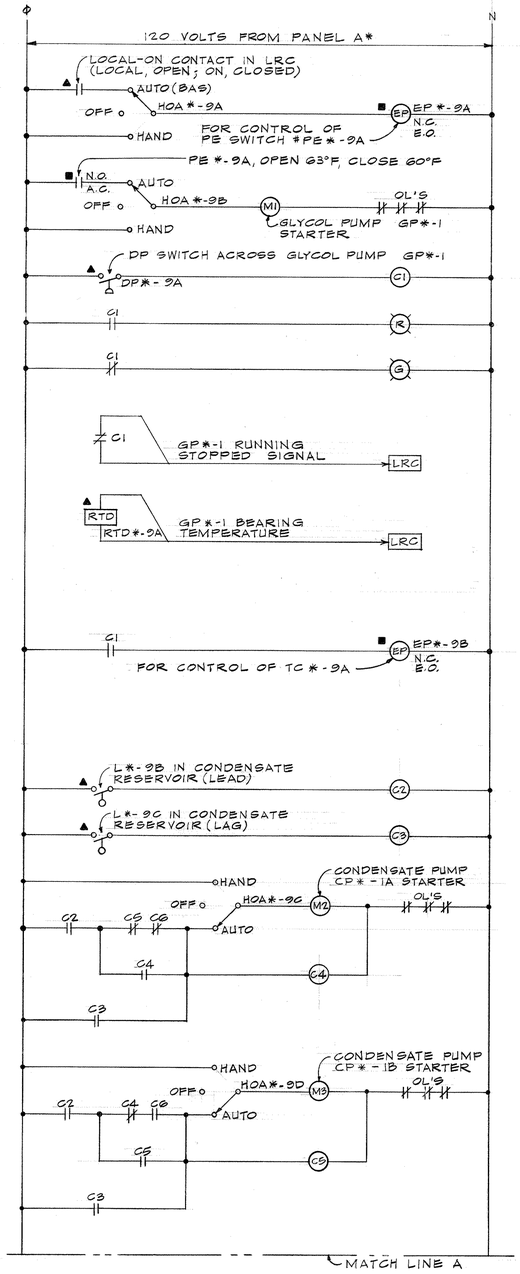

MEDIUM PRESSURE STEAM AND GLYCOL SYSTEM *-1

(NOTES 1,2,3 & 4)

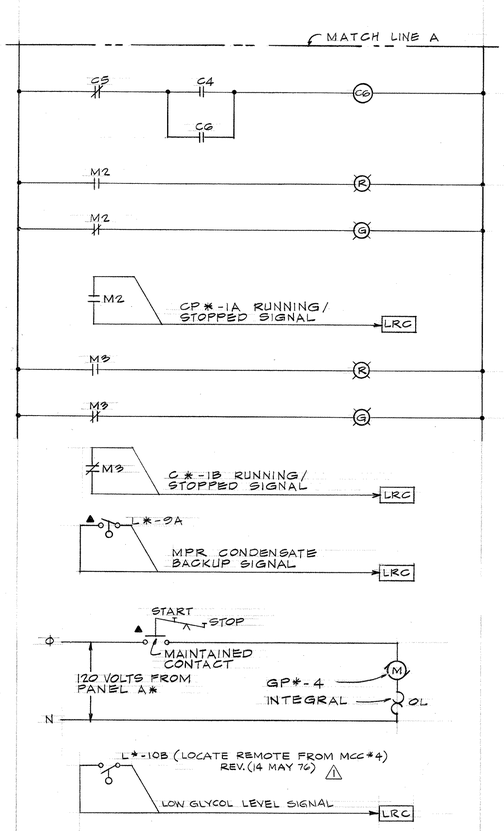

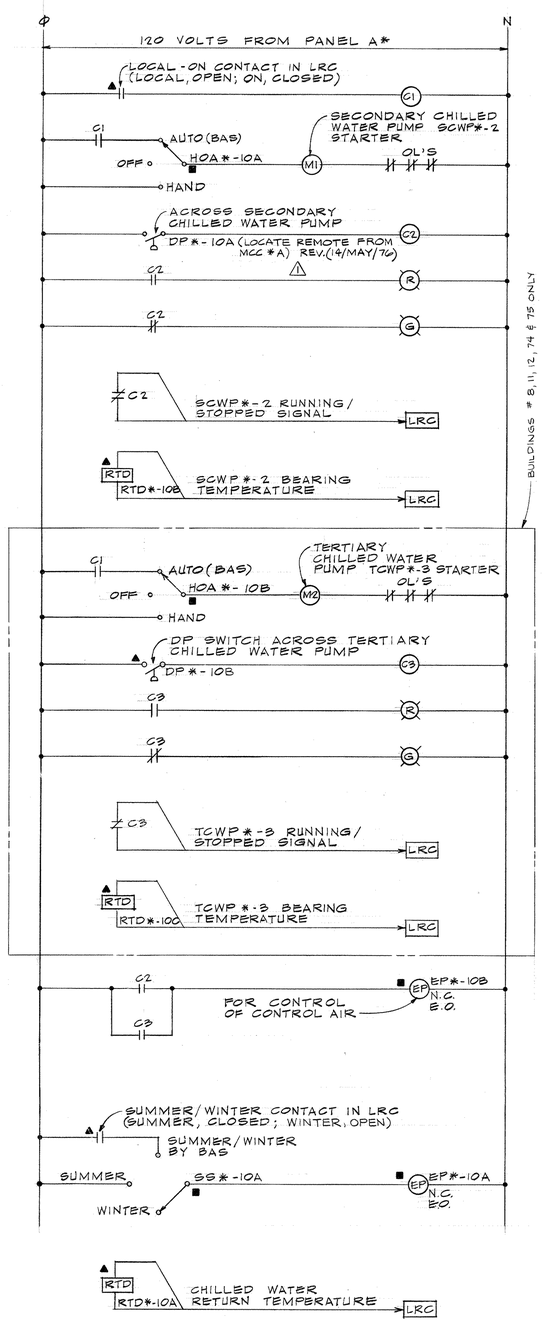

SECONDARY AND TERTIARY CHILLED WATER SYSTEM *-1

(NOTES 1,2,3,&4)

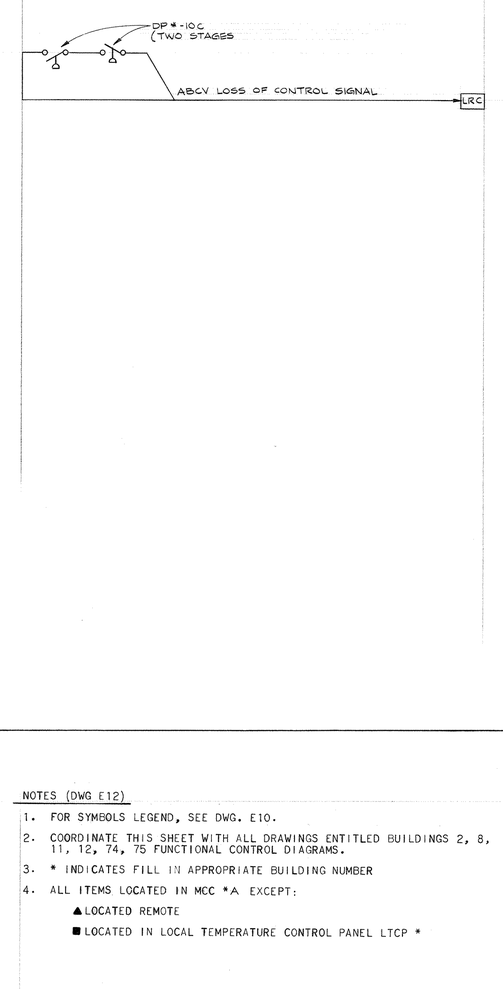

NOTES (DWG E12)

1. FOR SYMBOLS LEGEND, SEE DWG. E10.
2. COORDINATE THIS SHEET WITH ALL DRAWINGS ENTITLED BUILDINGS 2, 8, 11, 12, 74, 75 FUNCTIONAL CONTROL DIAGRAMS.
3. * INDICATES FILL IN APPROPRIATE BUILDING NUMBER
4. ALL ITEMS LOCATED IN MCC *A EXCEPT:
   - ▲ LOCATED REMOTE
   - ■ LOCATED IN LOCAL TEMPERATURE CONTROL PANEL LTCP *

5-2-2-2182

COMMONWEALTH OF VIRGINIA — WALTER G. MILES — No. 6740 — CERTIFIED PROFESSIONAL ENGINEER

NO.	DATE	DESCRIPTION
1	9-5-80	RECORD DRAWING REVISION

REVISIONS

SHEET TITLE: BUILDINGS 2, 8, 11, 12, 74, 75 ELECTRICAL CONTROL DIAGRAMS

BLDG. NO.	PROJECT TITLE
2, 8, 11, 12, 74, 75	AIR CONDITION VARIOUS BUILDINGS

DRAWN	CHECKED	DATE
HDB	WGM, DHJ	APRIL 27, 1976

WILEY & WILSON, INC.
ENGINEERS • ARCHITECTS • PLANNERS
LYNCHBURG, VIRGINIA

DRAWING NUMBER: E12 dwg. 114 of 165

APPROVED PROJECT DIRECTION

658-036
658-042

VETERANS ADMINISTRATION

LOCATION: VAH, SALEM, VIRGINIA

THREE INCHES EQUALS ONE FOOT
ONE AND ONE HALF INCHES EQUALS ONE FOOT
ONE INCH EQUALS ONE FOOT
THREE QUARTER INCH EQUALS ONE FOOT
ONE HALF INCH EQUALS ONE FOOT
THREE EIGHTH INCH EQUALS ONE FOOT
ONE QUARTER INCH EQUALS ONE FOOT
ONE EIGHTH INCH EQUALS ONE FOOT

114

76-266