

REVISES SHEET: A1-04

ISSUED WITH ADDENDUM #1

REFLECTED CEILING PLAN PARTIAL FLOOR

DesignLevel

DEPARTMENT OF VETERANS AFFAIRS

Project Name: OPEN MRI SITE PREP

Project No.: 552-CSI-101

Project Description: MRI/ IMAGING ADDITION

No. R1-01

DesignLevel 455 Arden Road Columbus, OH 43214 p. 614.267.6603 or 614.354.3021
www.DesignLevelArchitecture.com

Date: April 26, 2012

© Copyright 2012

Attachment #3

ROOM FINISH SCHEDULE													
ROOM NO.	ROOM NAME	FLOOR		BASE		WALLS					* NOTES		
		MATERIAL	COLOR	MATERIAL	COLOR	MATERIAL	COLOR						
							N	E	S	W			
C-MRI1	COORIDOR	*CS	1,2,3,4,5								SEE FINISH PLAN FOR FLOOR PATTERN		
C-MRI2	COORIDOR	*CS	1,2,3,4,5								SEE FINISH PLAN FOR FLOOR PATTERN		
C-MRI3	COORIDOR	*CS	2,3,4,5				BRICK				SEE FINISH PLAN FOR FLOOR PATTERN		
C-MRI4	COORIDOR	*CS	2,3,4,5					BRICK			SEE FINISH PLAN FOR FLOOR PATTERN		
C-MRI5	COORIDOR	*CS	2,3,4,5	RB	1				BRICK		SEE FINISH PLAN FOR FLOOR PATTERN		
C-MRI6	COORIDOR	*WSV	2	WSV	2	PT					SEE FINISH PLAN FOR FLOOR PATTERN		
C-MRI7	COORIDOR	*CS	2,3,4,5	RB	1	*PT	4	4	4	4	SEE FINISH PLAN FOR FLOOR PATTERN & PAINT LOCATIONS		
C-MRI8	COORIDOR	WSV	2	WSV	2						SEE FINISH PLAN FOR FLOOR PATTERN		
C-MRI9	COORIDOR	*CS	2,3,4,5	RB	1	*PT				5	SEE FINISH PLAN FOR FLOOR PATTERN & PAINT LOCATIONS		
MRI100	VESTIBULE	CPT	1,1A								SEE FINISH PLAN FOR FLOOR PATTERN		
MRI101	LOBBY WAITING	*CS	2,3,4,5	RB	1	*	BRICK				SEE FINISH PLAN FOR FLOOR PATTERN & PAINT LOCATIONS		
MRI102	RECEPTION	CPT	2	RB	1	*	BRICK						
MRI103	STAFF WORK	CPT	2	RB	1	PT	4						
MRI104	VIEW CONSULT	CPT	2	RB	1	PT		5					
MRI105	ELECTRICAL	EPY	1	RB	1	PT							
MRI106	DATA	EPY	1	RB	1	PT					SEE NOTE 3 BELOW		
MRI107	TOILET	PCT	1	PCT	1	PCT/PT	PCT/PT	PCT/PT	PCT/PT	PCT/PT	PCT-1, PT-6. SEE ELEVATIONS FOR PATTERN		
MRI108	TOILET	PCT	1	PCT	1	PCT/PT	PCT/PT	PCT/PT	PCT/PT	PCT/PT	PCT-1, PT-6. SEE ELEVATIONS FOR PATTERN		
MRI109	SUB-WAITING	WSV	1/2	WSV	2	*PT		5			SEE FINISH PLAN FOR ACCENT PAINT LOCATIONS		
MRI110	TOILET	PCT	1	PCT	1	*PCT/PT	PCT/PT	PCT/PT	PCT/PT	PCT/PT	PCT-1, PT-6. SEE ELEVATIONS FOR PATTERN		
MRI111	INPATIENT HOLDING	WSV	1/2	WSV	2	PT		5					
MRI112	MRI CONTROL	WSV	1/2	WSV	2	PT		4			SEE FINISH PLAN AND ELEVATIONS		
MRI113	MRI	WSV	1/2	WSV	2	*PT	3/5	3/5	3/5	3/5	SEE FINISH PLAN AND ELEVATIONS		
MRI114	DRESSING	CPT	2	RB	1	PT	4	4	4	4	SEE FINISH PLAN AND ELEVATIONS		
MRI115	DRESSING	CPT	2	RB	1	PT	4	4	4	4	SEE FINISH PLAN AND ELEVATIONS		
MRI116	UPS/ MRI MECHANICAL	AF	-	RB	1	PT							
MRI117	MECHANICAL	CSL		RB	1	PT							
MRI118	HAC	PCT	1	PCT	1	PCT/PT	PCT/PT	PCT/PT	PCT/PT	PCT/PT	ALL WALLS, PCT-1 (24"x24") UP TO 4'-0", PT-1		
MRI119	BIO WASTE	WSV	2	WSV	2	PT							
MRI120	CLEAN SUPPLY	WSV	2	WSV	2	PT							
MRI121	SOILED UTILITY	WSV	2	WSV	2	PT							
MRI122	EQUIPMENT	CSL		RB	1	PT					SEE FINISH PLAN FOR FLOOR PATTERN		
MRI123	STAFF TOILET	PCT	1	PCT	1	PCT/PT	PCT/PT	PCT/PT	PCT/PT	PCT/PT			
MRI124	STAFF LOCKERS	*CS	3,4,5	RB	1	PT	4	4	4	4	SEE FINISH PLAN FOR FLOOR PATTERN		
MRI125	SHOWER	PCT	1	PCT	1	PCT/PT	PCT/PT	PCT/PT	PCT/PT	PCT/PT			
MRI126	STAFF LOUNGE	*CS	2,3,4,5	RB	1	PT				2	SEE FINISH PLAN FOR FLOOR PATTERN		
MRI127	STAFF RADIOLOGIST	CPT	2	RB	1	PT	2	2	2	2	PAINT FINISH: MATTE		
MRI128	PROF NON-PHYSICIAN	CPT	2	RB	1	PT				4			

2

1

FINISH MATERIAL NOTES

1. ALL WALLS SHALL BE PT-1, UNO.

2. 2. PAINT COUNTER TOP BRACES TO MATCH WALL.

3. PROVIDE FULL HEIGHT PAINTED 3/4" AC GRADE FIRE RETARDANT PLYWOOD OVER TYPE "X" GYPSUM BOARD ALL WALLS.

REFER TO SPECIFICATIONS 09 06 00 SCHEDULE FOR FINISHES FOR ABBREVIATIONS.

2

1

FINISH MATERIAL NOTES

- ALL WALLS SHALL BE PT-1, UNO.
2. PAINT COUNTER TOP BRACES TO MATCH WALL.
3. PROVIDE FULL HEIGHT PAINTED 3/4" AC GRADE FIRE RETARDANT PLYWOOD OVER TYPE "X" GYPSUM BOARD ALL WALLS.

REFER TO SPECIFICATIONS 09 06 00 SCHEDULE FOR FINISHES FOR ABBREVIATIONS.

REVISES SHEET: A7-01 and A7-02
PARTIAL FLOOR FINISH PLAN

ISSUED WITH ADDENDUM #1

DesignLevel

DEPARTMENT OF VETERANS AFFAIRS
Project Name: OPEN MRI SITE PREP

Project No.: 552-CSI-101

Project Description: MRI/ IMAGING ADDITION

No. R1-02

DesignLevel 455 Arden Road Columbus, OH 43214 p. 614.267.6603 or 614.354.3021

www.DesignLevelArchitecture.com

Date: April 26, 2012

© Copyright 2012

- PLAN NOTES**
1. PROVIDE PENDANT SPEAKER ABOVE CEILING.
 2. PUSHBUTTON DOOR RELEASE FOR THIS DOOR.
 3. THIS ROOM TO BE TREATED AS A "TECHNOLOGY CLOSET" AS DEFINED BY THE SPECIFICATIONS. PROVIDE EQUIPMENT RACK/CABINET, SWITCHES, PATCH PANELS, WIRE MANAGEMENT, ETC. AS DEFINED IN THE SPECIFICATIONS. RUN 62 5/125 TWELVE STRAND MULTIMODE FIBER OPTIC CABLE FROM ROOM 1C-152 TO NEW TR.
 4. FIRE ALARM PANEL. TIE INTO EXISTING FIRE ALARM SYSTEM IN ROOM 1C-149.




FIRST FLOOR SYSTEMS PLAN
SCALE: 1/8"=1'-0"

DESIGNER/ENGINEER
CAD OPERATOR
CHECKER

ISSUED FOR BID
PRE-BID AMENDMENT, REV 1

02/28/2012
04/26/2012

Dynamix Engineering Ltd.
Facility Engineering Consultants
855 Grandview Avenue, Third Floor Columbus, Ohio 43215
Phone: (614)443-1178 · Fax: (614)443-1594 · Email: dynamix@dynamix-ltd.com
Comm. No.: 110028

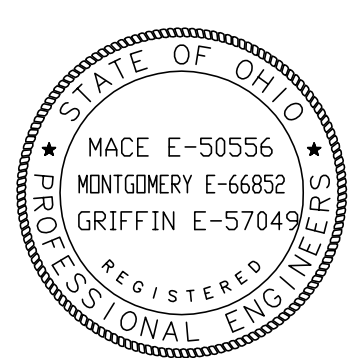

Professional Seal

Revised By:

Drawing Title
FIRST FLOOR SYSTEMS PLAN

Project Title
OPEN MRI SITE PREP

Date
02-28-2012
Project No.
552-CSI-101

SCALE: 1/8"=1'-0"

Approved: Project Manager
RANDI FIORINA

Building Number
335


Checked
DYNAMIX

Drawn
JH

Approved: Service Chief
GARY ABREU

Location 4100 WEST THIRD STREET
DAYTON, OH 45428

Drawing No.
E1-03

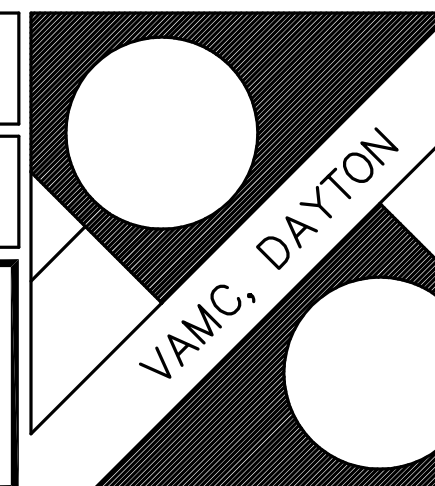

VA Department of Veterans Affairs