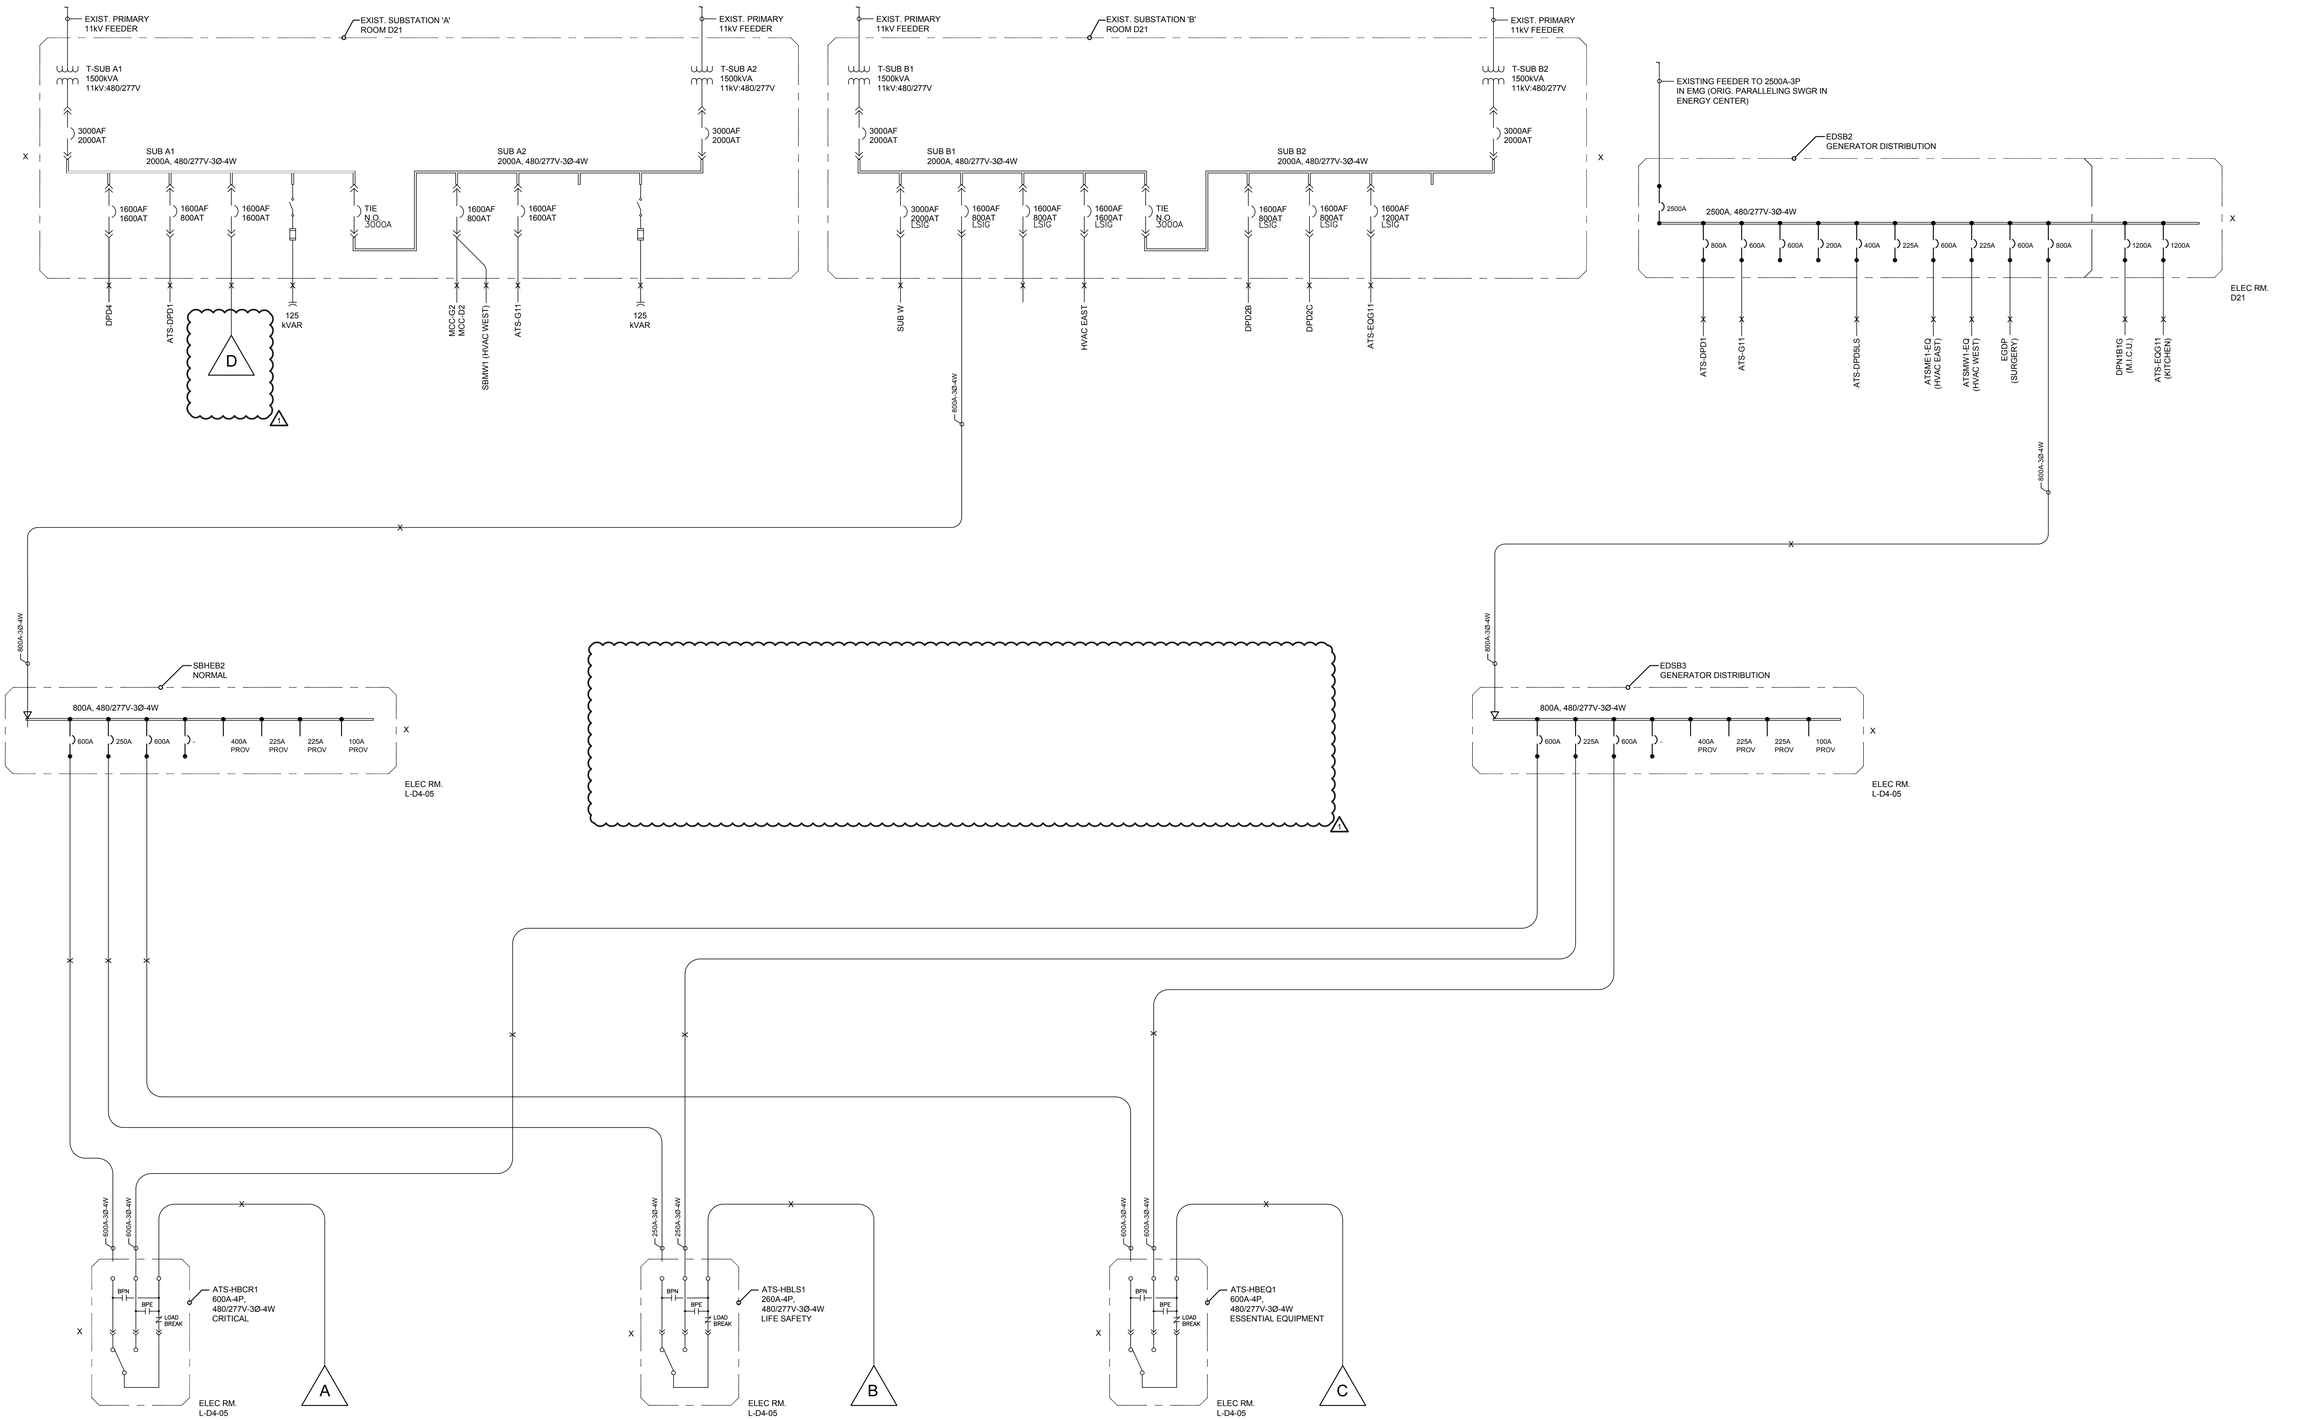

FOR CONSTRUCTION

FINAL SUBMISSION
FULLY SPRINKLERED

ADDENDUM 02	03/03/17
FINAL SUBMISSION	07/05/16
Revisions:	Date

CONSULTANTS:

STATE OF OHIO
M.P. LONG
59459
16009

ARCHITECT/ENGINEERS:

MAKOVICH & PUSTI
ARCHITECTS, INC.
111 FRONT STREET BEREA, OHIO 44017
(440) 891-8910 p (440) 891-0086 f

FREDRICK, FREDRICK & HELLER
ENGINEERS, INC.
672 EAST ROYALTON ROAD
BROADVIEW HTS., OHIO 44147
TEL: (440) 546-9555
FAX: (440) 546-9699

Drawing Title
POWER DISTRIBUTION
ONE LINE DIAGRAM - EXISTING

Approved: Project Director

Project Title
VAMC WADE PARK
CLEVELAND RENOVATE
RESEARCH NORTH

Location
10701 EAST BLVD, CLEVELAND, OHIO 44106

Date: 07/05/16
Checked By: MPL
Drawn By: TWM

Project Number: 541-13-104
Building Number: 1
Drawing Number: 1-E9C

Office of
Construction
and Facilities
Management

Department of
Veterans Affairs

VA FORM 08-6231