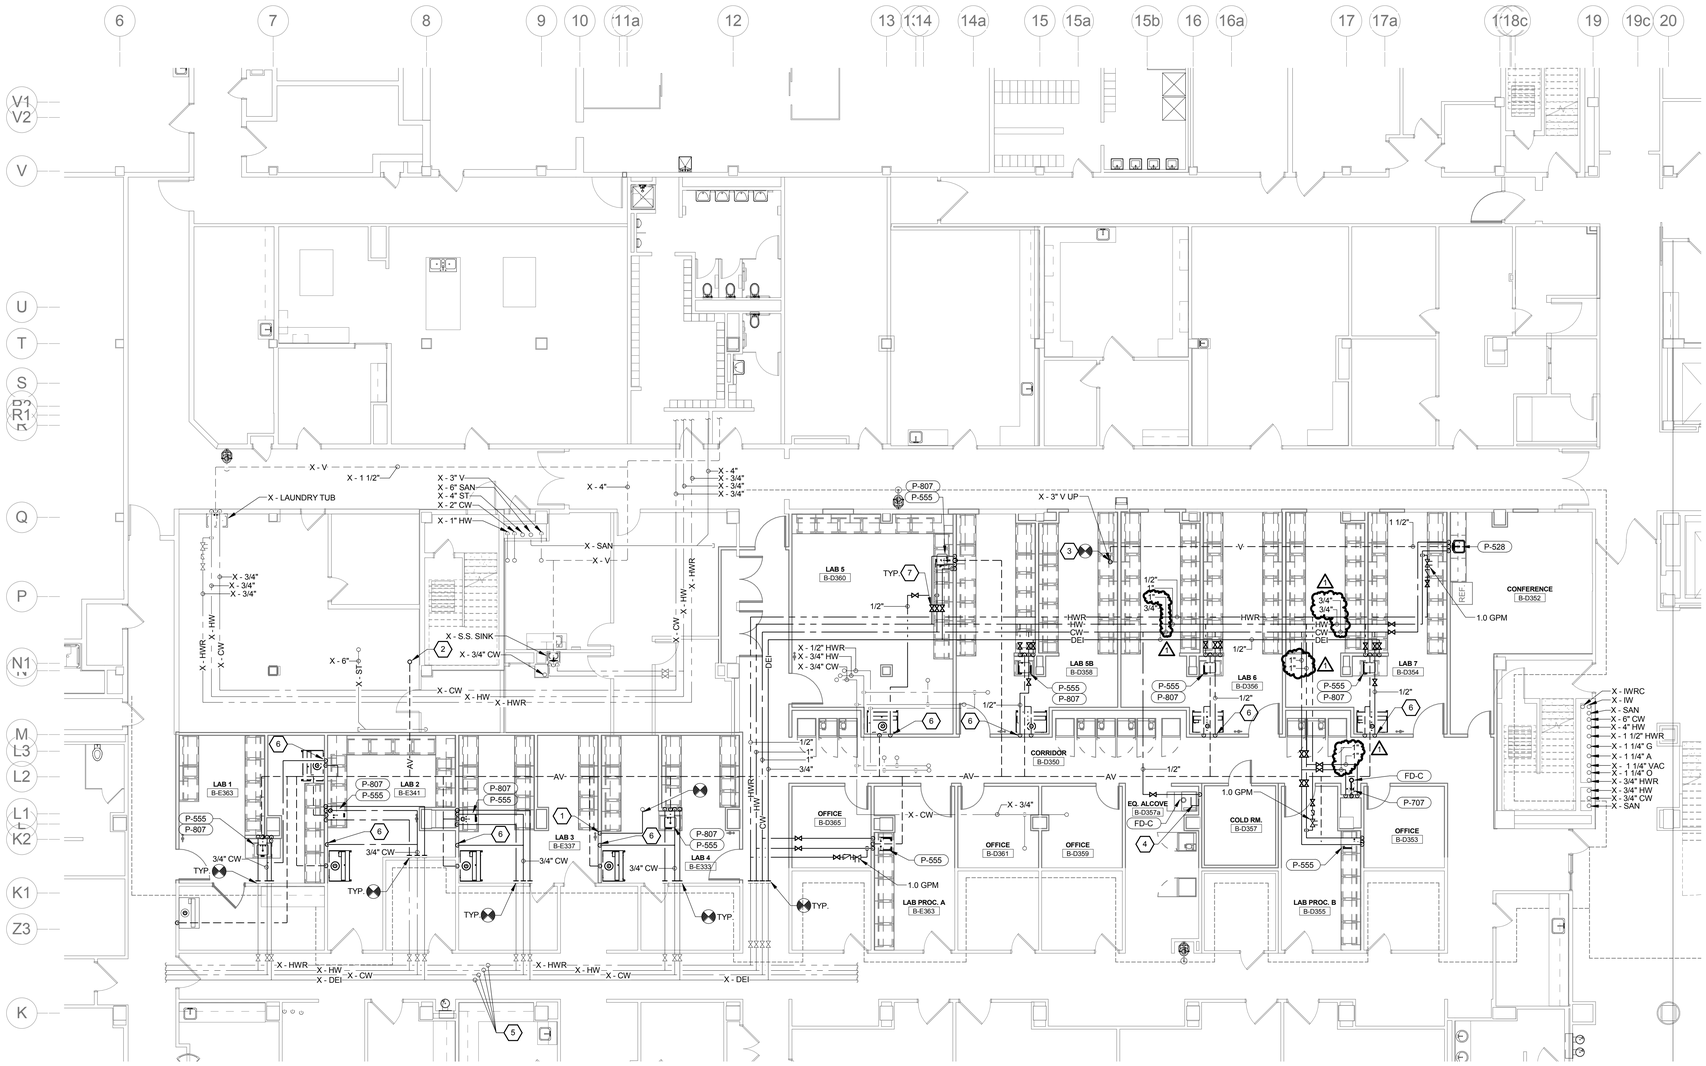

CODED NOTES

1. ROUTE 1" CW DOWN THROUGH WALL TO SUB-BASEMENT. RE-CONNECT 1" CW LINE TO EXISTING BRANCH LOCATED IN SUB-BASEMENT.
2. ROUTE 3" ACID VENT UP. REFER TO PARTIAL FIRST FLOOR PLAN (THIS DWG.) FOR CONTINUATION.
3. CONNECT 1-1/2" VENT TO EXISTING 3" RISER. TRANSITION PIPE AS REQUIRED.
4. PROVIDE HEAVY-DUTY ICE MAKER CONNECTION BOX WITHIN WALL. (GUY GRAY MODEL BIM-875 OR EQUAL)
5. CONTRACTOR SHALL FIELD VERIFY EXACT ROUTING OF MAINS IN ORDER TO COORDINATE POINTS OF CONNECTION.
6. ROUTE 1/2" CW DOWN WALL FOR CONNECTION TO LABORATORY FUME HOOD. CONNECT TO FUME HOOD PER MANUFACTURER'S RECOMMENDATIONS. COORDINATE FUME HOOD MANUFACTURER SELECTION WITH GC AND VA PERSONNEL.
7. SHUT-OFF VALVES SHALL BE PROVIDED TO SHUT-DOWN ALL SERVICES TO INDIVIDUAL LABORATORY. PROVIDE LAMACOID PLATE AT CEILING AT APPROXIMATE VALVE LOCATION. LAMACOID PLATE SHALL INDICATE VALVE LOCATION AND SERVICE.
8. ROUTE 3" ACID VENT UP AND DOWN THROUGH SHAFT. TERMINATE AT ROOF ABOVE. CUT AND PATCH SHAFT WALL AS REQUIRED FOR INSTALLATION OF VENT PIPE. PAINT PATCHED WALL CORNER TO CORNER TO MATCH EXISTING WALL FINISH. COORDINATE WORK IN THIS ROOM WITH GC AND VA FACILITIES PERSONNEL.

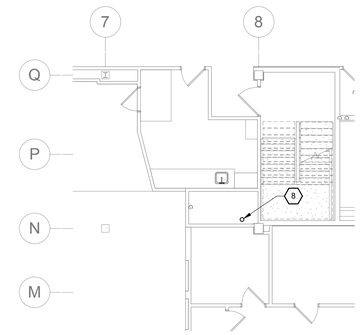

PARTIAL FIRST FLOOR PLUMBING PLAN — 2

1/8" = 1'-0"

0' 4' 8' 16' 32'

PARTIAL BASEMENT PLUMBING PLAN — 1

1/8" = 1'-0"

0' 4' 8' 16' 32'

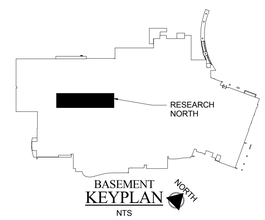

FOR CONSTRUCTION

FINAL SUBMISSION
FULLY SPRINKLERED

ADDENDUM 02	03/03/17
FINAL SUBMISSION	07/05/16
Revisions:	Date

CONSULTANTS:

STATE OF OHIO — L.D. HENDRIX, JR — 74490 — PROFESSIONAL ENGINEER — 16009

ARCHITECT/ENGINEERS:

MAKOVICH & PUSTI ARCHITECTS, INC.
111 FRONT STREET BEREA, OHIO 44017
(440) 891-0910 p (440) 891-0086 f

FREDRICK, FREDRICK & HELLER ENGINEERS, INC.
672 PLAIN STREET, SUITE 200
AKRON, OHIO 44311-1067
(330) 535-5600
FAX (330) 535-5610

Drawing Title: PARTIAL BASEMENT PLUMBING PLAN

Approved: Project Director

Project Title: VAMC WADE PARK CLEVELAND RENOVATE RESEARCH NORTH

Location: 10701 EAST BLVD, CLEVELAND, OHIO 44106

Date: 07/05/16 | Checked By: LDH | Drawn By: AMM

Project Number: 541-13-104

Building Number: 1

Drawing Number: 1-P4

Office of Construction and Facilities Management

Department of Veterans Affairs

VA FORM 08-6231