

**VA MENLO PARK DIVISION**  
795 Willow Road  
Menlo Park, California 94025



**WELCOME CENTER**

**DOMICILIARY**


**CUR.**

**ENGINEERING**

**WAREHOUSE**

**DARU**

**CLC 2016**

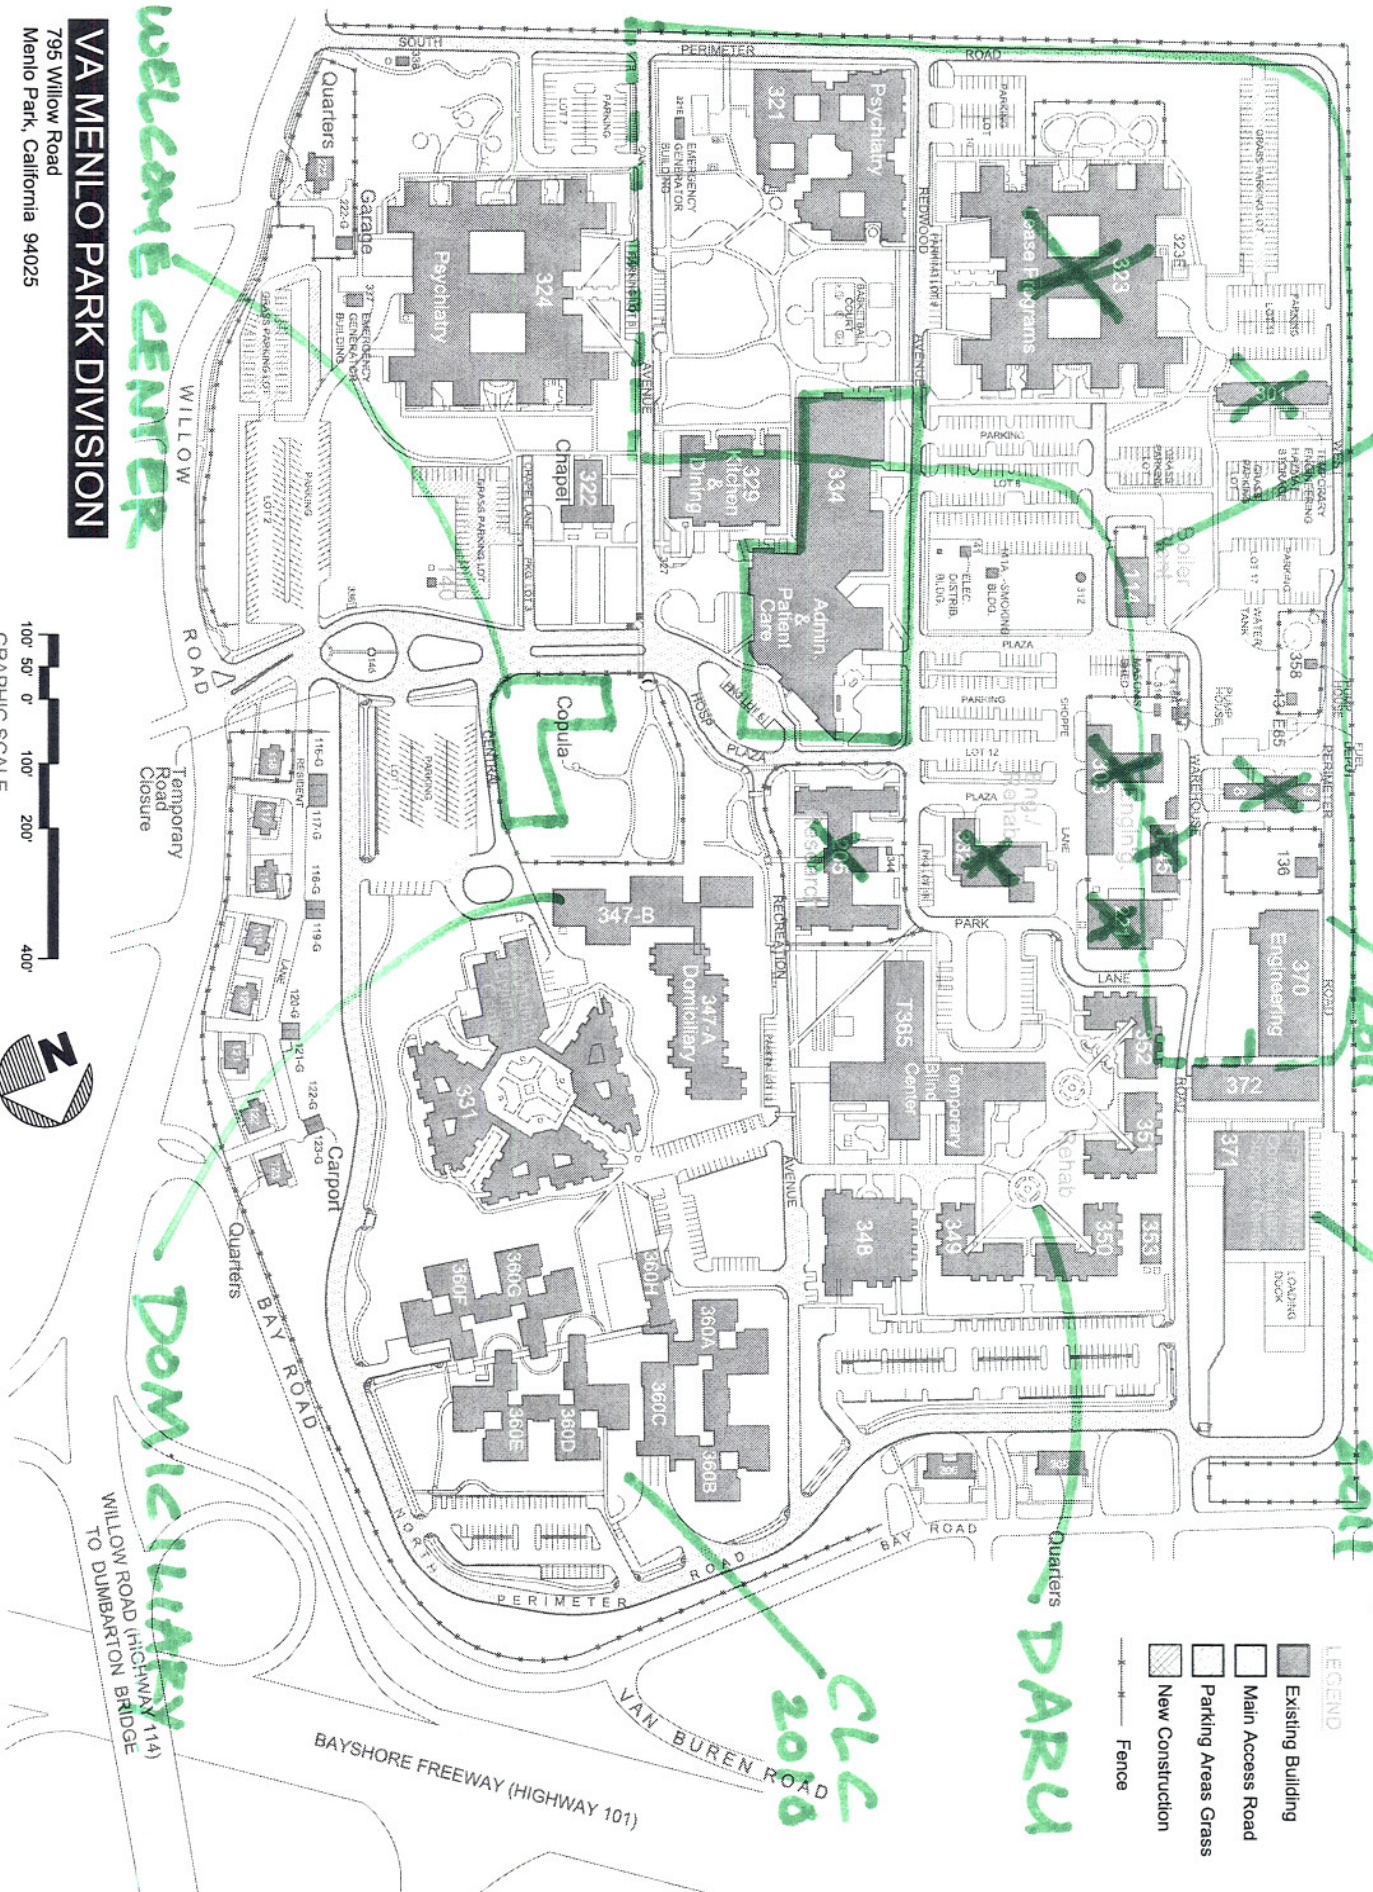

- LEGEND**
- Existing Building
  - Main Access Road
  - Parking Areas Grass
  - New Construction
  - Fence