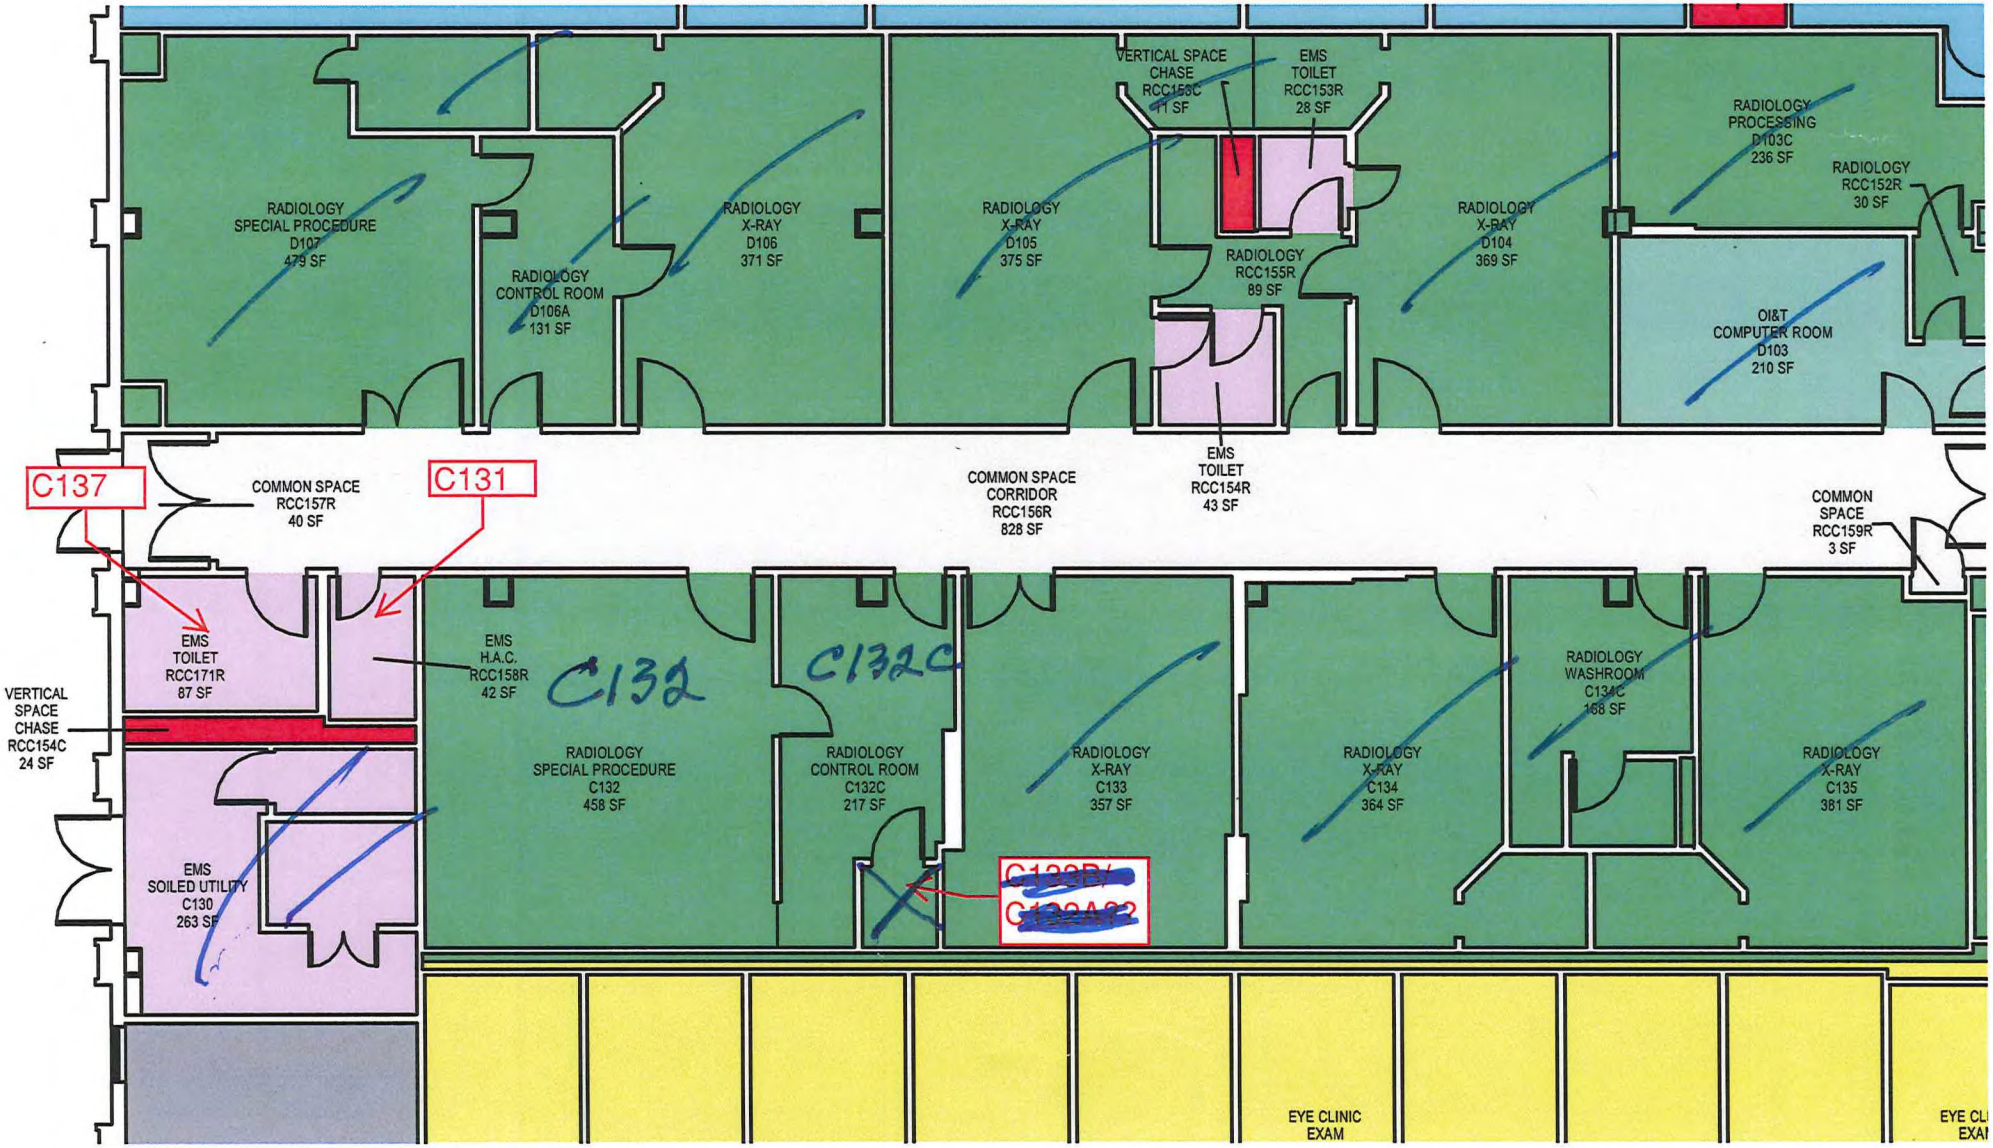578-16-043 Room Plan