


③ Data Drops
to be
Relocated

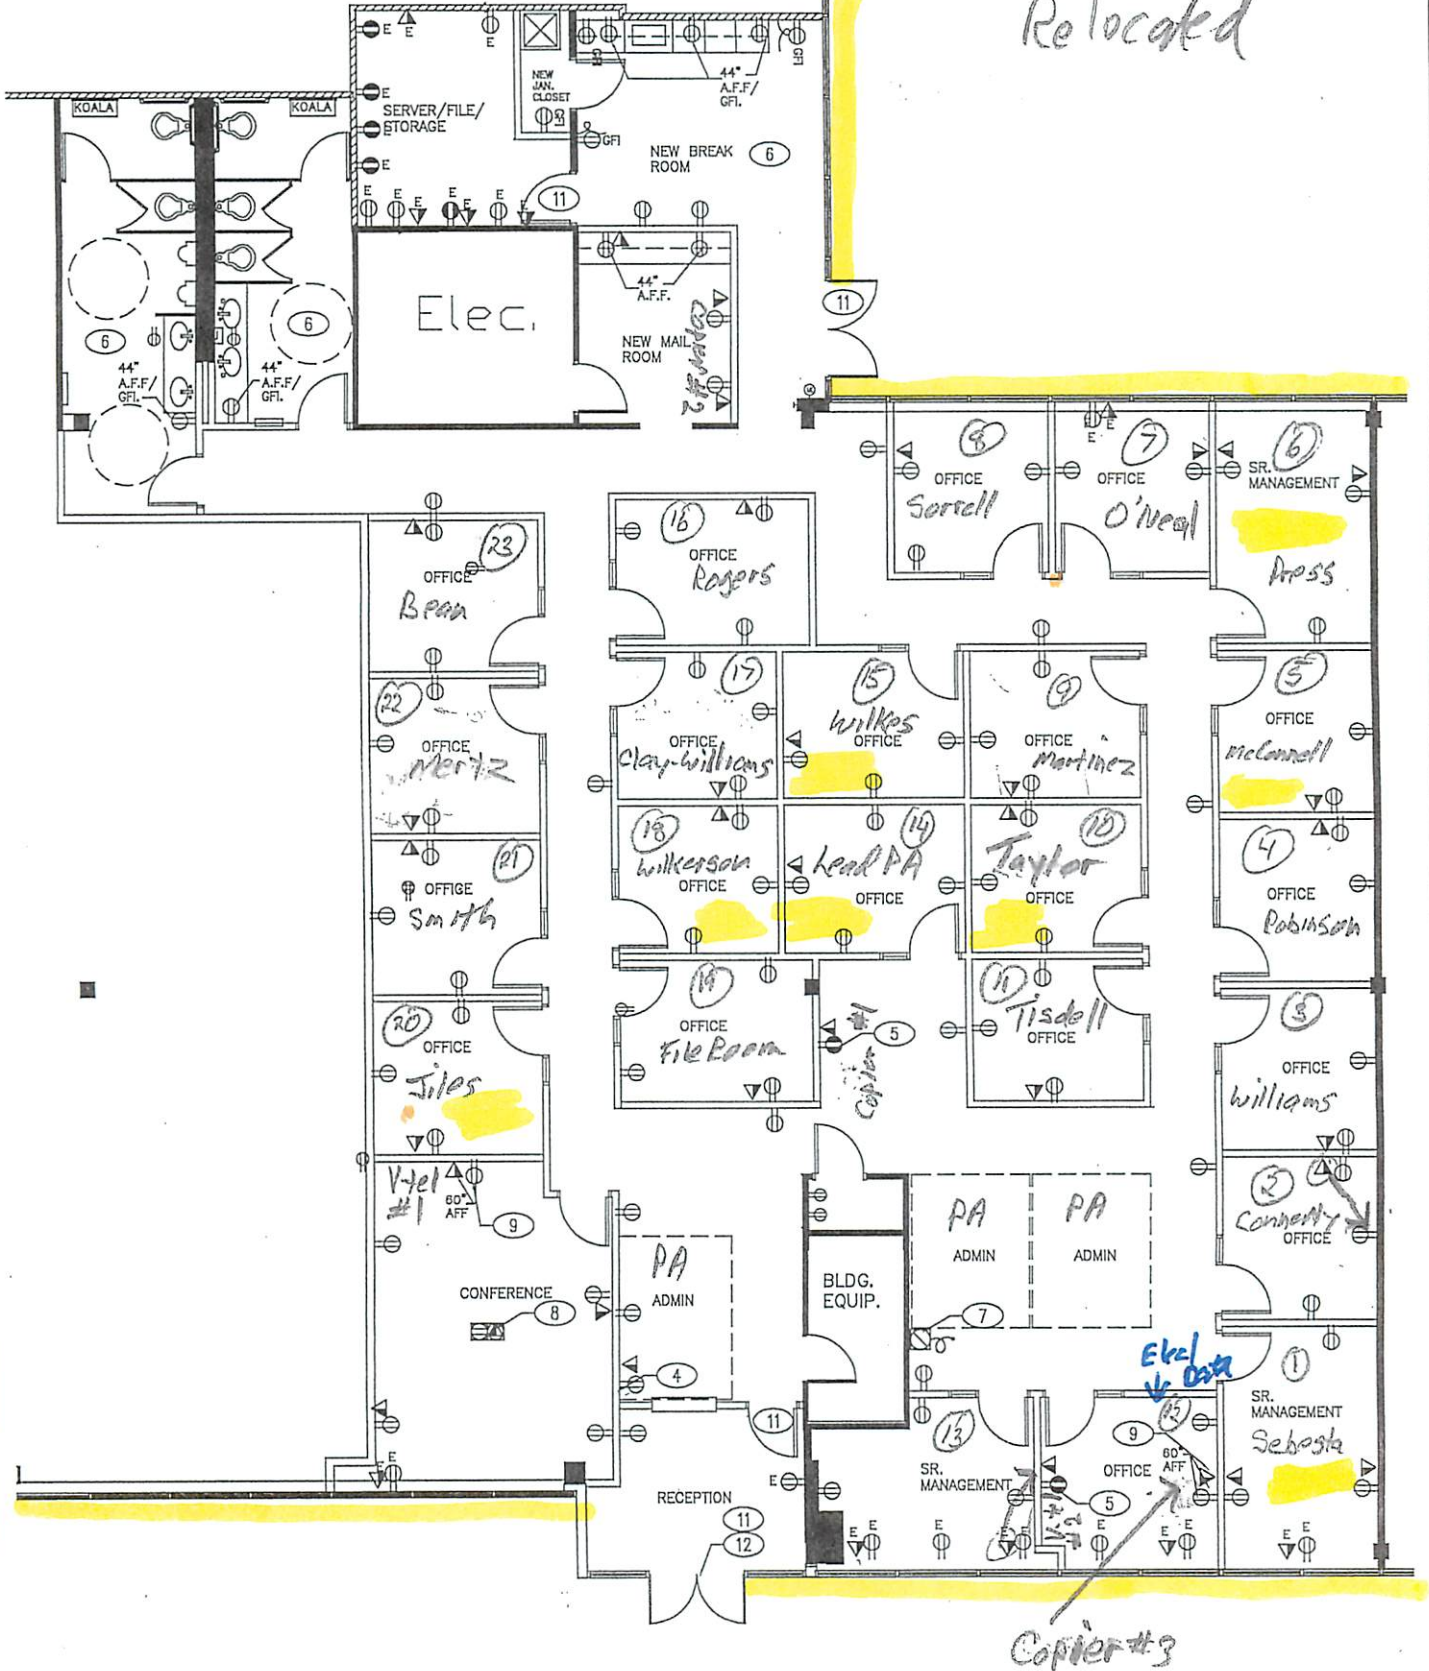

DATE: 08/10/16
BUILDING: 2255 ENTERPRISE DR
SUITE: 5506 PARTIAL
SCALE: N.T.S.
SPACE PLAN #: SP-3

GSA - VA ADMINISTRATION (EXP)

JOB #: 255-M-16XXXX
DESIGNER: KAT
BROKER:
R.S.F. 5,575
SHEET #: 4 OF 5