

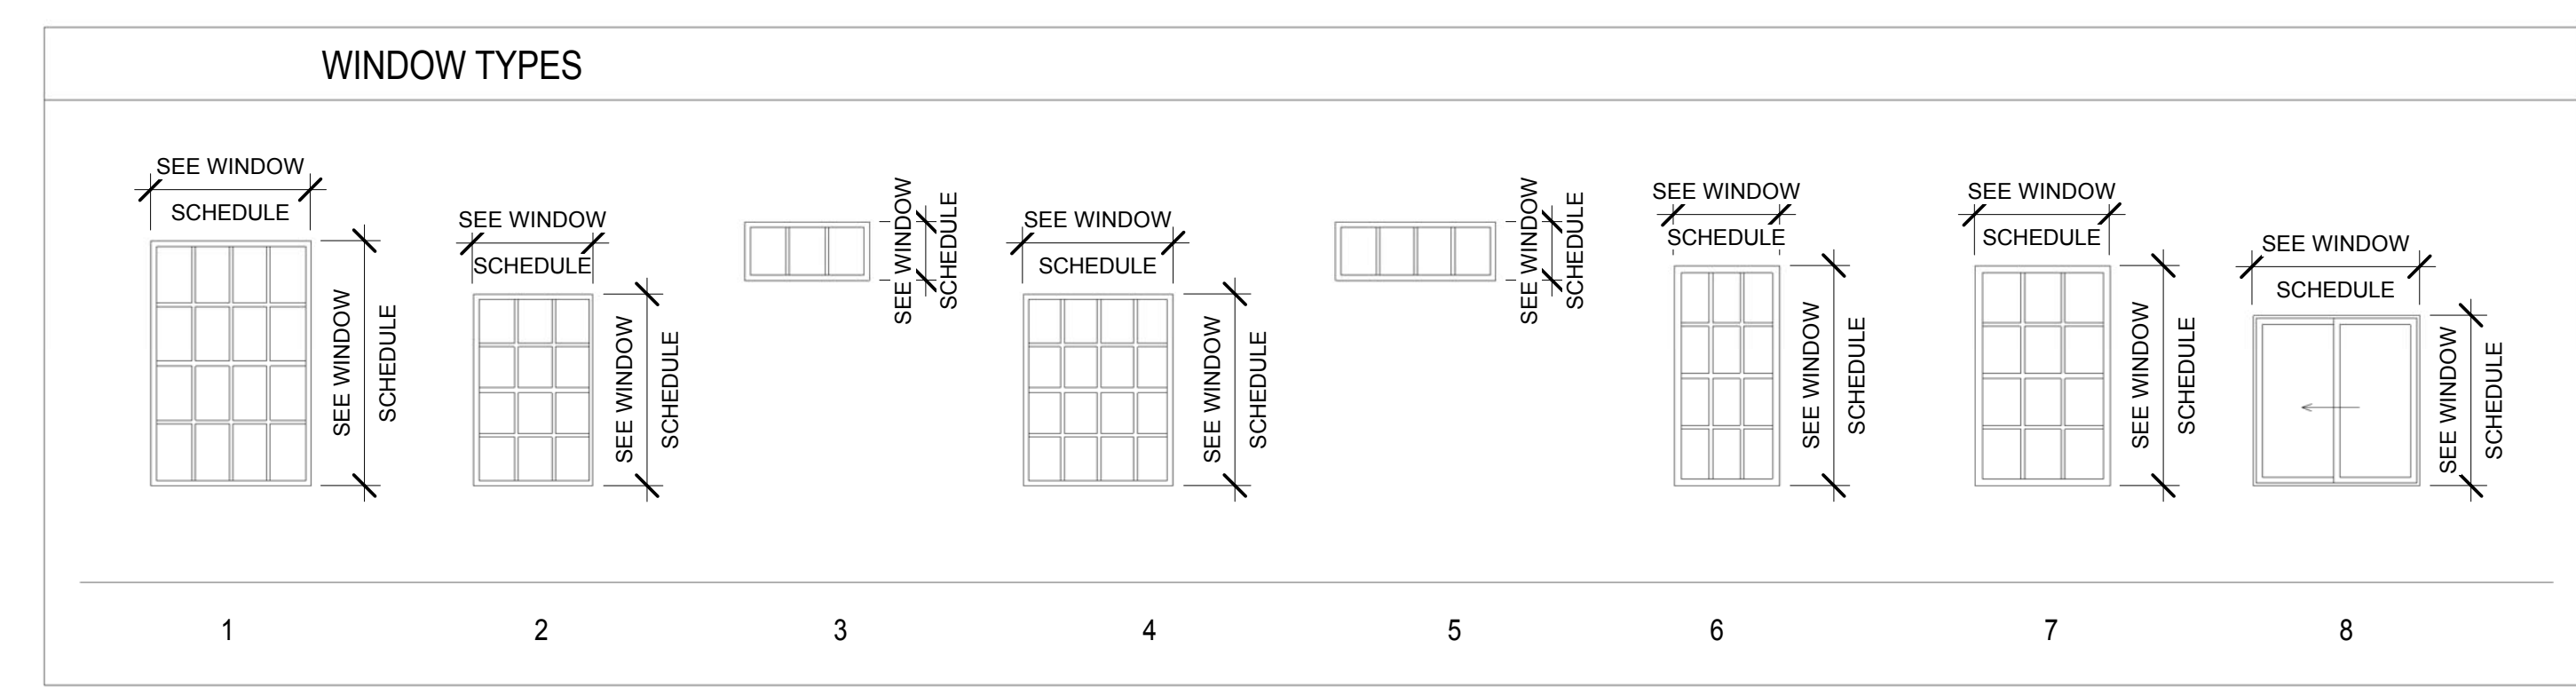
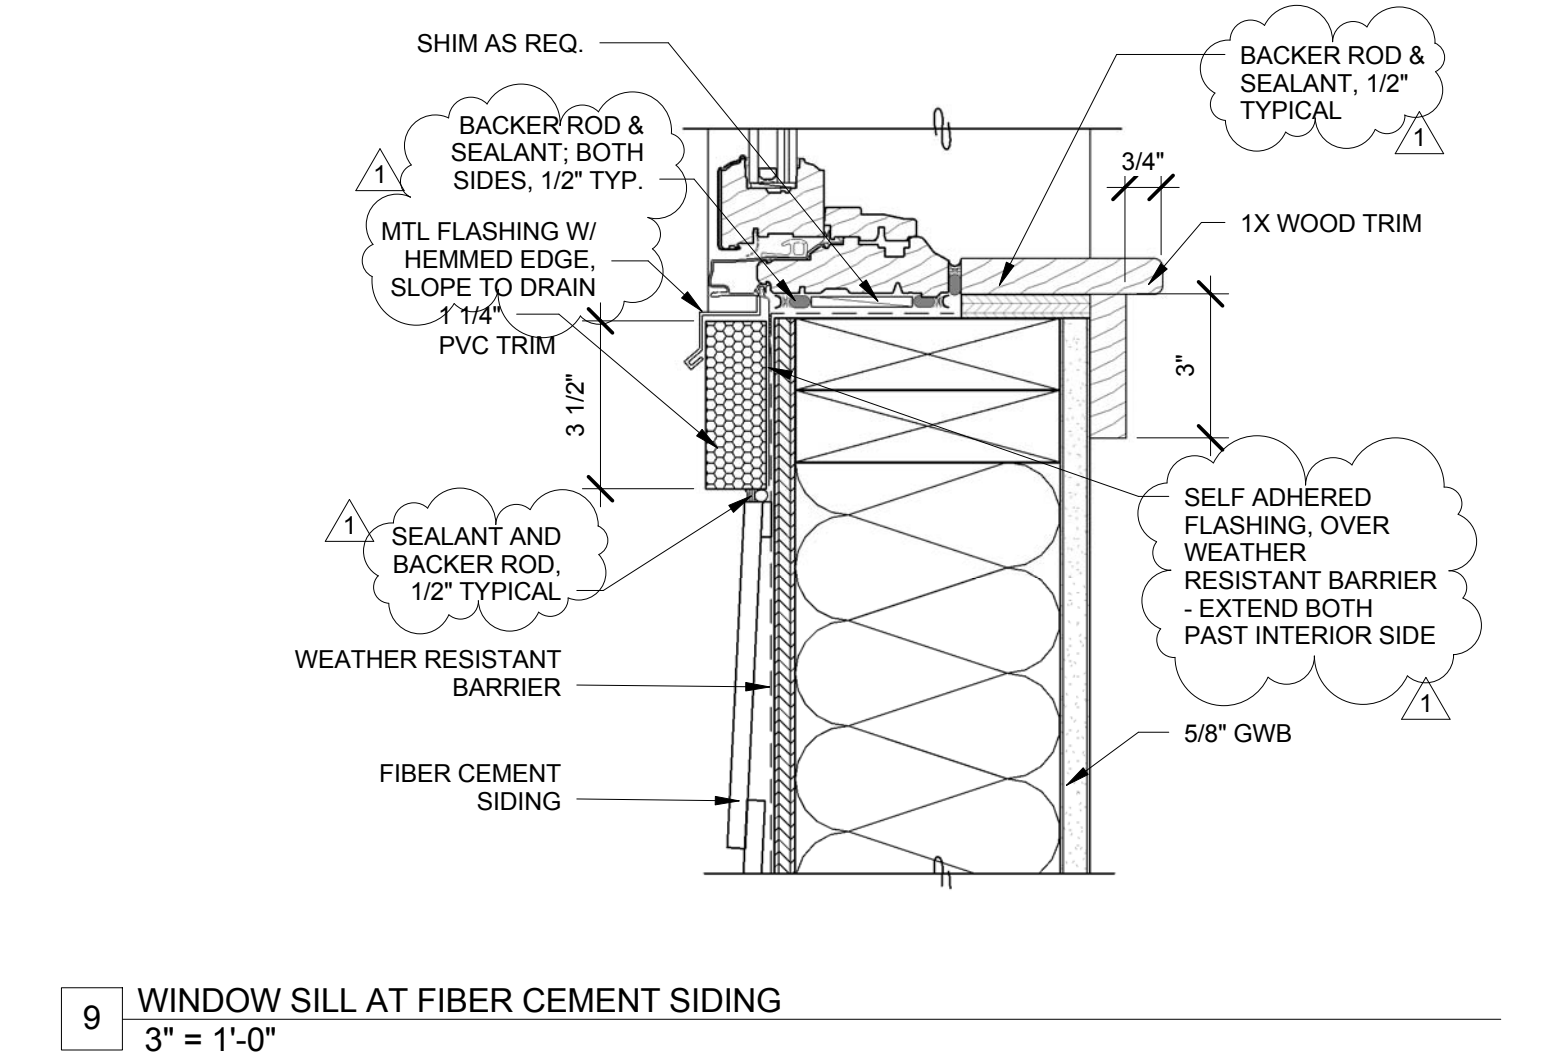
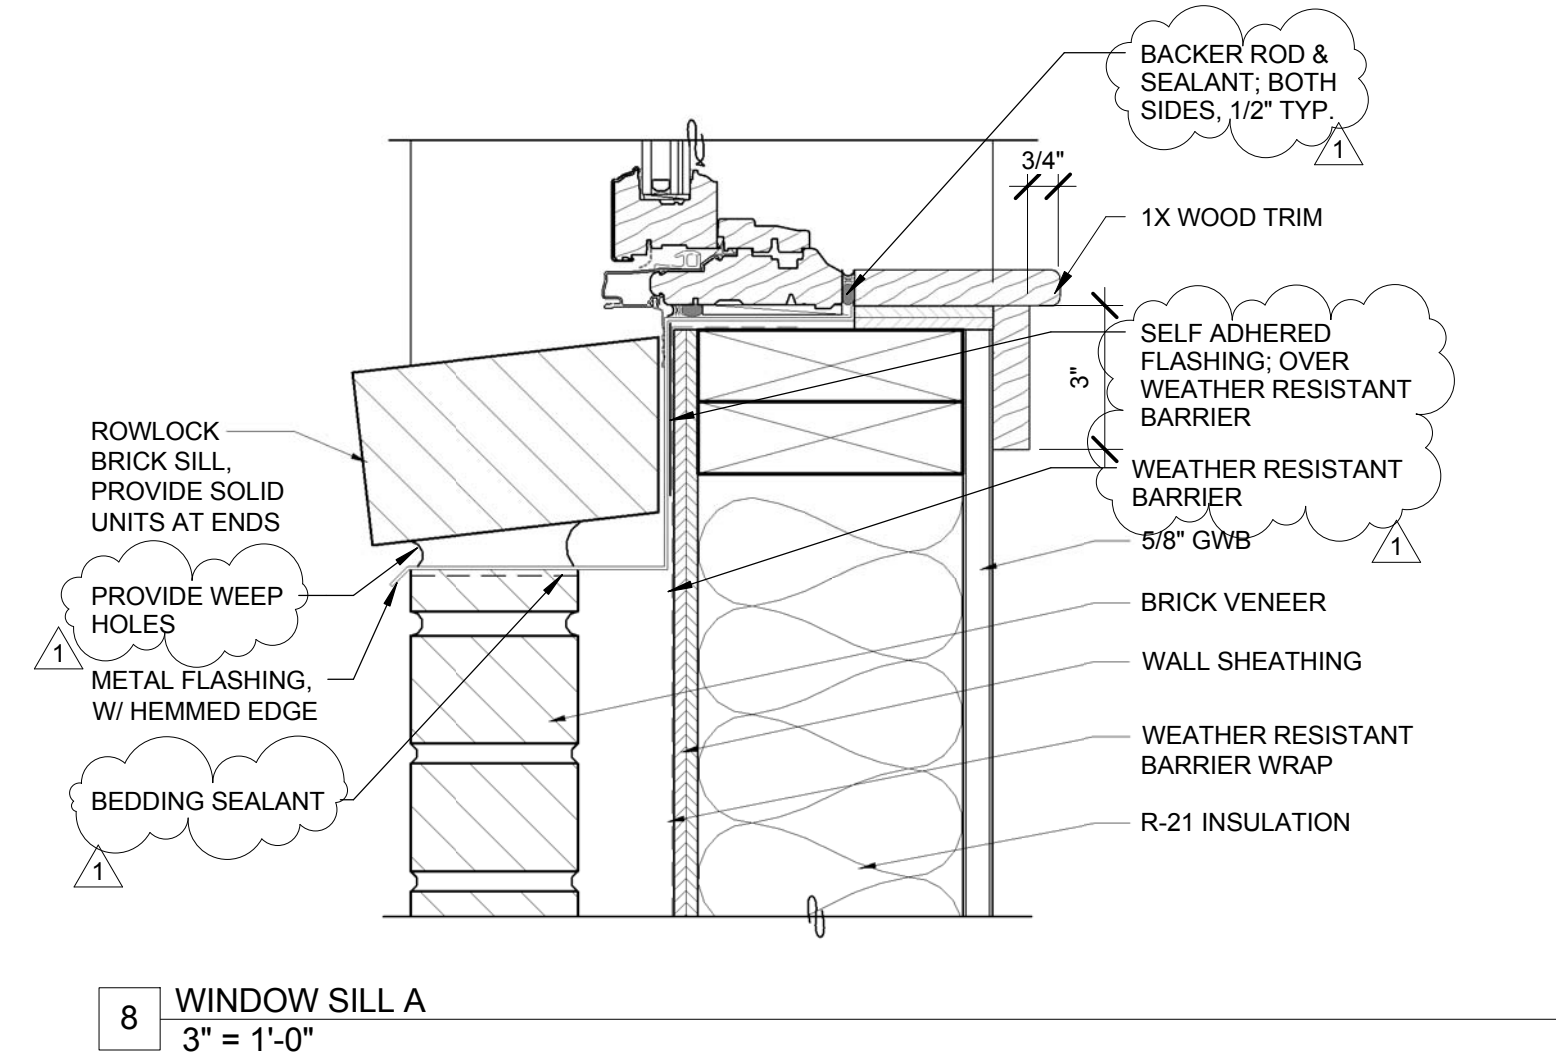
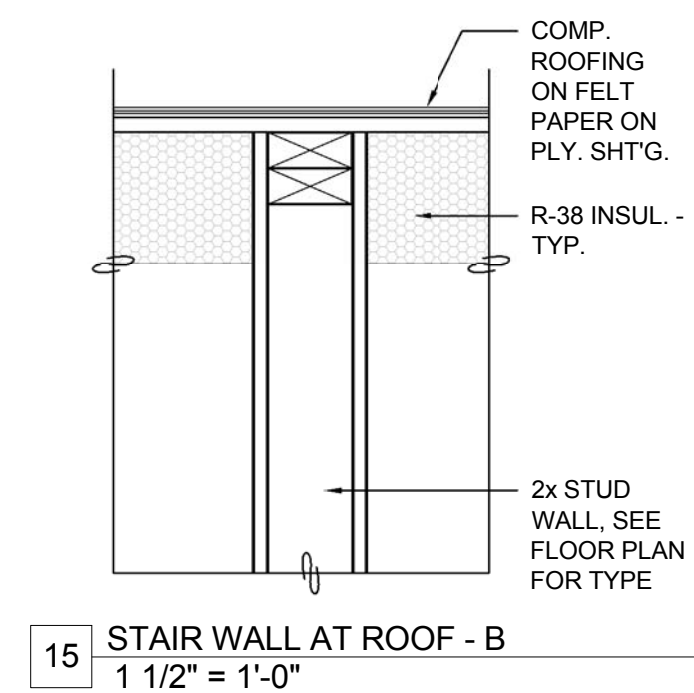
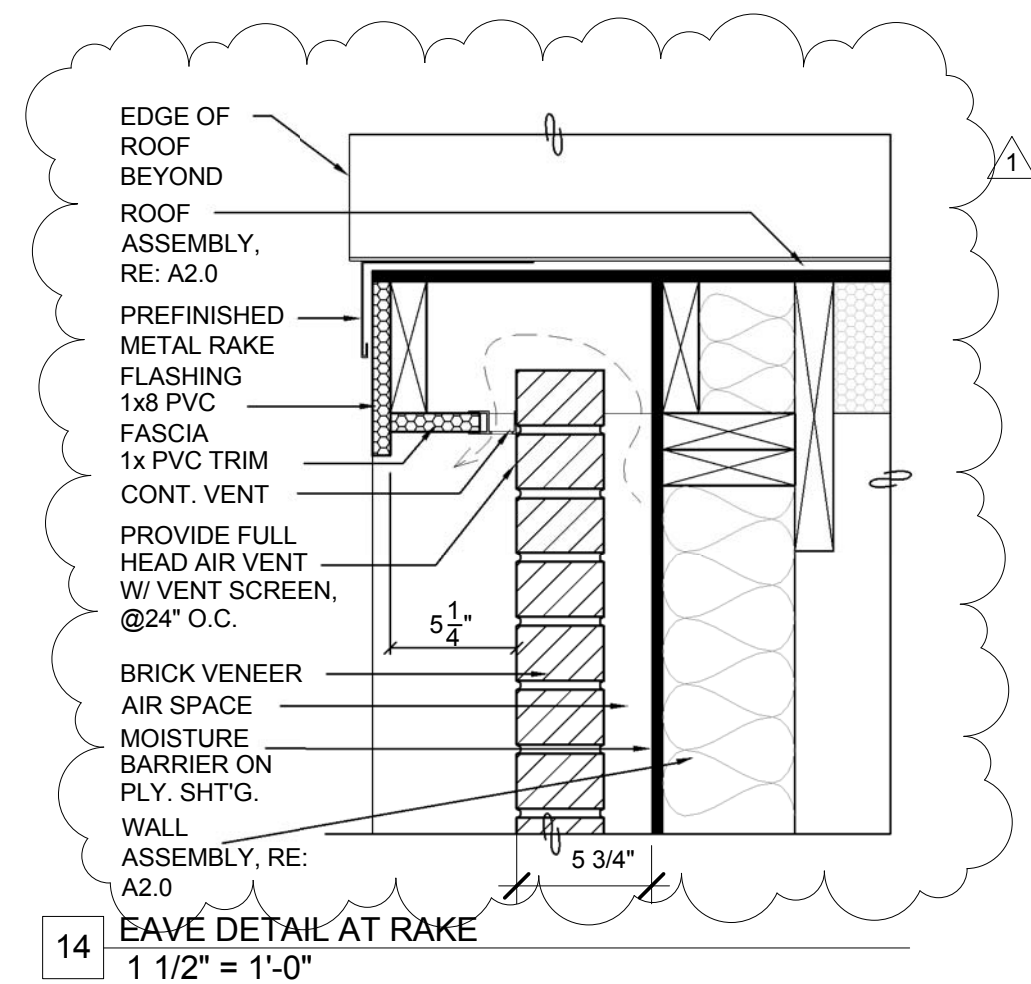
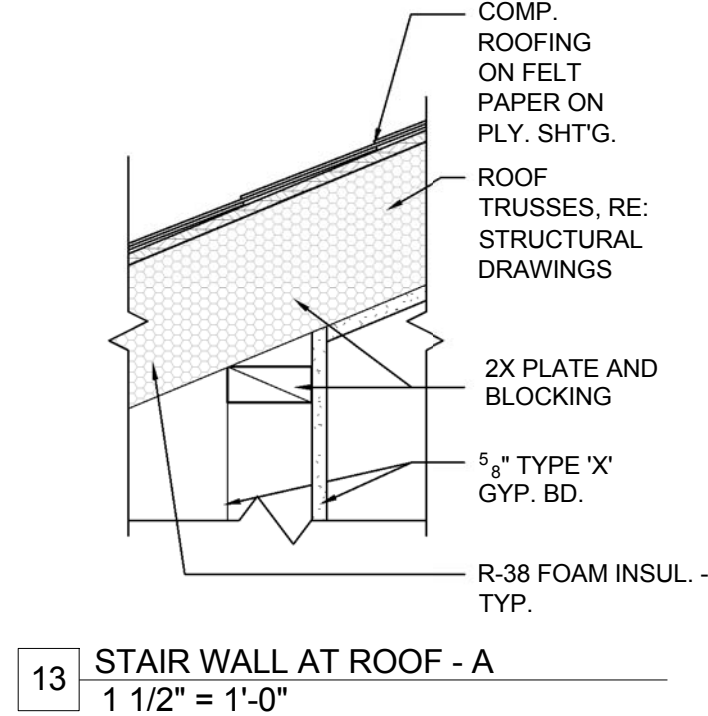
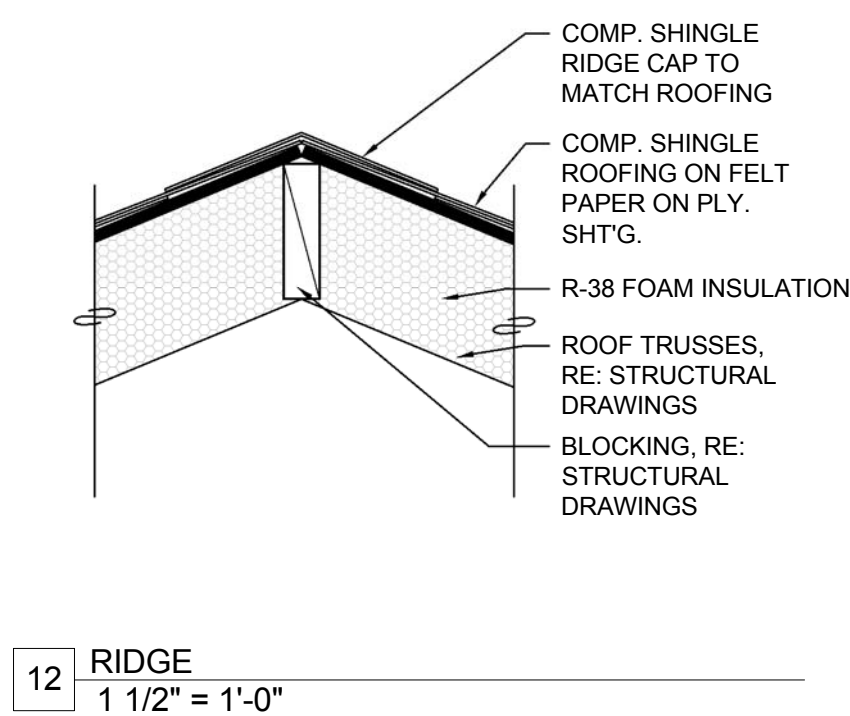
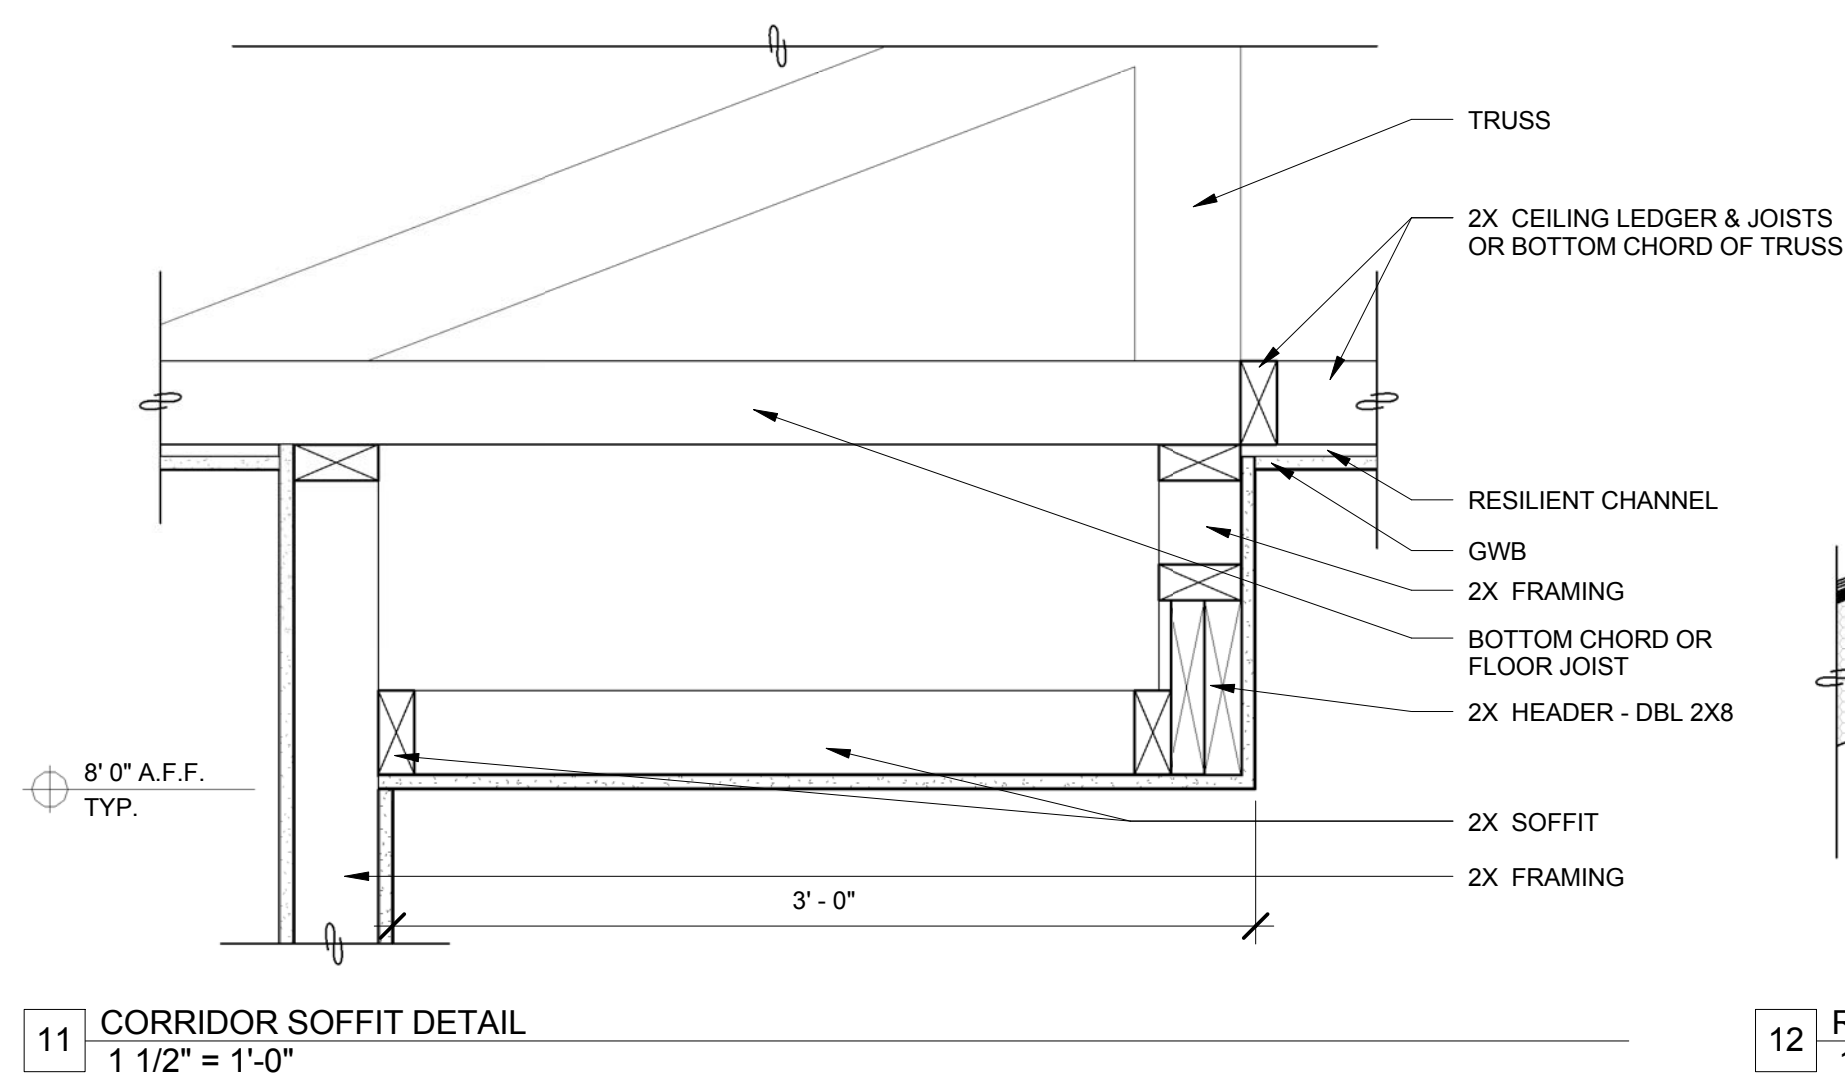
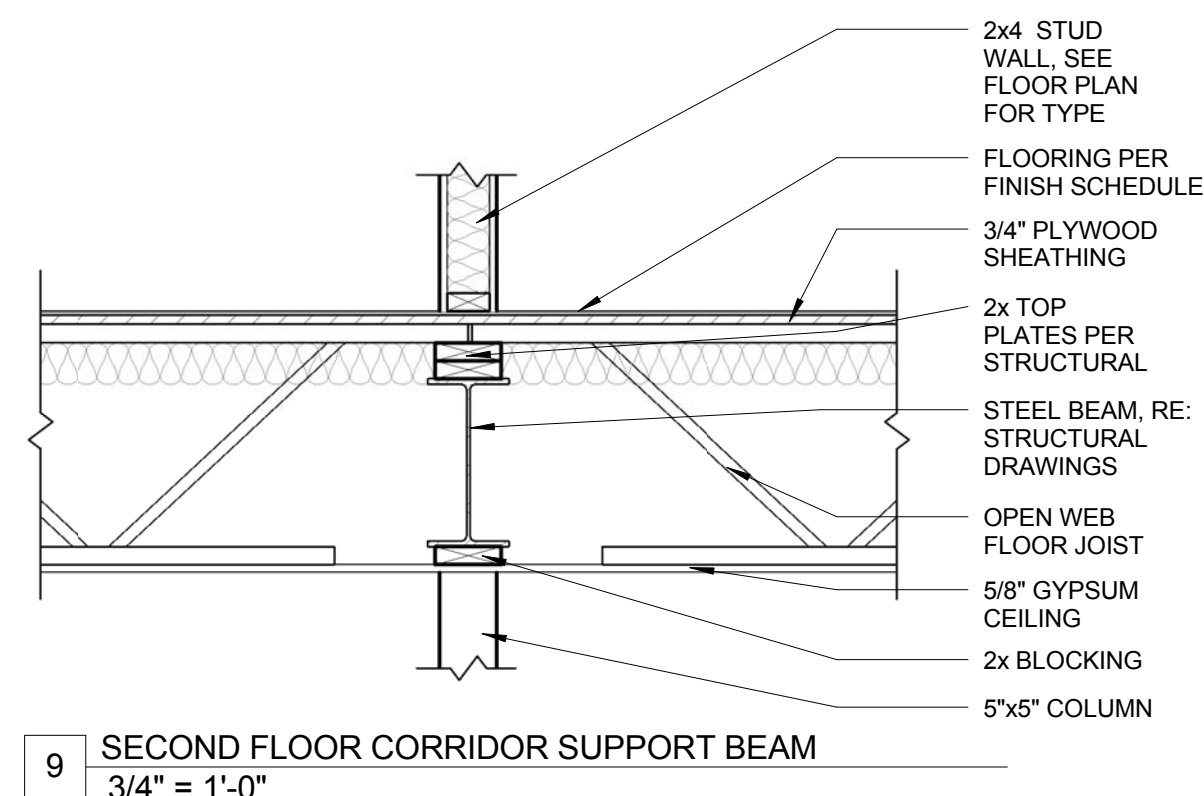
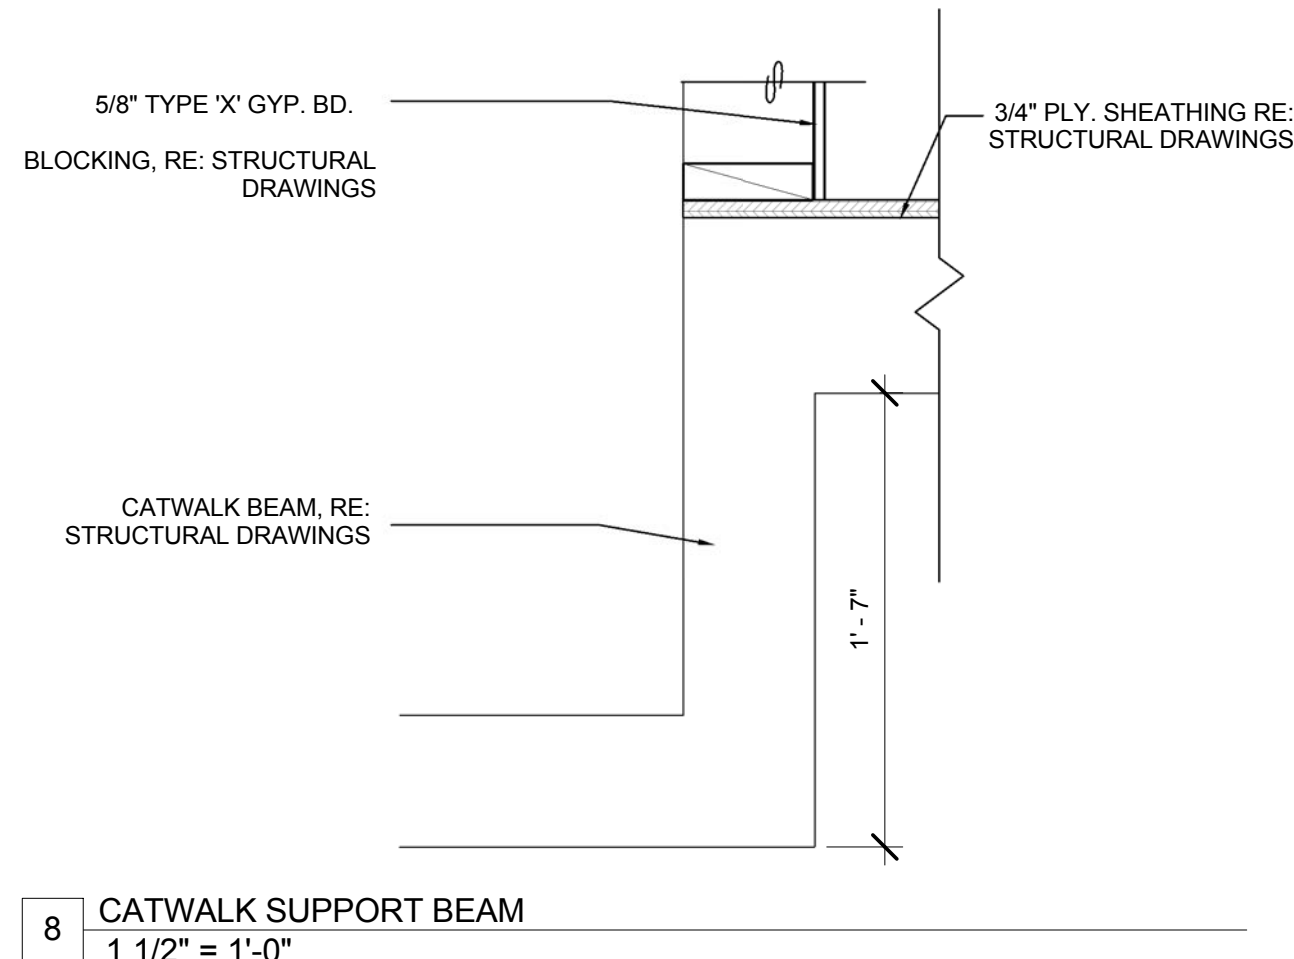
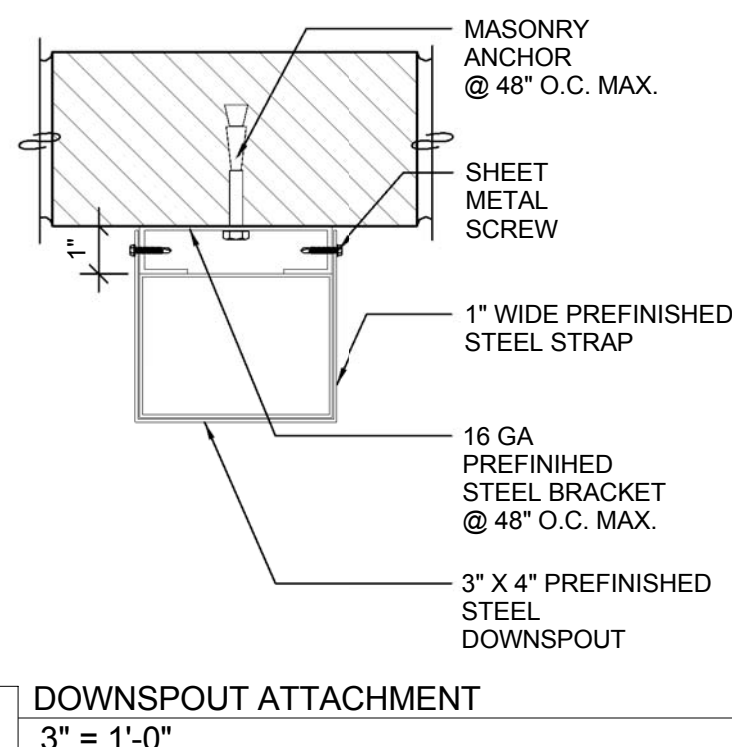
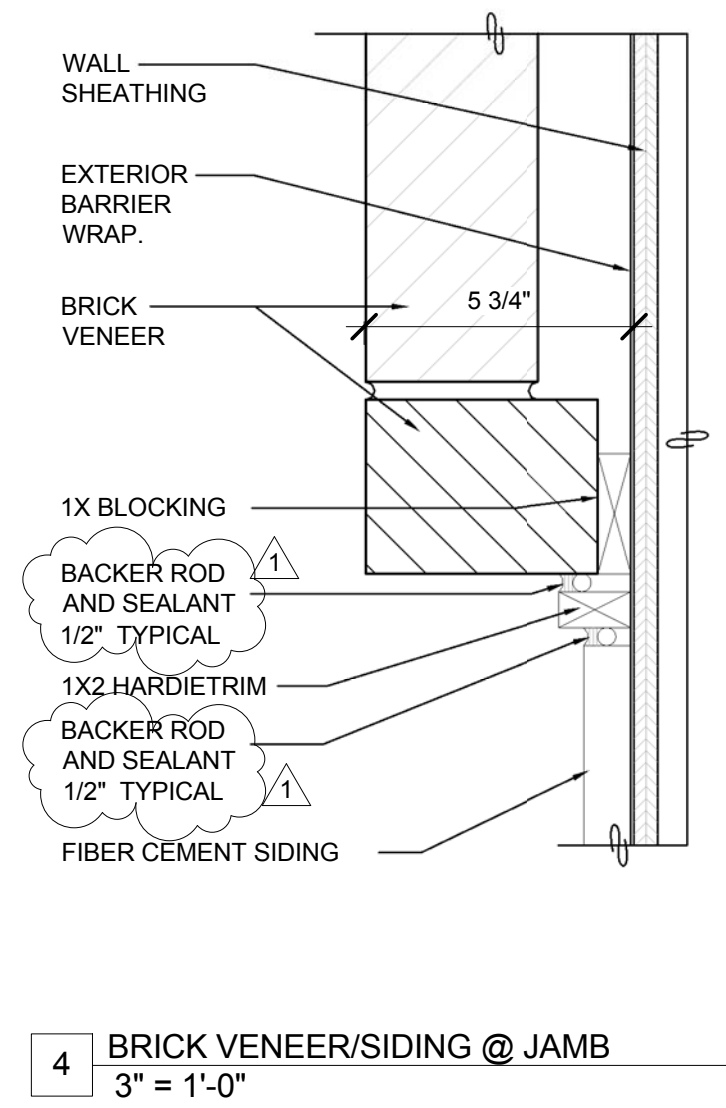
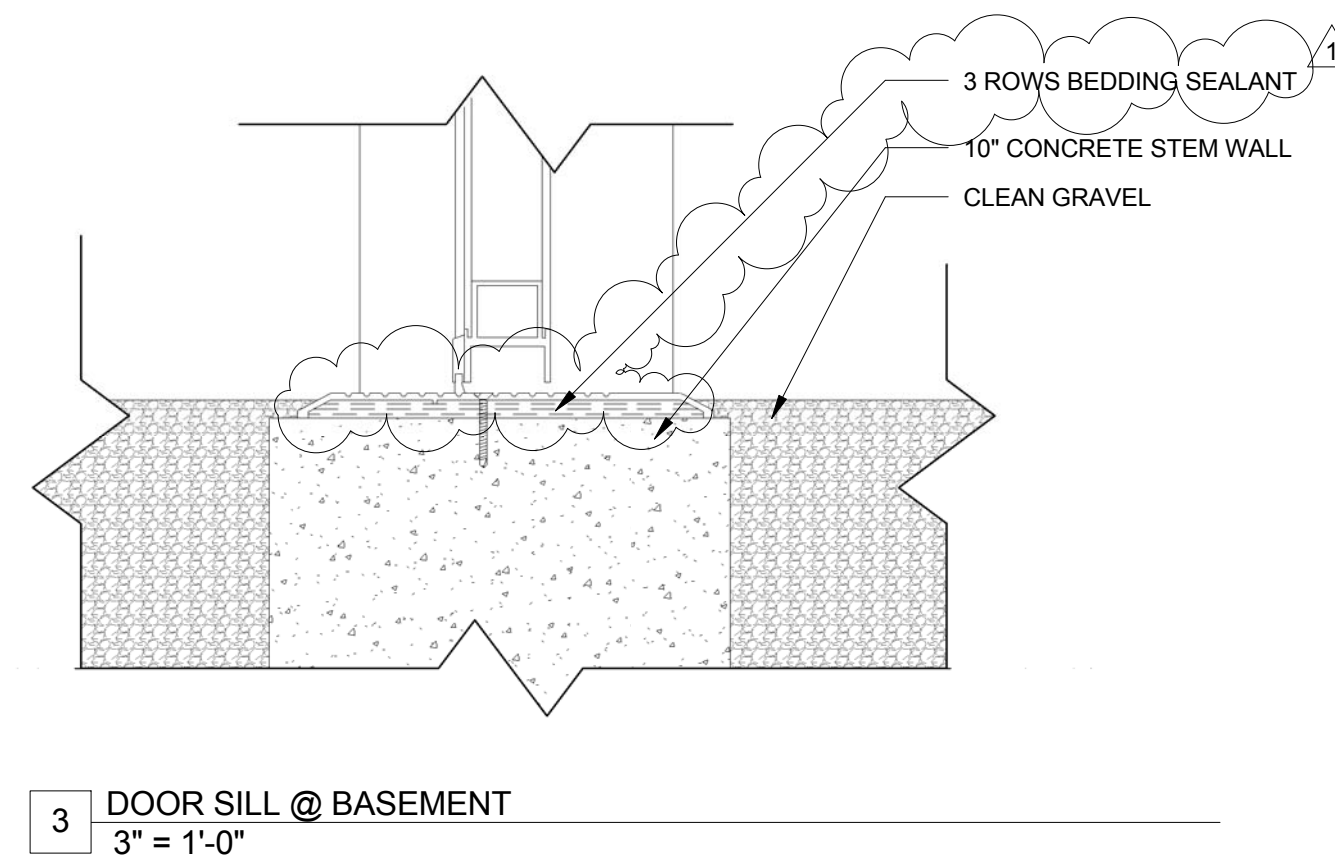


ABBREVIATIONS	
FACT	= FACTORY
F.R.	= FIRE RESISTANT
HM	= HOLLOW METAL, PAINTED
PT	= PAINTED
TEMP	= TEMPERED
ALUM	= ALUMINUM

WINDOW SCHEDULE										
MARK	SIZE		WINDOW ELEVATION	GLAZING	FRAME		HEAD	DETAILS		NOTES
	WIDTH	HEIGHT			MATERIAL	FINISH		JAMB	SILL	
A	3' - 6"	5' - 6"	1	LAMINATED	ALUM CLAD	FACT/WHITE	1/A3.3	5/A3.3, 6/A3.3	7/A3.3	
B	2' - 6"	4' - 9"	2	LAMINATED	ALUM CLAD	FACT/WHITE	4/A3.3	5/A3.3, 6/A3.3	7/A3.3	
C	2' - 6"	1' - 3"	3	LAMINATED	ALUM CLAD	FACT/WHITE	3/A3.3	5/A3.3, 6/A3.3	4/A3.3	
D	3' - 2"	4' - 9"	4	LAMINATED	ALUM CLAD	FACT/WHITE	4/A3.3	5/A3.3, 6/A3.3	7/A3.3	
E	3' - 2"	1' - 3"	5	LAMINATED	ALUM CLAD	FACT/WHITE	3/A3.3	5/A3.3, 6/A3.3	4/A3.3	
G	2' - 6"	5' - 2"	6	LAMINATED	ALUM CLAD	FACT/WHITE	2/A3.3	5/A3.3, 6/A3.3	8/A3.3	
H	3' - 2"	5' - 2"	7	LAMINATED	ALUM CLAD	FACT/WHITE	2/A3.3	5/A3.3, 6/A3.3	8/A3.3	
I	4' - 0"	4' - 0"	8	LAMINATED	WOOD	FACT	10/A3.3	10/A3.3	10/A3.3	FROSTED GLASS

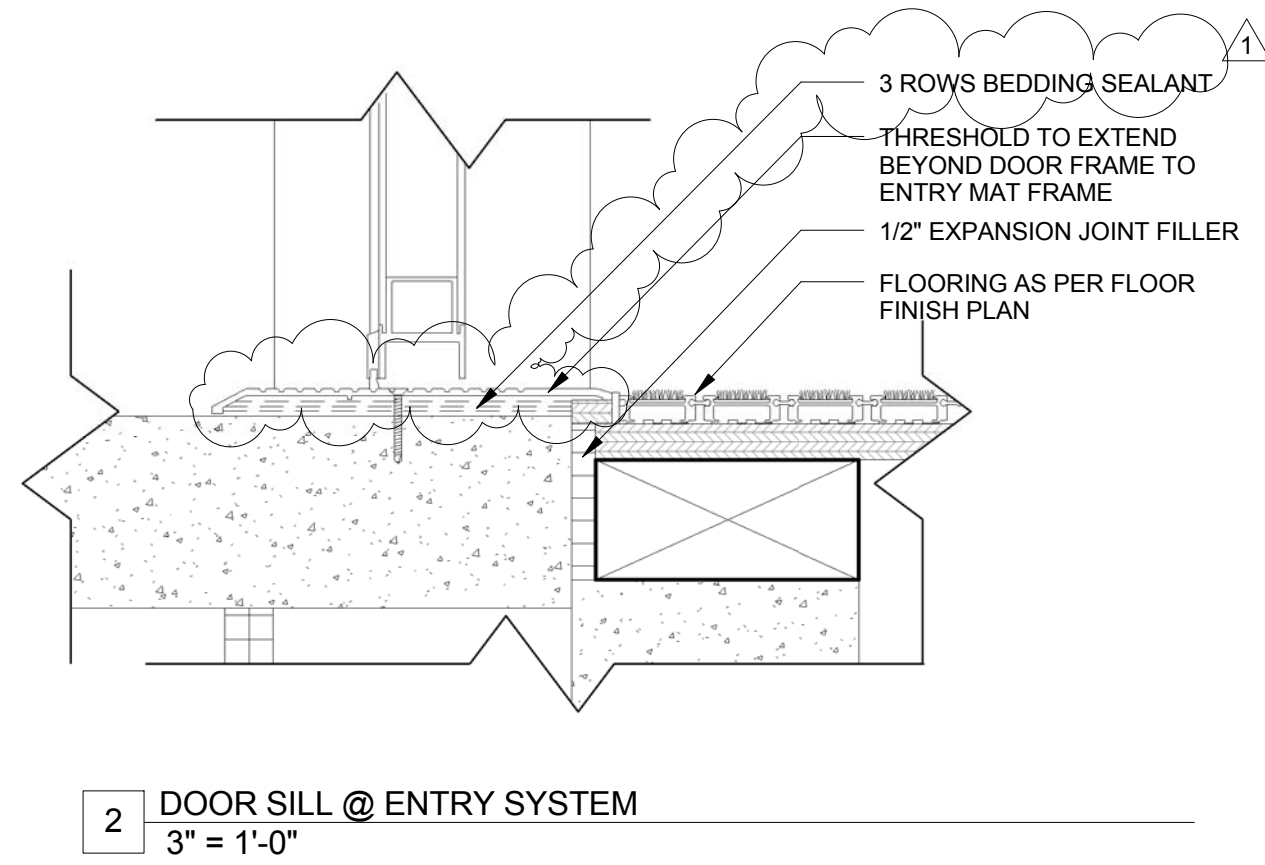

<table><tr><th>REVISIONS</th><th>DATE</th></tr><tr><td>△ ENVELOPE REVIEW</td><td>03/01/17</td></tr><tr><td> </td><td> </td></tr><tr><td> </td><td> </td></tr><tr><td> </td><td> </td></tr><tr><td> </td><td> </td></tr><tr><td> </td><td> </td></tr><tr><td> </td><td> </td></tr></table>	REVISIONS	DATE	△ ENVELOPE REVIEW	03/01/17													CONSULTANTS	<table><tr><td>REGISTERED ARCHITECT RICHARD J. SHUGAR EUGENE, OREGON STATE OF OREGON</td><td>ARCHITECT 2form ARCHITECTURE</td></tr></table>	REGISTERED ARCHITECT RICHARD J. SHUGAR EUGENE, OREGON STATE OF OREGON	ARCHITECT 2form ARCHITECTURE	<table><tr><td colspan="2">DRAWING TITLE WINDOW DETAILS & SCHEDULE</td></tr><tr><td colspan="2">APPROVED PROJECT DIRECTOR BEN SUTTER, CONTRACTING OFFICER REPRESENTATIVE</td></tr></table>	DRAWING TITLE WINDOW DETAILS & SCHEDULE		APPROVED PROJECT DIRECTOR BEN SUTTER, CONTRACTING OFFICER REPRESENTATIVE		<table><tr><td colspan="2">PROJECT TITLE VA SORCC: REPLACE BUILDING 207</td></tr><tr><td>LOCATION VA SORCC WHITE CITY OREGON</td><td>DATE 08.18.16</td></tr><tr><td>DRAWN BY 2FORM STAFF</td><td>CHECKED BY JOSH HILTON</td></tr></table>	PROJECT TITLE VA SORCC: REPLACE BUILDING 207		LOCATION VA SORCC WHITE CITY OREGON	DATE 08.18.16	DRAWN BY 2FORM STAFF	CHECKED BY JOSH HILTON	<table><tr><td>PROJECT NUMBER 692-346</td></tr><tr><td>BUILDING NUMBER 207</td></tr><tr><td>DRAWING NUMBER A3.3</td></tr><tr><td>DWG 24 OF 56</td></tr></table>	PROJECT NUMBER 692-346	BUILDING NUMBER 207	DRAWING NUMBER A3.3	DWG 24 OF 56	OFFICE OF CONSTRUCTION AND FACILITIES MANAGEMENT Department of Veterans Affairs
REVISIONS	DATE																																					
△ ENVELOPE REVIEW	03/01/17																																					
REGISTERED ARCHITECT RICHARD J. SHUGAR EUGENE, OREGON STATE OF OREGON	ARCHITECT 2form ARCHITECTURE																																					
DRAWING TITLE WINDOW DETAILS & SCHEDULE																																						
APPROVED PROJECT DIRECTOR BEN SUTTER, CONTRACTING OFFICER REPRESENTATIVE																																						
PROJECT TITLE VA SORCC: REPLACE BUILDING 207																																						
LOCATION VA SORCC WHITE CITY OREGON	DATE 08.18.16																																					
DRAWN BY 2FORM STAFF	CHECKED BY JOSH HILTON																																					
PROJECT NUMBER 692-346																																						
BUILDING NUMBER 207																																						
DRAWING NUMBER A3.3																																						
DWG 24 OF 56																																						

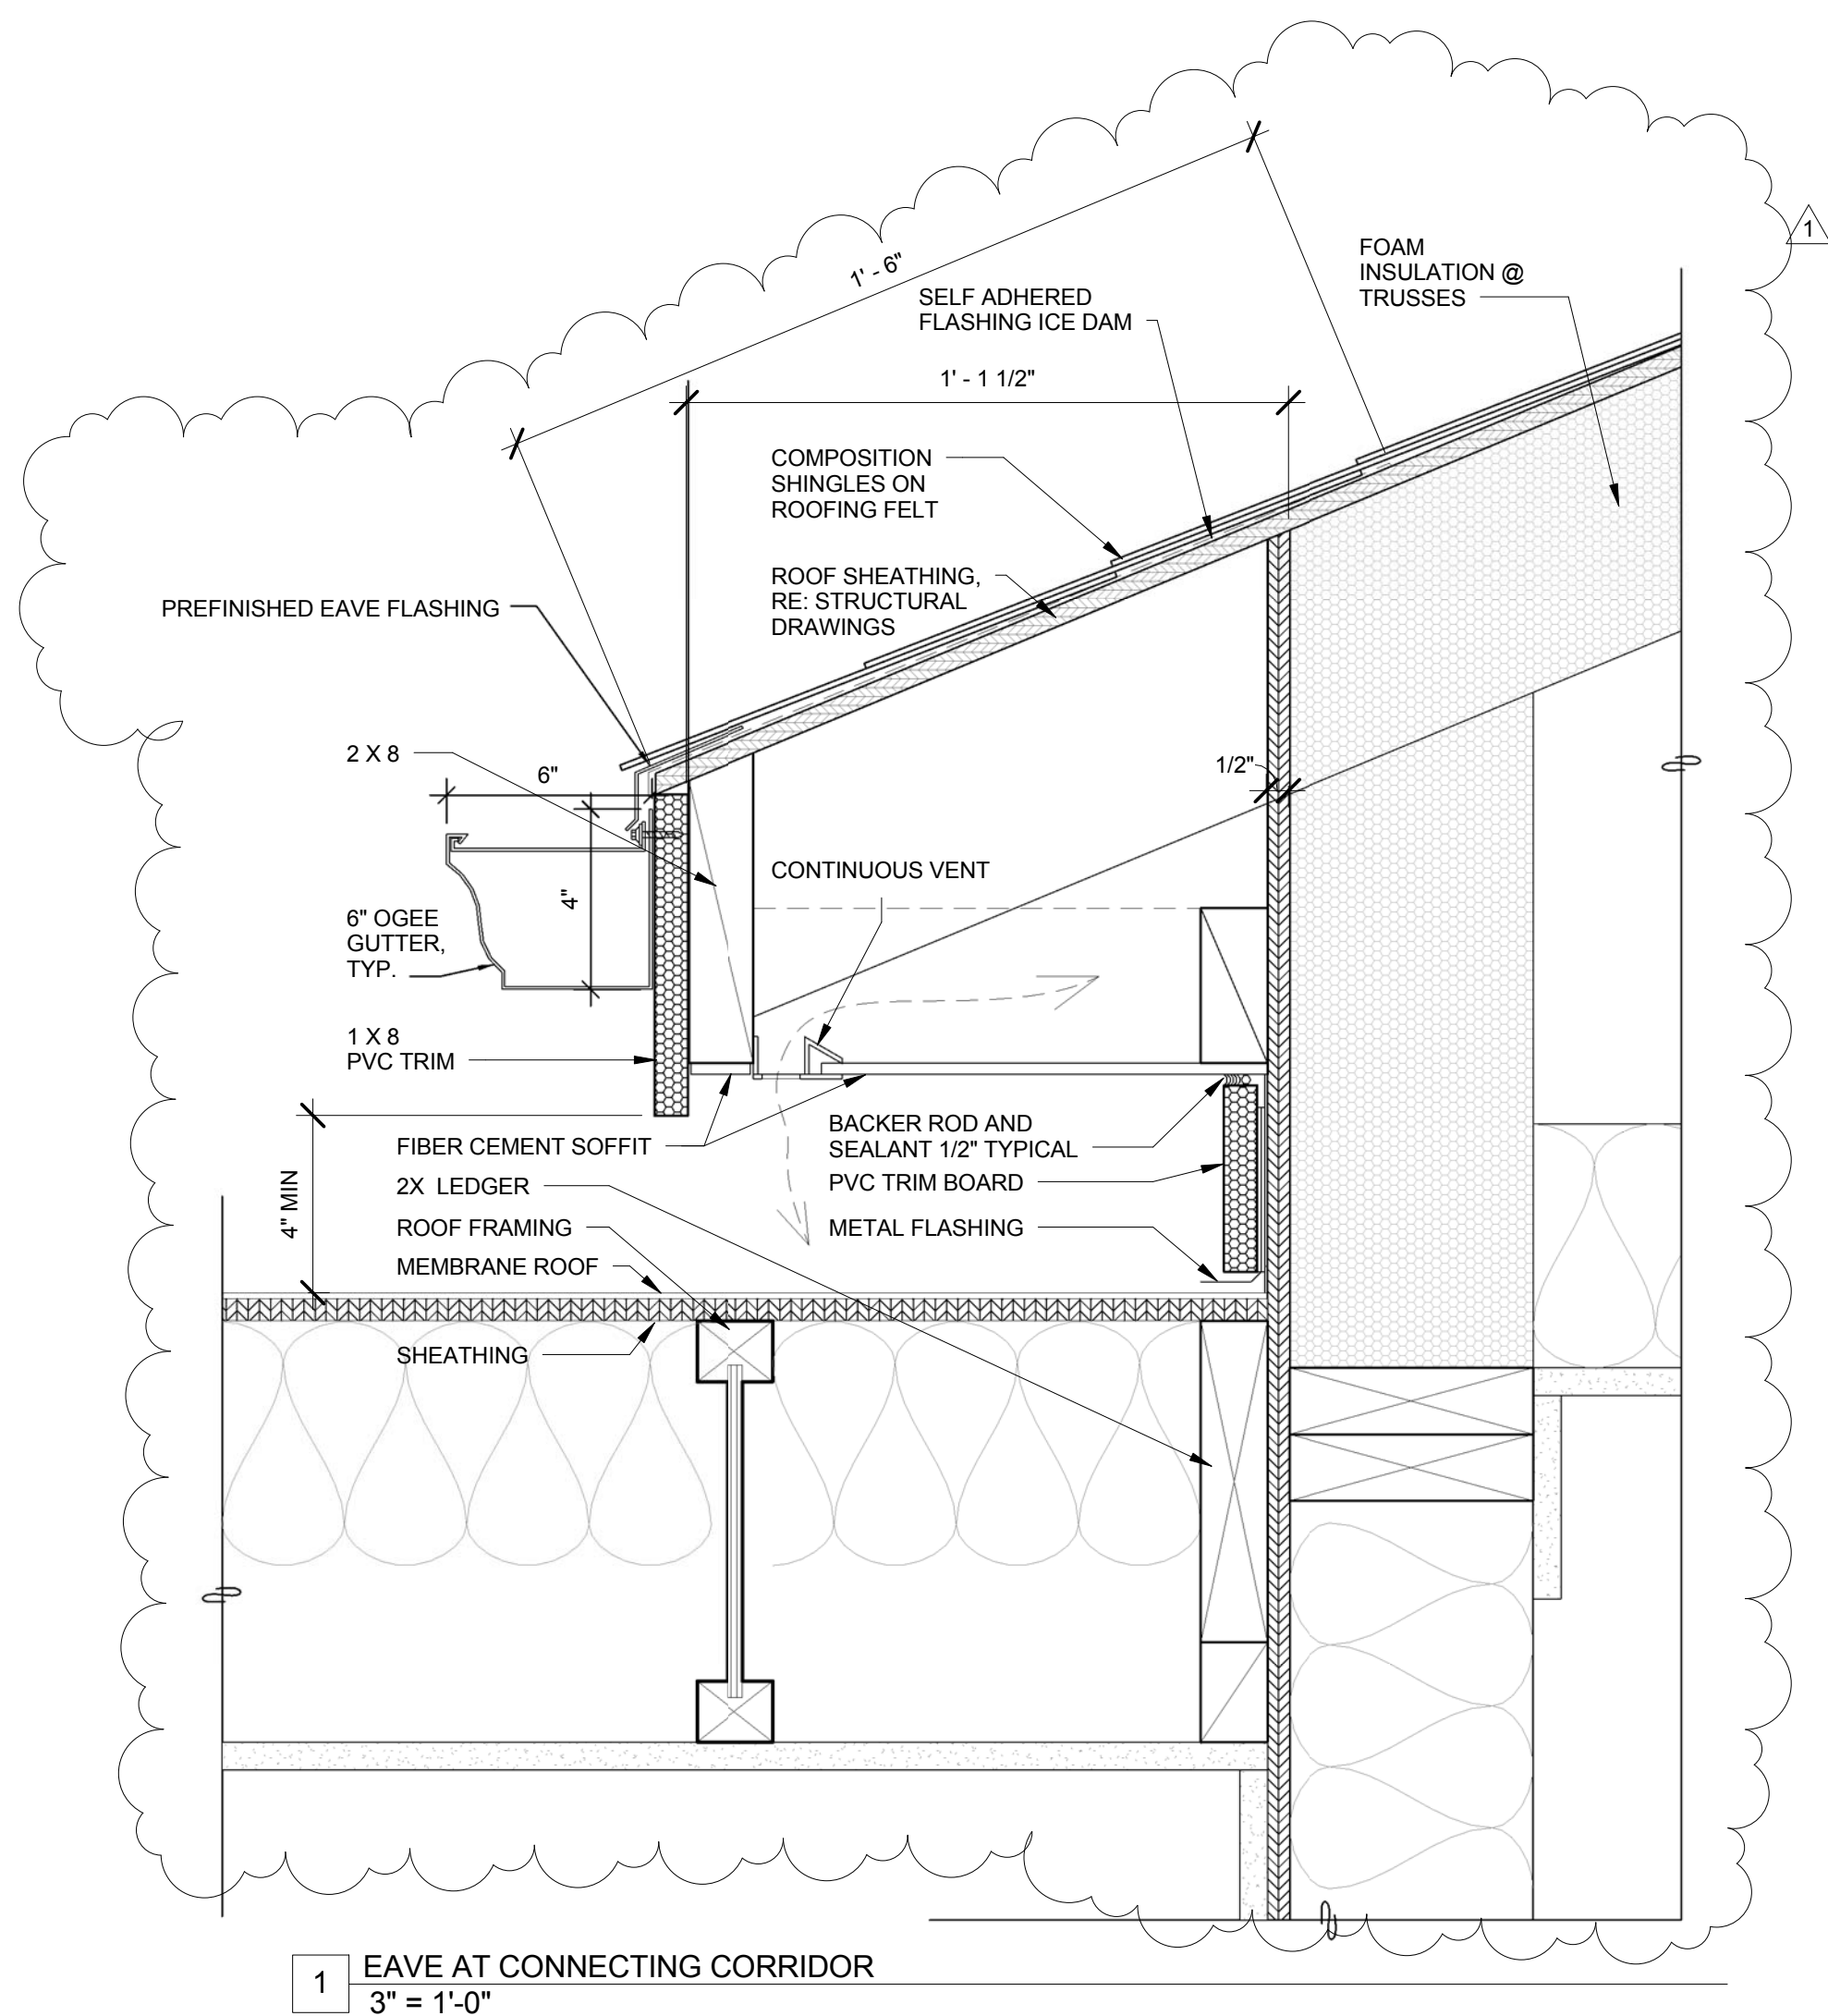

REVISIONS	DATE
△ ENVELOPE REVIEW	03/01/17

CONSULTANTS






DRAWING TITLE
DETAILS
APPROVED PROJECT DIRECTOR
BEN SUTTER, CONTRACTING OFFICER REPRESENTATIVE

PROJECT TITLE
VA SORCC: REPLACE BUILDING 207
LOCATION
VA SORCC WHITE CITY OREGON
DATE
08.18.16
DRAWN BY
2FORM STAFF
CHECKED BY
JOSH HILTON

PROJECT NUMBER
692-346
BUILDING NUMBER
207
DRAWING NUMBER
A10.1
DWG 53 OF 56



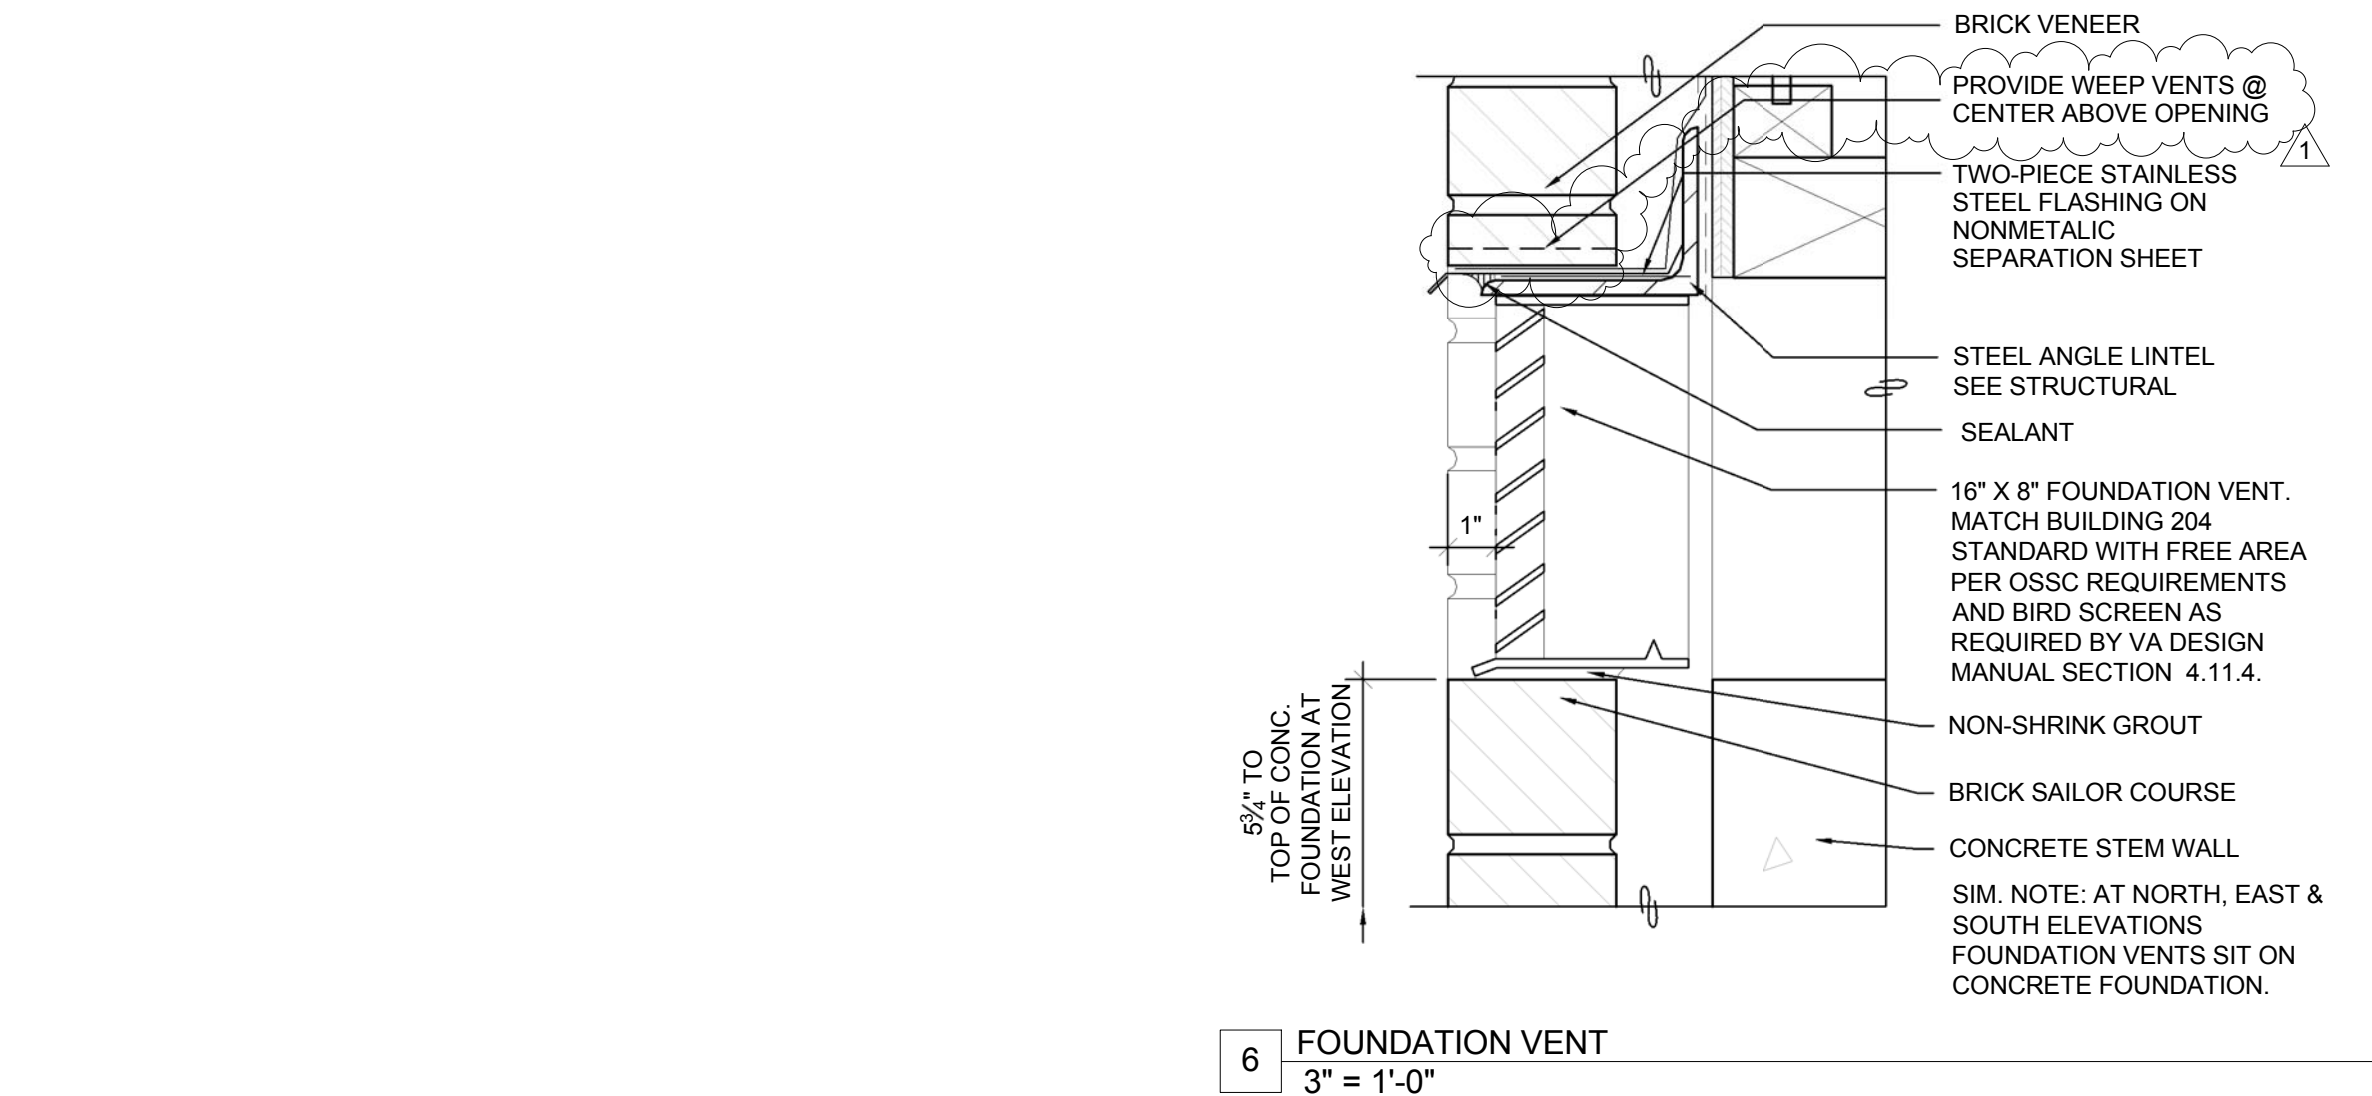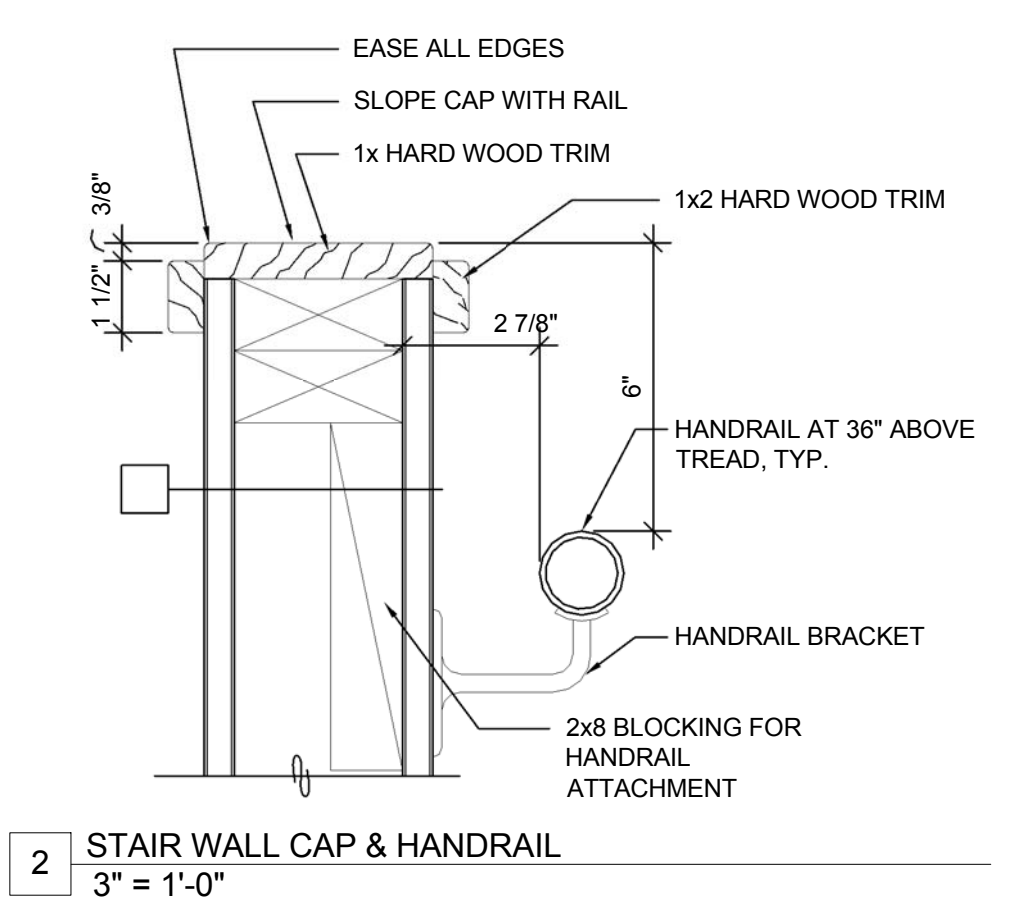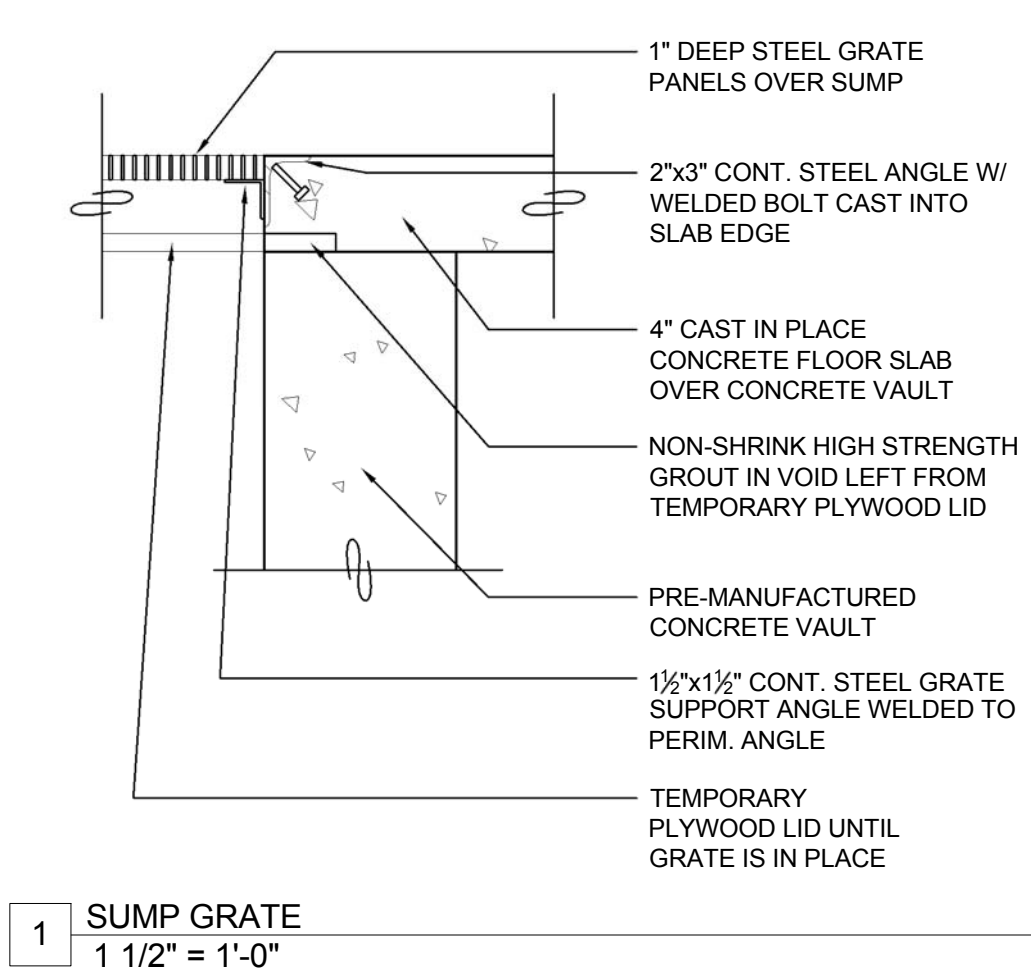

REVISIONS	DATE
△ ENVELOPE REVIEW	03/01/17

CONSULTANTS



P 541.345.6777
F 541.345.6128
WWW.2-FORM.COM
131 Lawrence St.
Eugene, OR 97401

DRAWING TITLE
MISCELLANEOUS DETAILS
APPROVED PROJECT DIRECTOR
BEN SUTTER, CONTRACTING OFFICER REPRESENTATIVE

PROJECT TITLE
VA SORCC: REPLACE BUILDING 207
LOCATION
VA SORCC WHITE CITY OREGON
DATE
08.18.16
DRAWN BY
2FORM STAFF
CHECKED BY
JOSH HILTON

PROJECT NUMBER
692-346
BUILDING NUMBER
207
DRAWING NUMBER
A10.4
DWG 56 OF 56

