




three inches = one foot  
one and one half inches = one foot  
one inch = one foot  
three quarters inch = one foot  
one half inch = one foot  
three eighths inch = one foot  
one quarter inch = one foot  
one eighth inch = one foot

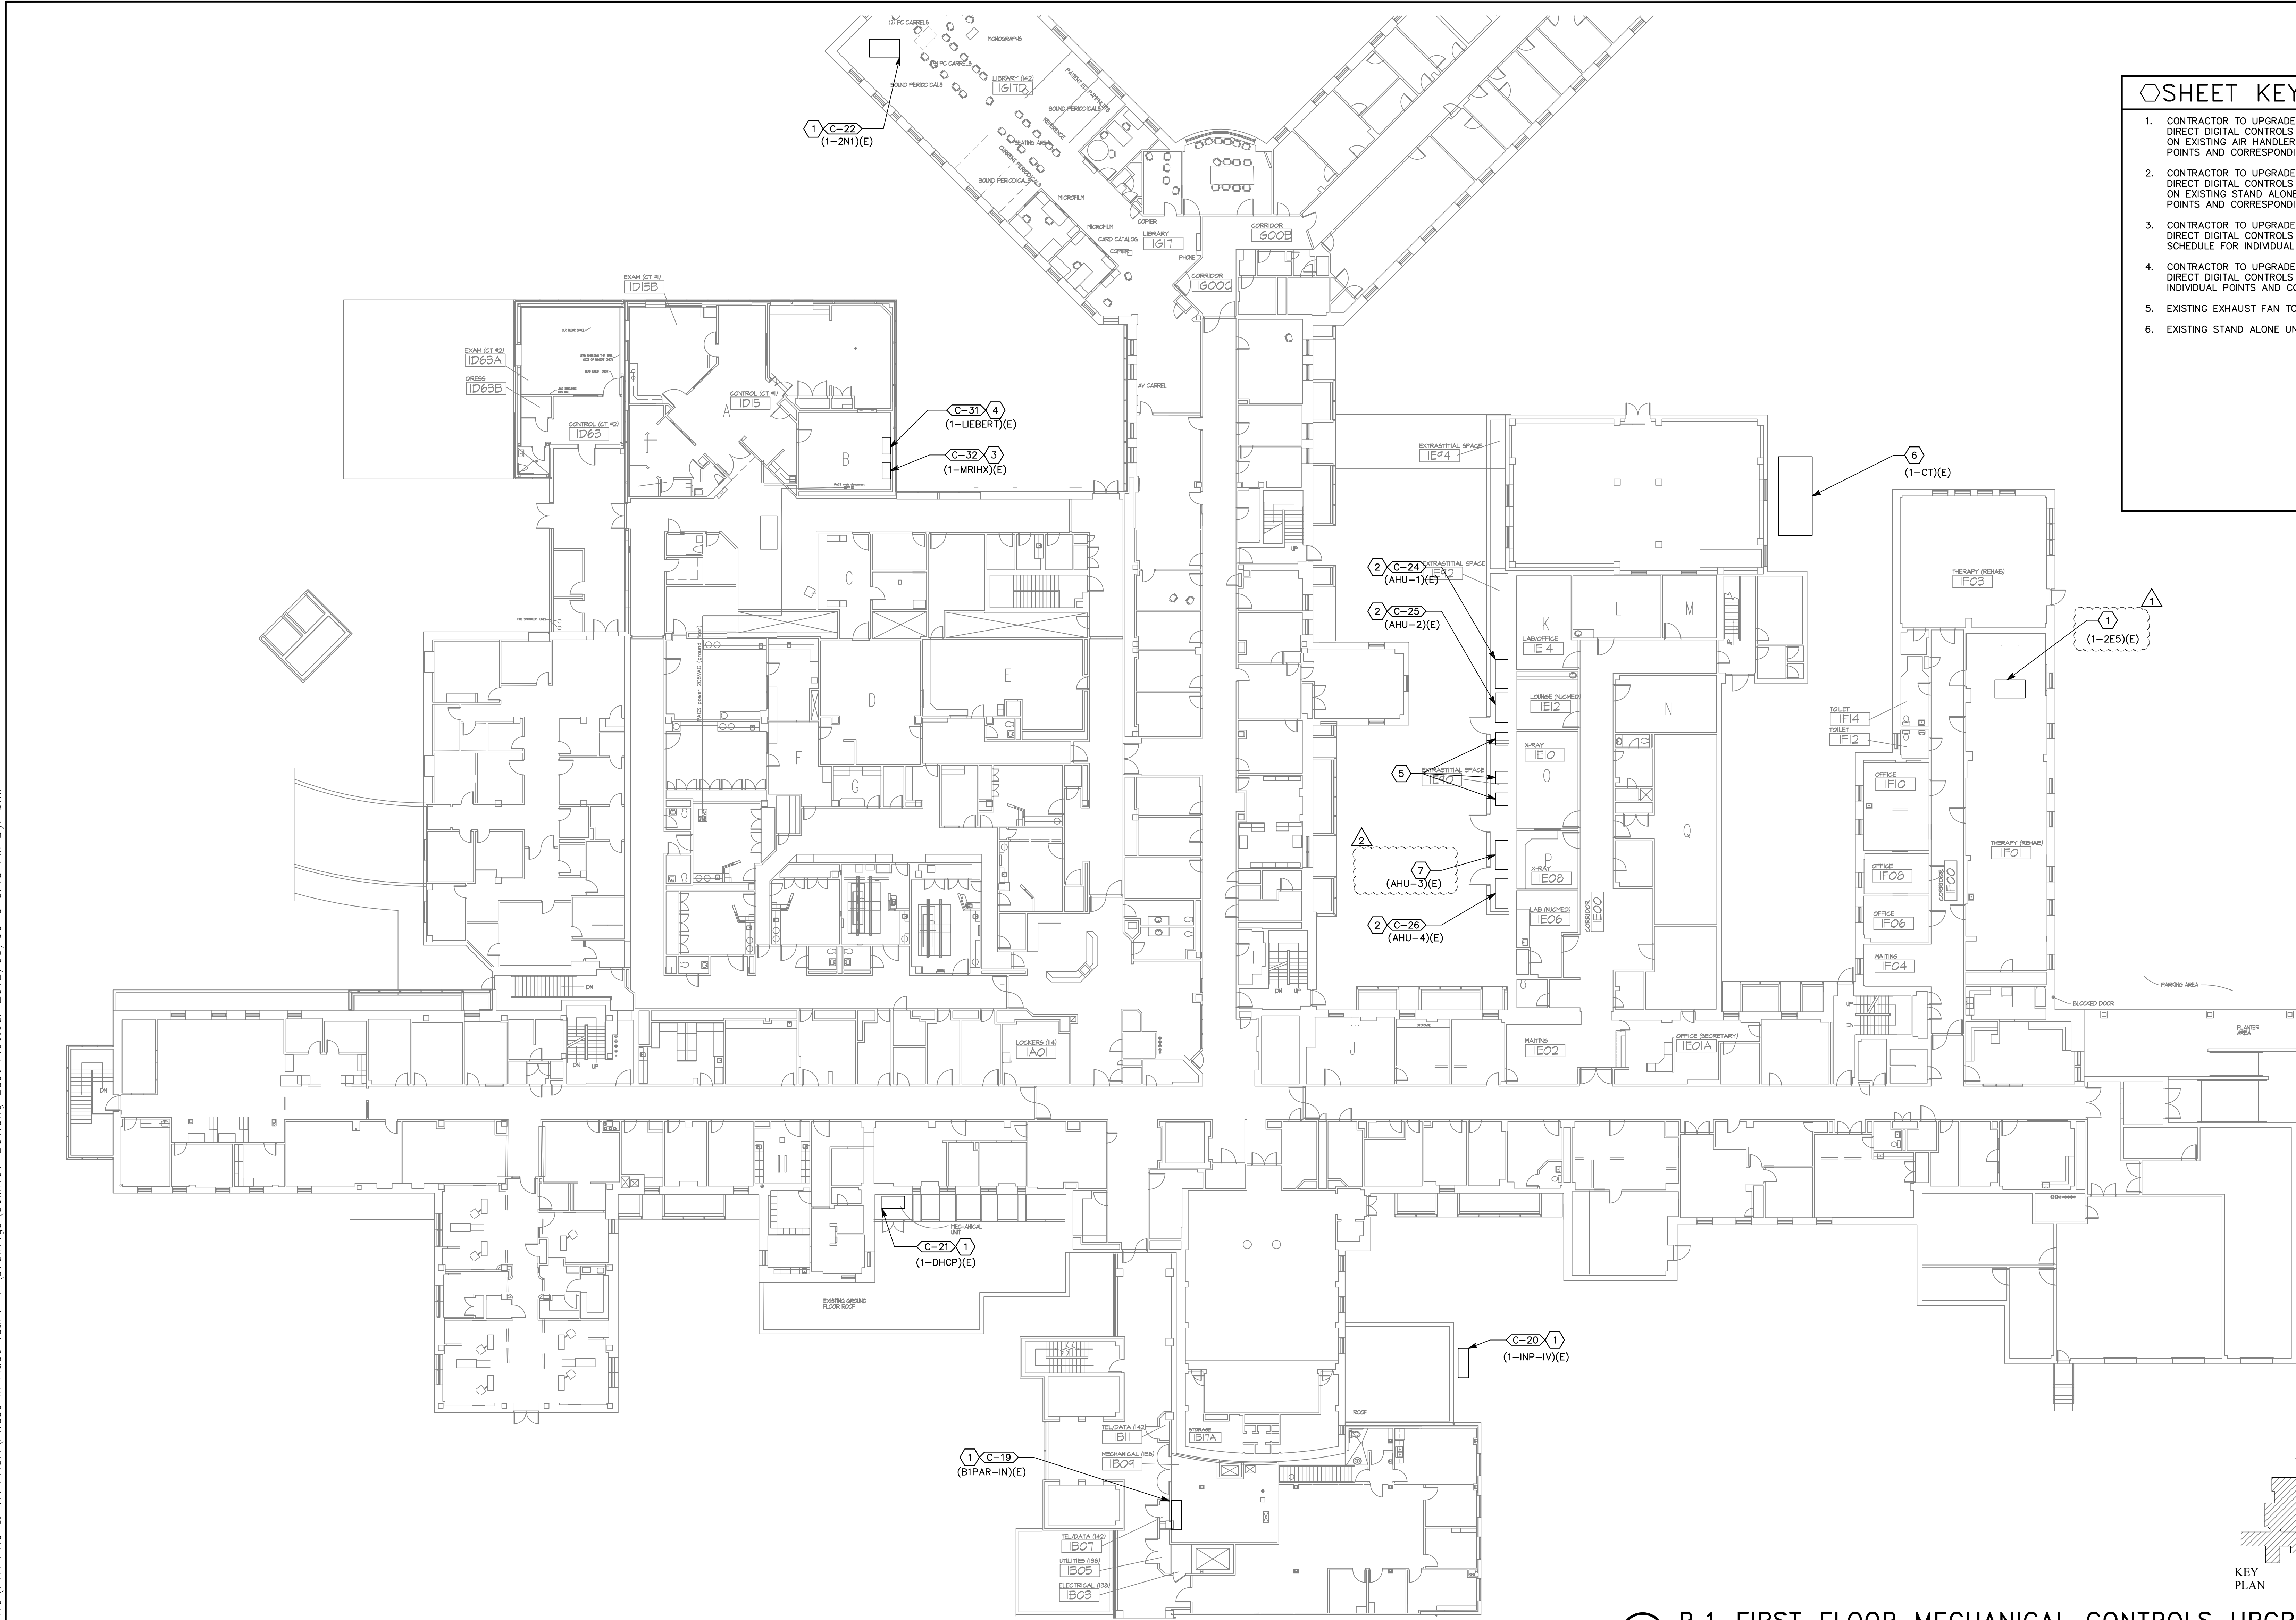

- SHEET KEYNOTES**
1. CONTRACTOR TO UPGRADE EXISTING PNEUMATIC CONTROLS TO DIRECT DIGITAL CONTROLS AND ADD ADDITIONAL CONTROL DEVICES ON EXISTING AIR HANDLER UNIT. SEE SCHEDULE FOR INDIVIDUAL POINTS AND CORRESPONDING DETAILS.
  2. CONTRACTOR TO UPGRADE EXISTING PNEUMATIC CONTROLS TO DIRECT DIGITAL CONTROLS AND ADD ADDITIONAL CONTROL DEVICES ON EXISTING STAND ALONE UNITS. SEE SCHEDULE FOR INDIVIDUAL POINTS AND CORRESPONDING DETAILS.
  3. CONTRACTOR TO UPGRADE EXISTING PNEUMATIC CONTROLS TO DIRECT DIGITAL CONTROLS ON HEAT EXCHANGER UNIT. SEE SCHEDULE FOR INDIVIDUAL POINTS AND CORRESPONDING DETAILS.
  4. CONTRACTOR TO UPGRADE EXISTING PNEUMATIC CONTROLS TO DIRECT DIGITAL CONTROLS ON LIEBERT UNIT. SEE SCHEDULE FOR INDIVIDUAL POINTS AND CORRESPONDING DETAILS.
  5. EXISTING EXHAUST FAN TO REMAIN.
  6. EXISTING STAND ALONE UNIT TO REMAIN.

**1 B.1 FIRST FLOOR MECHANICAL CONTROLS UPGRADE PLAN**  
SCALE: 1/16"=1'-0"

		CONSULTANTS:		ARCHITECT/ENGINEERS:	<div><div>324 S. State St., Suite 400 Salt Lake City, UT 84111 800-678-7077 801-328-5151 fax: 801-328-5155 www.spectrum-engineers.com</div></div>	Drawing Title	Project Number	Office of Construction and Facilities Management	
						B.1 FIRST FLOOR MECHANICAL CONTROLS UPGRADE PLAN	METASYS CONTROLS AND ENERGY UPGRADE PHASE III ADDENDUM A		660-12-110
						Approved: Project Director	Building Number		
							B.1		
							Drawing Number		
							MI101-B01		
 ADDENDUM B	05/03/2012							Department of Veterans Affairs	
Revisions: REVISION 1	JUNE 22						Dwg. 6 of 14		