



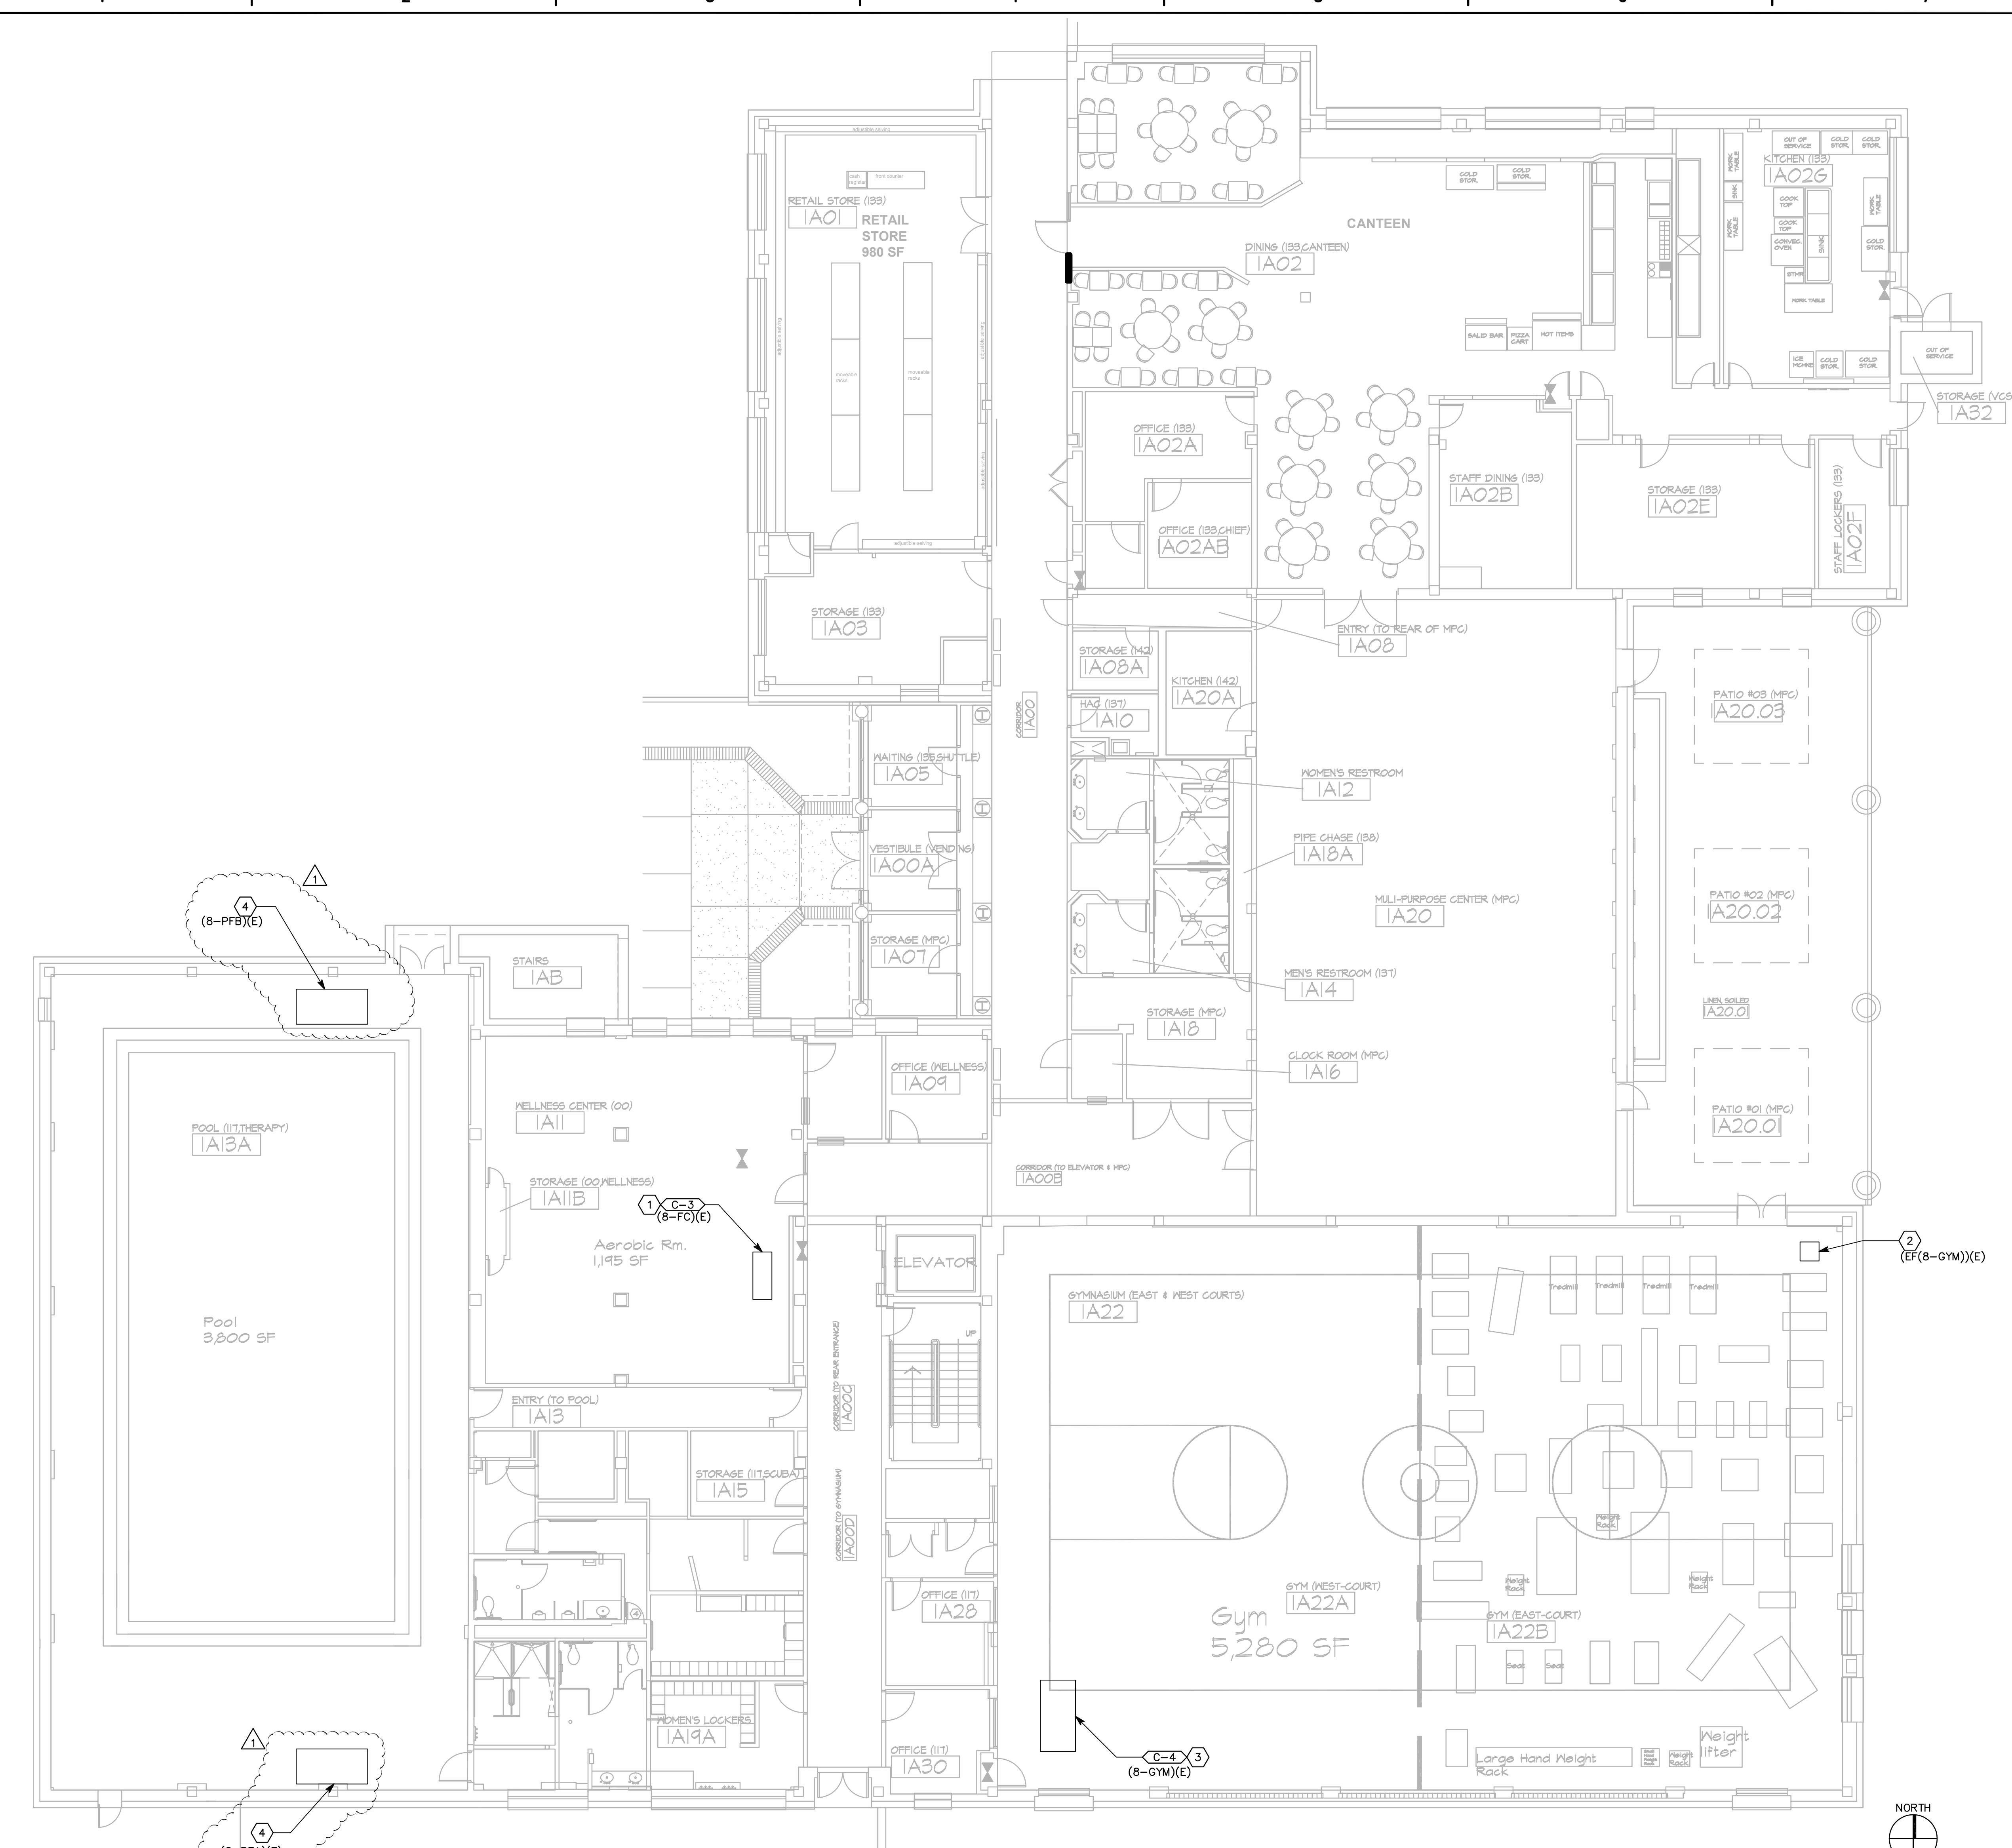


one eighth inch = one foot
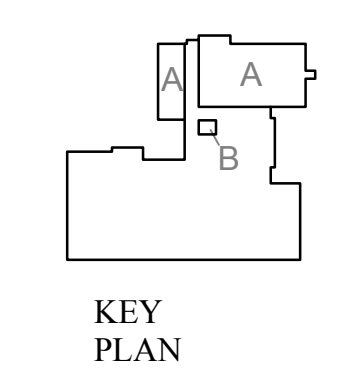

1 B.8 FIRST FLOOR MECHANICAL CONTROLS UPGRADE PLAN
SCALE: 1/8"=1'-0"

- SHEET KEYNOTES**
1. CONTRACTOR TO UPGRADE EXISTING PNEUMATIC CONTROLS TO DIRECT DIGITAL CONTROLS AND PROVIDE ADDITIONAL CONTROLS ON EXISTING FAN COIL UNIT WHICH SERVES AEROBICS ROOM.. SEE SCHEDULE FOR INDIVIDUAL POINTS AND CORRESPONDING DETAILS.
 2. EXISTING EXHAUST FAN SERVES GYM.
 3. EXISTING AIR HANDLING UNIT SERVES GYM. CONTRACTOR TO UPGRADE EXISTING PNEUMATIC CONTROLS TO DIRECT DIGITAL CONTROLS. SEE SCHEDULE FOR INDIVIDUAL POINTS AND CORRESPONDING DETAILS.
 4. EXISTING AIR HANDLING UNIT TO REMAIN.



		CONSULTANTS:		ARCHITECT/ENGINEERS:	<div><div>324 S. State St., Suite 400 Salt Lake City, UT 84111 800-678-7077 801-328-5151 fax: 801-328-5155 www.spectrum-engineers.com</div></div>	Drawing Title	Project Title	Project Number	<div>Office of Construction and Facilities Management</div> <div> Department of Veterans Affairs</div>	
						B.5 FIRST FLOOR MECHANICAL CONTROLS UPGRADE PLAN	METASYS CONTROLS AND ENERGY UPGRADE PHASE III	660-12-110		
								Building Number		
								BLDG 8		
								Drawing Number		
						Approved: Project Director	Location			
							VAMC GEORGE E. WAHLEN SLC, UT			
							Date	Checked	Drawn	
							2011-05-02	RLP	TNB	
										MI101-B08
										Dwg. 7 of 19
 ADDENDUM B	05/03/2012									
Revisions:	Date:									