



three inches = one foot
one and one half inches = one foot
one inch = one foot
three quarters inch = one foot
one half inch = one foot
three eighths inch = one foot
one quarter inch = one foot
one eighth inch = one foot



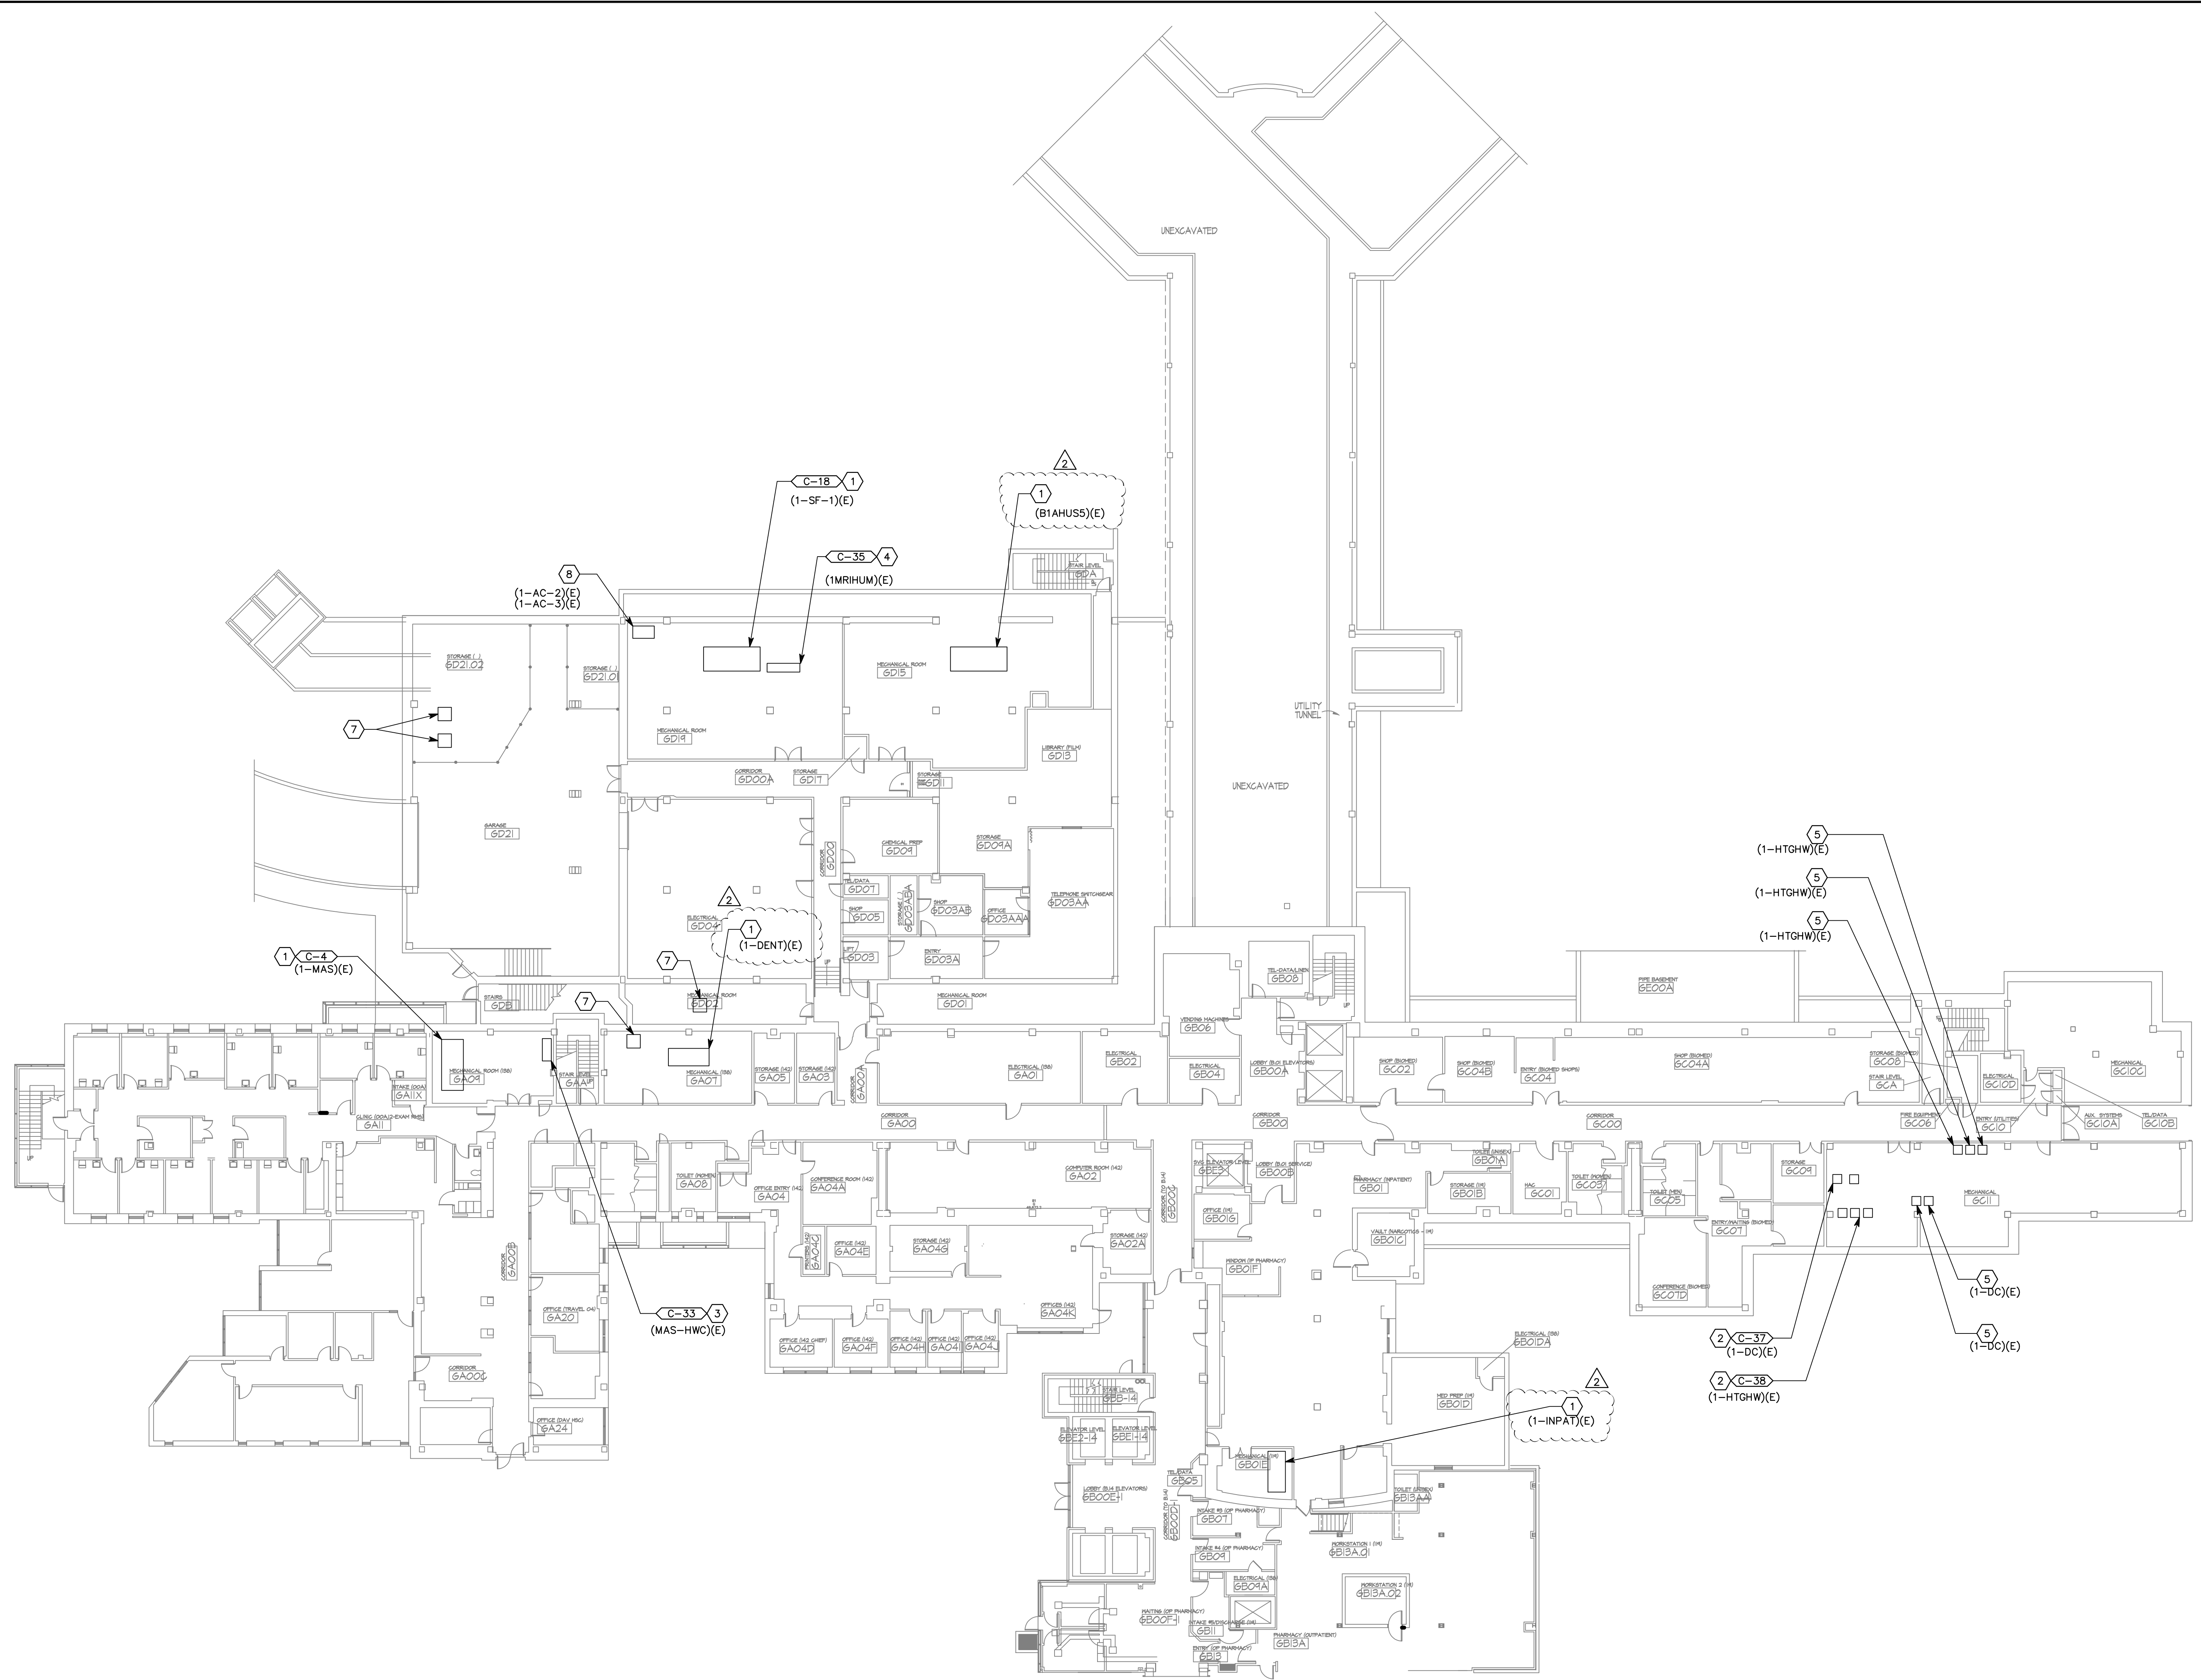


1 B.1 GROUND LEVEL MECHANICAL CONTROLS UPGRADE PLAN
SCALE: 1/16"=1'-0"

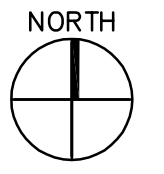

SHEET KEYNOTES

- EXISTING AIR HANDLER UNIT TO REMAIN.
- CONTRACTOR TO UPGRADE EXISTING PNEUMATIC CONTROLS TO DIRECT DIGITAL CONTROLS AND ADD ADDITIONAL CONTROL DEVICES ON EXISTING HOT WATER CONVERTER. SEE SCHEDULE FOR INDIVIDUAL POINTS AND CORRESPONDING DETAILS.
- CONTRACTOR TO UPGRADE EXISTING PNEUMATIC CONTROL TO DIRECT DIGITAL CONTROLS AND ADD ADDITIONAL CONTROL DEVICES ON EXISTING HEAT EXCHANGER CONTROLS. SEE SCHEDULE FOR INDIVIDUAL POINTS AND CORRESPONDING DETAILS.
- CONTRACTOR TO ADD ADDITIONAL CONTROL DEVICES ON HUMIDIFIER UNIT. SEE SCHEDULE FOR INDIVIDUAL POINTS AND CORRESPONDING DETAILS.
- EXISTING PUMP TO REMAIN.
- CONTRACTOR TO ADD ADDITIONAL CONTROL DEVICES ON EXISTING STAND ALONE UNIT. SEE SCHEDULE FOR INDIVIDUAL POINTS AND CORRESPONDING DETAILS.
- EXISTING EXHAUST FAN TO REMAIN.
- EXISTING STAND ALONE UNIT TO REMAIN.

KEY PLAN

| | | | | | | | | | | |
|---|------------|--------------|--|----------------------|--|--|------------------------------|---|------------------------|---|
| | | CONSULTANTS: | | ARCHITECT/ENGINEERS: | <div><div>324 S. State St., Suite 400 Salt Lake City, UT 84111 800-678-7077 801-328-5151 fax: 801-328-5155 www.spectrum-engineers.com</div></div> | Drawing Title B.1 GROUND LEVEL MECHANICAL CONTROLS UPGRADE PLAN | Project Number 660-12-110 | Project Title METASYS CONTROLS AND ENERGY UPGRADE PHASE III ADDENDUM A | Building Number B.1 | Office of Construction and Facilities Management |
| | | | | | | | | | | |
| | | | | | | | | | | |
| | | | | | | | | | | |
| | | | | | | | | | | |
| | | | | | | | | | | |
| | | | | | | | | | | |
| <div> ADDENDUM B</div> | 05/03/2012 | | | | | | | | | <div> Department of Veterans Affairs</div> |
| Revisions: REVISION 1 | JUNE 22 | | | | | | | | | |