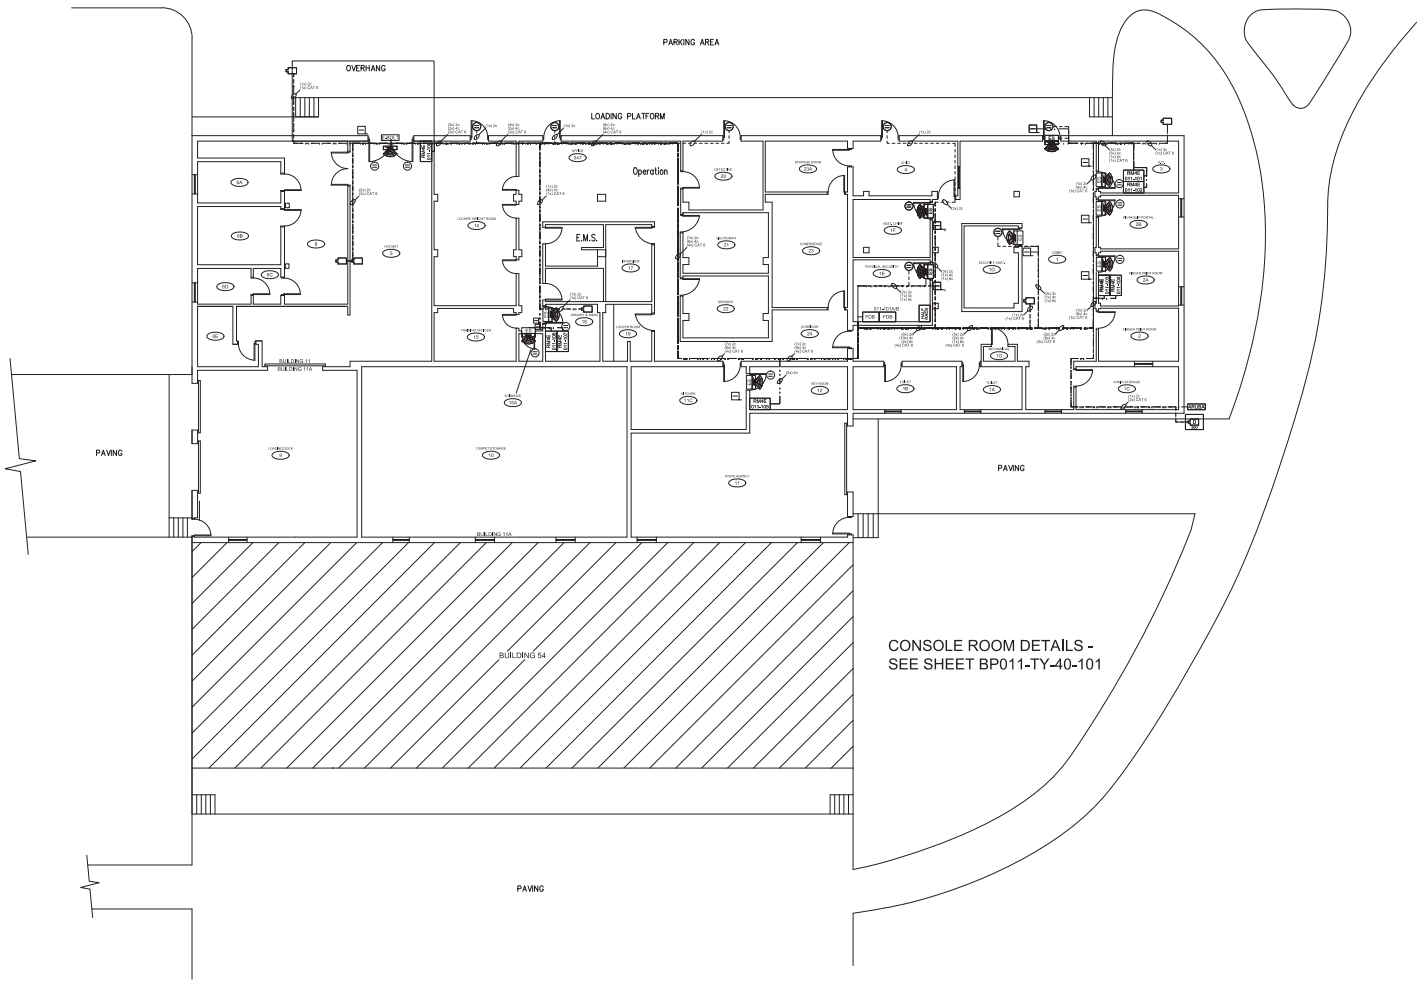

UNIFIED CONSULTANTS GROUP, INC.
111 HIGHLAND DRIVE
FAYETTEVILLE, GA 30214
PHONE: 770-692-1971
FAX: 678-817-9028

CLIENTELE

U.S. DEPARTMENT OF VETERANS AFFAIRS
4300 DUHME ROAD, SUITE 300
MADEIRA BEACH, FL 33708

PROJECT IDENTIFICATION

BAY PINES VA HEALTHCARE FACILITY
ELECTRONIC & PHYSICAL SECURITY UPGRADE

AS-BUILT SET

MARK	DATE	DESCRIPTION
REV E	11-15-2013	AS-BUILT

CONTRACT NUMBER	VA248-12-F-0157
CAD DWG FILE:	BP011-TY-11-101
DESIGNED BY:	B. YOUNG
DRAWN BY:	I. MACFARLANE/S.LEVITT
CHECKED BY:	B. YOUNG
REVIEWED BY:	M. LAUDE
DATE:	MARCH 12, 2013

FOR OFFICIAL USE ONLY

SHEET TITLE

BUILDING 11 WIRE RUNS

10'-8" 0 10'-8" 21'-4"

BP011-TY-11-101
SECTION - ELECTRICAL & CABLING
SHEET 3 OF 6