


three inches = one foot  
 one and one-half inches = one foot  
 one inch = one foot  
 three-quarters inch = one foot  
 one-half inch = one foot  
 three-eighths inch = one foot  
 one-quarter inch = one foot  
 one-eighth inch = one foot

- LEGEND**
- 162 BUILDING NUMBER
  - NEW 8'-0" HIGH x 8'-0" PANEL WIDTH DECORATIVE METAL PANEL FENCE.
  - NEW 8'-0" HIGH CHAIN LINK FENCE.
  - EXISTING 8'-0" HIGH CHAIN LINK FENCE TO REMAIN.
  - EXISTING PROPERTY LINE.
  - NEW 28"x28"x9'-10" BRICK PILASTER. (NOT ALL ARE SHOWN).

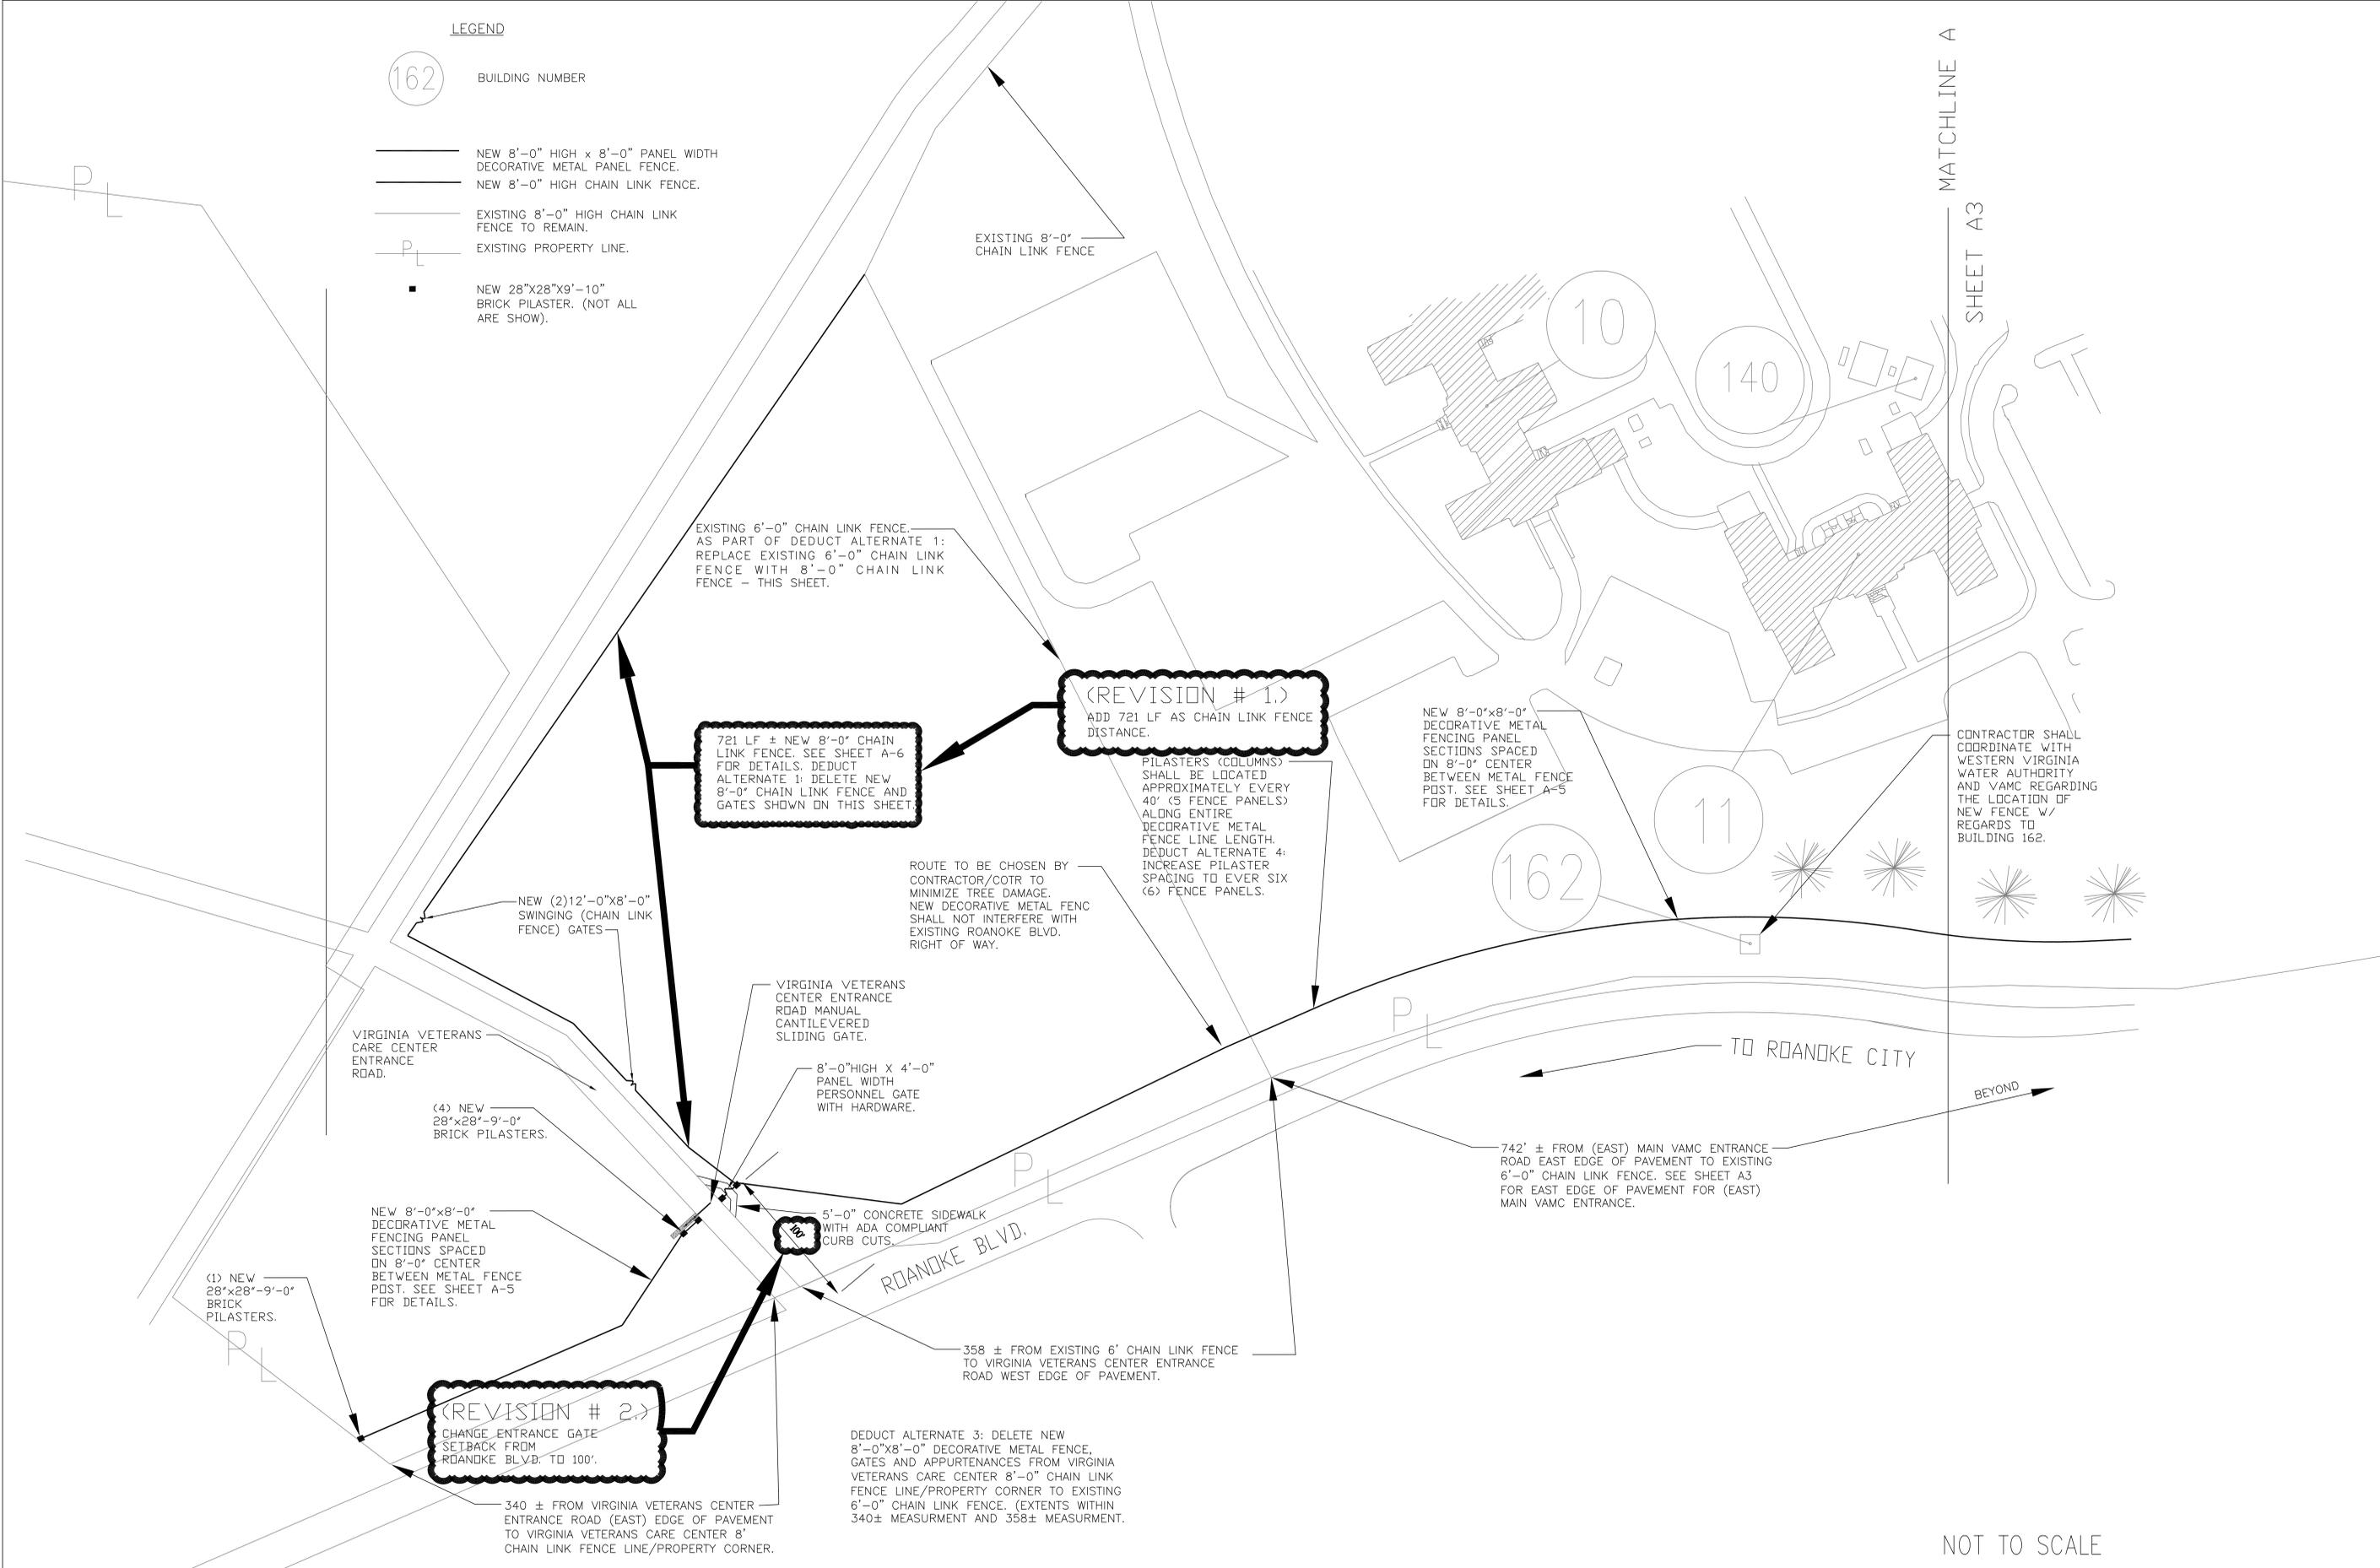

**(REVISION # 1.)**  
 ADD 721 LF AS CHAIN LINK FENCE DISTANCE.

721 LF ± NEW 8'-0" CHAIN LINK FENCE. SEE SHEET A-6 FOR DETAILS. DEDUCT ALTERNATE 1: DELETE NEW 8'-0" CHAIN LINK FENCE AND GATES SHOWN ON THIS SHEET.

PILASTERS (COLUMNS) SHALL BE LOCATED APPROXIMATELY EVERY 40' (5 FENCE PANELS) ALONG ENTIRE DECORATIVE METAL FENCE LINE LENGTH. DEDUCT ALTERNATE 4: INCREASE PILASTER SPACING TO EVERY SIX (6) FENCE PANELS.

ROUTE TO BE CHOSEN BY CONTRACTOR/COTR TO MINIMIZE TREE DAMAGE. NEW DECORATIVE METAL FENCE SHALL NOT INTERFERE WITH EXISTING ROANOKE BLVD. RIGHT OF WAY.

NEW 8'-0"x8'-0" DECORATIVE METAL FENCING PANEL SECTIONS SPACED ON 8'-0" CENTER BETWEEN METAL FENCE POST. SEE SHEET A-5 FOR DETAILS.

CONTRACTOR SHALL COORDINATE WITH WESTERN VIRGINIA WATER AUTHORITY AND VAMC REGARDING THE LOCATION OF NEW FENCE W/ REGARDS TO BUILDING 162.

**(REVISION # 2.)**  
 CHANGE ENTRANCE GATE SETBACK FROM ROANOKE BLVD. TO 100'.

DEDUCT ALTERNATE 3: DELETE NEW 8'-0"x8'-0" DECORATIVE METAL FENCE, GATES AND APPURTENANCES FROM VIRGINIA VETERANS CARE CENTER 8'-0" CHAIN LINK FENCE LINE/PROPERTY CORNER TO EXISTING 6'-0" CHAIN LINK FENCE. (EXTENTS WITHIN 340± MEASUREMENT AND 358± MEASUREMENT.

NOT TO SCALE

REVISION # 2 (CHANGE LINE TYPE) 5/4/12 REVISION # 1 (ADD DISTANCE TO NOTE) 5/4/12 Revisions Date	Approved: Energy Engineer	Approved: Safety Manager	Approved: Service Chief	Drawing Title SITE FENCING PLAN VIRGINIA VET. CENTER ENTRANCE	Project Title INSTALL PERIMETER SECURITY FENCE	Date 02-15-12	Veterans Affairs
		Approved: Infection Control Officer	Approved: Chief of Staff	Approved: Chief of Facility Management Svc.	Building Number NORTH SITE	Checked WGJ	
	Approved: GEMS Coordinator	Approved: Associate Director	Approved: Medical Center Director	Location V.A.M.C. SALEM 24153	Project No. 658-12-101	DRAWING NO. A2 2555	
						Dwg. 3 of 9	