
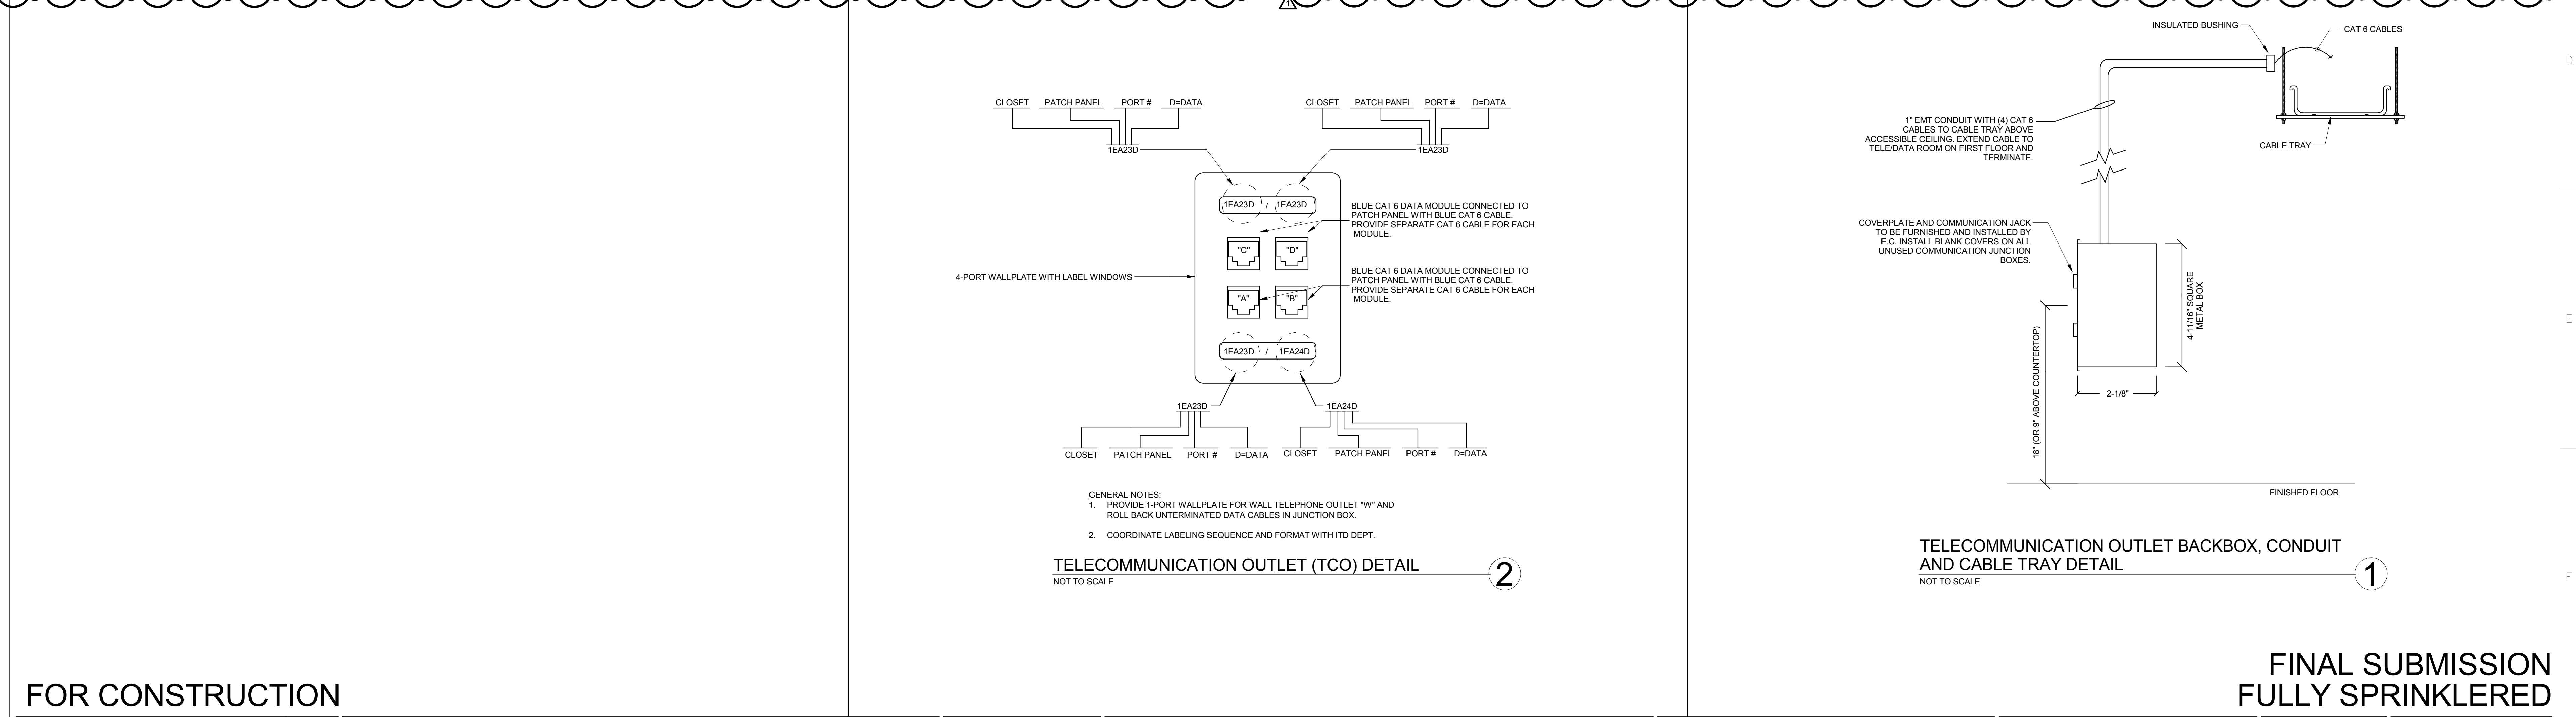


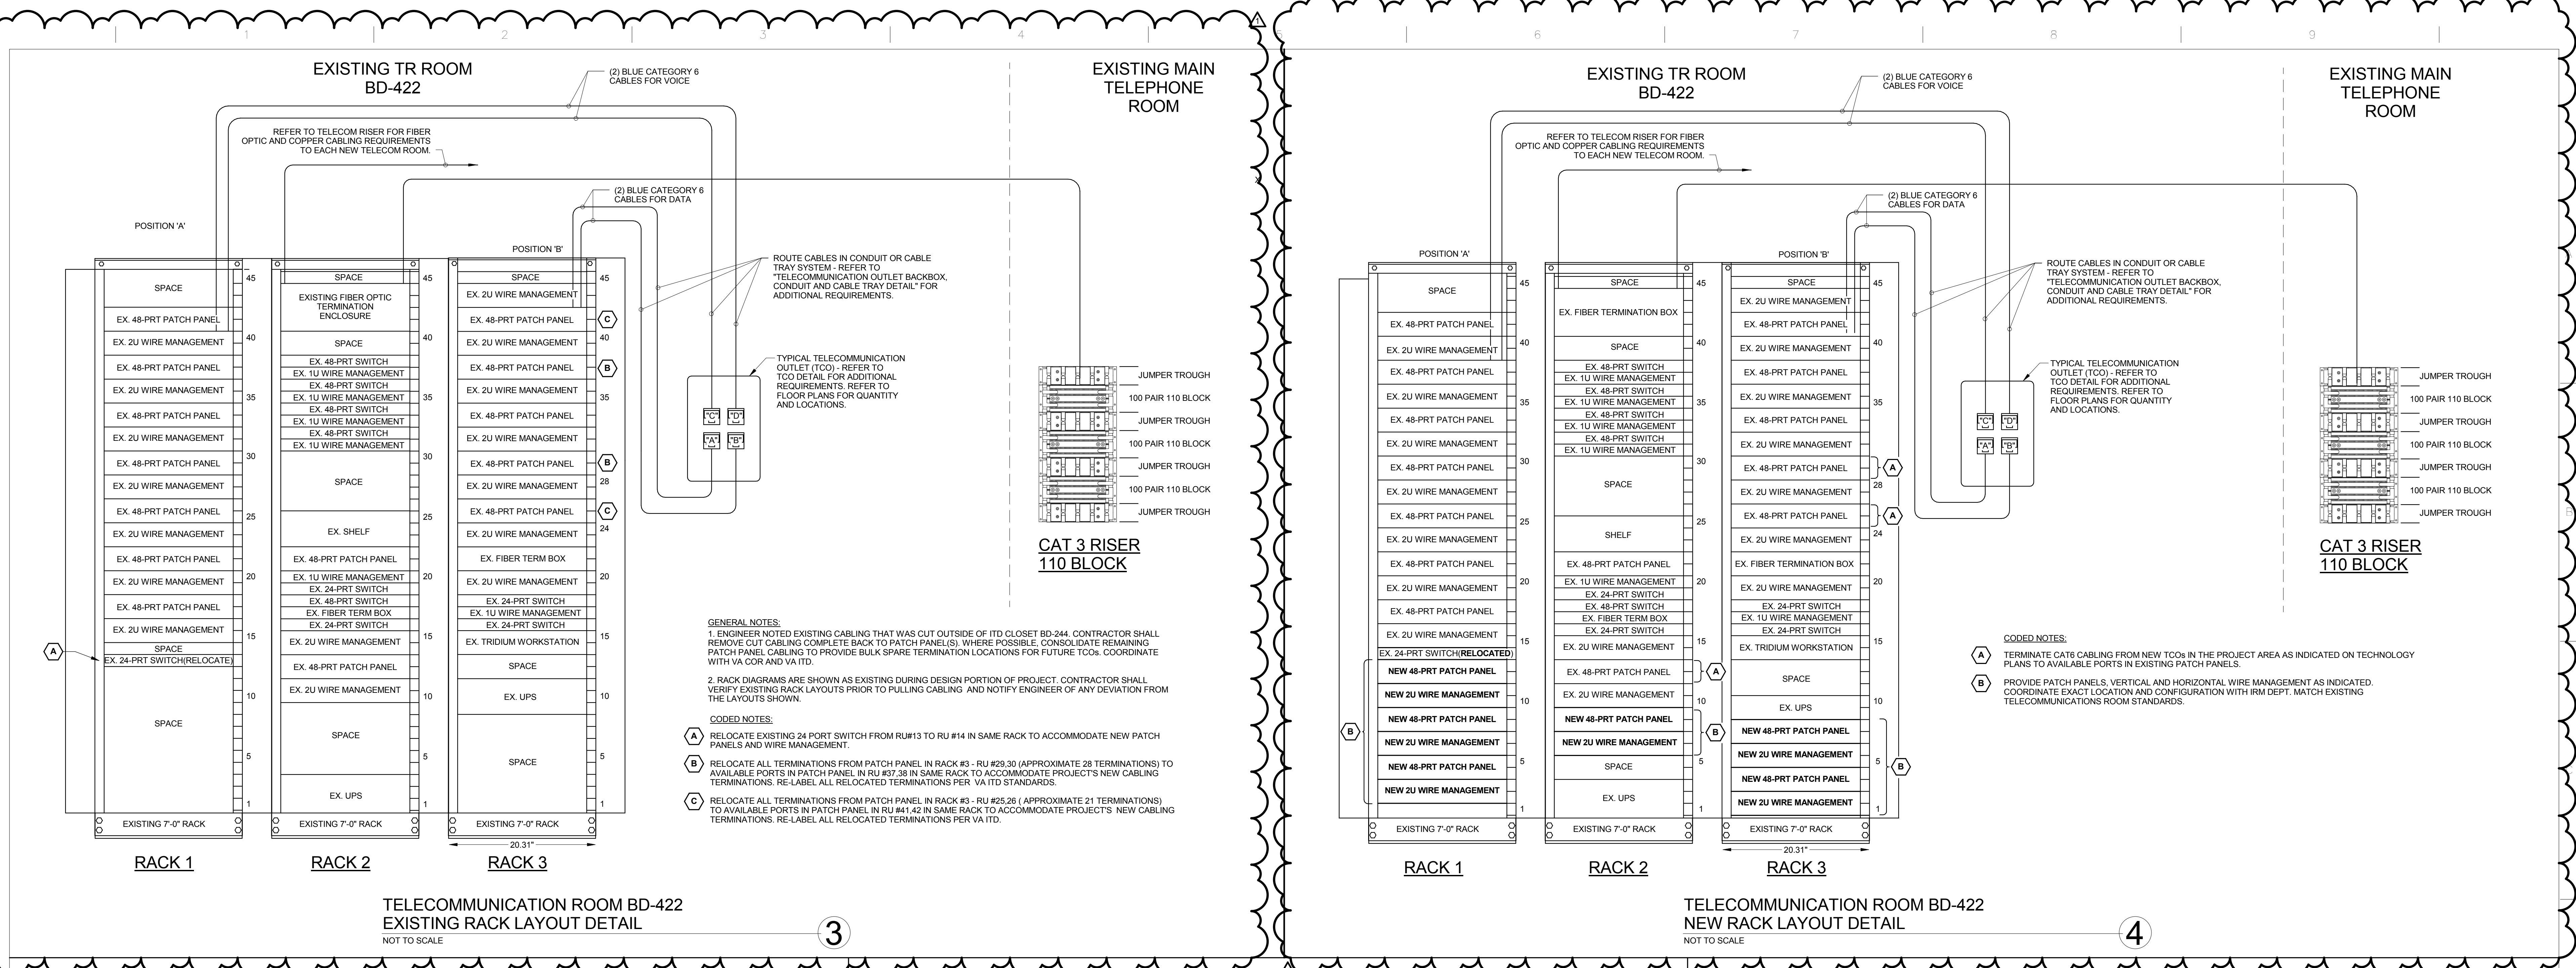

<b>FOR CONSTRUCTION</b>		<b>CONSULTANTS:</b>		<b>ARCHITECT/ENGINEERS:</b>		<b>FINAL SUBMISSION FULLY SPRINKLERED</b>	
<div>ADDENDUM 03 FINAL SUBMISSION Revisions:</div>		<div>03/17/17 07/05/16 Date</div>		<div>STATE OF OHIO M.P. LONG Professional Engineer 16009</div>		<div>MAKOVICH &amp; PUSTI ARCHITECTS, INC. 131 FRONT STREET, BEREA, OHIO 44017 (440) 951-0910</div>	
<div>VA FORM 08-6231</div>		<div>1</div>		<div>2</div>		<div>3</div>	
