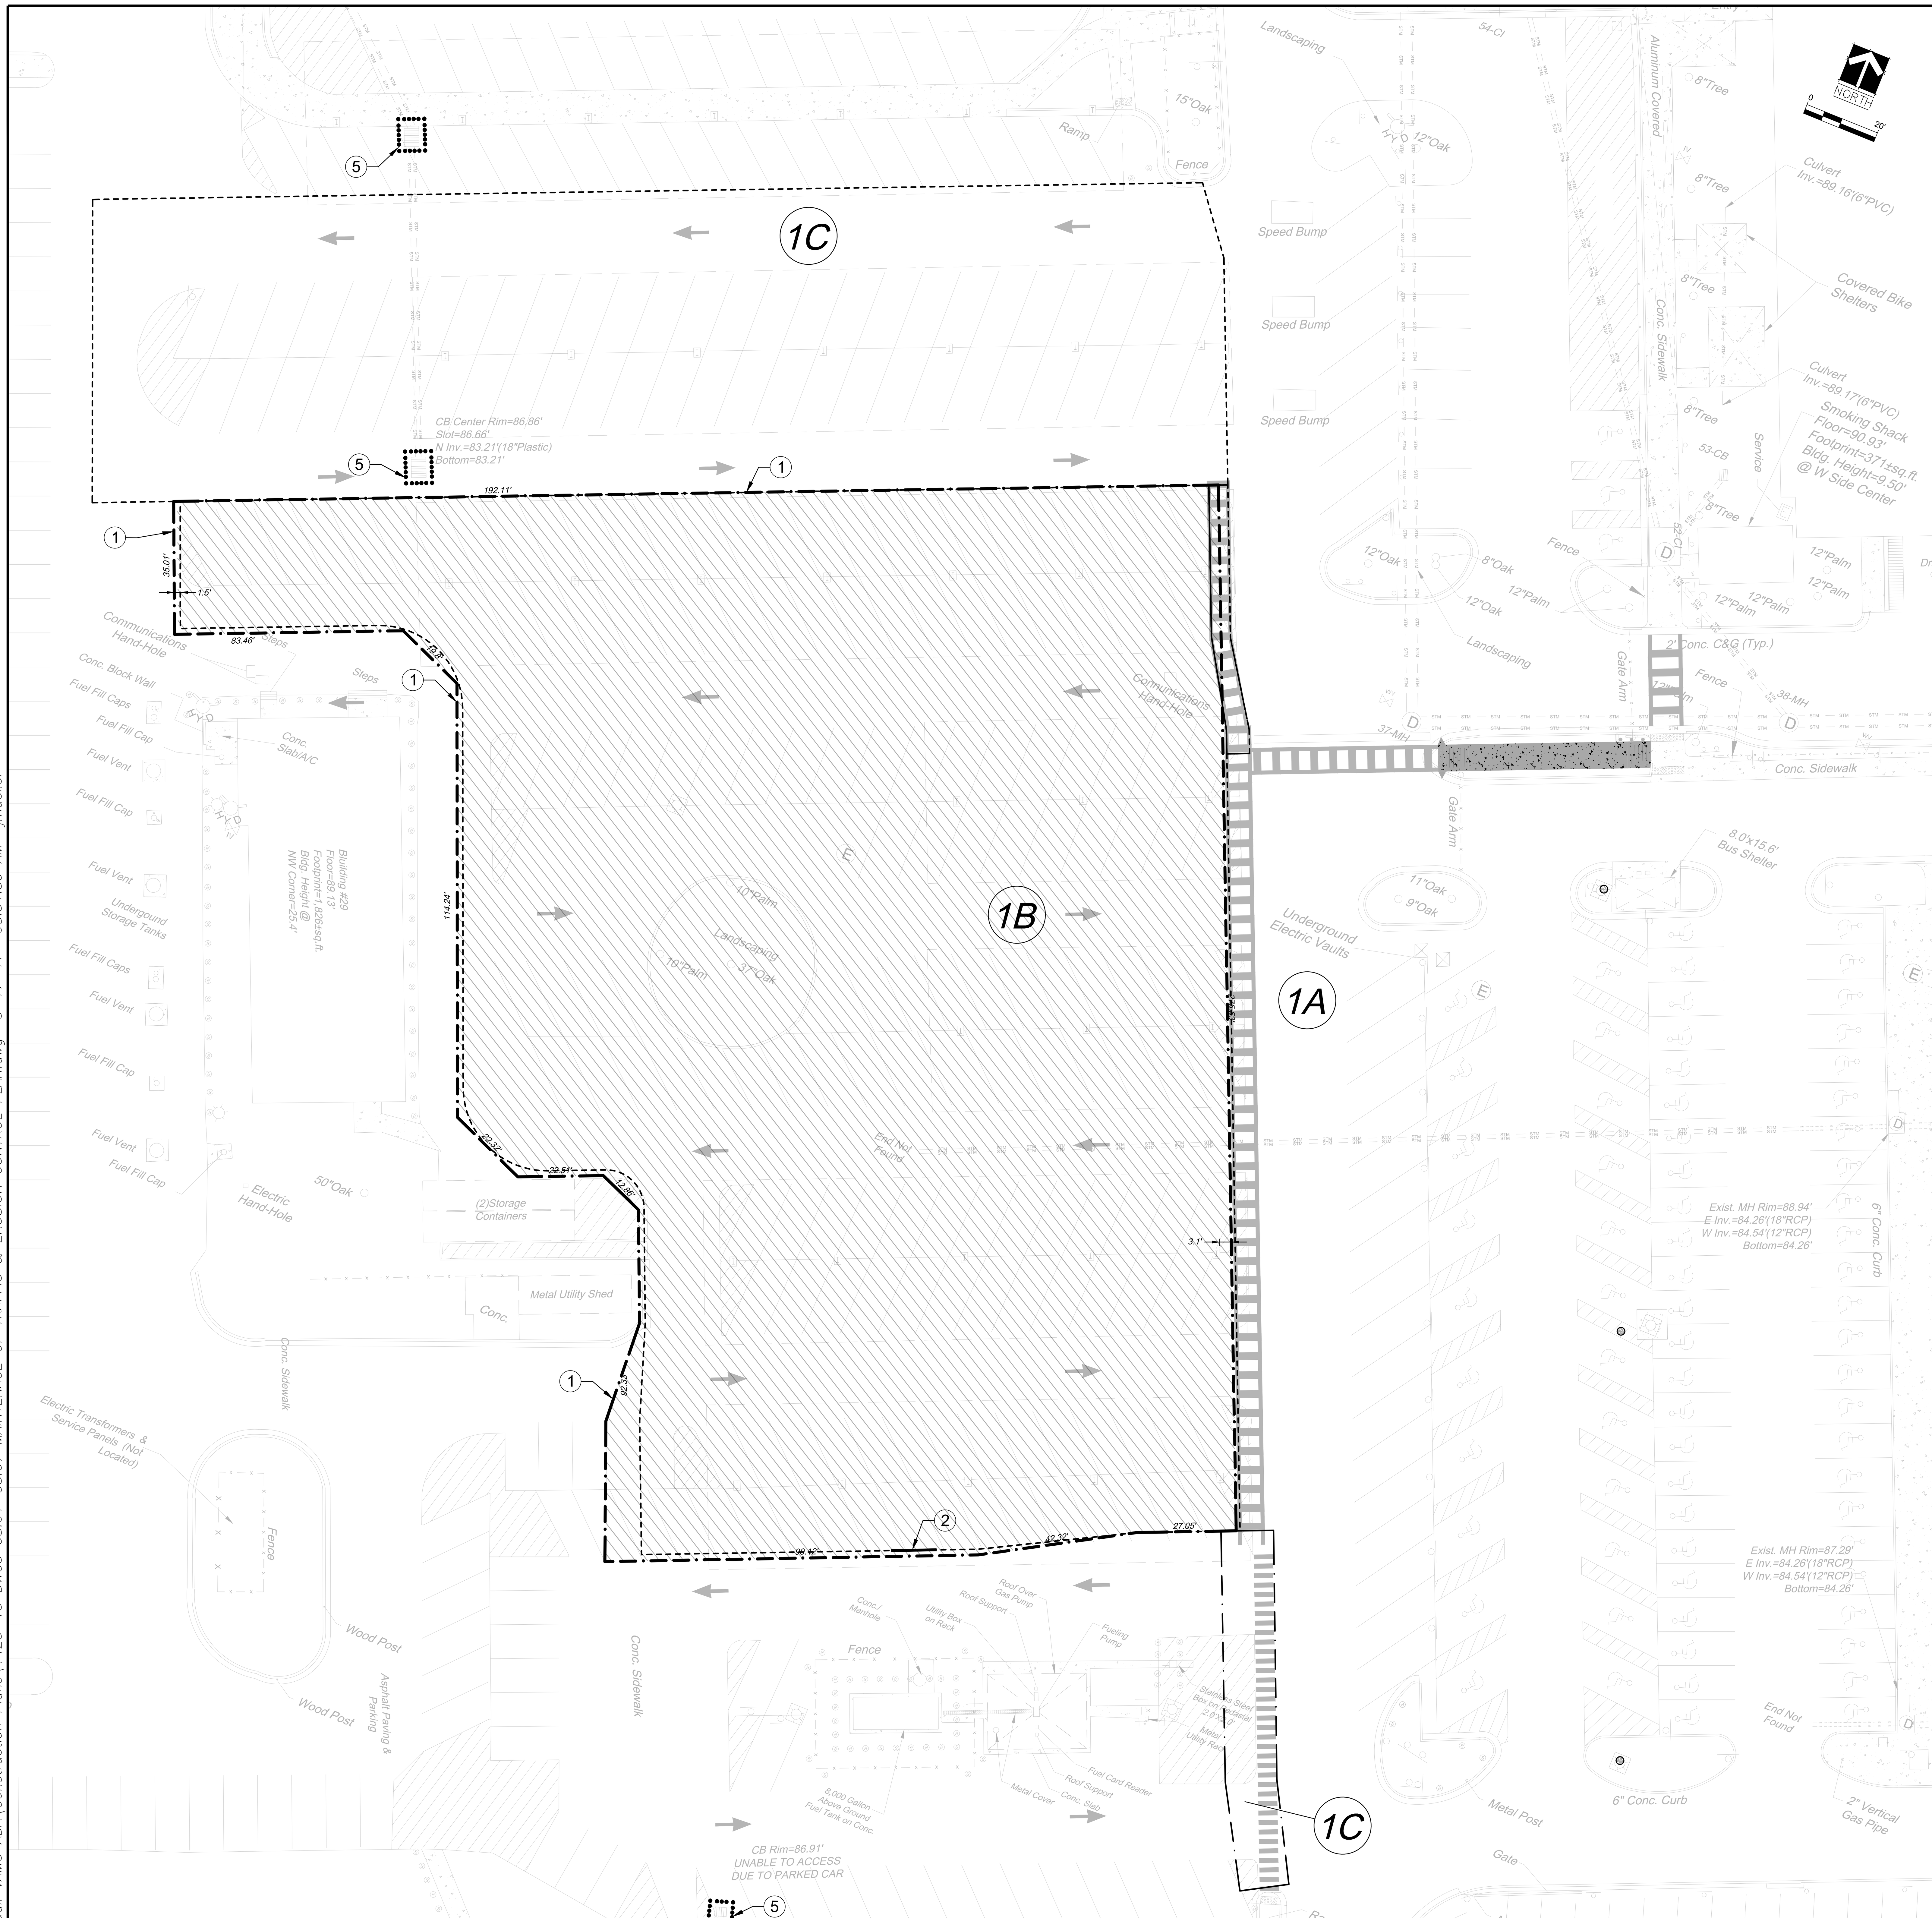


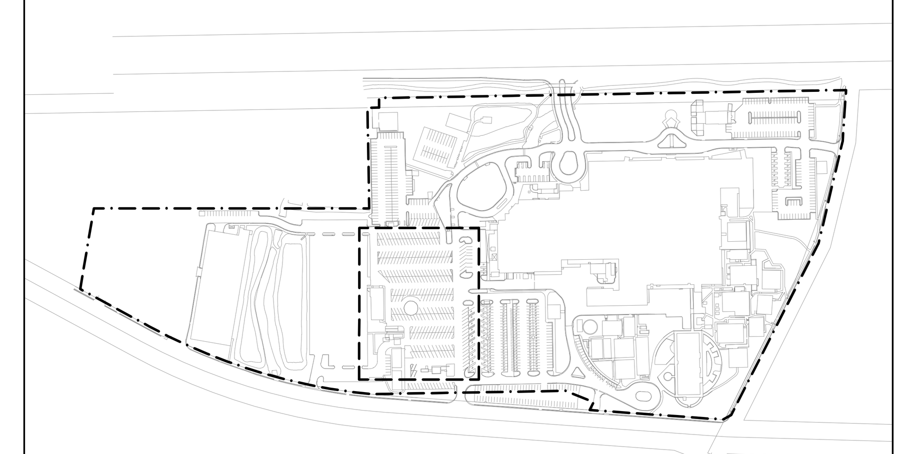

KEY MAP

KEYED NOTES:

1. TEMPORARY 6' HIGH CHAIN LINK FENCE
2. GATE
3. TYPE 2 BARRICADE, WITH WARNING LIGHT, PER FDOT INDEX #600.
4. ITEM REMOVED (revision 3)
5. INLET SEDIMENT CONTROL DEVICE, DETAIL 17, SHEET CI.13

NOTES:

1. NO ADDITIONAL CONSTRUCTION QUANTITIES ARE ASSUMED HERE AS CONSTRUCTION FENCE FROM AREA 1A WILL BE RELOCATED FOR AREA 1B.
2. AFTER COMPLETION OF CONSTRUCTION OF AREA 1B, THE FENCES SHALL BE REMOVED AND THE POST & STAKE HOLES SHALL BE PATCHED.

CONSTRUCTION QUANTITIES:

LEGEND:

| | |
|---|---|
| — — · — — · — | CHAIN LINK FENCE |
| ▭ | TYPE II BARRICADE |
| ⬚ | INLET PROTECTION |
| ——— | GATE |
| - - - - - - - | AREA BOUNDARY |

| Number | Description | Date |
|---|---|---|
| 1 | REVISED 100% CONSTRUCTION DRAWINGS | 6/15/2016 |
| 3 | REVISED 100% CONSTRUCTION DRAWINGS | 3/7/2017 |

MECHANICAL / ELECTRICAL ENGINEERS:

MES GROUP
550 NORTH REO STREET, SUITE 203
TAMPA, FL 33609
PHONE: (813) 289-4700
FAX: (813) 289-1041
WWW. MESGROUPINC.COM

J. DALLAS EVANS, P.E.
FLORIDA LICENSE # 72691

CIVIL ENGINEERS:

Sprinkle CONSULTING
Planners + Engineers
18115 U.S. HWY. 41 NORTH SUITE 600
LUTZ, FL 33549
PHONE: (813) 949-7449 FAX: (813) 909-9840
WWW. SPRINKLECONSULTING.COM
BOARD OF ENGINEERS CERTIFICATE OF AUTHORIZATION #4548

Drawing Title
AREA 1B - MAINTENANCE OF TRAFFIC & EROSION CONTROL PLAN

Approved: Project Director

Project Status: REVISED 100% CONSTRUCTION DRAWINGS

Project Title
UPDATE SITE FOR COMPLIANCE WITH VA BARRIER FREE GUIDE

Location GAINESVILLE, FL
PROJECT #573-13-601

Date 06/15/2016 | Checked | Drawn

Project Number 573-13-601

Building Number N/A

Drawing Number CS.02
Dwg. 9 of 50

Office of Construction and Facilities Management
Department of Veterans Affairs

W:\1\1425-13 Malcom Randall VAMC ADA\Construction Plans\1425-13 DWGS CS.01-CS.07 MAINTENACE OF TRAFFIC & EROSION CONTROL PLAN.dwg 3-17-17 08:51:39 AM jmueller