


- GENERAL NOTES:**
- A. CONTRACTOR SHALL LIMIT ACCESS TO ACTIVE CONSTRUCTION AREAS THROUGH USE OF TEMPORARY FENCING (PORTABLE CHAIN LINK FENCE 6' IN HEIGHT WITH GATES FOR ACCESS).
- KEYED NOTES:** (1)
1. NEW 30' POLE LUMINAIRE.
 2. RELOCATED METAL HALIDE SOURCE BOLLARD.
 3. CONNECT NEW LIGHTING FIXTURE TO EXISTING LIGHTING CIRCUIT.
 4. DIRECTIONAL BORE CONDUIT UNDER ROADWAY. PRIOR TO PERFORMING DIRECTIONAL BORE, COORDINATE WITH VA FOR ANY UTILITIES THAT MAY BE PRESENT.
 5. NEW BOLLARD.
 6. EXTEND EXISTING LIGHTING CIRCUIT TO NEW FIXTURE.
 7. CONTRACTOR SHALL REPAIR WALL SO NO GAPS APPEAR AROUND LIGHTING FIXTURE.

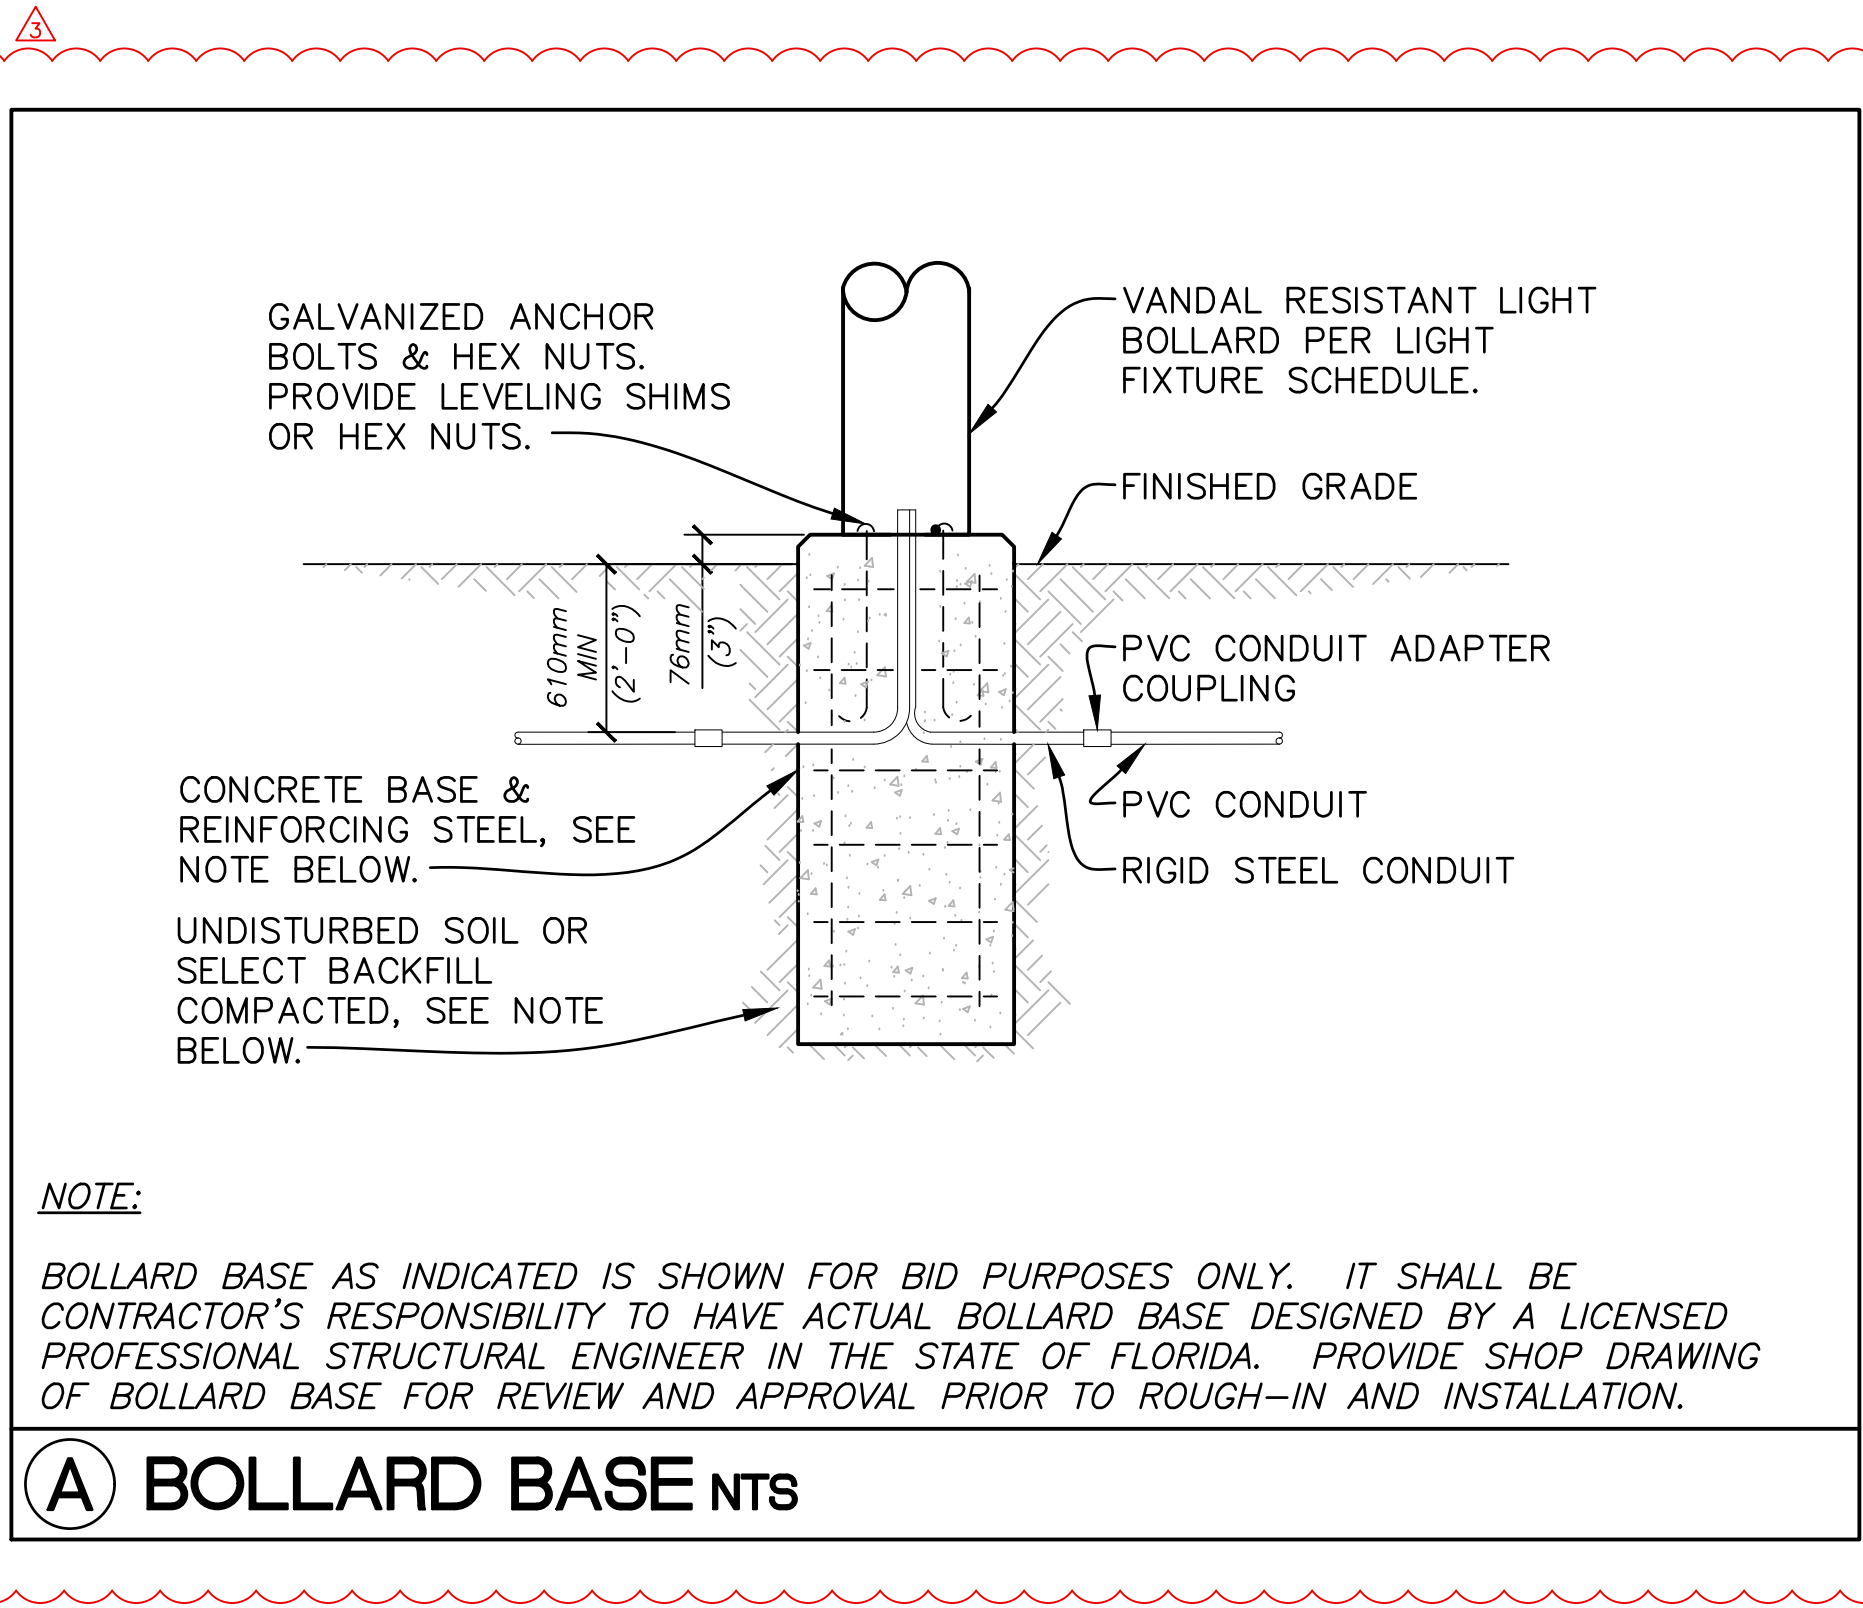

Number	Description	Date
1	REVISED 100% CONSTRUCTION DRAWINGS	6/15/2016
2	REVISED 100% CONSTRUCTION DRAWINGS	6/24/2016
3	REVISED 100% CONSTRUCTION DRAWINGS	3/16/2017

MECHANICAL / ELECTRICAL ENGINEERS:

MES GROUP
MES GROUP
550 NORTH REO STREET, SUITE 203
TAMPA, FL 33609
PHONE: (813) 289-4700
FAX: (813) 289-1041
WWW. MESGROUPINC.COM

DALE A. BACIK, P.E.
36564

CIVIL ENGINEERS:

Sprinkle CONSULTING
Planners + Engineers
18115 U.S. HWY. 41 NORTH SUITE 600
LUTZ, FL 33549
PHONE: (813) 949-7449 FAX: (813) 909-9840
WWW. SPRINKLECONSULTING.COM
BOARD OF ENGINEERS CERTIFICATE OF AUTHORIZATION #4548

Drawing Title
AREAS 3 AND 4 - PROPOSED IMPROVEMENTS PLAN

Approved Project Director

Project Status: REVISED 100% CONSTRUCTION DRAWINGS

Project Title
UPDATE SITE FOR COMPLIANCE WITH VA BARRIER FREE GUIDE

Location
GAINESVILLE, FL
PROJECT #573-13-601

Date
06/15/2016

Checked

Drawn

Project Number
573-13-601

Building Number
N/A

Drawing Number
E-203
Dwg. 49 of 50

Office of
Construction
and Facilities
Management

Department of
Veterans Affairs