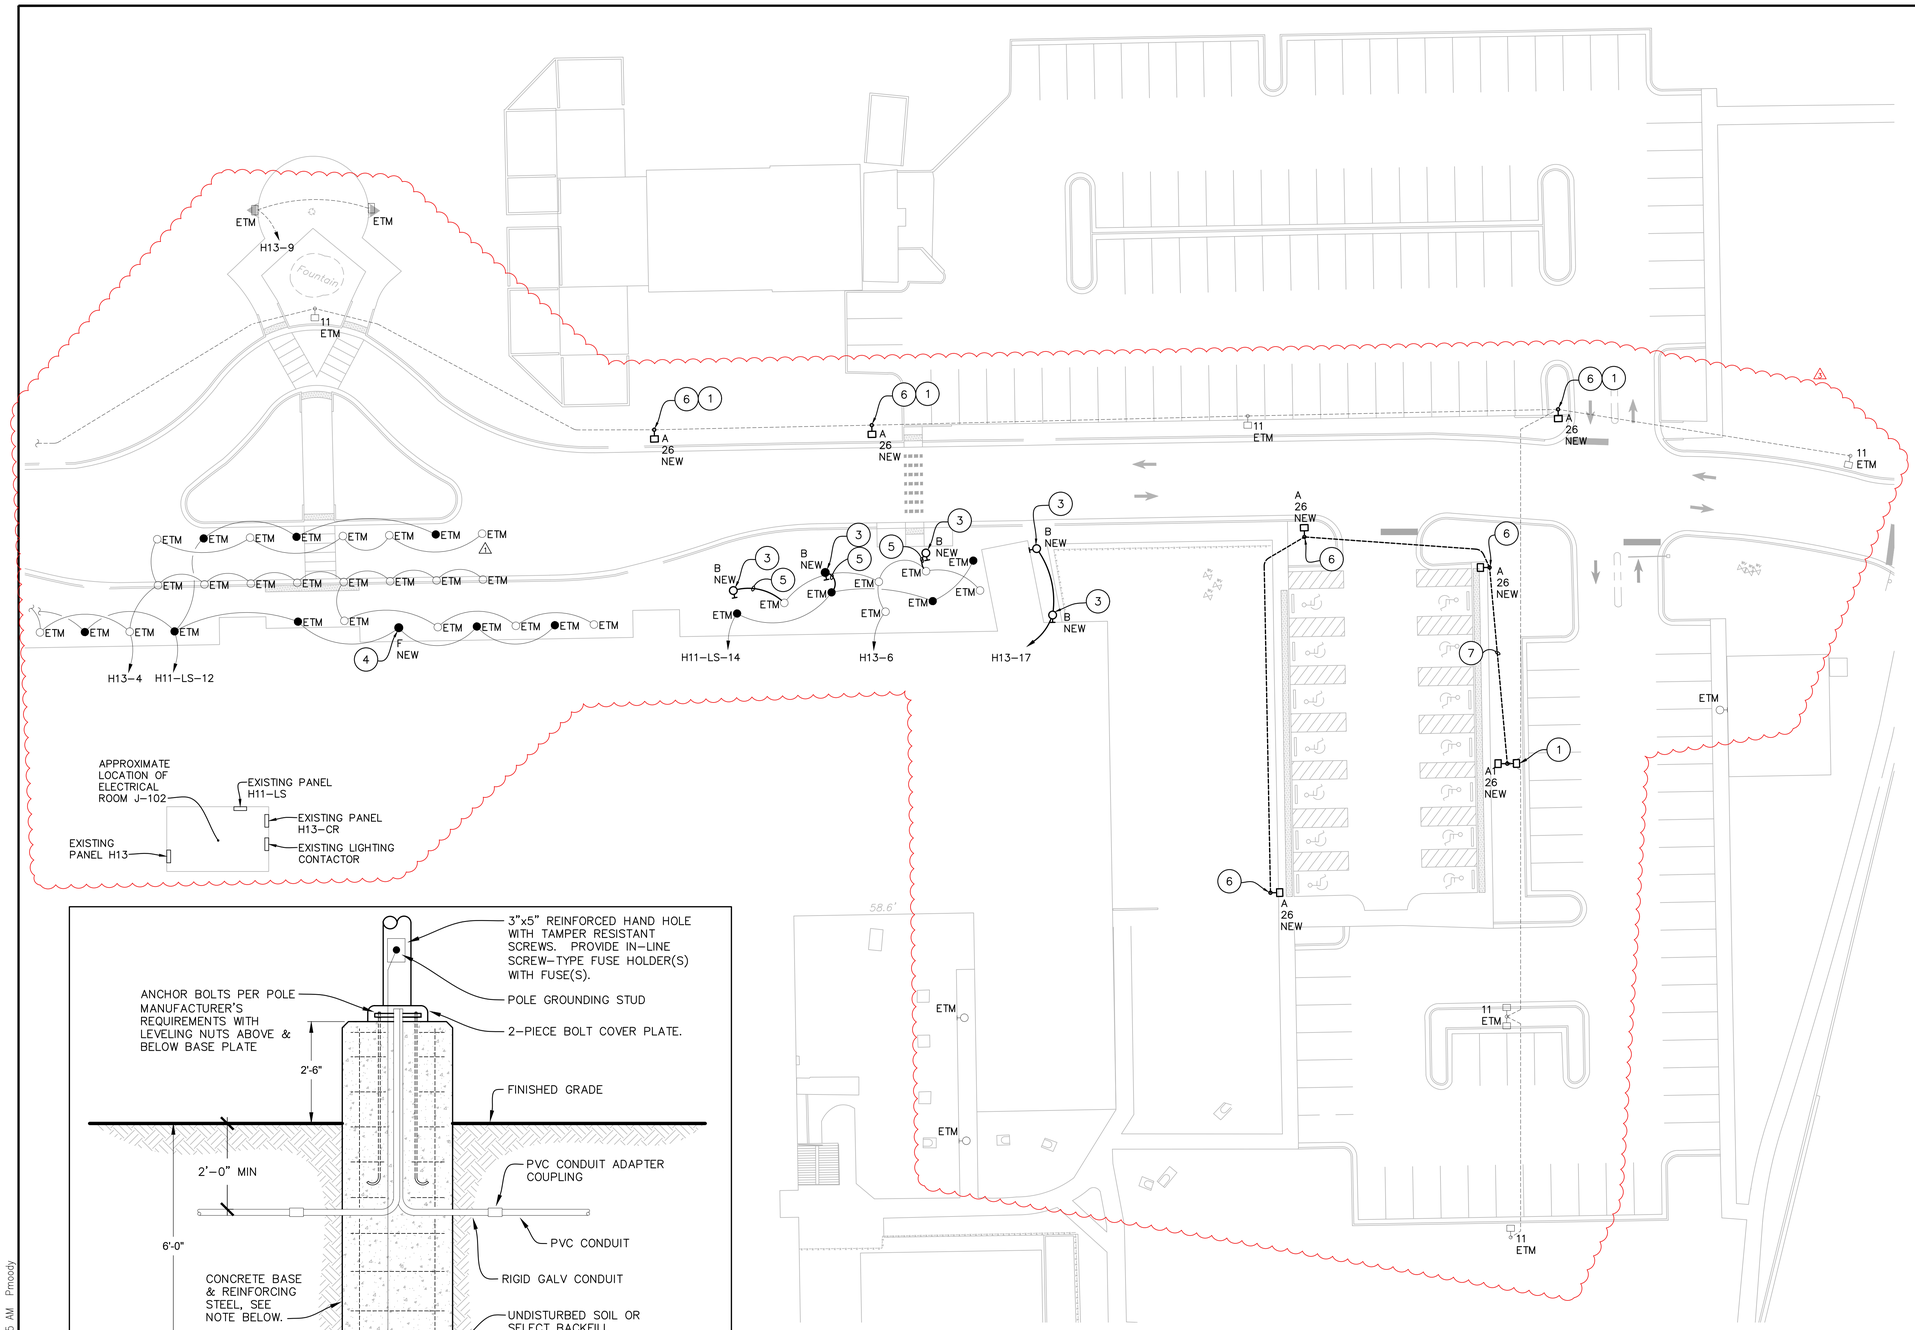

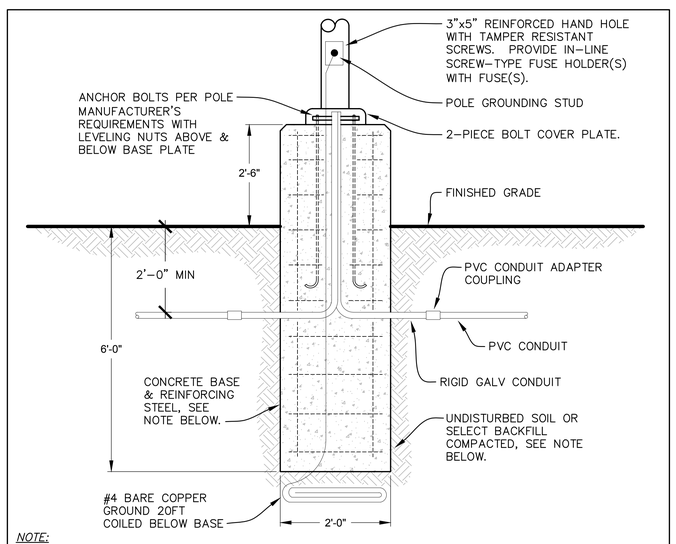

NOTE:

POLE BASE AS INDICATED IS SHOWN FOR BID PURPOSES ONLY. IT SHALL BE CONTRACTOR'S RESPONSIBILITY TO HAVE ACTUAL POLE BASE DESIGNED BY A LICENSED PROFESSIONAL STRUCTURAL ENGINEER IN THE STATE OF FLORIDA. PROVIDE SHOP DRAWING OF POLE BASE FOR REVIEW AND APPROVAL PRIOR TO ROUGH–IN AND INSTALLATION.

Ⓐ POLE BASE NTS

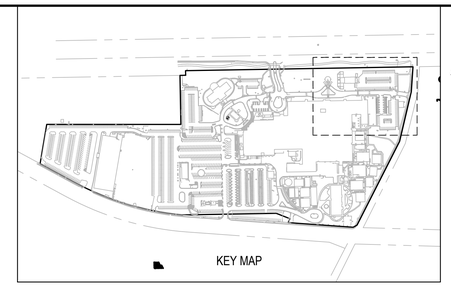

GENERAL NOTES:

A. CONTRACTOR SHALL LIMIT ACCESS TO ACTIVE CONSTRUCTION AREAS THROUGH USE OF TEMPORARY FENCING (PORTABLE CHAIN LINK FENCE 6' IN HEIGHT WITH GATES FOR ACCESS).

KEYED NOTES: (–)

1. CONNECT NEW LIGHTING FIXTURE TO EXISTING LIGHTING CIRCUIT.
2. DIRECTIONAL BORE CONDUIT UNDER ROADWAY. PRIOR TO PERFORMING DIRECTIONAL BORE, COORDINATE WITH VA FOR ANY UTILITIES THAT MAY BE PRESENT.
3. NEW WALL PACK FIXTURE.
4. NEW RECESSED DOWNLIGHT. CONNECT TO EXISTING LIGHT CIRCUIT.
5. CONNECT NEW LIGHTING FIXTURE TO EXISTING CANOPY LIGHTING CIRCUIT.
6. NEW 30' POLE LUMINAIRE.
7. EXTEND EXISTING LIGHTING CIRCUIT TO NEW FIXTURE.

Number	Description	Date
1	REVISED 100% CONSTRUCTION DRAWINGS	6/15/2016
2	REVISED 100% CONSTRUCTION DRAWINGS	6/24/2016
3	REVISED 100% CONSTRUCTION DRAWINGS	3/16/2017

MECHANICAL / ELECTRICAL ENGINEERS:

MES GROUP
550 NORTH REO STREET, SUITE 203
TAMPA, FL 33609
PHONE: (813) 289–4700
FAX: (813) 289–1041
WWW. MESGROUPINC.COM

DALE A. BACIK, P.E.
36564

CIVIL ENGINEERS:

Sprinkle Consulting
Planners • Engineers
18115 U.S. HWY. 41 NORTH SUITE 600
LUTZ, FL 33549
PHONE: (813) 949–7449 FAX: (813) 909–9840
WWW. SPRINKLECONSULTING.COM
BOARD OF ENGINEERS CERTIFICATE OF AUTHORIZATION #4548

Drawing Title: AREA 8 - PROPOSED IMPROVEMENTS PLAN

Approved: Project Director

Project Status: REVISED 100% CONSTRUCTION DRAWINGS

Project Title: UPDATE SITE FOR COMPLIANCE WITH VA BARRIER FREE GUIDE

Location: GAINESVILLE, FL
PROJECT #573-13-601

Date: 06/15/2016 | Checked | Drawn

Project Number: 573-13-601

Building Number: N/A

Drawing Number: E-204
Dwg. 50 of 50

Office of Construction and Facilities Management
Department of Veterans Affairs

K:\2013537 vg gainesville barrier free\2013537-E-201.dwg 3-16-17 09:41:35 AM Pmoody