


three inches = one foot
one and one half inches = one foot
one inch = one foot
three quarters inch = one foot
one half inch = one foot
three eighths inch = one foot
one quarter inch = one foot
one eighth inch = one foot

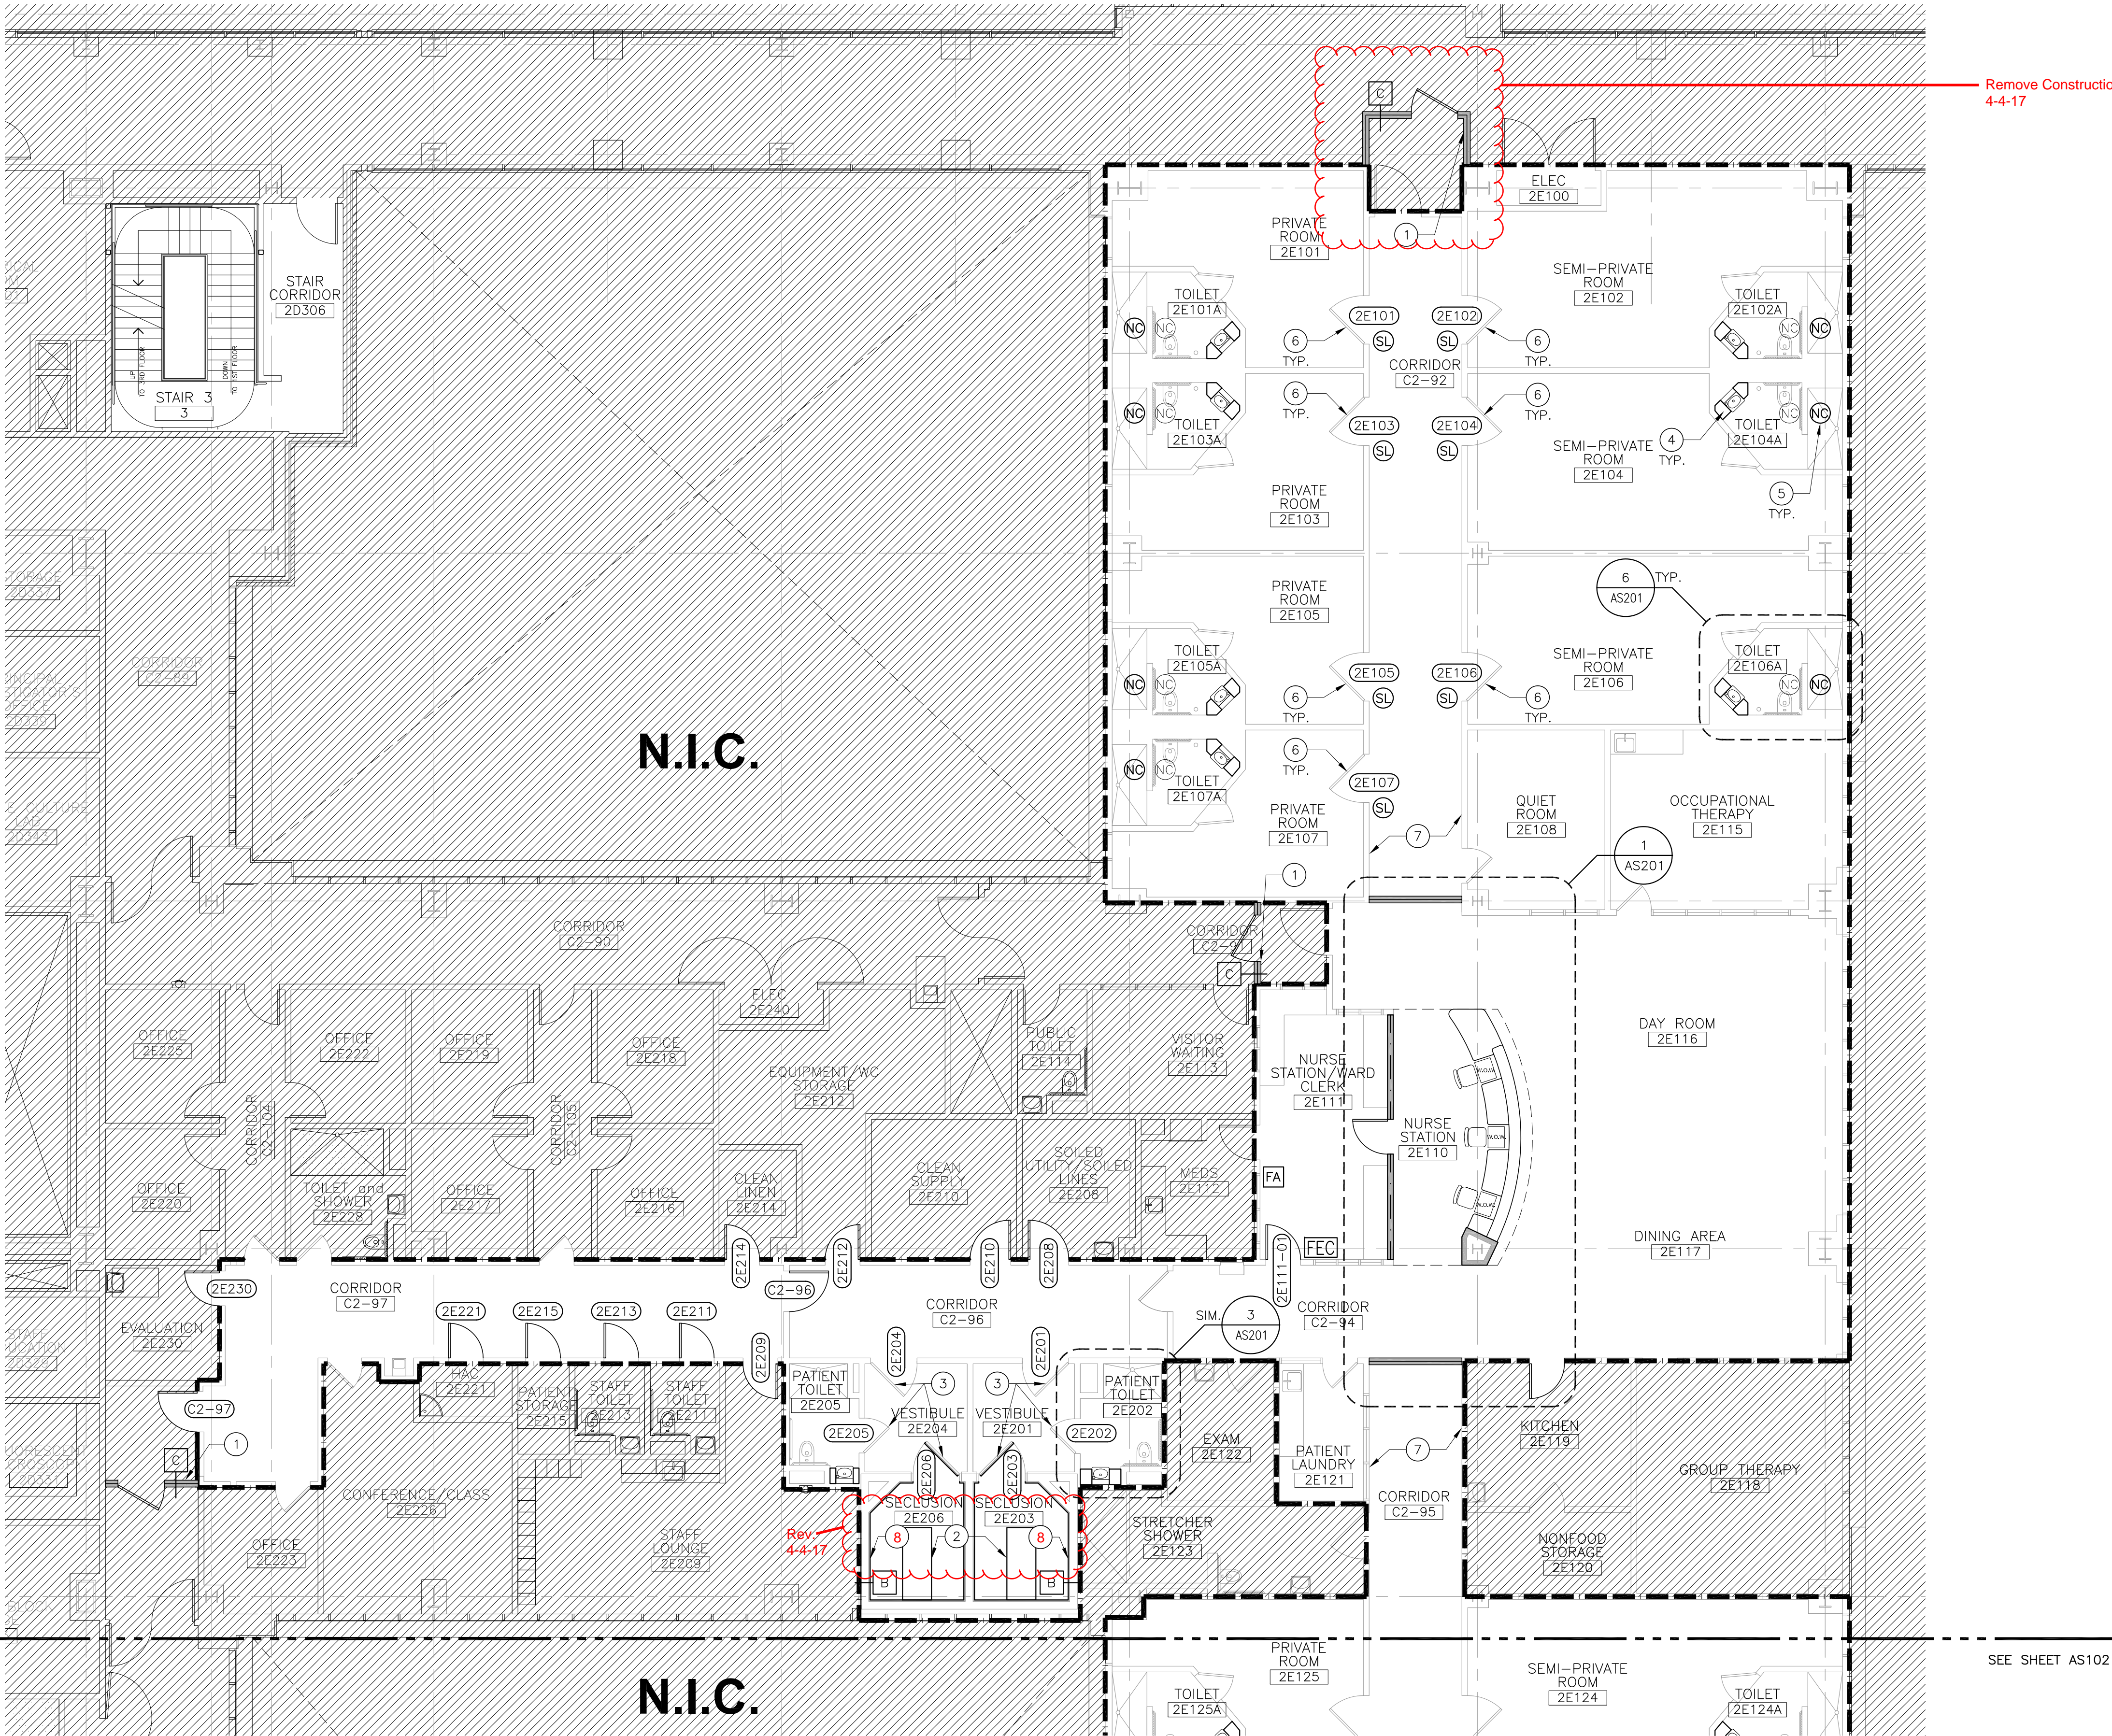

1 FLOOR PLAN - NORTH
AS101 SCALE: 1/8" = 1'-0"



KEYNOTES

- 1 CONSTRUCTION BARRIER.
- 2 RE-INSTALL BED AND ANCHOR THROUGH SAFETY PADDING TO FLOORING SUBSTRATE. SEE SHEET AS401 FOR DETAIL.
- 3 DOOR TO RECEIVE 1-3/4" UNDERCUT. REMOVE DOOR THRESHOLDS.
- 4 NEW STAINLESS STEEL COUNTER-TOPS ADJACENT TO SINK IN ALL PATIENT TOILET ROOMS.
- 5 NEW WATERPROOF NURSE CALL BUTTON IN ALL PATIENT TOILET ROOM SHOWERS. COORDINATE, TAP, AND ROUTE SERVICE LINE OF NURSE CALL BUTTON FROM EXISTING CALL BUTTON WITH ELECTRICAL.
- 6 DOOR TO RECEIVE NEW PRESSURE SENSITIVE DOOR ALARM TO BE INSTALLED ON PATIENT ROOM SIDE OF DOOR. SEE ELECTRICAL DRAWINGS AND SPECIFICATIONS.
- 7 PATCH AND REPAIR WALLS AFTER DEMOLITION. PREP WALLS TO RECEIVE NEW PAINT. SEE SHEET AF201 FOR ROOM FINISH SCHEDULE.
- 8 NEW SAFETY PADDING ON ALL WALLS AND DOOR AT SECLUSION ROOMS.


NOTES

1. CONTRACTOR TO COORDINATE AND LOCATE FOR THE A/E TEAM THE LOCATIONS OF ANY AND ALL ACCESS DOORS FOR VARIOUS MEP ITEMS FOR APPROVAL PRIOR TO ROUGH-IN. PRIME AND PAINT TO MATCH ADJACENT FINISH. SEE SHEET AF201 FOR ROOM FINISH SCHEDULE.
2. REFER TO SHEETS AF101 AND AF201 FOR WALL PROTECTION LOCATIONS AND SCHEDULE.
3. ALL DEVICES INSTALLED WITHIN THE MENTAL HEALTH WARD SHALL BE INSTALLED FLUSH WITH MOUNTING SURFACES WHERE POSSIBLE.
4. ALL DEVICES INSTALLED WITHIN THE MENTAL HEALTH WARD SHALL BE ANTI-LIGATURE AND USE SAFETY SCREWS, TAMPER RESISTANT MOUNTING HARDWARE, HOUSINGS, AND COMPONENTS.

LEGEND

- CONSTRUCTION LIMIT
- EXISTING CONSTRUCTION
- NEW CONSTRUCTION
- X PARTITION TYPE - REFER TO SHEET AS401
- XXX DOOR NUMBER - REFER TO SHEET AS501 FOR SCHEDULE
- FEC FIRE EXTINGUISHER CABINET REINSTALLED IN NURSE STATION/WARD CLERK (2E111)
- NC NEW WATERPROOF NURSE CALL BUTTON AT SHOWER
- NC EXISTING NURSE CALL BUTTON
- SL PATIENT BEDROOM DOOR ALARM STROBE LIGHT LOCATED IN CORRIDOR. SEE SHEET AS501 FOR LOCATIONS.
- FA FIRE ALARM PULL STATION. SEE MEP.

KEY PLAN

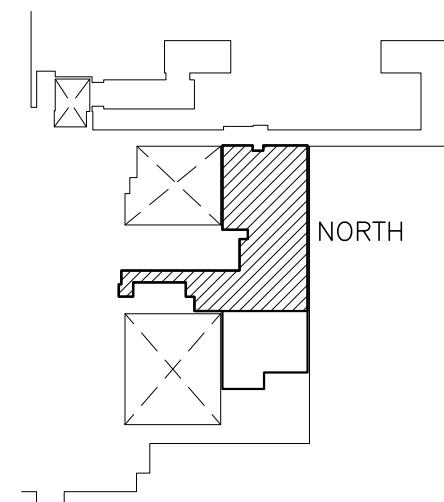

--	--	