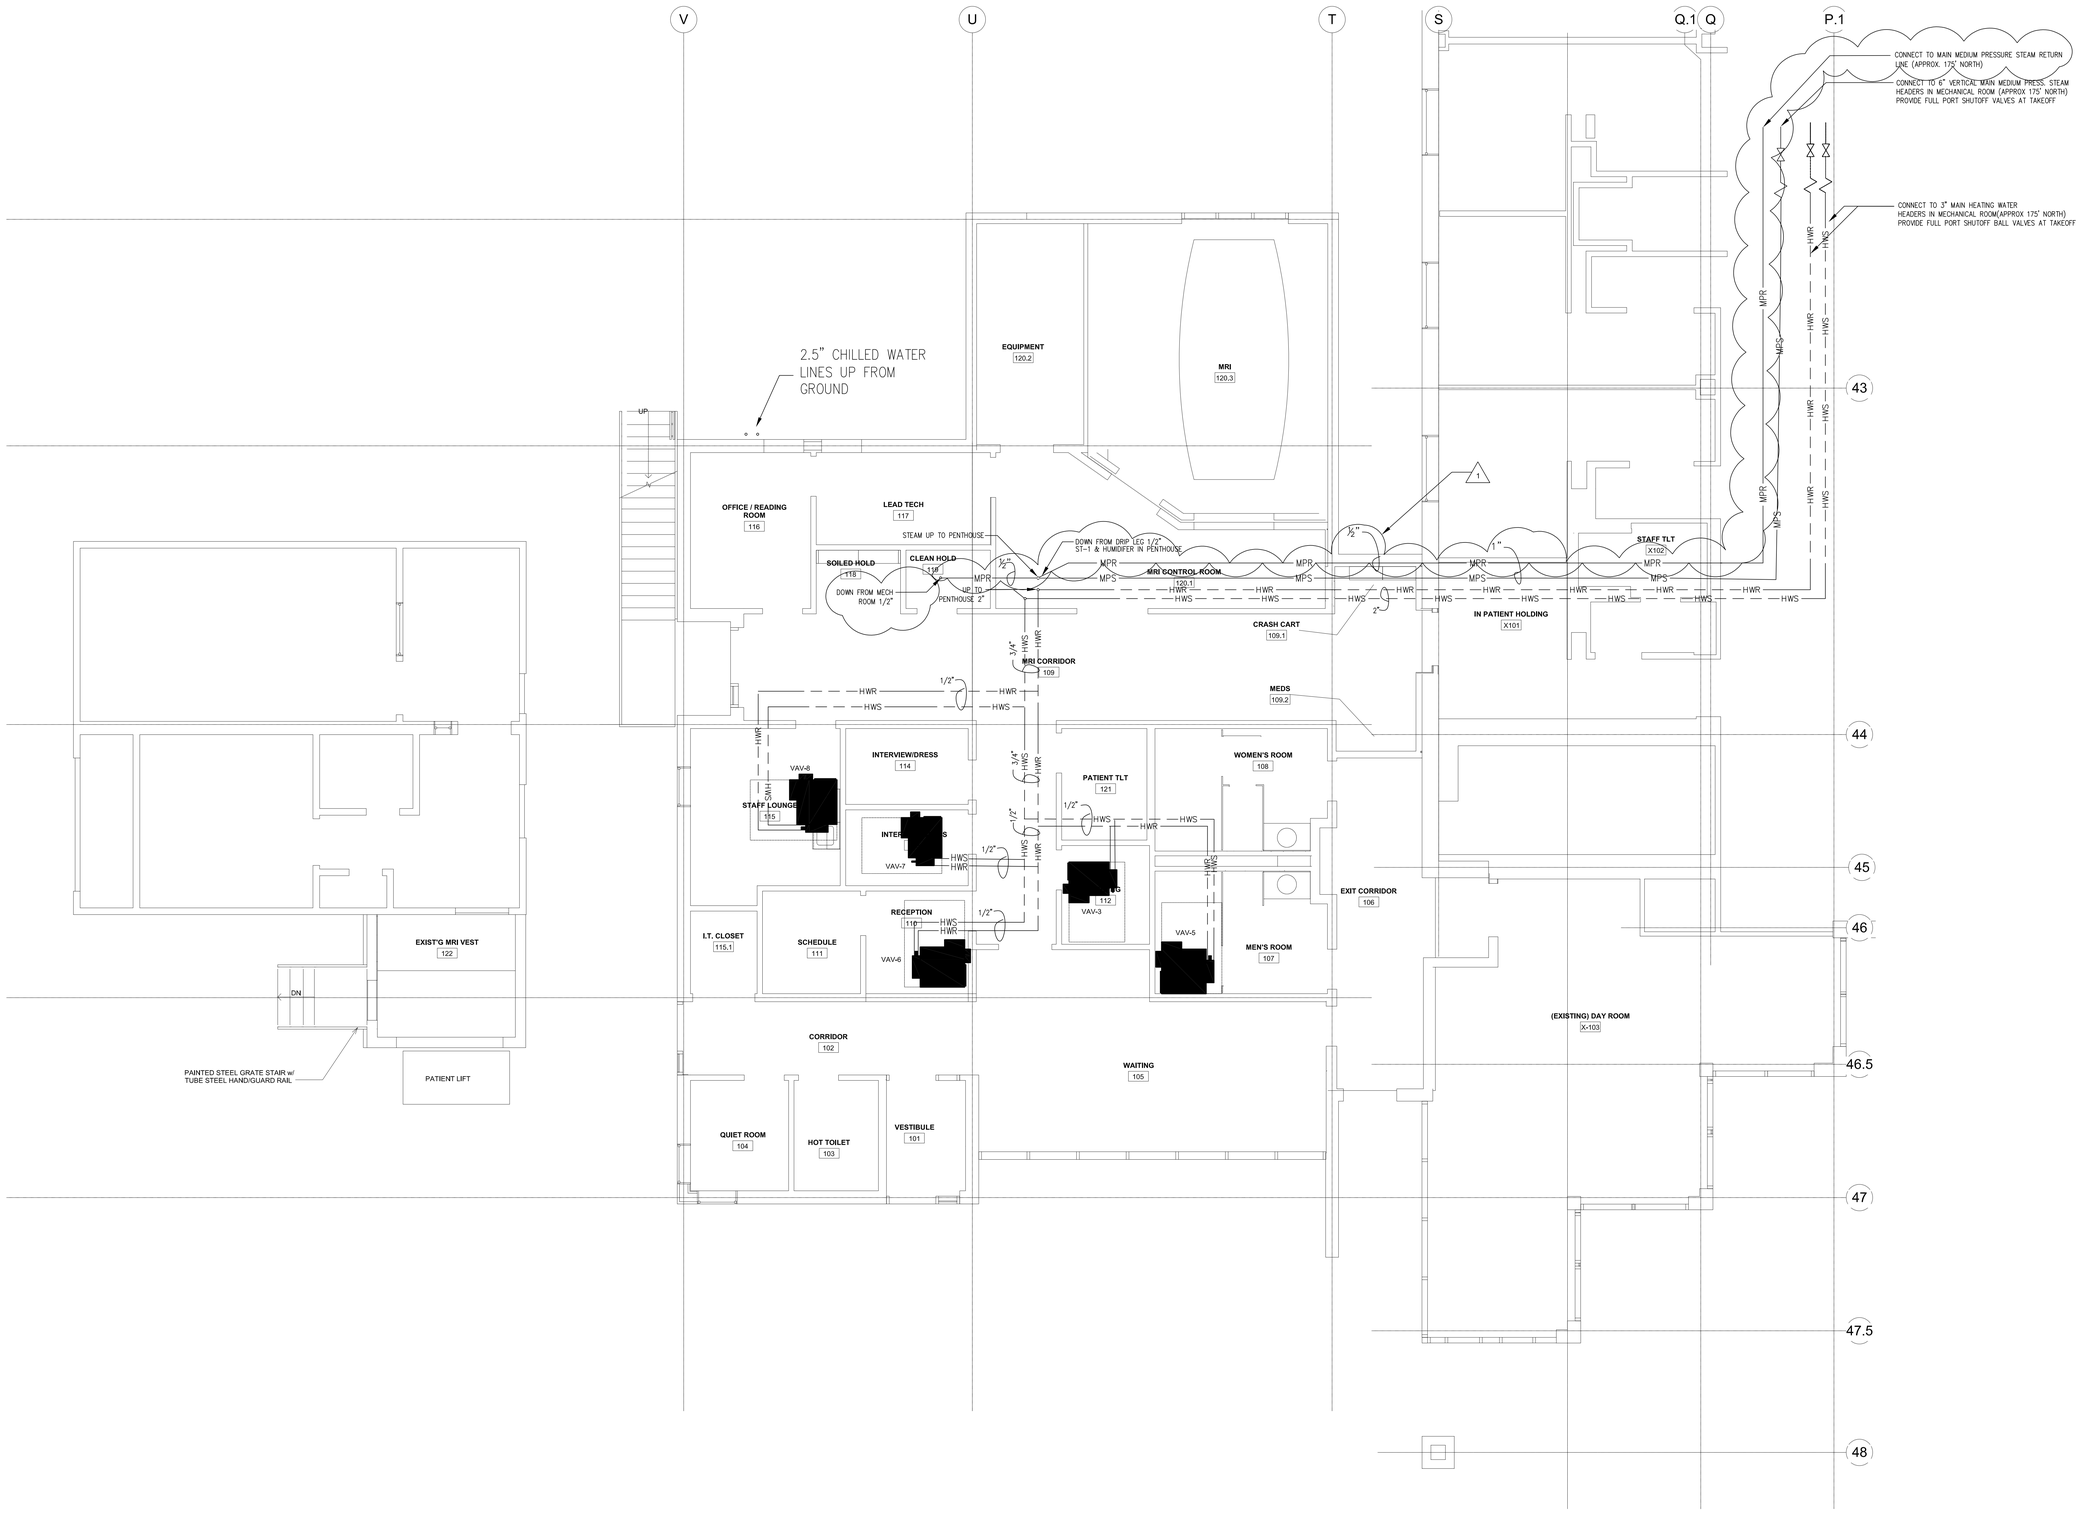

1 FIRST FLOOR HVAC PIPING PLAN

SCALE: 1/4" = 1'-0"

0 1' 2' 4' 8' 16'

No.	Description	Date
1	100% CONST. DOCS	12/30/2016
2	REVISION #1	03/28/2017

ARCHITECTS/ENGINEERS:

VALHALLA ENGINEERING GROUP, LLC

2629 West Main Street
Suite 190
Littleton, CO 80120
(720) 550-6307
www.valhallaengineering.com

CONSULTANTS:

JA JÜNK ARCHITECTS

802 Broadway - 5th Floor
Kansas City MO 64105
tele (816) 472-7722
fax (816) 472-1822
www.junkarchitects.com

COLORADO LICENSED CHARLES C. CROSBY 44106 PROFESSIONAL ENGINEER

VISN 9: MID SOUTH NETWORK
MOUNTAIN HOME VA MEDICAL CENTER

Drawing Title: **FIRST FLOOR HVAC PIPING PLAN**

Project Title: MRI/PET CLINIC & WAITING AREA

Date: 03/03/2017

Project No: 621-326

Scale: 1/4"=1'-0"

Building Number:

Checked by: JCD

Drawn by: MDC

Approved:

Location: Mountain Home VA Medical Center
809 Lamont St., Mountain Home, TN 37684

Drawing Number: **M301**

Sheet - Of 90

Department of Veterans Affairs