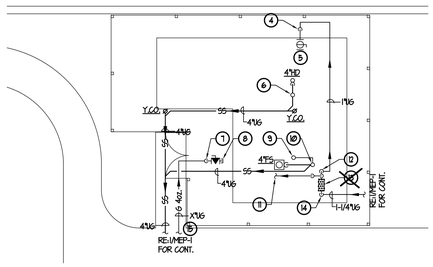

2 ENLARGED PARTIAL PLUMBING PLAN

SCALE: 1/8"=1'-0"

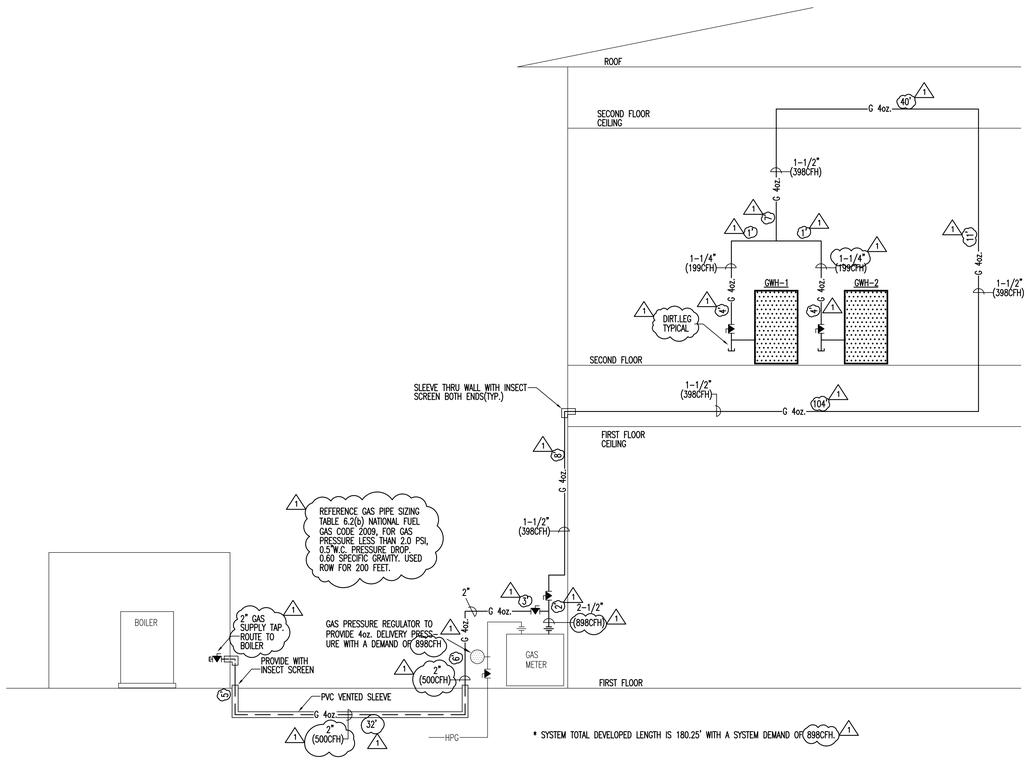

3 GAS PIPING SCHEMATIC

SCALE: NOT TO SCALE

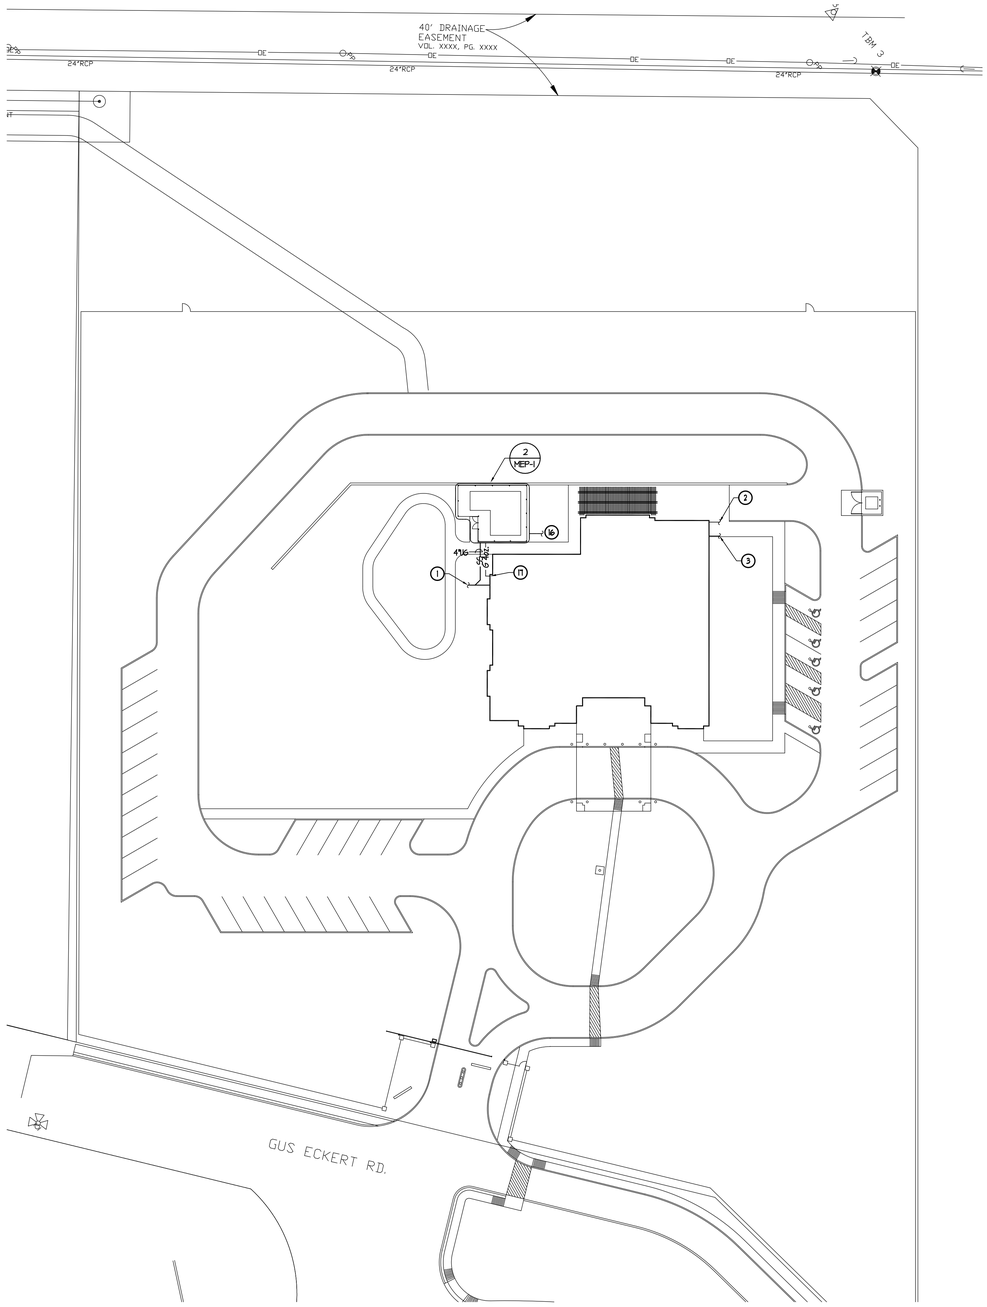

1 MECHANICAL AND PLUMBING SITE PLAN

SCALE: 1"=30'-0"

GENERAL NOTES

1. SANITARY SEWER PIPING 3" AND SMALLER WILL BE INSTALLED AT A 2% SLOPE AND SANITARY SEWER PIPING 4" AND LARGER WILL BE INSTALLED AT A 1% SLOPE.

KEYED NOTES

1. 4" SANITARY SEWER MAIN EXITING THE BUILDING @ -4.50' BELOW FINISHED FLOOR ELEVATION. REFER TO CIVIL PLANS FOR CONTINUATION.
2. 6" INCOMING FIRE MAIN. REFER TO CIVIL PLANS FOR CONTINUATION.
3. 2-1/2" INCOMING COLD WATER MAIN. REFER TO CIVIL PLANS FOR CONTINUATION.
4. 1" COLD WATER MAKE-UP WATER LINE FROM BELOW.
5. 1" COLD WATER CHILLER MAKE-UP WATER LINE TAP. EXTEND AND CONNECT AS REQUIRED. FIELD COORDINATE FINAL POINT OF CONNECTION.
6. 4" WASTE DOWN AND 2" VENT UP THRU ROOF.
7. 2" GAS LINE FROM BELOW.
8. 2" GAS LINE TAP FOR BOILER. EXTEND AND CONNECT AS REQUIRED. FIELD COORDINATE FINAL POINT OF CONNECTION.
9. 2" VENT UP THRU ROOF.
10. 4" WASTE DOWN AND 2" VENT UP.
11. 1" COLD WATER BOILER MAKE-UP WATER LINE TAP. EXTEND AND CONNECT AS REQUIRED. FIELD COORDINATE FINAL POINT OF CONNECTION.
12. 1" COLD WATER MAKE-UP WATER LINE DOWN.
13. 1-1/4" REDUCED PRESSURE PRINCIPLE BACKFLOW PREVENTER. SUPPORT FROM CEILING WITH THE USE OF PIPE SUPPORT STANCHIONS. ROUTE DRAIN LINE FULL SIZE TO 4"FS.
14. 1-1/4" COLD WATER LINE FROM BELOW.
15. GAS LINE SHALL BE INSTALLED IN A PVC SLEEVE THAT IS VENTED TO ATMOSPHERE AT BOTH ENDS.
16. 1-1/4" COLD WATER MAKE-UP WATER LINE. REFER TO CIVIL PLANS FOR CONTINUATION.
17. REFER TO I/P1.1 FOR CONTINUATION OF GAS PIPING AND GAS METER LOCATION.

RECORD DRAWINGS

DATE: NOVEMBER 16, 2012

THESE AS-BUILT DOCUMENTS HAVE BEEN PREPARED BASED ON INFORMATION PROVIDED BY THE CONTRACTOR LOEBIG GENERAL CONTRACTORS, LTD.I THE ARCHITECT/ ENGINEER HAS NOT VERIFIED THE ACCURACY AND/OR COMPLETENESS OF THIS INFORMATION AND SHALL NOT BE RESPONSIBLE FOR ANY EFFORTS OR OMISSIONS THAT MAY BE INCORPORATED AS RESULT OF INCORRECT INFORMATION PROVIDED BY THE CONTRACTOR.

Revisions	Date
1 ASI #6	04/04/11
2 RFI No. 097	11/09/11

CONSULTANTS:

TEXAS REGISTERED ENGINEERING FIRM F-10487
700 N. ST. MARY'S
SUITE 1225
SAN ANTONIO, TX 78205
WWW.RGMENGINEERING.NET
PHONE: 210.299.4522
FAX: 210.299.4525

Approved: Assistant Director	Approved: Chief of Staff	Approved: Chief, Engineering
Approved: Service Chief	Approved: Service Chief	Approved: Service Chief
Approved: Chief, BioMed	Approved: Chief, EMS	Approved: Chief, Infection Control
Approved: Chief, IT	Approved: Chief, M & O	Approved: Chief, Police
Approved: Chief, Safety	Approved: Chief	Approved: Chief

ARCHITECT:

WESTEAST DESIGN GROUP
1617 E. COMMERCE ST., SUITE 7102, SAN ANTONIO, TEXAS 78205 USA
210.530.0755 FAX. 210.530.9427

These documents can not be copied or reproduced without written consent from WestEast Design Group

Drawing Title	MECHANICAL AND PLUMBING SITE PLAN
Approved: Project Director	
Project Title	POLYTRAUMA TRANSITIONAL HOUSING
Location	Audie L. Murphy Memorial Veterans Hospital San Antonio, Texas
Date	28 JULY 2010
Checked	
Drawn	
Project Number	671-237
Building Number	1
Drawing Number	MP1.1
	Dwg. 1 of 2

Office of Facilities Management

Department of Veterans Affairs

VA FORM 08-6231, OCT 1978