# KEYED NOTES

1. CHILLED WATER SUPPLY AND RETURN PIPES DOWN IN CHASE.
2. HOT WATER SUPPLY AND RETURN PIPES DOWN IN CHASE.
3. CHILLED WATER SUPPLY AND RETURN PIPES UP TO ROOFTOP UNIT ON ROOF.

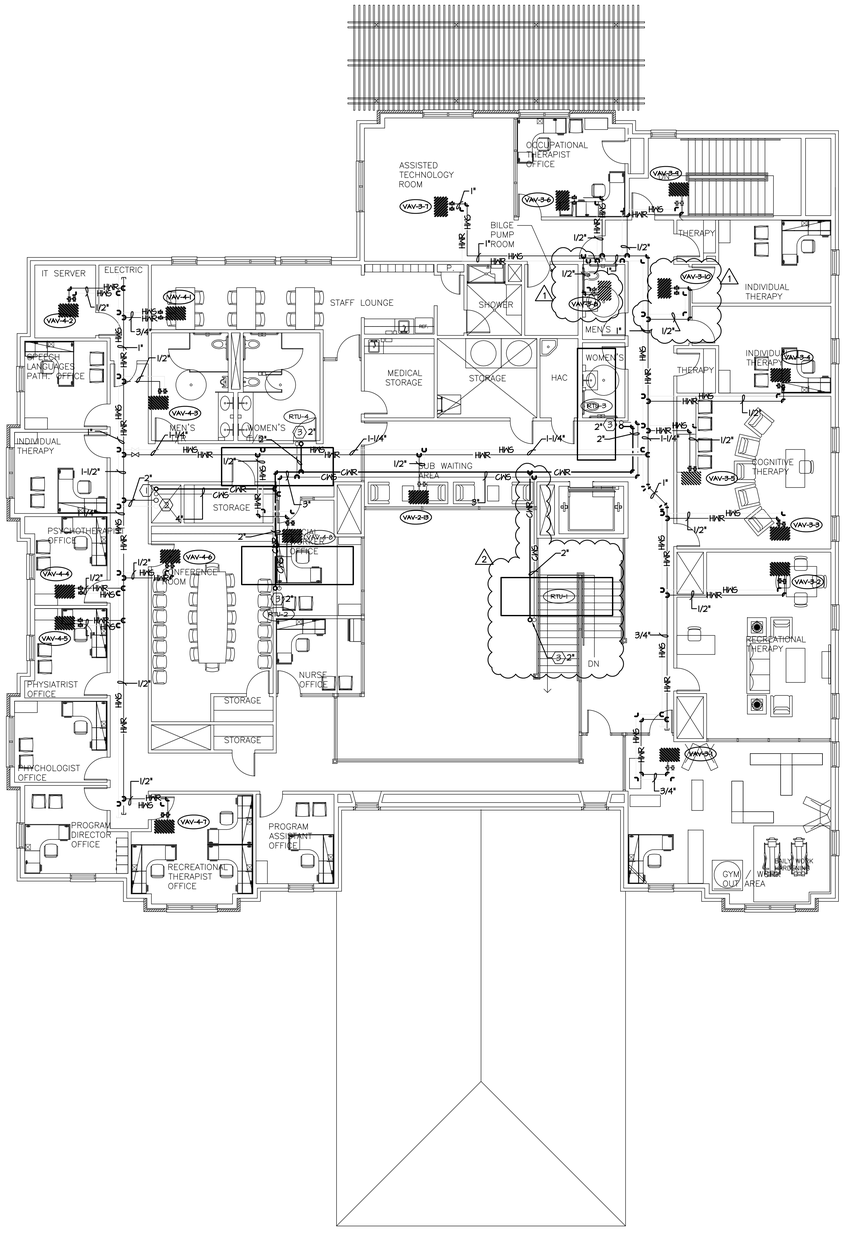


## 1 SECOND FLOOR MECHANICAL PLAN - CHILLED WATER & HOT WATER PIPING

SCALE: 1/8"=1'-0"

RECORD DRAWINGS

DATE: NOVEMBER 16, 2012

THESE AS-BUILT DOCUMENTS HAVE BEEN PREPARED BASED ON INFORMATION PROVIDED BY THE CONTRACTOR (ACERO GENERAL CONTRACTORS, LTD.). THE ARCHITECT/ ENGINEER HAS NOT VERIFIED THE ACCURACY AND/OR COMPLETENESS OF THIS INFORMATION AND SHALL NOT BE RESPONSIBLE FOR ANY ERRORS OR OMISSIONS THAT MAY BE INCORPORATED AS RESULT OF INCORRECT INFORMATION PROVIDED BY THE CONTRACTOR.

| Revisions: | Date |
|---|---|
| 1 ASI#2 | 04/04/11 |
| 2 ASI#3 | 04/04/11 |

CONSULTANTS:

TEXAS REGISTERED ENGINEERING FIRM F-10487
700 N. ST. MARY'S
SUITE 1225
SAN ANTONIO, TX 78205
WWW.RGMENGINEERING.NET
PHONE: 210.299.4522
FAX: 210.299.4525

| | | |
|---|---|---|
| Approved: Assistant Director | Approved: Chief of Staff | Approved: Chief, Engineering |
| Approved: Service Chief | Approved: Service Chief | Approved: Service Chief |
| Approved: Chief, BioMed | Approved: Chief, EMS | Approved: Chief, Infection Control |
| Approved: Chief, IT | Approved: Chief, M & O | Approved: Chief, Police |
| Approved: Chief, Safety | Approved: Chief | Approved: Chief |

ARCHITECT:

WESTEAST DESIGN GROUP

1617 E. COMMERCE ST., SUITE 7102, SAN ANTONIO, TEXAS 78205 USA
210.530.0755 FAX: 210.530.9427

These documents can not be copied or reproduced without written consent from WestEast Design Group

Drawing Title: SECOND FLOOR MECHANICAL PLAN PIPING SCHEMATIC

Approved: Project Director

Project Title: POLYTRAUMA TRANSITIONAL HOUSING

Location: Audie L. Murphy Memorial Veterans Hospital, San Antonio, Texas

Date: 28 JULY 2010 | Checked | Drawn

Project Number: 671-237

Building Number: 1

Drawing Number: MH2.2

Dwg. 5 of 10

Office of Facilities Management

Department of Veterans Affairs

VA FORM 08-6231, OCT 1978