



Copyright © RAMTECH-Engineers, P.C.
one eighth inch = one foot
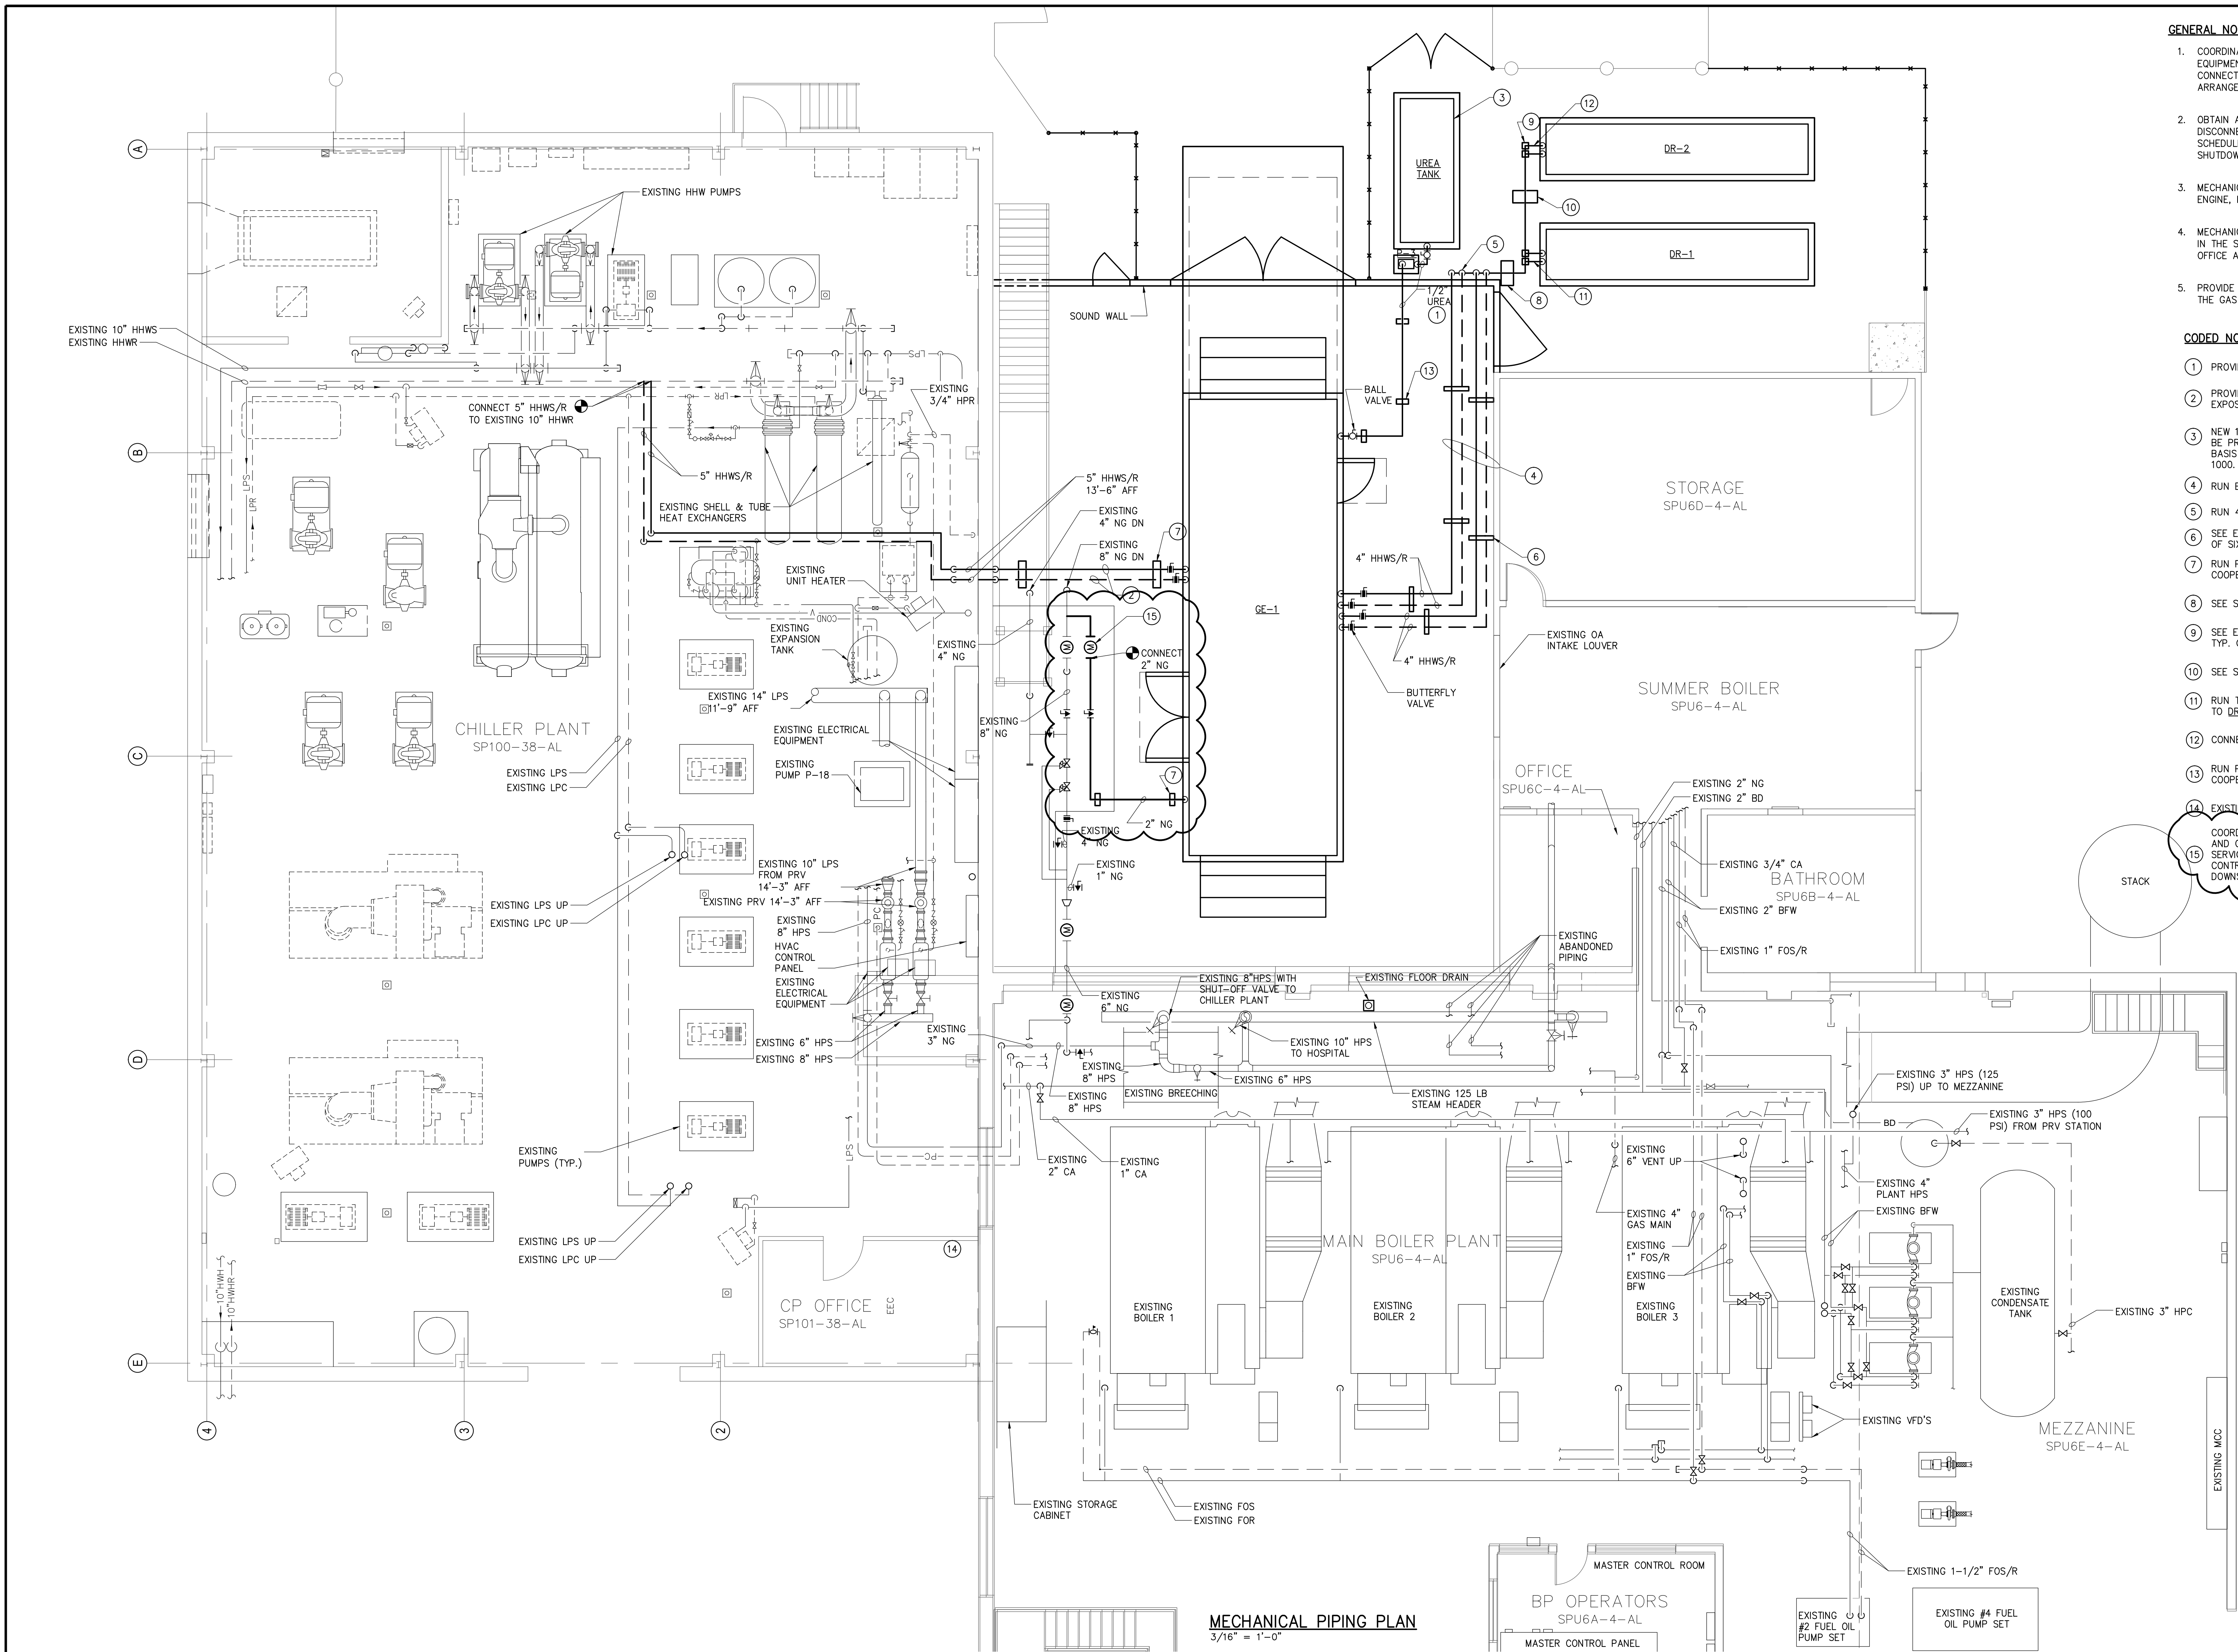

- GENERAL NOTES**
- COORDINATE PIPING ARRANGEMENT/PENETRATIONS WITH EQUIPMENT MANUFACTURER. EQUIPMENT MANUFACTURER SHALL PROVIDE PREFABRICATED FLANGES FOR PIPING CONNECTIONS. PREFABRICATED FLANGES SHALL BE LOCATED USING THE PIPING ARRANGEMENT SHOWN ON FLOOR PLAN.
 - OBTAIN AUTHORIZATION AND CONFIRMATION FROM THE OWNER PRIOR TO DISCONNECTING OR REMOVING ANY EQUIPMENT OR ITEMS. COORDINATE AND SCHEDULE NECESSARY RELATED SYSTEM SHUTDOWN WITH OWNER. MINIMIZE SHUTDOWN TIME AND LIMIT IMPACT TO BUILDING.
 - MECHANICAL CONTRACTOR IS RESPONSIBLE FOR PIPING TO AND FROM THE GAS ENGINE, RADIATORS AND UREA TANK.
 - MECHANICAL CONTRACTOR CAN USE APPROXIMATELY 50% OF CP OFFICE LOCATED IN THE SOUTHEAST CORNER OF CHILLER PLANT FOR THE GC SUPERINTENDENT OFFICE AND RESTROOMS ARE AVAILABLE IN THE BOILER PLANT.
 - PROVIDE FLANGED FLEXIBLE CONNECTORS AT ALL PIPING CONNECTION POINTS TO THE GAS ENGINE.

- CODED NOTES**
- PROVIDE HEAT TRACING FOR ALL UREA PIPING.
 - PROVIDE HEAT TRACING FOR ALL SECONDARY LOOP PIPING EXPOSED TO THE OUTDOORS.
 - NEW 1000 GALLON POLYETHYLENE UREA TANK WITH STAND TO BE PROVIDED BY GAS ENGINE EQUIPMENT MANUFACTURER. BASIS OF DESIGN: ASSMANN CORP OF AMERICA, MODEL IHT 1000.
 - RUN ELEVATED PIPING AT 13 FT ABOVE GRADE.
 - RUN 4" HHWS/R DOWN AND TURN 90°.
 - SEE ELEVATED PIPE SUPPORT DETAIL ON SHEET M-501. TYP. OF SIX.
 - RUN PIPING ON THE GROUND. PIPE SUPPORTS SHALL BE COOPER INDUSTRIES MODEL DB10. TYP. FOR TWO.
 - SEE STACKED FOUR PIPE SUPPORT DETAIL ON SHEET M-501. TYP. OF FOUR.
 - SEE ELBOW SUPPORT BRACKET DETAIL ON SHEET M-501. TYP. OF FOUR.
 - SEE STACKED TWO PIPE SUPPORT DETAIL ON SHEET M-501.
 - RUN THE TWO HIGHEST HHWS/R PIPES DOWN AND CONNECT TO DR-1.
 - CONNECT HHWS/R PIPES TO DR-2.
 - RUN PIPING ON THE GROUND. PIPE SUPPORTS SHALL BE COOPER INDUSTRIES MODEL DB10. TYP. FOR THREE.
 - EXISTING AUTOMATED LOGIC HVAC CONTROL SYSTEM PANEL.
 - COORDINATE GAS SERVICE CONNECTION WITH NATIONAL GRID AND OWNER. OWNER SHALL BE RESPONSIBLE FOR GAS SERVICE ALTERATIONS AND INSTALLATION OF METER. CONTRACTOR SHALL BE RESPONSIBLE FOR ALL PIPING DOWNSTREAM OF CONNECTION TO METER.

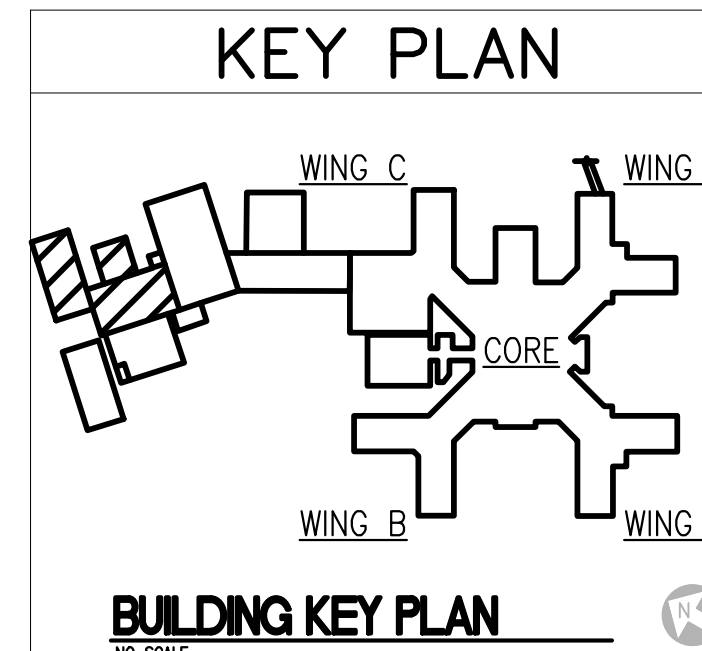

		CONSULTANTS:				ARCHITECT/ENGINEERS:		Drawing Title		Project Title		Project Number		<div>Office of Facilities Management</div> <div> Department of Veterans Affairs</div>	
								Approved Project Director		Location		Drawing Number			
ADDENDUM #3 (UTILITY COMMENTS)		04/7/17								VAMC ALBANY, NY		M-101			
BID SET		06/21/16													
100% SUBMISSION		04/29/16													
95% SUBMISSION (RECIPROCATING ENGINE DESIGN)		04/06/16													
Revisions		Date								Date		Dwg. 3 of 6			