



three inches = one foot
one and one half inches = one foot
one inch = one foot
three quarters inch = one foot
one half inch = one foot
three eighths inch = one foot
one quarter inch = one foot
one eighth inch = one foot

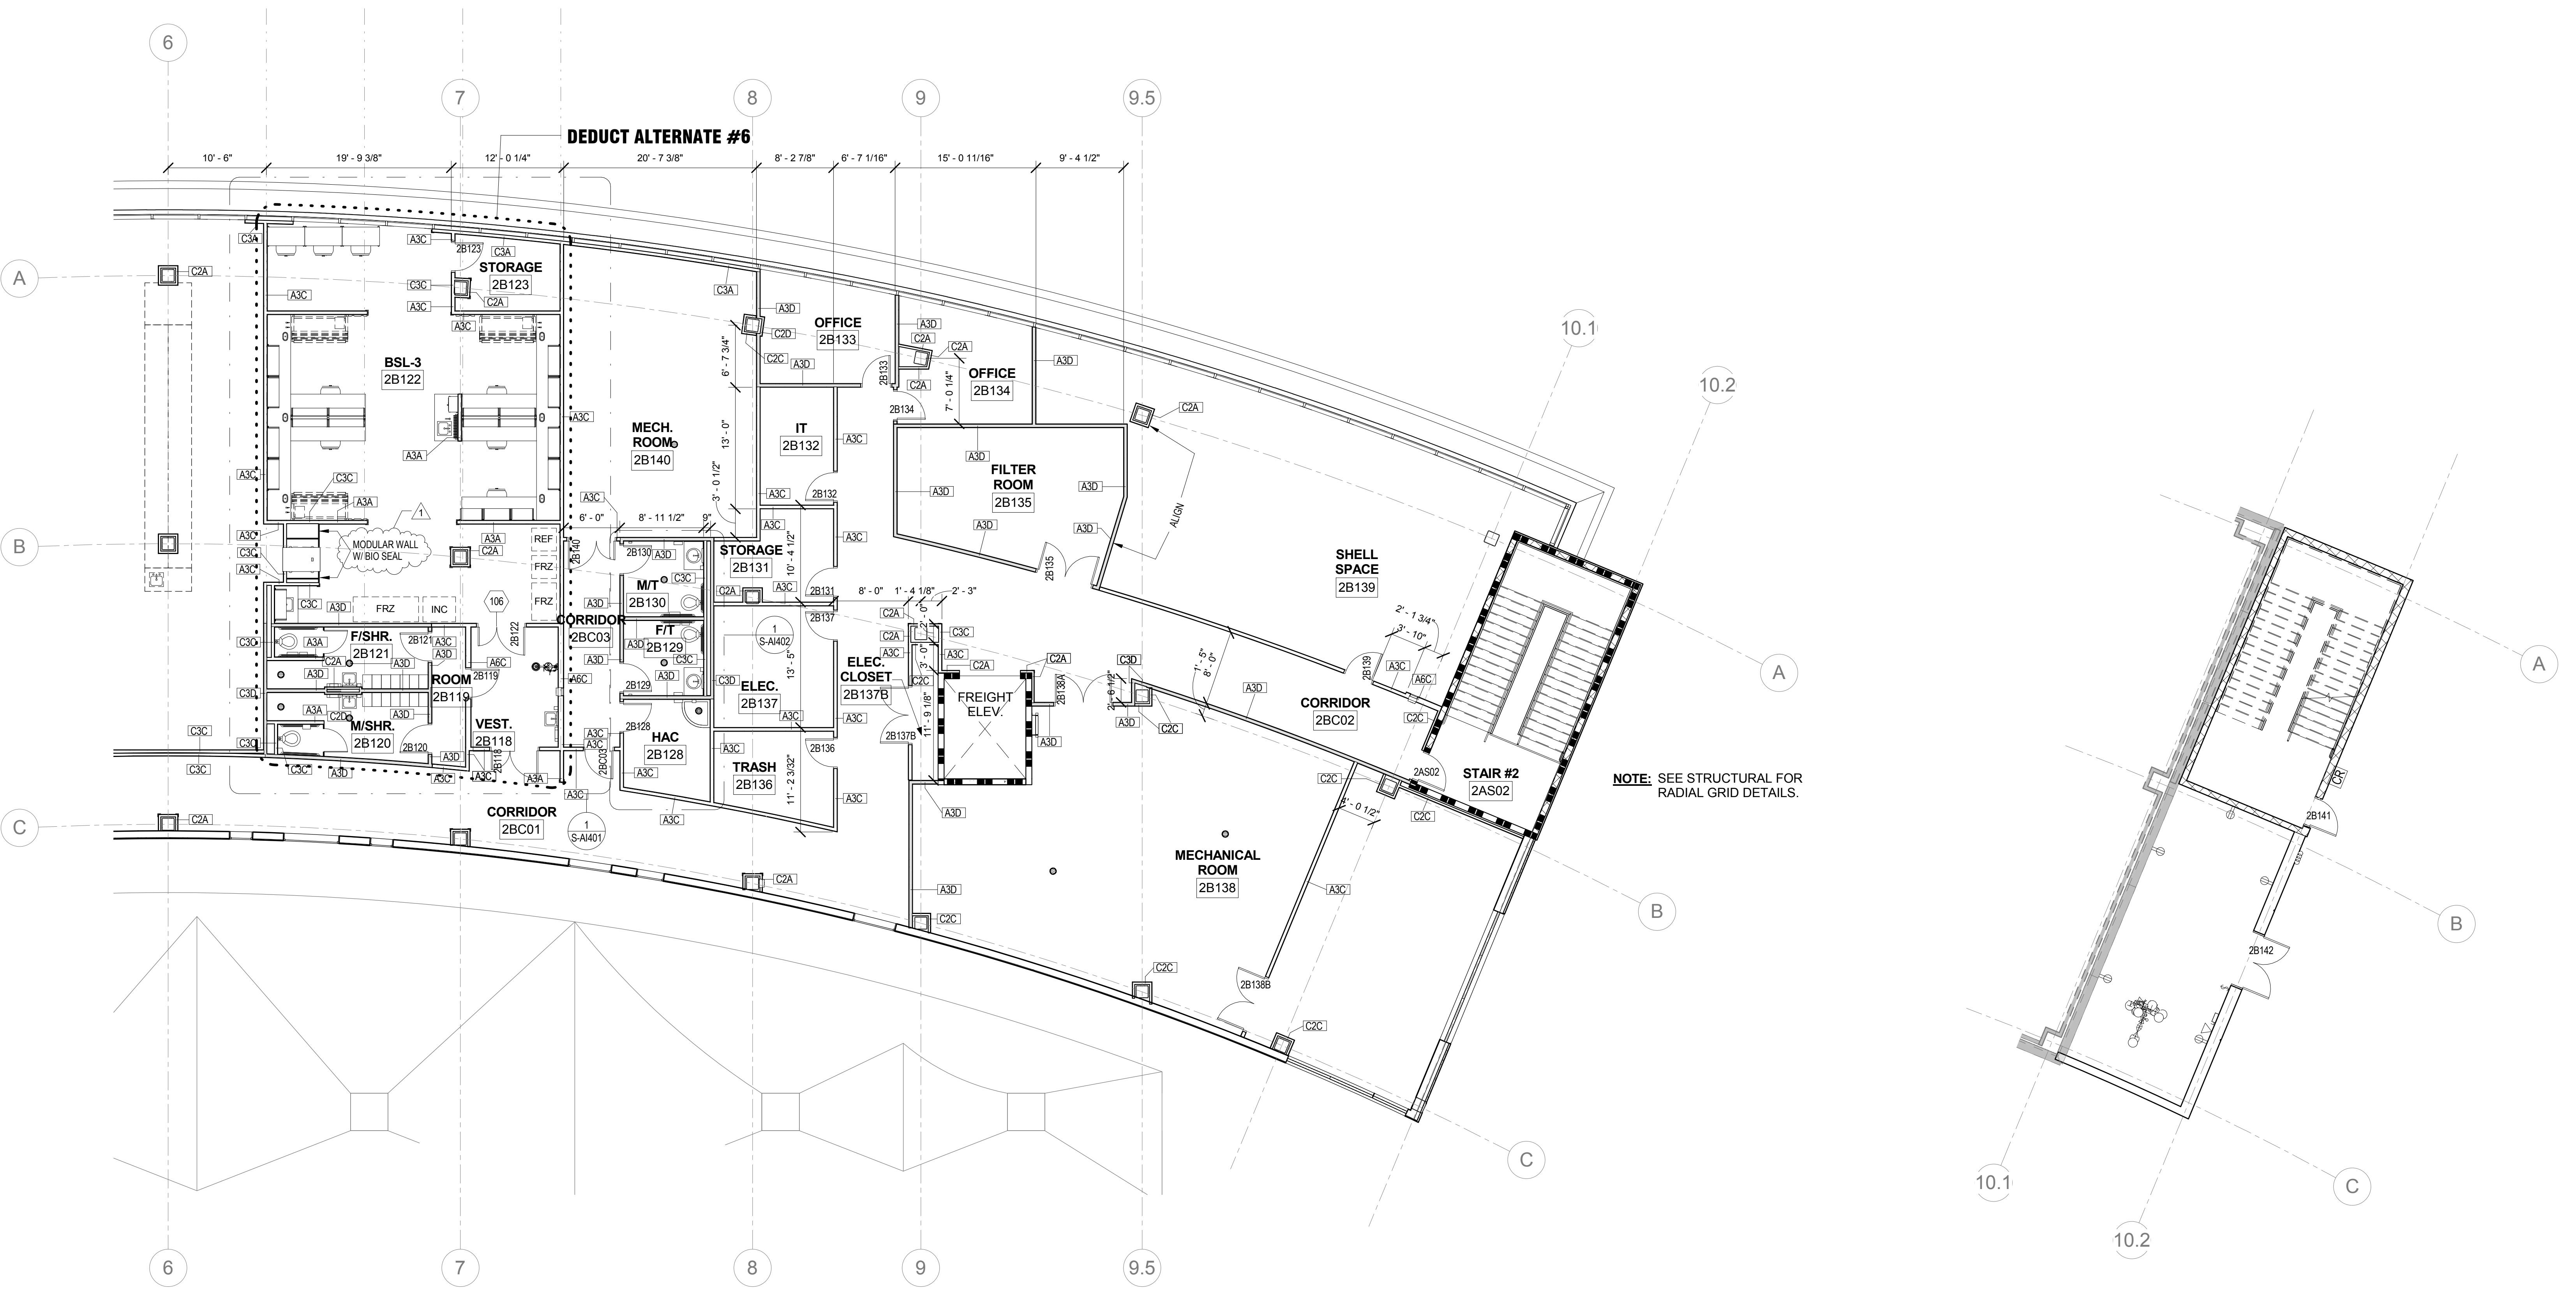

1 LEVEL 2 - AREA C - PARTITION AND DIMENSION PLAN
1/8" = 1'-0"

2 LEVEL 1 - AREA C PARTIAL- ARCHITECTURAL PLAN
1/8" = 1'-0"

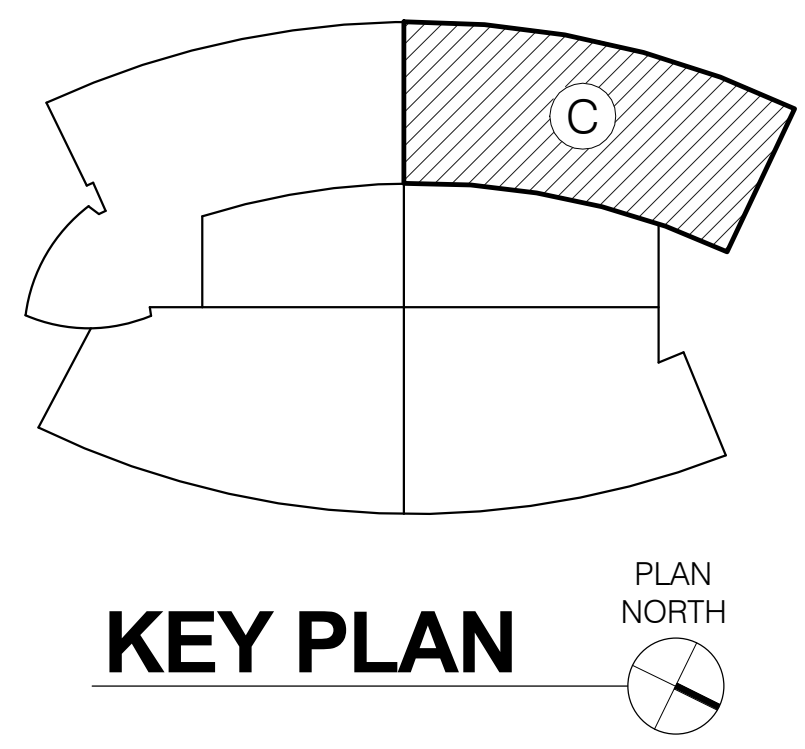

FLOOR PLAN NOTES

- DIMENSIONS ARE TO THE FACE OF PARTITION/EQUIPMENT/EXISTING ELEMENT, CENTERLINE OR CLEAR JAMB OPENING OF DOORS, OR STRUCTURAL GRID. DO NOT SCALE DRAWINGS
- REFER TO S-A1700 THROUGH S-A1702 FOR PARTITION TYPES. REFER TO GENERAL NOTES ON S-A1700 THROUGH S-A1702 FOR WALL BOARD APPLICATION TYPES.
- REFER TO S-AF101 AND S-AF102 FOR FINISH INFORMATION.

SHEET KEYNOTES

106 RECESSED EXIT SIGN CENTERED OVER DOOR. COORDINATE FRAMING FOR FIXTURE INSTALLATION.

FLOOR PLAN SYMBOLS

- ONE HOUR FIRE RATED PARTITION
- TWO HOUR FIRE RATED PARTITION
- PARTITION TAG SEE S-A1700 THROUGH S-A1702
- DOOR OPENING MARK DOOR OPENING
- FIRE EXTINGUISHER CABINET
- FIRE EXTINGUISHER (MOUNT 3'-6" AFF)
- AREA OUTSIDE ARCHITECTURAL CONTRACT LIMITS

| | | | | | | | |
|-----------------------------|--------------|--|--|---|--|-----------------------------------|--|
| ADDENDUM 1 April 7, 2017 | CONSULTANTS: | ARCHITECT-OF-RECORD THOMAS H. GYLLSTROM FL REG. NO. 9598 | ARCHITECT/ENGINEERS: AKEA INC. 3603 NW 98th Street, Suite B Gainesville, FL 32606 Phone: (352) 474-6124 Fax: (352) 474-6324 AKEA Project No. 039-12 | Drawing Title LEVEL 2 - AREA C - PARTITION AND DIMENSION PLAN | Project Title VAMC AT LAKE NONA BUILD NEW RESEARCH SPACE | Project Number 675-900 | Office of Construction and Facilities Management Department of Veterans Affairs |
| Revisions: | | | | Approved: Project Director | Location Orlando, Florida | Building Number 13 | |
| Date | | | | Date JUNE 17, 2016 | Checked TW | Drawn JH | |
| | | | | | | Drawing Number S-A1112C | 21 OF 176 |

VA FORM 08-6231