


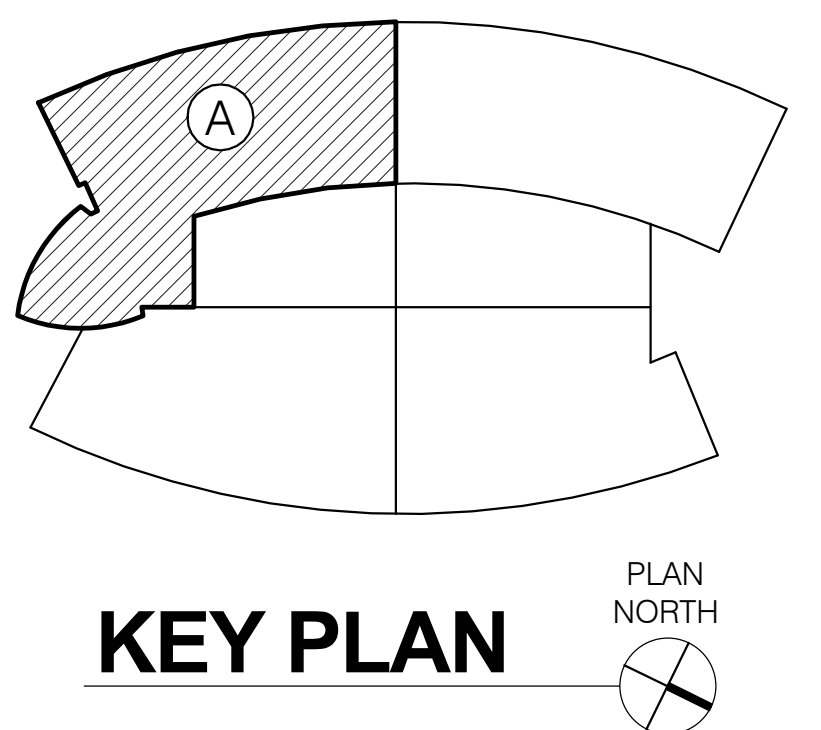


## SHEET KEYNOTES

## FLOOR PLAN SYMBOLS




FINAL DESIGN  
APPROVED FOR CONSTRUCTION

Office of  
Construction  
and Facilities  
Management

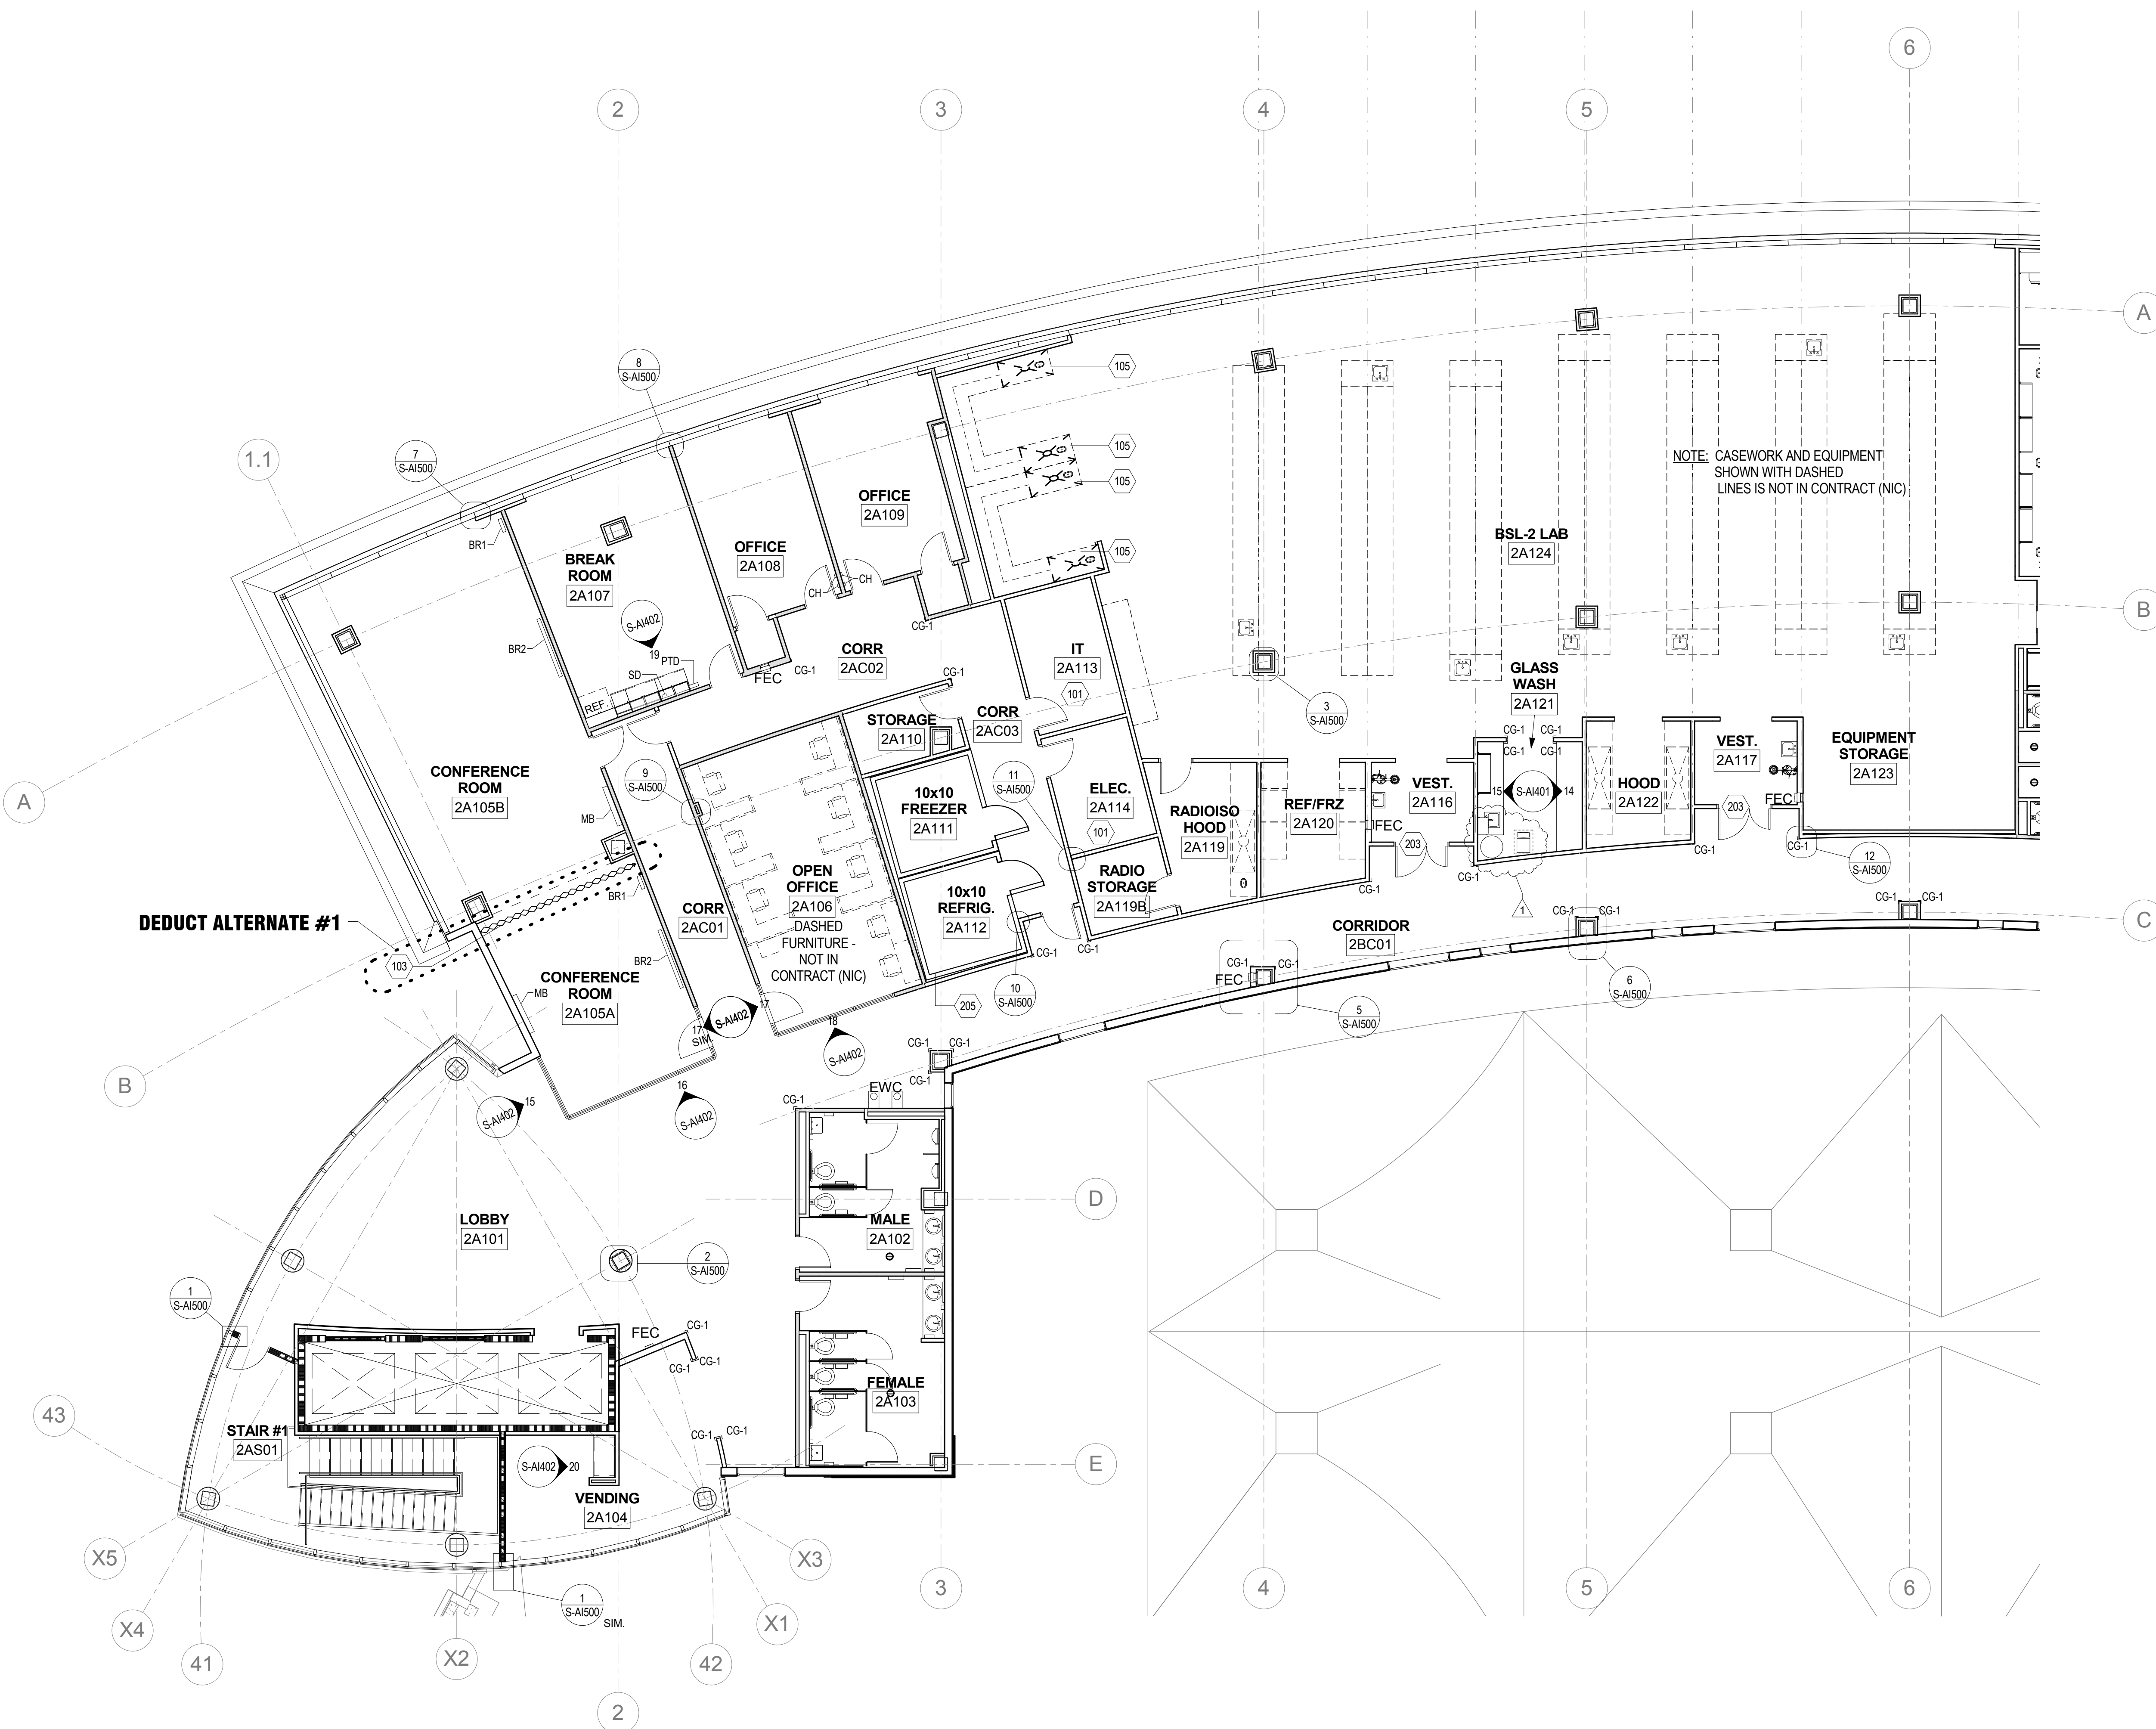

	ADDENDUM 1	April 7, 2017
<b>Revisions:</b>		<b>Date</b>

CONSULTANTS:

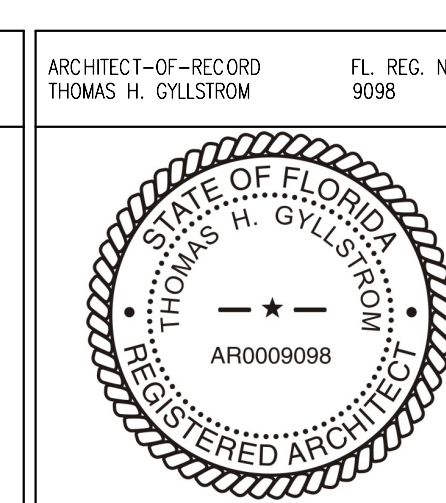

ARCHITECT/ENGINEERS:

Drawing Title

**LEVEL 2 - AREA A - ARCHITECTURAL PLAN**

Approved: Project Director

Project Title		
<b>VAMC AT LAKE NONA BUILD NEW RESEARCH SPACE</b>		
Location		
<b>Orlando, Florida</b>		
Date	Checked	Drawn
JUNE 17, 2016	TW	JH

Project Number	675-900
Building Number	13
Drawing Number	S-AI102A 18 OF 176