


three inches = one foot
one and one half inches = one foot
one inch = one foot
three quarters inch = one foot
one half inch = one foot
three eighths inch = one foot
one quarter inch = one foot
one eighth inch = one foot

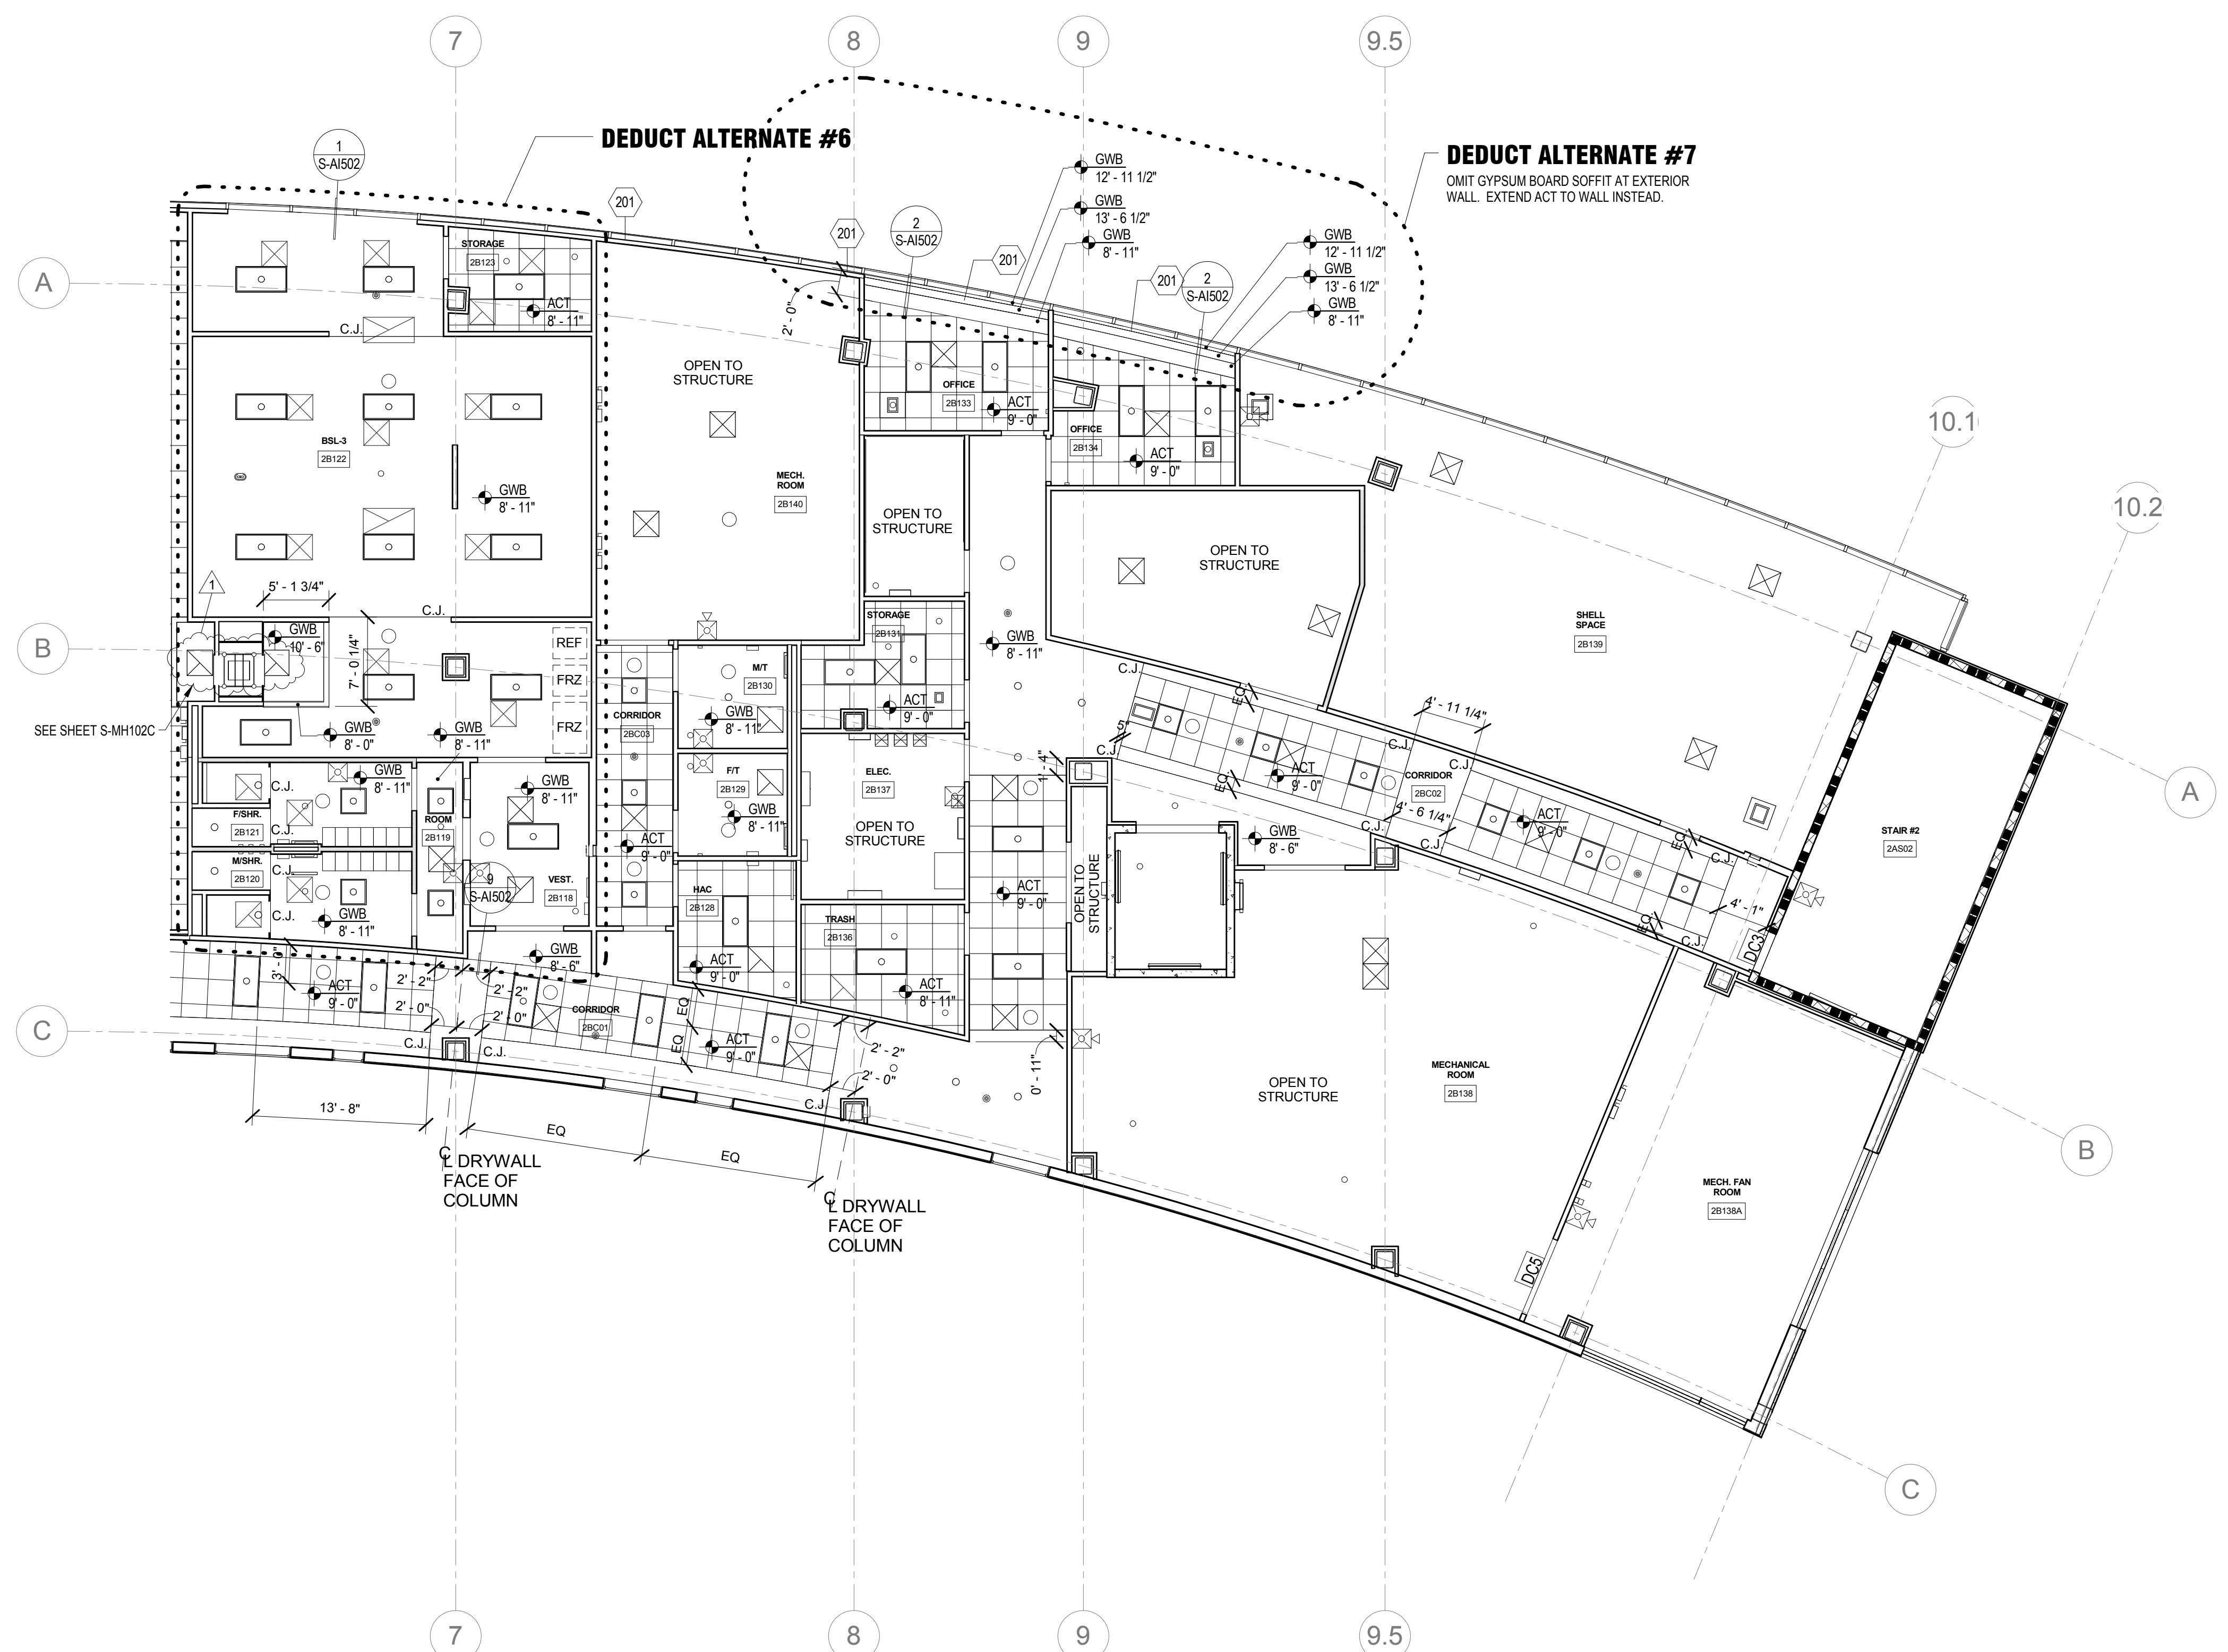

1 SECOND FLOOR RCP - SOUTH
1/8" = 1'-0"

CEILING PLAN NOTES


- REFER TO SPECIFICATIONS FOR PRODUCT AND MATERIAL INFORMATION. REFER TO INDIVIDUAL SECTIONS FOR MATERIAL SELECTION KEY CODES AND COLOR SCHEDULE(S).
- REFER TO ENGINEERING DRAWINGS AND SPECIFICATIONS FOR FIXTURE AND EQUIPMENT SCHEDULES.
- CEILING MOUNTED DEVICES (LIGHT FIXTURES, DIFFUSERS, SPRINKLER HEADS, ETC.) TO BE CENTERED IN CEILING TILES UNLESS NOTED OTHERWISE.
- SEE S-AI502 FOR TYPICAL CEILING DETAILS.

SHEET KEYNOTES

201	IWS-1, MANUAL OPERATION: FULL WIDTH OF WINDOW. SEE SPECIFICATION.
-----	---

REFLECTED CEILING PLAN SYMBOLS

	CEILING TAG WITH CEILING HEIGHT. HEIGHT INDICATED IS ABOVE FINISH FLOOR. SEE ROOM FINISH SCHEDULE FOR ACT TYPE.
	2x2' RECESSED LIGHT FIXTURE
	2x4' RECESSED LIGHT FIXTURE
	1x4' RECESSED LIGHT FIXTURE
	RECESSED DOWNLIGHT
	FIRE PROTECTION-SPRINKLER HEAD
	FIRE PROTECTION-FIRE ALARM DEVICE
	PENDANT / SUSPENDED LIGHT FIXTURE
	HVAC SUPPLY GRILLE
	HVAC RETURN GRILLE
	HVAC SWITCHED EXHAUST GRILLE
	HVAC SUPPLY/RETURN LINEAR DIFFUSER
	ACCESS PANEL
	EXIT SIGN SINGLE-SIDED
	EXIT SIGN DOUBLE-SIDED
	CONTROL JOINT

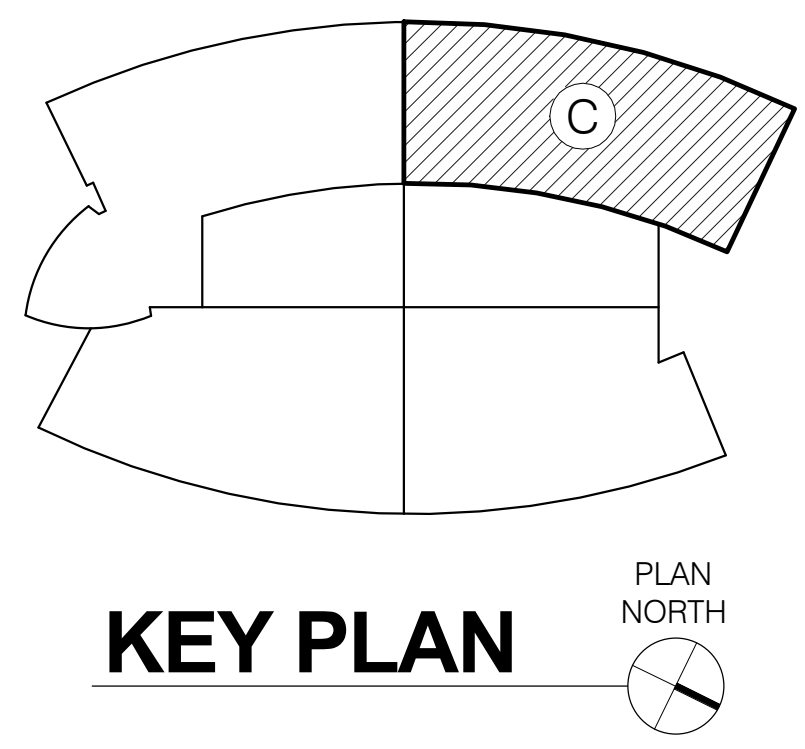

FINAL DESIGN
APPROVED FOR CONSTRUCTION

ADDENDUM 1 April 7, 2017	CONSULTANTS:	ARCHITECT-OF-RECORD THOMAS H. GYLLSTROM FL REG. NO. 9598	ARCHITECT/ENGINEERS: AKEA INC. 3603 NW 98th Street, Suite B Gainesville, FL 32606 Phone: (352) 474-6124 Fax: (352) 474-6324 AKEA Project No. 039-12	Drawing Title LEVEL 2 - AREA C - REFLECTED CEILING PLAN	Project Title VAMC AT LAKE NONA BUILD NEW RESEARCH SPACE	Project Number 675-900	Office of Construction and Facilities Management
Revisions:	Date			Approved: Project Director	Location Orlando, Florida	Building Number 13	Department of Veterans Affairs
					Date JUNE 17, 2016	Checked TW	Drawn JH
						Drawing Number S-AI122C	
						23 OF 176	