



1  
2  
3  
4  
5  
6  
7  
8  
9

A  
B  
C  
D  
E  
F

three inches = one foot  
one and one half inches = one foot  
one inch = one foot  
three quarters inch = one foot  
one half inch = one foot  
three eighths inch = one foot  
one quarter inch = one foot  
one eighth inch = one foot

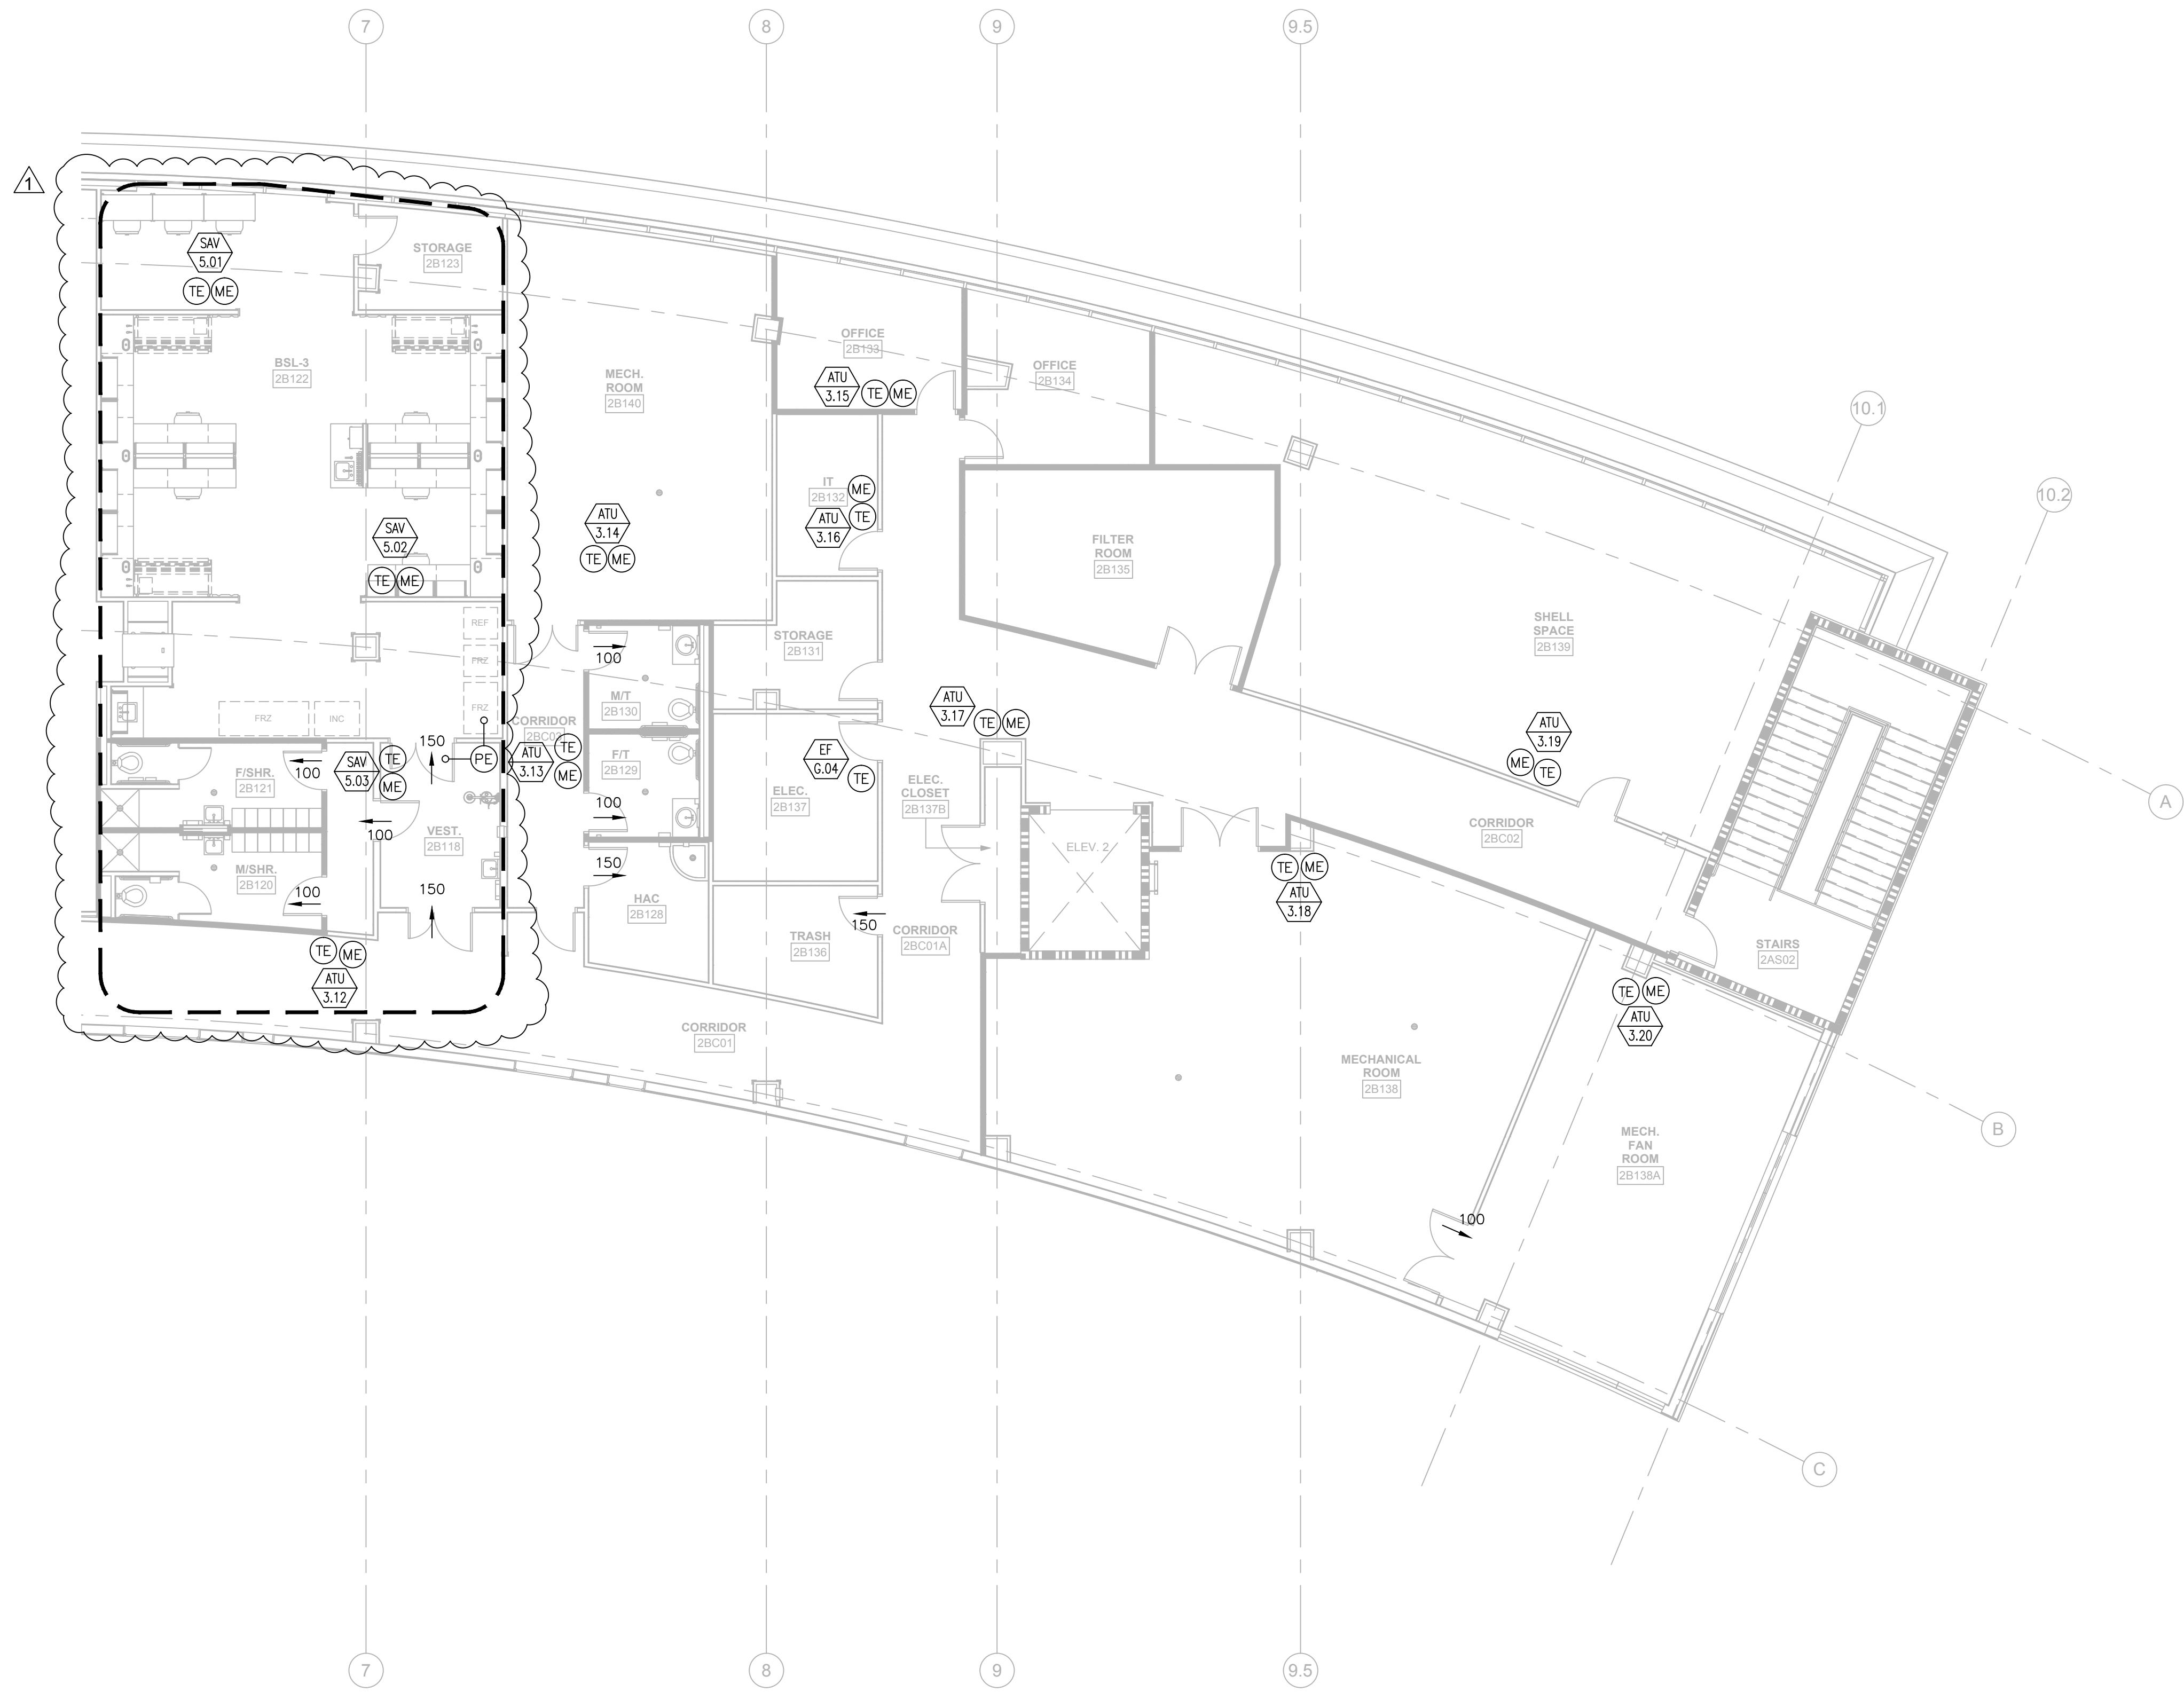

1 LEVEL 2 - AREA C - MECHANICAL INSTRUMENTATION PLAN  
SCALE: 1/8" = 1'-0"

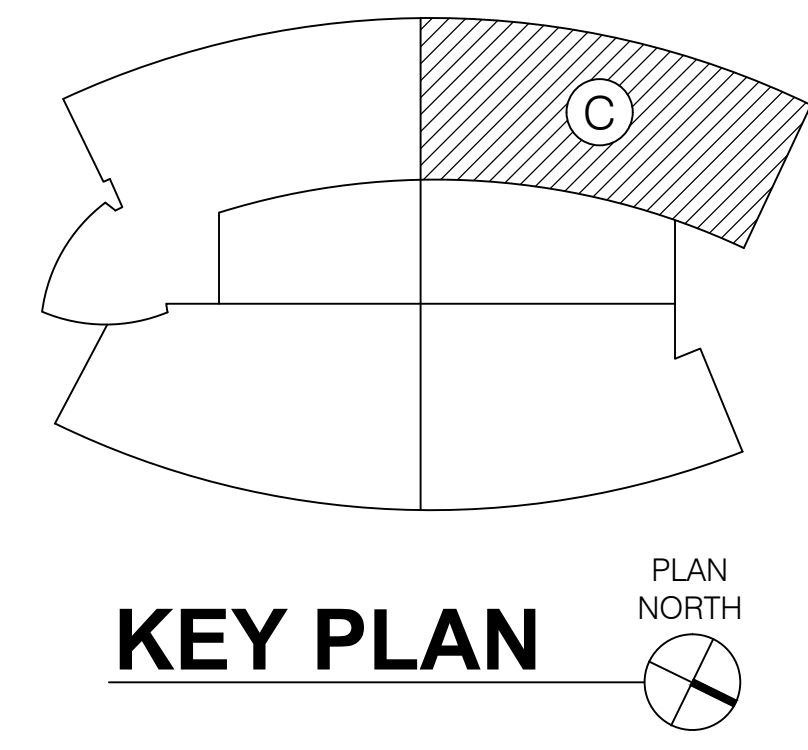

SHEET NOTES

1. DEDUCT ALTERNATE #6

SHEET KEYNOTES

1. XXX

|             |               |              |  |  |  |  |                           |   |                            |
|-------------|---------------|--------------|--|--|--|--|---------------------------|---|----------------------------|
| ADDENDUM #1 | April 7, 2017 | CONSULTANTS: | ENGINEER-OF-RECORD<br>STEPHEN T. STEFFE<br>FL P.E. NO. 70349 | ARCHITECT/ENGINEERS:<br><b>AKEA INC.</b><br>3603 NW 98th Street, Suite B<br>Gainesville, FL 32606<br>Phone: (352) 474-6124<br>Fax: (352) 474-6324<br>COA: FL #26693<br>AKEA Project No. 039-12 | Drawing Title<br>LEVEL 2 - AREA C<br>MECHANICAL INSTRUMENTATION PLAN | Project Title<br>VAMC AT LAKE NONA<br>BUILD NEW RESEARCH SPACE | Project Number<br>675-900 | Office of<br>Construction<br>and Facilities<br>Management<br> |                            |
|             |               |              |  |  | Approved: Project Director   | Location<br>Orlando, Florida                                   | Building Number<br>13     |   | Drawing Number<br>S-MI102C |
| Revisions:  | Date          |              |  |  | Date<br>JUNE 17, 2016  | Checked<br>STS   | Drawn<br>TJM              |   | 95 OF 176                  |

FINAL DESIGN  
APPROVED FOR CONSTRUCTION