GENERAL NOTES:

1. REFER TO DRAWING NO. I-274 THRU NO. I-285 FOR PLANS, SECTIONS, AND DETAILS OF INTERIOR STAIRS.
2. REFER TO DRAWING NO. I-286 THRU NO. I-294A FOR SCHEDULE, PLANS, SECTIONS, AND DETAILS OF ELEVATORS, AUTOMATIC TRANSPORT SYSTEMS AND DUMBWAITERS.
3. REFER TO DRAWING NO. I-296 FOR SCHEDULE AND DETAILS OF 6" PNEUMATIC TUBE SYSTEM.
4. REFER TO DRAWING NO. I-297 AND NO. I-298 FOR PLANS, ELEVATIONS, SECTIONS AND DETAILS OF TRASH AND LINEN CHUTES PNEUMATIC TUBE SYSTEM.
5. REFER TO DRAWING NO. I-256a FOR SCHEDULE AND DETAILS OF SHOWERS.

FIRE PROTECTION KEY

- UNRATED PARTITION
- SMOKE PARTITION
- 1 HOUR PARTITION
- 2 HOUR PARTITION
- 1 HOUR SMOKE PARTITION
- 2 HOUR SMOKE PARTITION
- SHIELDED PARTITION

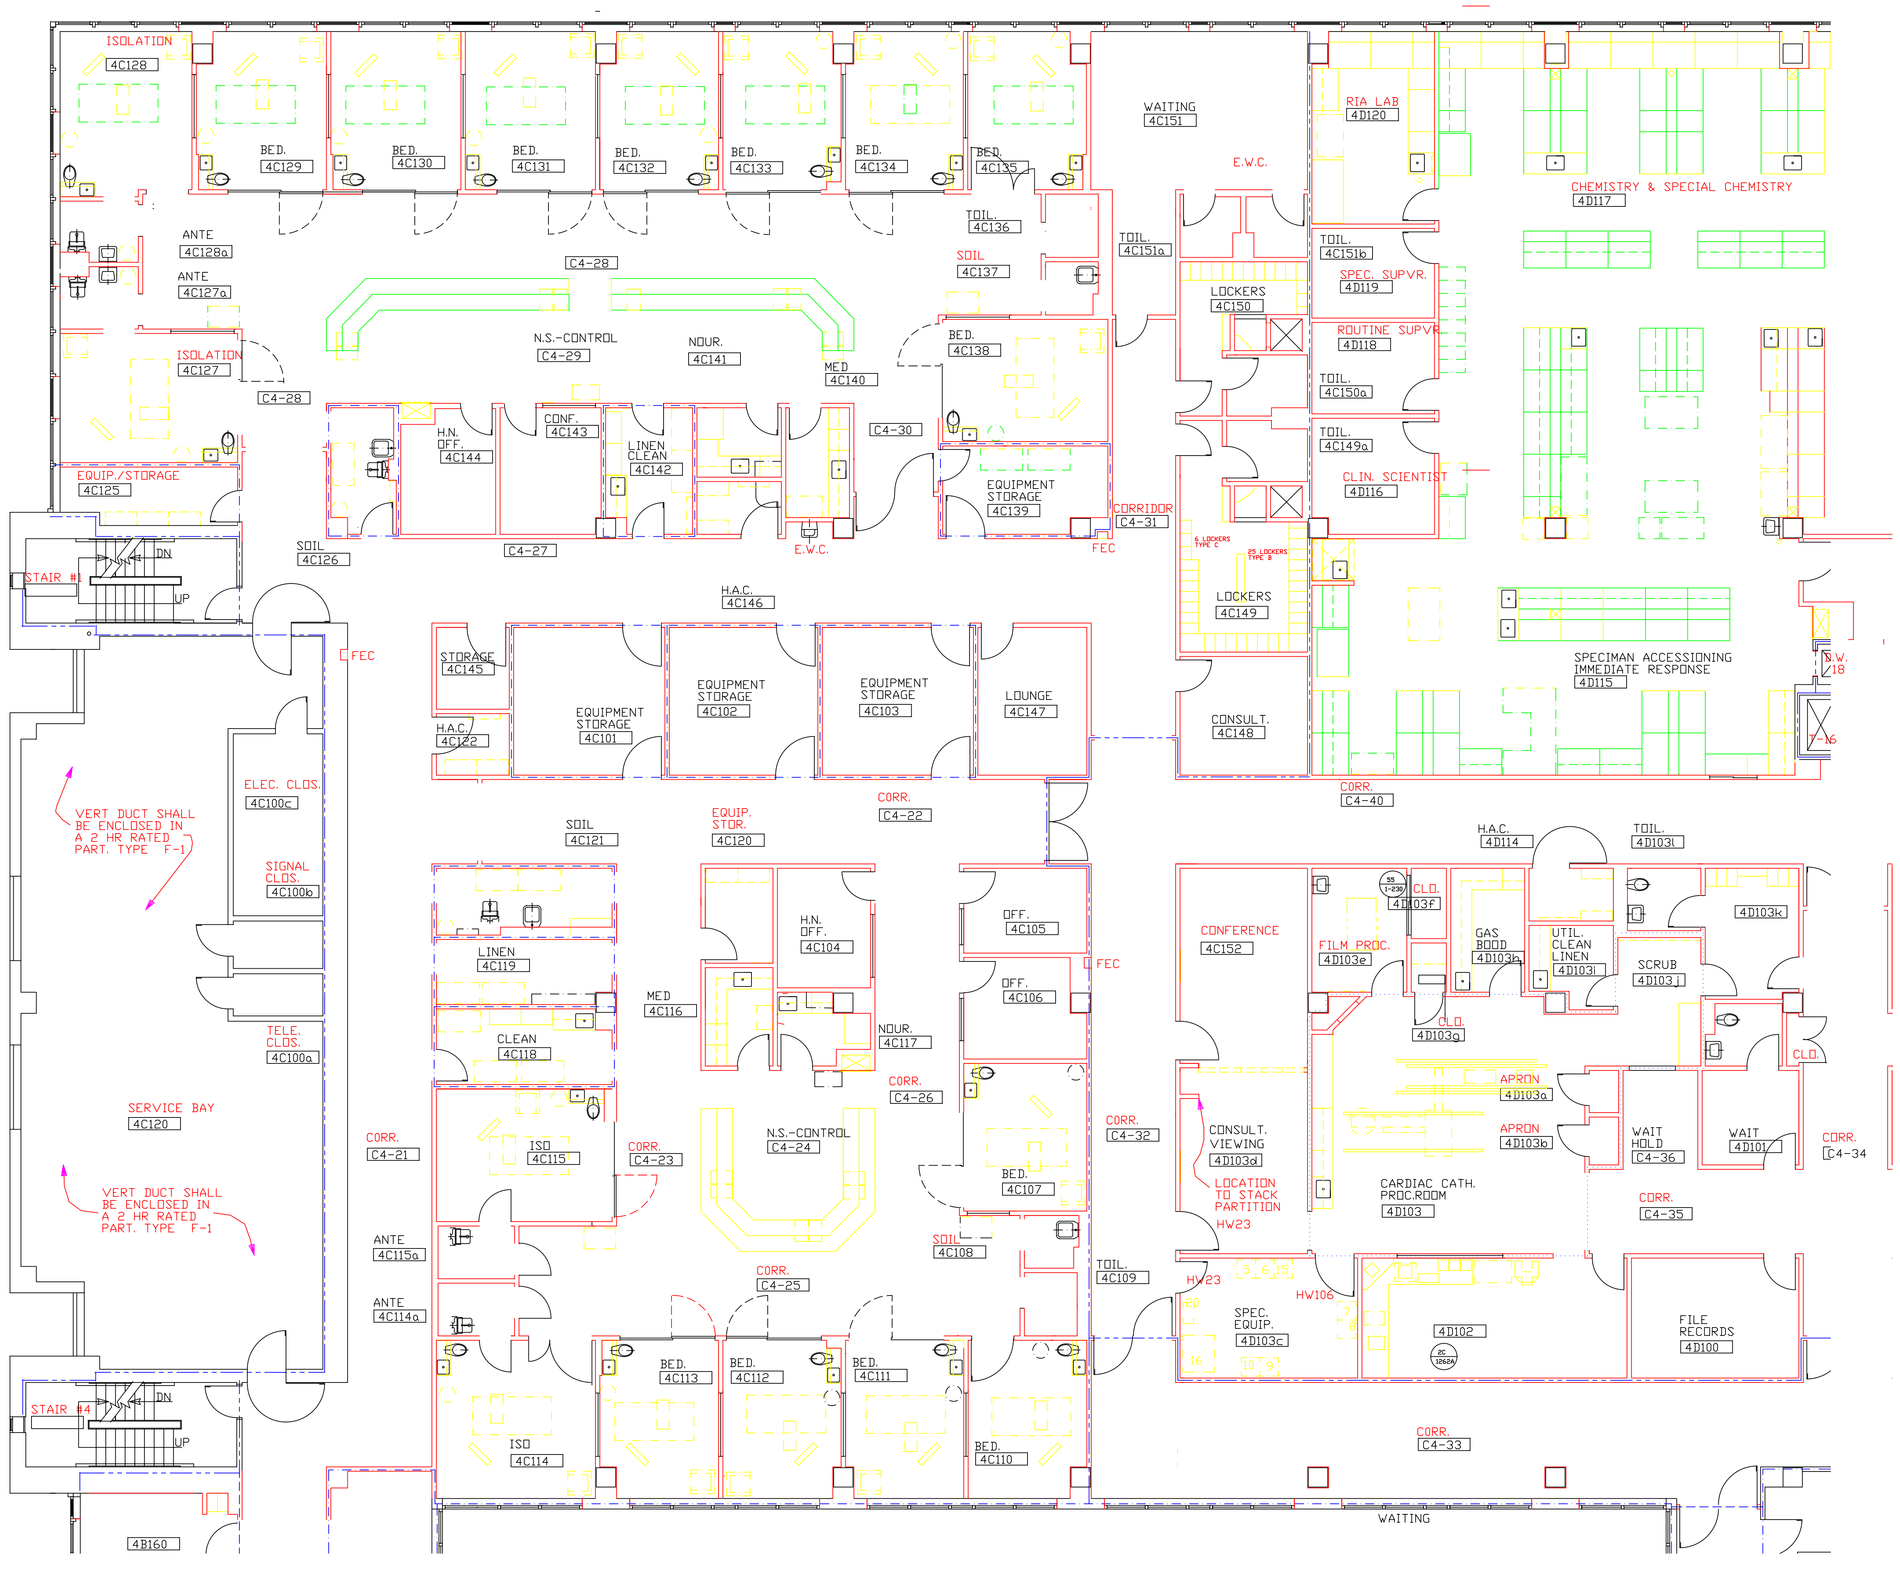

FOURTH FLOOR AREA C

DEPARTMENTS

LABORATORY SERVICE
CARDIAC INTENSIVE CARE UNIT
MEDICAL INTENSIVE CARE UNIT
CLINICAL CARDIAC LABORATORY
LOCKERS, LOUNGE, TOILETS & SHOWERS

FULLY SPRINKLERED

Revisions	Date
⚠ RECORD DRAWING	3/25/94

Keyplan: A, B, C, D

NORTH

Seal

RTKL/CSD/HENRY ADAMS (J.V.)
ARCHITECTS AND ENGINEERS
400 E. PRATT STREET
BALTIMORE, MD 21202

Drawing Title: FOURTH FLOOR AREA C

Project Title: 324 - BED REPLACEMENT HOSPITAL-PHASE II

Date: 9/1/88

Project No.: 511-001D

Approved Project Director

Scale: 1/8" = 1'-0"

Checked

Building Number: 1

Location: VAMC-BALTIMORE, MD.

DRAWING No.: I-47

Dwg.

Veterans Administration