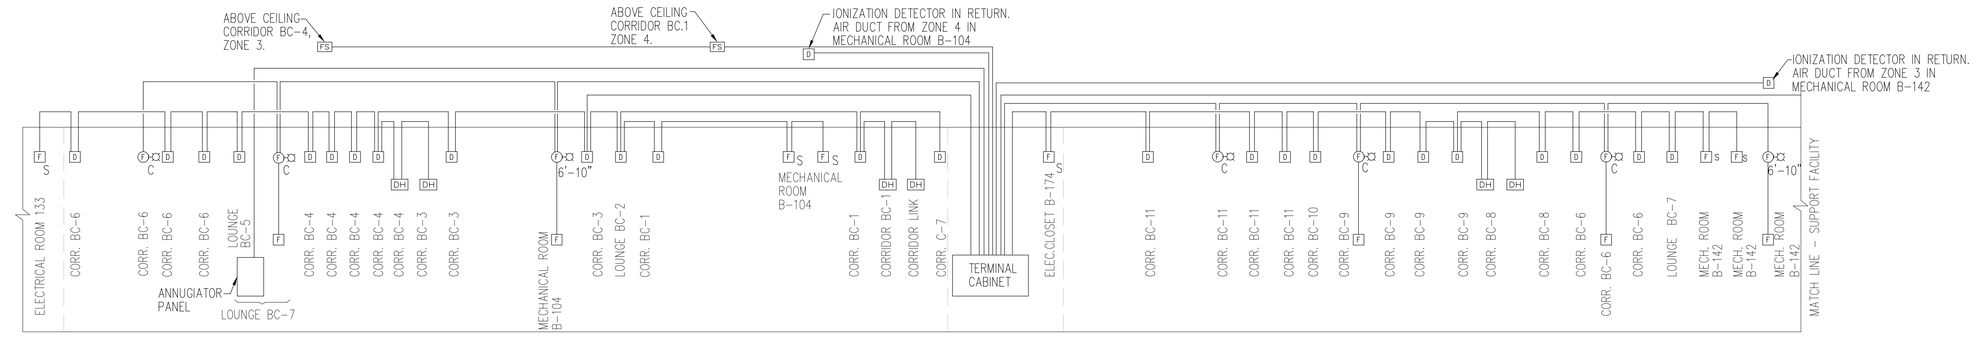

BED ROOM UNIT "B" (A,C, & D TYPICAL)

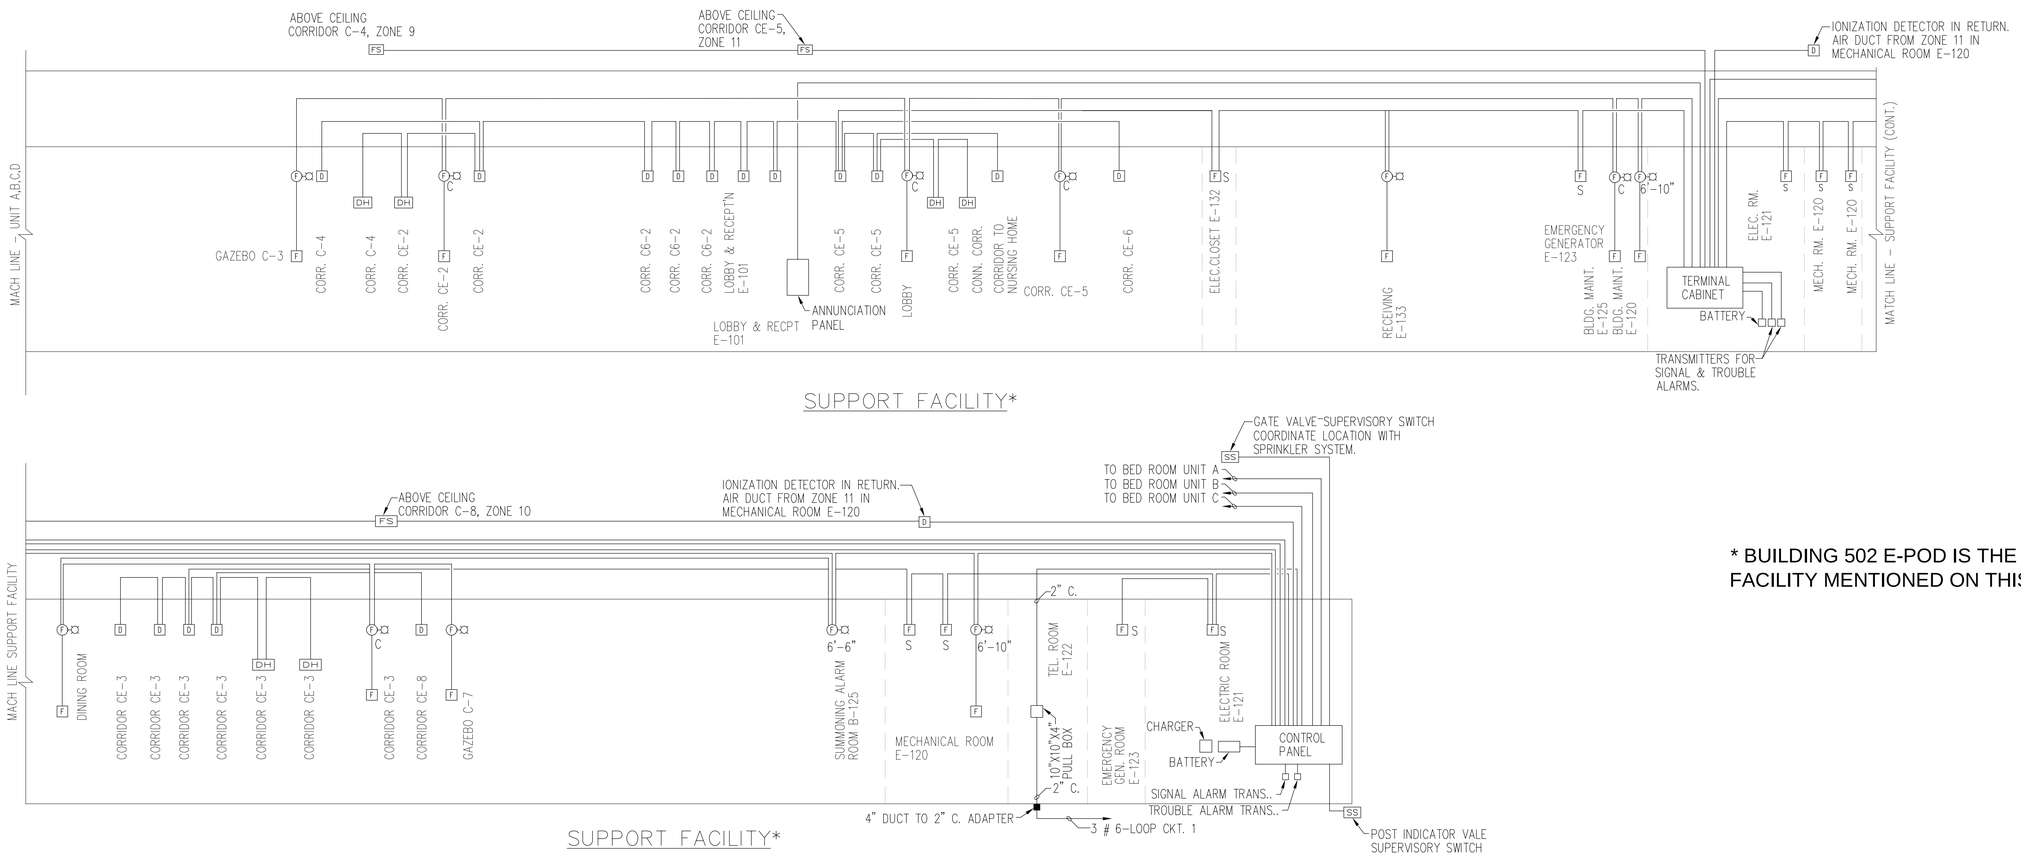

SUPPORT FACILITY*

SUPPORT FACILITY*

FIRE ALARM SYSTEM RISER DIAGRAM

* BUILDING 502 E-POD IS THE SUPPORT FACILITY MENTIONED ON THIS SHEET.

Rev	Explanation & Initials	Date

Professional Seal

Drawing Title: RISER DIAGRAM FOR FIRE PROTECTION

Project Title: AS-BUILT DRAWING

Date: 5/16/2012

Project No.: XXX-XX-XXX

Approved:

Approved:

Building Number: 502

Checked: -

Drawn: GDF

Location: VAMC, MARTINSBURG WV

Dwg. 1 of 1

VAMC, MARTINSBURG

VA Department of Veterans Affairs