


2017/03/17, M.S. (AES)

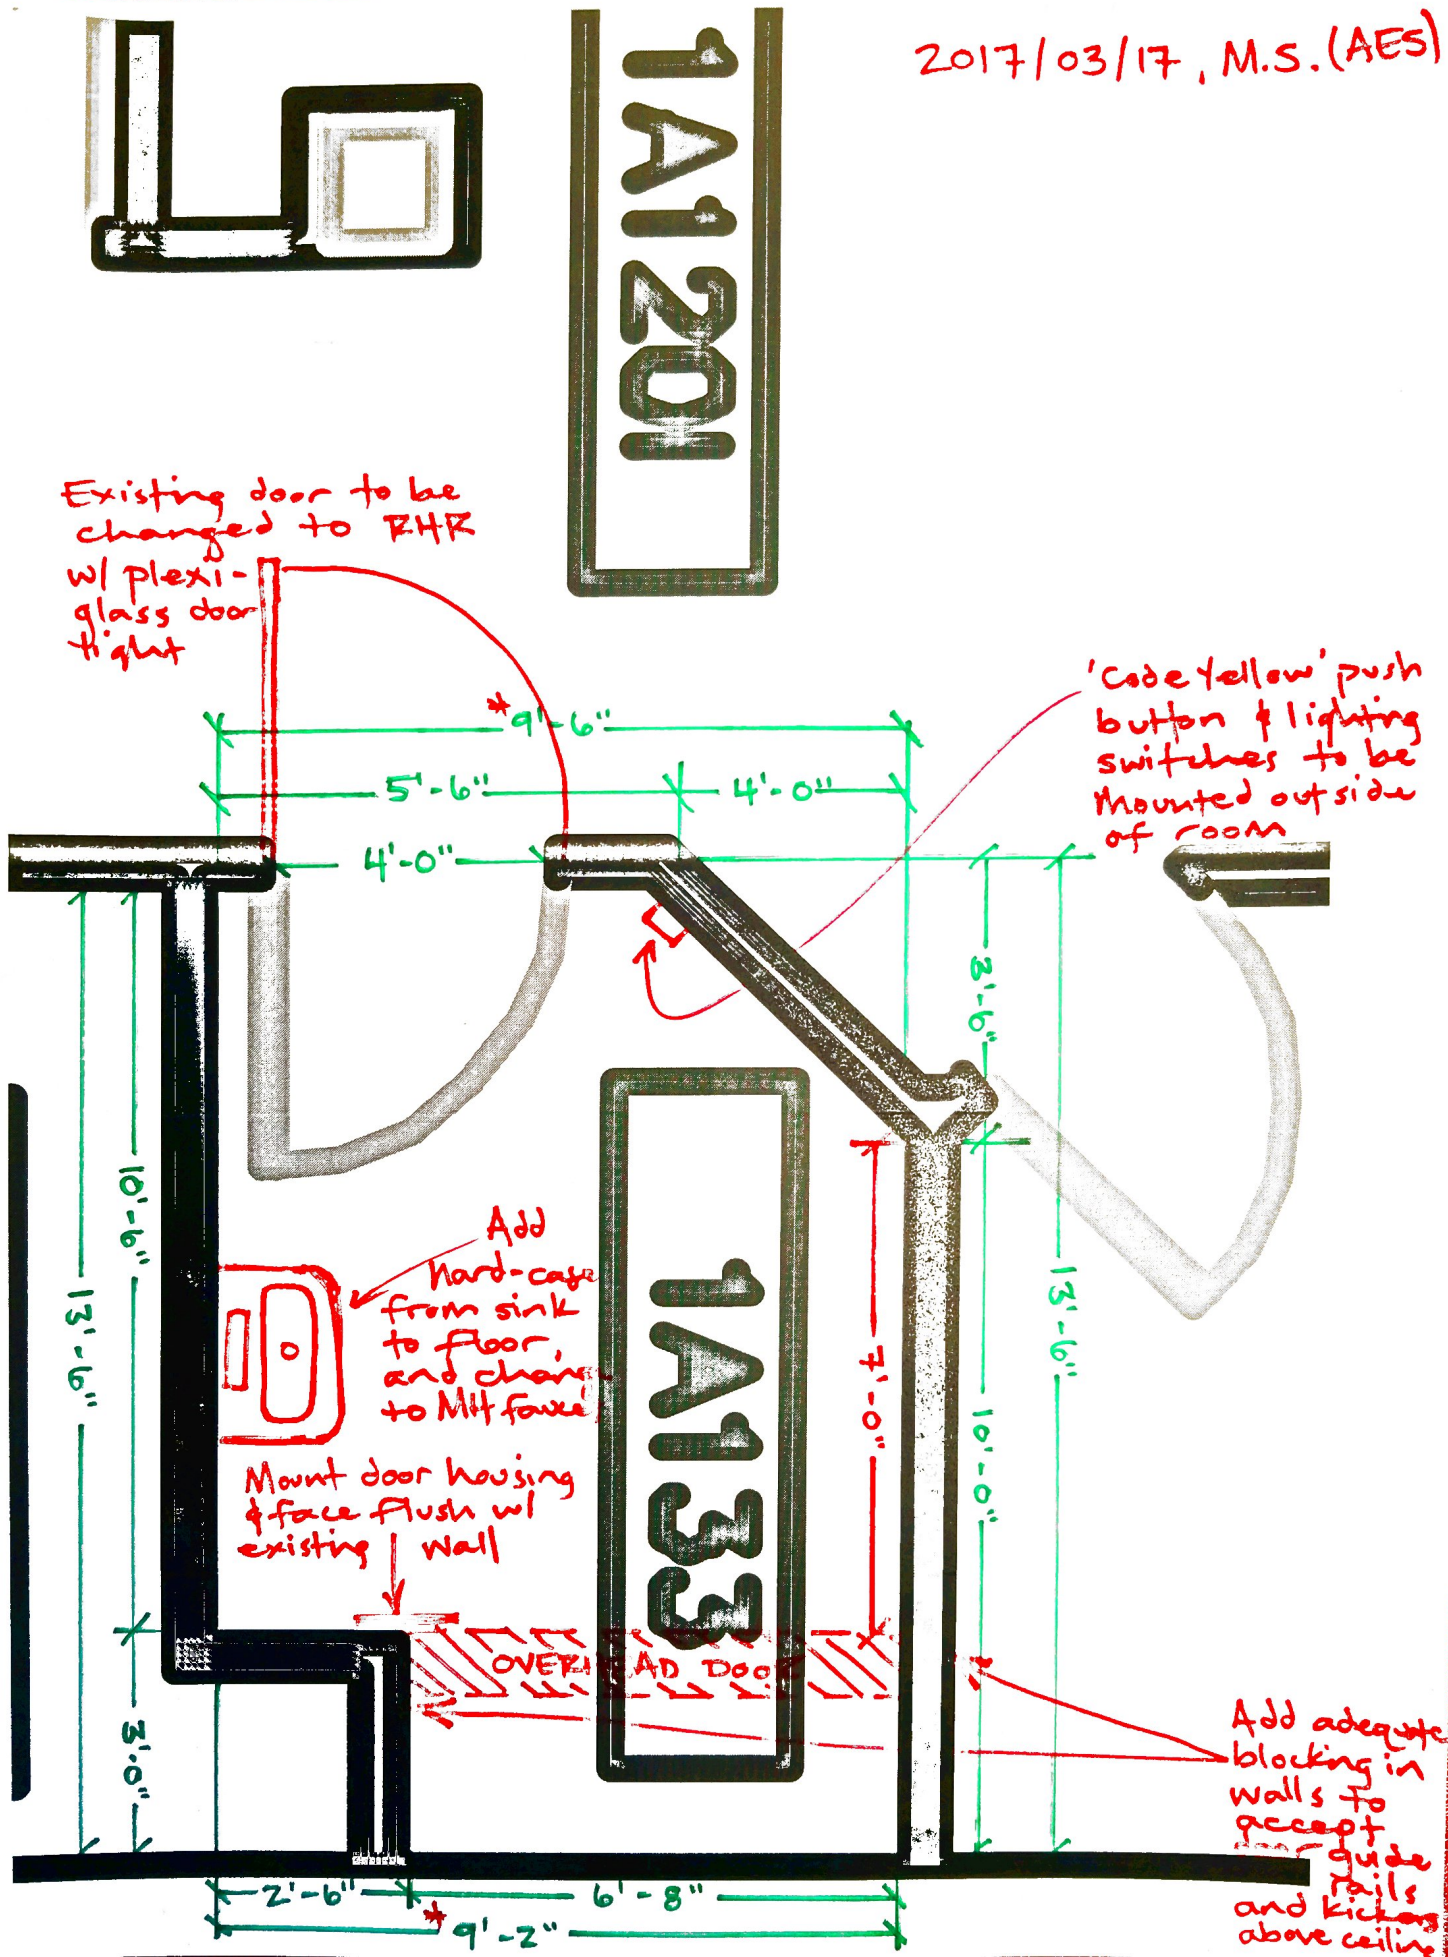

2017/03/17, M.S.(AES)

