

three inches = one foot
one and one half inches = one foot
one inch = one foot
three quarters inch = one foot
one half inch = one foot
three eighths inch = one foot
one quarter inch = one foot
one eighth inch = one foot



- GENERAL NOTES
1.

INSTALL NEW SUPPLY DIFFUSERS AND RETURN/EXHAUST GRILLES LOCATED IN BONE MARROW TRANSPLANT. CONNECT DIFFUSERS AND GRILLES TO EXISTING SUPPLY AND EXHAUST DUCTWORK.
2.

COORDINATE EXACT DIFFUSER LOCATION WITH EXISTING AND NEW REFLECTIVE CEILING PLAN PER ARCHITECTURAL DRAWINGS.
3.

PROVIDE COMPLETE AIR BALANCE OF BONE MARROW TRANSPLANT AND SLEEP LAB. SEE AIR BALANCE SCHEDULE FOR SUPPLY AND RETURN/EXHAUST CFM.
4.

SUPPLY DIFFUSERS AND RETURN/EXHAUST GRILLES ARE SHOWN FOR REFERENCE ONLY BASED ON BONE MARROW TRANSPLANT ACCESSIBILITY.

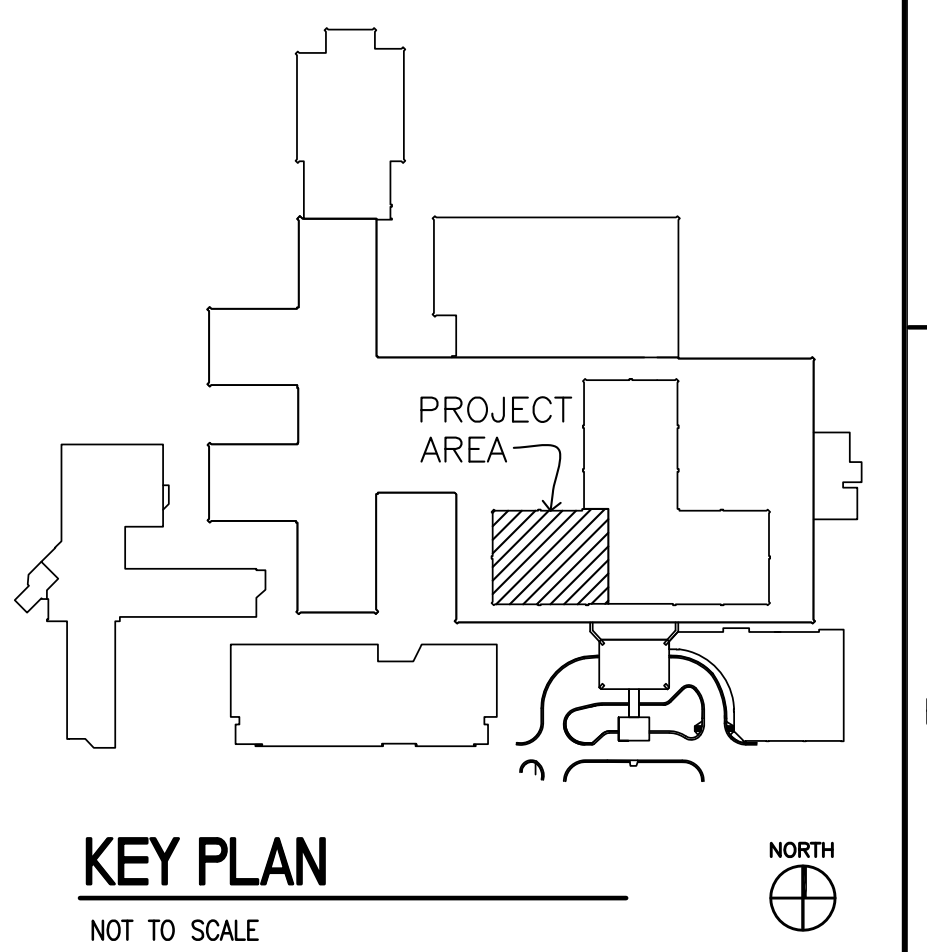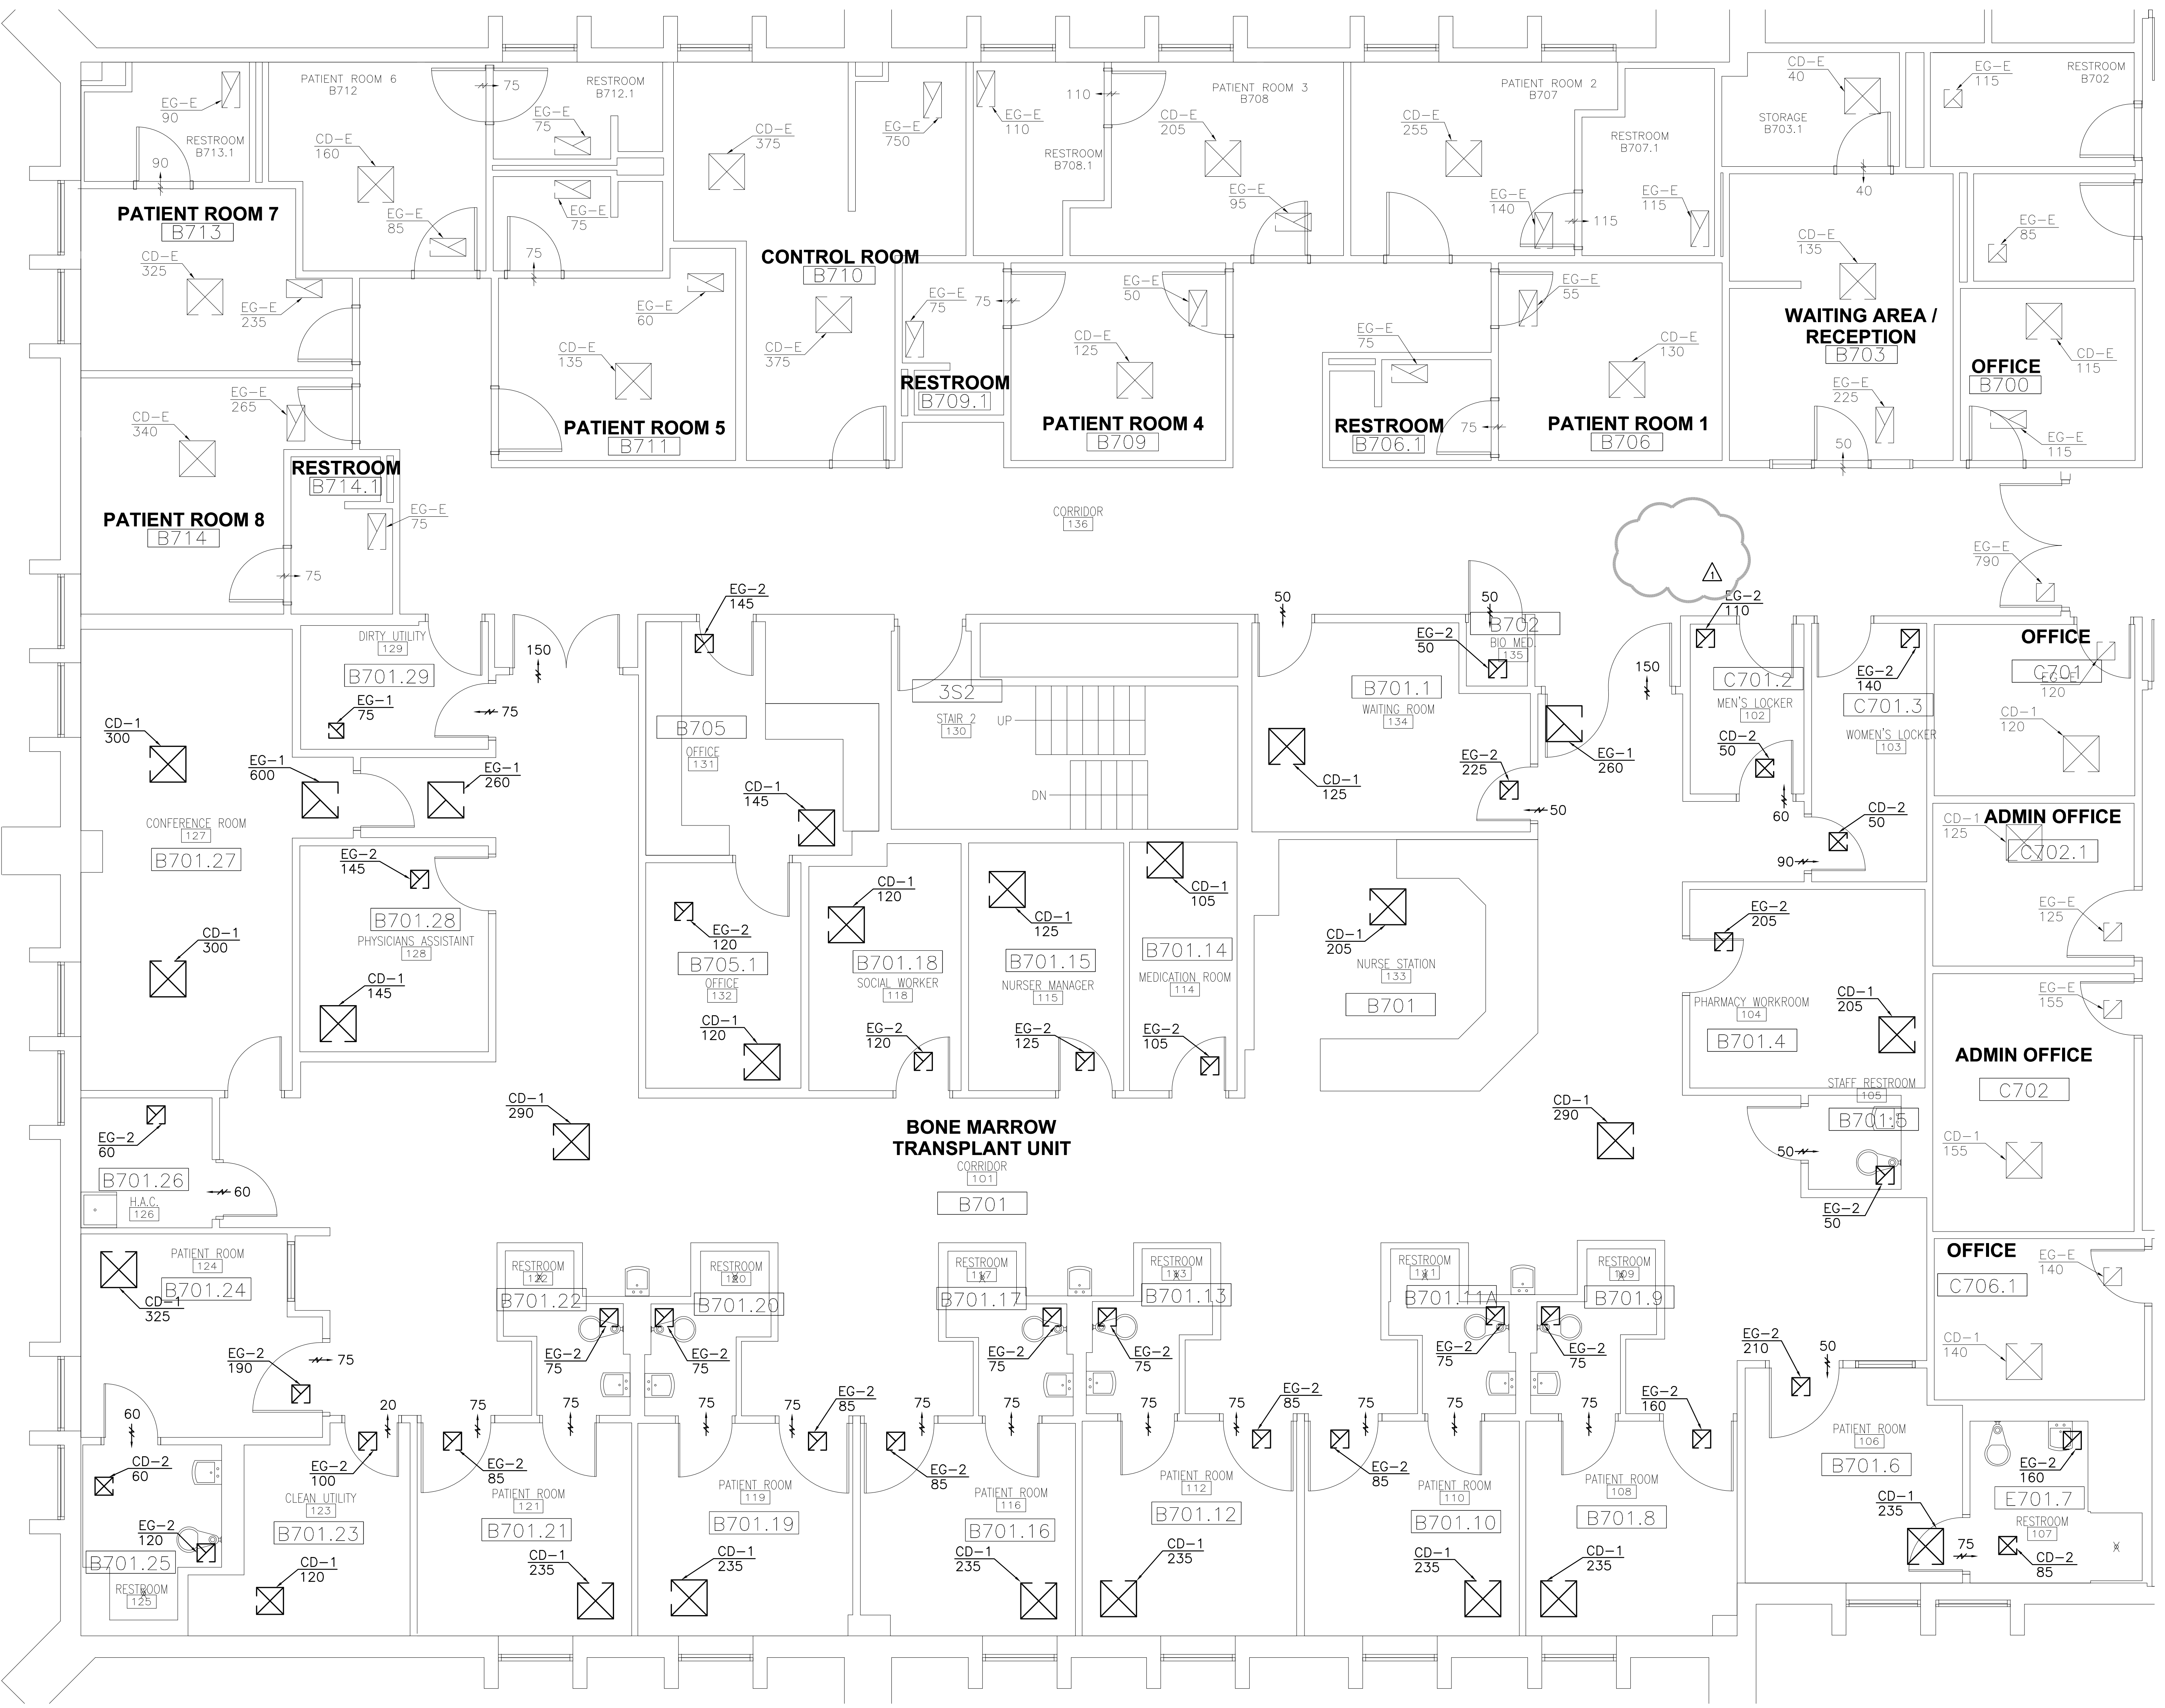

1 MECHANICAL - DIFFUSER REPLACEMENT PLAN 7TH FLOOR WEST
1/4" = 1'-0"

<div>CONSULTANTS:</div> <div><div><div>MEP</div><div>ASSOCIATES, INC.</div></div><div><div>engineers consultants commissioning</div><div>2801 Van Buren Street, Suite 2004 Houston, TX 77027</div><div>PH: 281.344.2028 F: 281.344.2029</div><div>CA#: 5121 Expiration Date: 06.30.2017</div><div>MEP PROJECT NO.: P14-15-01</div></div></div>	<div>ARCHITECT/ENGINEERS:</div> <div><div><div>PRIME</div><div>ARCHITECTS</div></div><div><div>1144 AIRPORT BLVD.</div><div>SUITE 260</div><div>AUSTIN, TX 78702</div><div>(866) 226-8071 TELE.</div><div>(866) 226-9969 FAX</div><div>WWW.PRIME-ARCH.COM</div></div></div>	<div>Drawing Title</div> <div>MECHANICAL - DIFFUSER REPLACEMENT PLAN 7TH FLOOR WEST</div> <div>Approved Project Director</div> <div></div>	<div>Project Title</div> <div>REFURBISH BONE MARROW TRANSPLANT UNIT</div> <div>Location</div> <div>VAMC SAN ANTONIO TX</div> <div>Date</div> <div>NOVEMBER 12, 2015</div> <div>Checked</div> <div>JAU</div> <div>Drawn</div> <div>JRM</div>	<div>Project Number</div> <div>671-15-100</div> <div>Building Number</div> <div>1</div> <div>Drawing Number</div> <div>MH-101</div> <div>Dwg. 20 of 45</div>	<div>Office of Construction and Facilities Management</div> <div><div>Department of Veterans Affairs</div></div>
--	---	--	---	--	--