


14/16/18/20/29
CDD-1

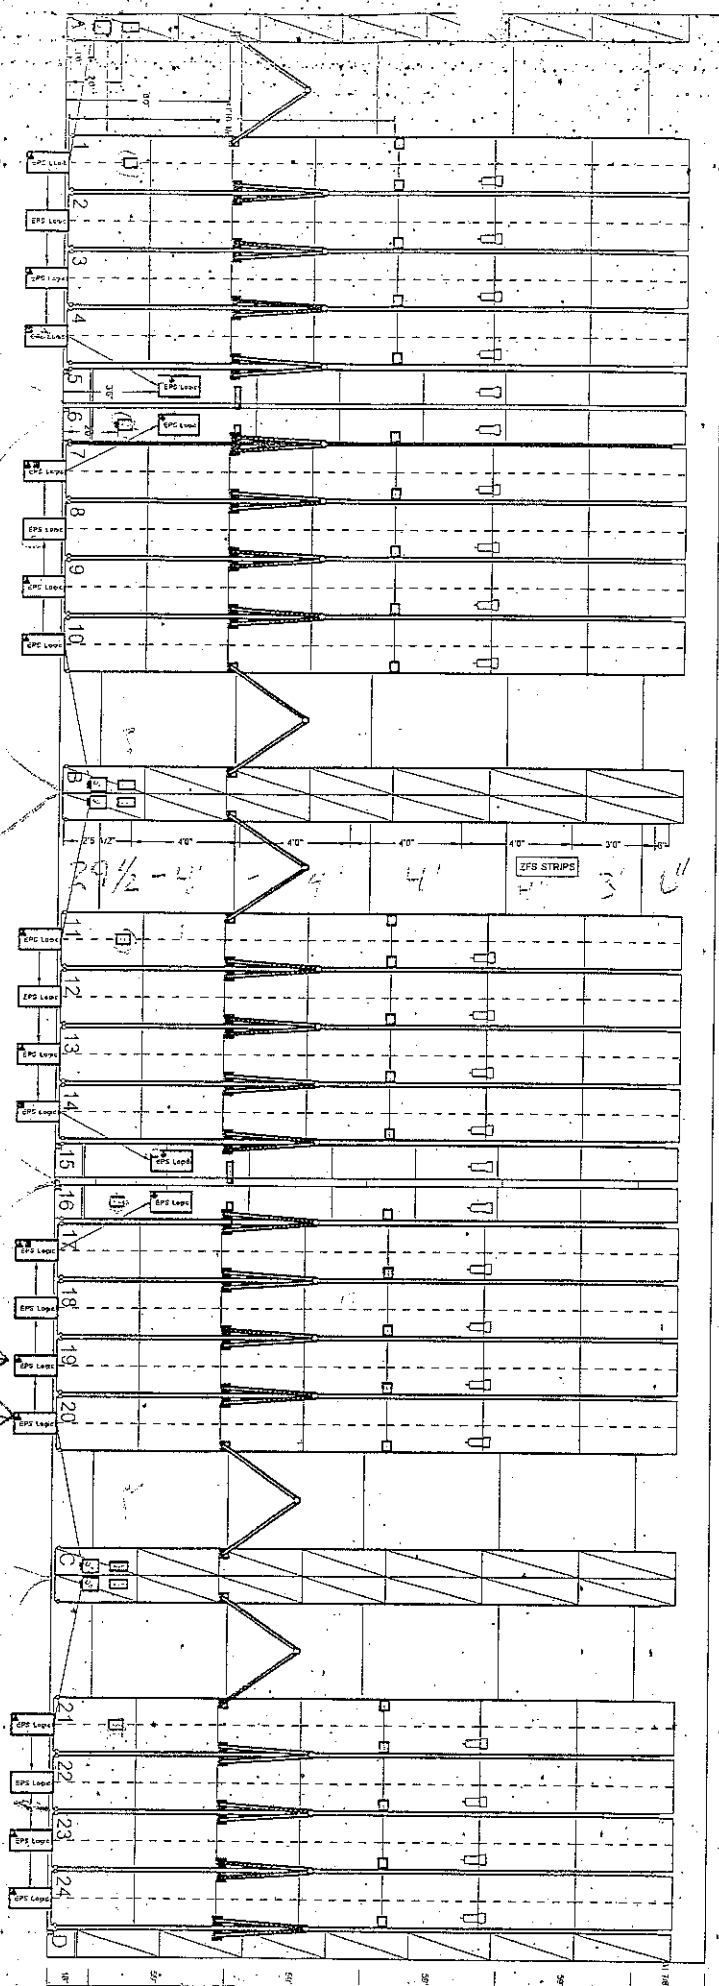

ZFS Board IR Brake Board Limit PS Expander

FRONT OF SYSTEM

Order #: 436546-02
AC: Spacesaver Systems (MD)
Planner: Dave Anderson
R/F Order #: 436546-04
Project Name: VBA-SAN JUAN/SYS 2
Est. Ship: 10/01/2010
Est. Ship R/F: 09/03/2010
Plan: 08/16/2010