





1 ARCHITECTURAL SITE PLAN  
1" = 50'-0"


REVISED 04-19-2017 TO ADDRESS  
CONSTRUCTION PHASE EXITING,  
CONTRACTOR PARKING, LAY-DOWN  
AREA AND STORAGE AREAS

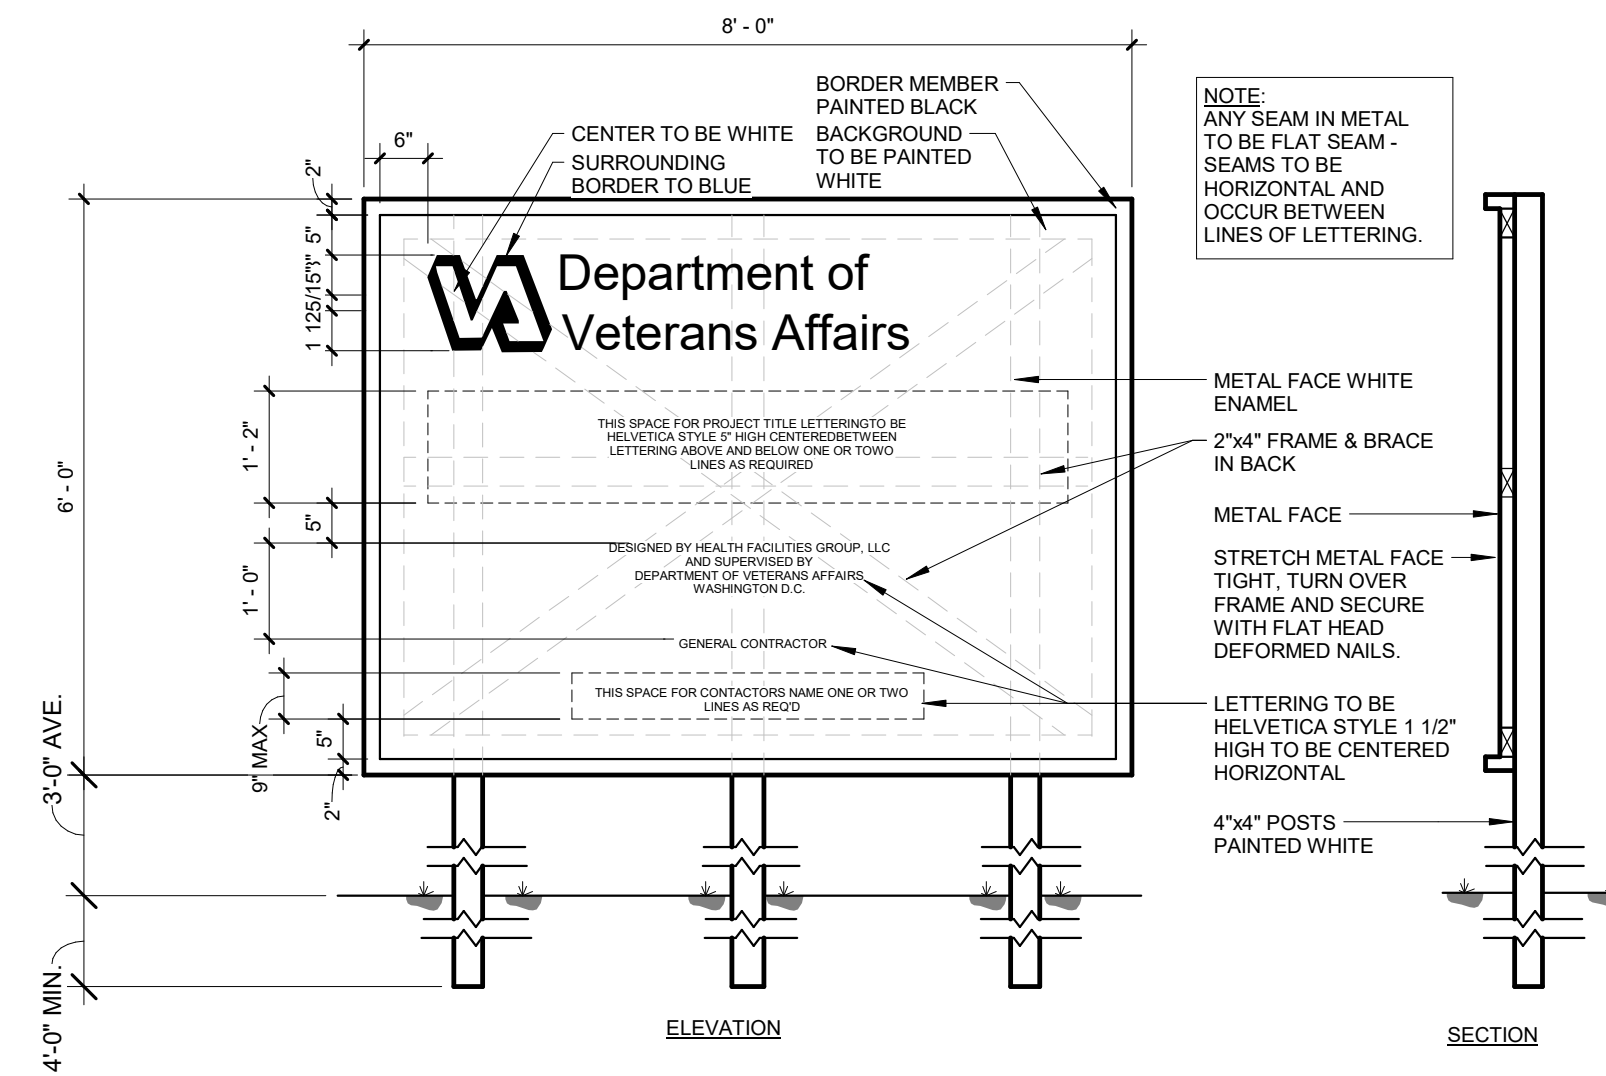


2 CONSTRUCTION & SAFETY SIGNS  
1/2" = 1'-0"

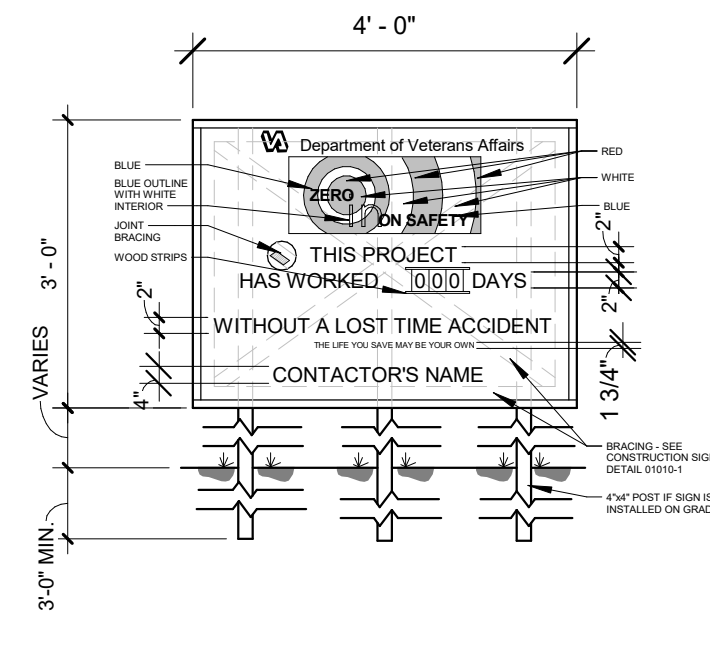

SAFETY SIGN

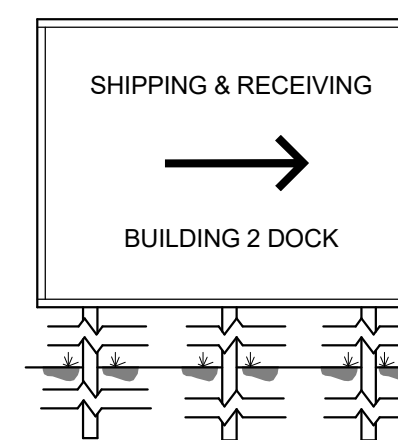


3 TEMPORARY SIGN POINTING TO BLDG. 2 DOCK  
1/2" = 1'-0"

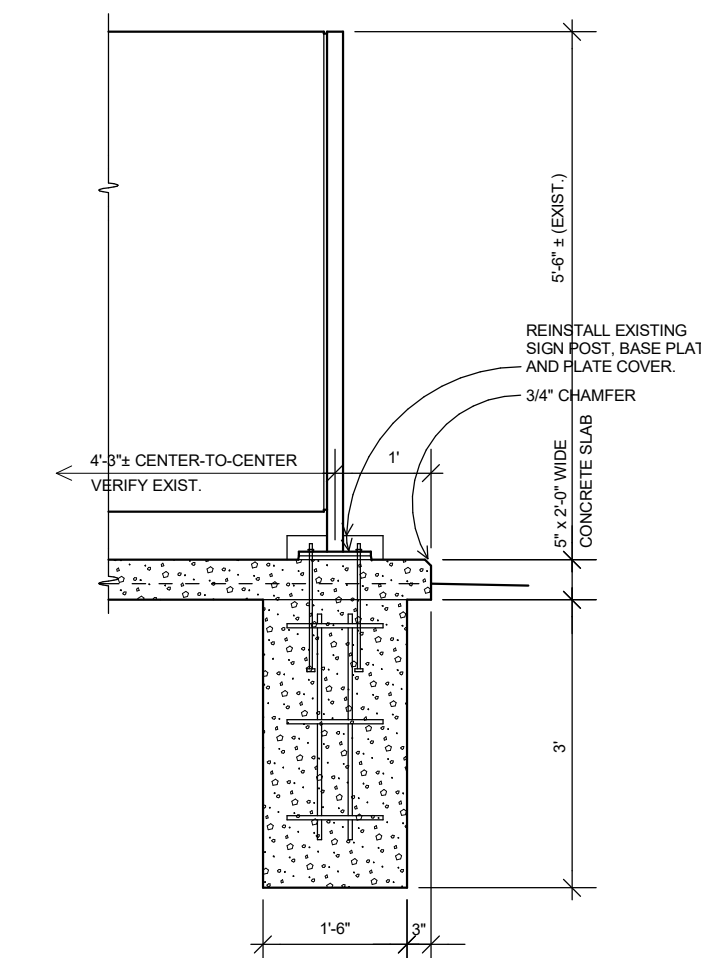

4 RELOCATED DIRECTORY SIGN DETAIL  
1/2" = 1'-0"

Revisions:	Date

CONSULTANTS:  
..

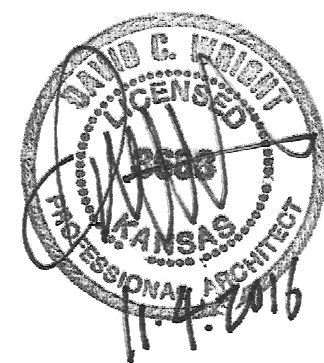

ARCHITECT/ENGINEERS:



Drawing Title

SITE PLAN

BID SET

Project Title  
STERILE PROCESSING SERVICE (SPS)  
SURGICAL SUITE EXPANSION, B34

Project Number  
589-754

Location  
Robert J. Dole VA Medical Center 5500 E Kellogg, Wichita, KS

Date  
10/31/2016

Checked  
MC

Drawn  
JW/RMC

Drawing Number  
SP-101

Dwg.

Office of  
Construction  
and Facilities  
Management

