


181

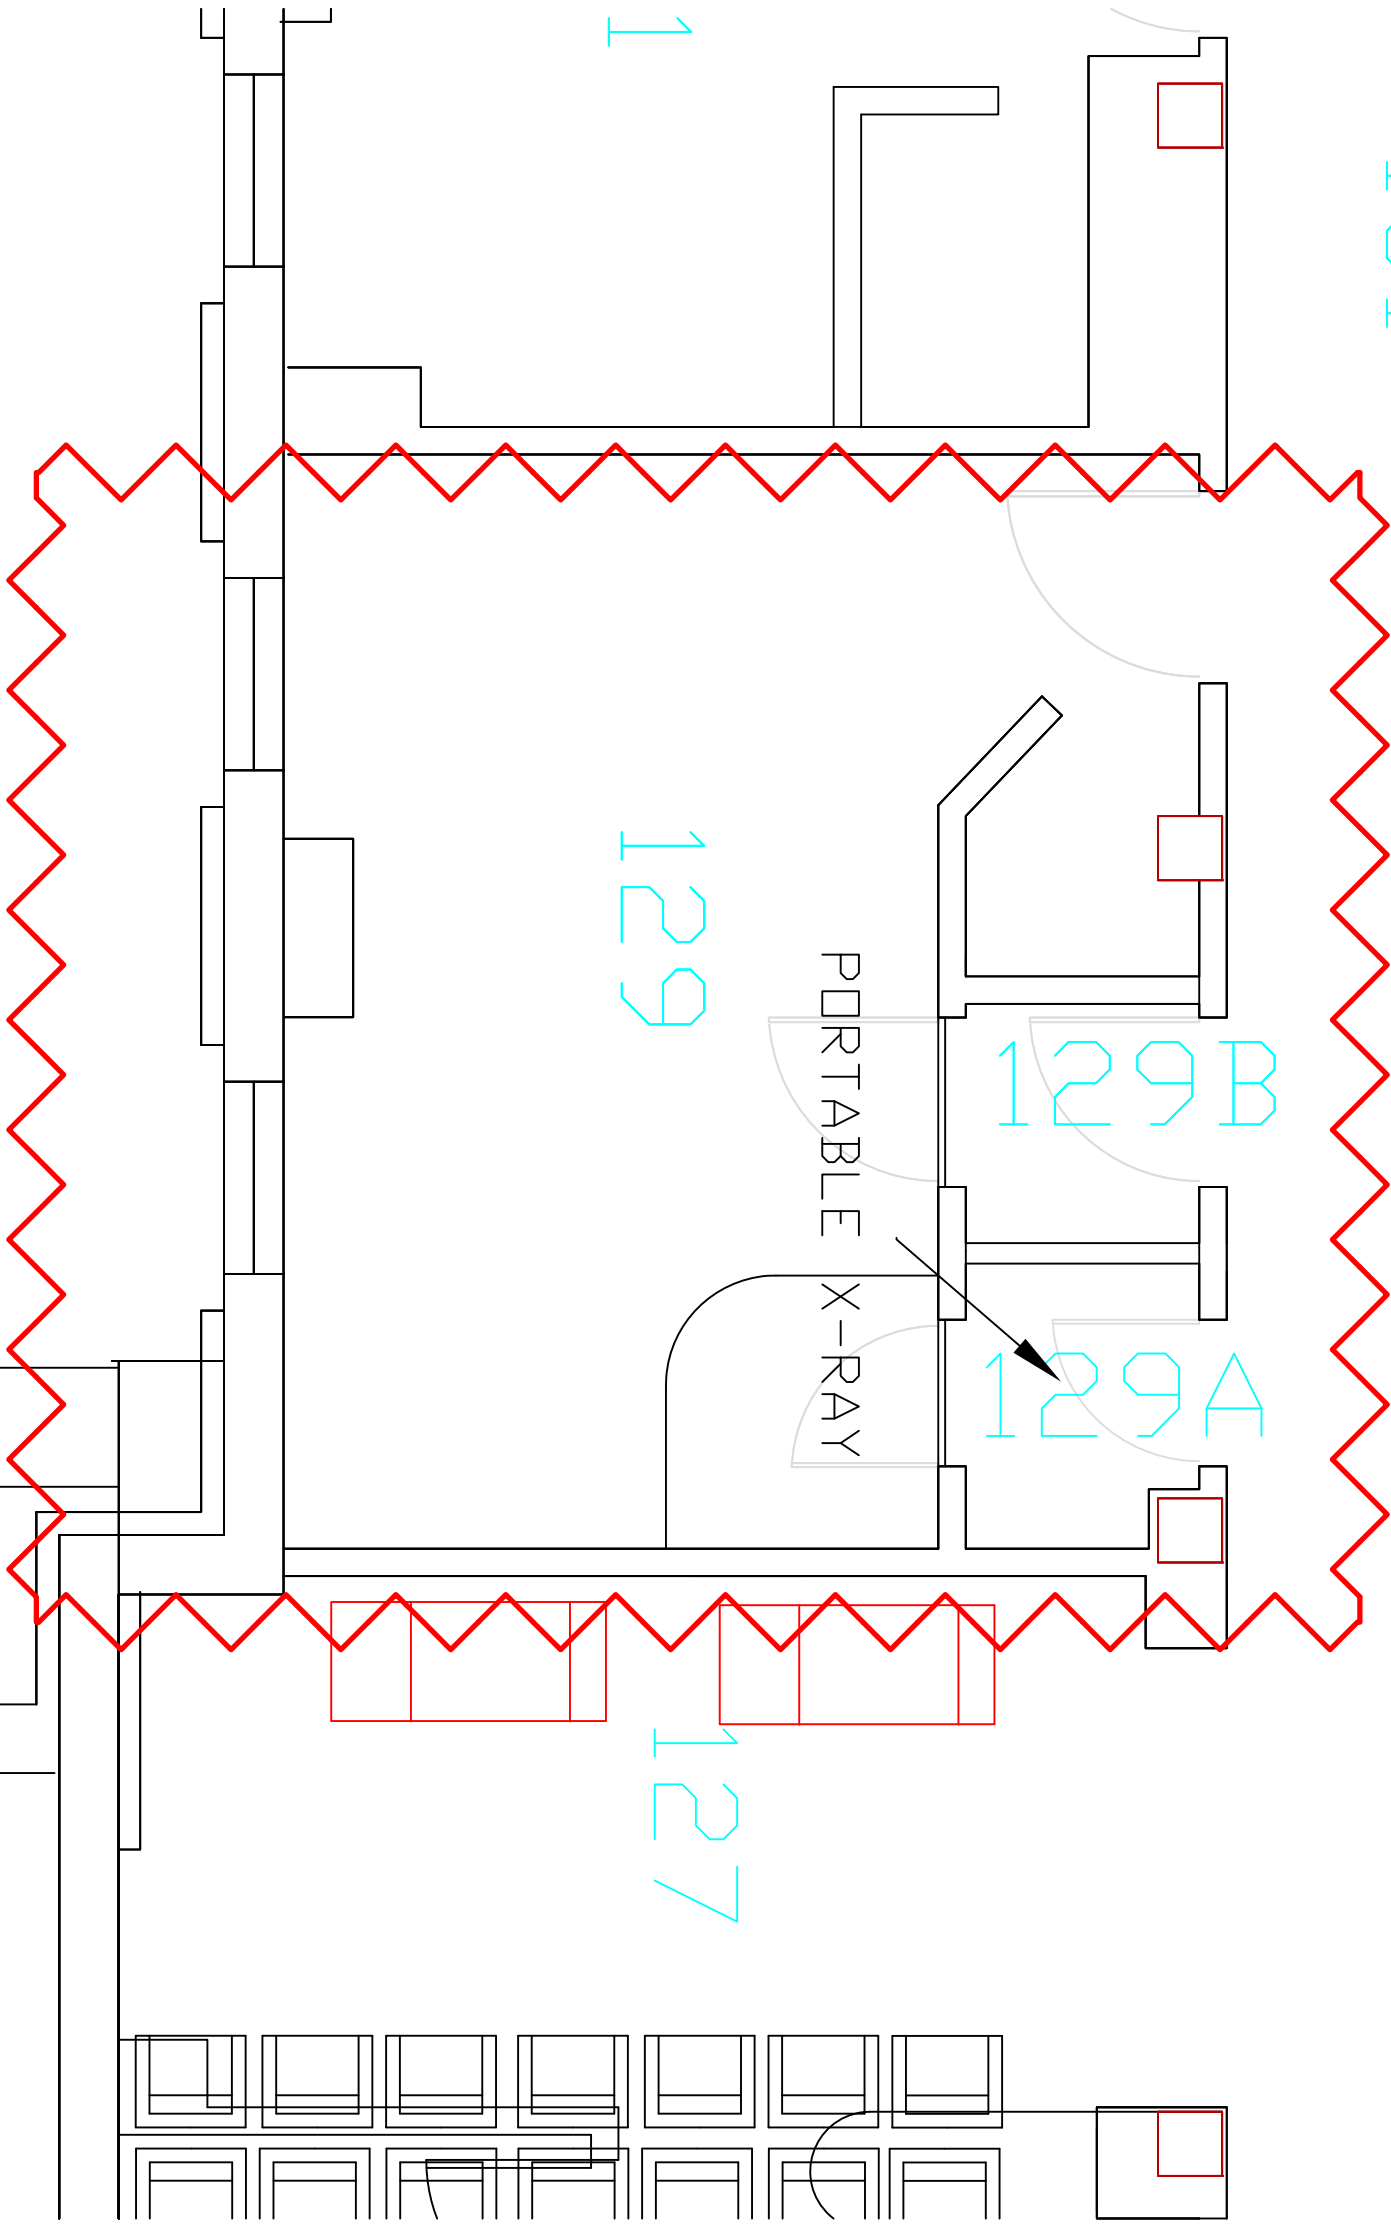

129

129B

129A

PORTABLE X-RAY

127

011