





















6522 MEADOWRIDGE ROAD, SUITE 101 ELKRIDGE, MD 21075
410-750-2246 (BAL T) 410-750-2588 (FAX)


LIFE SAFETY SYMBOLS

- | | |
|---|---------------------------|
|  | BUILDING SEPARATION |
|  | 3 HOUR FIRE SEPARATION |
|  | 2 HOUR FIRE SEPARATION |
|  | 1 HOUR FIRE SEPARATION |
|  | 1/2 HOUR FIRE SEPARATION |
|  | SMOKE BARRIER |
|  | SMOKE RESISTIVE |
|  | CONSTRUCTION |
|  | EXIT |
|  | NOT INCLUDED IN SOC |
|  | CHUTES/ACCESS/DISCHARGE |
|  | HAZARDOUS AREA |
|  | SLEEPING SUITE |
|  | NON-SLEEPING SUITE |
|  | NON-PATIENT SUITE |
|  | 2 HOUR FLOOR/CILING ABOVE |
|  | 1 HOUR FLOOR/CILING ABOVE |
|  | FINDING NUMBER |
|  | XXXX |

[illegible]

Base drawing are Koffel Statement of Conditions, Jan 2011.
Update in 2016 to show completed and current construction floor plans with fire barriers.

VA WILKES BARRE
VAMC
1111 East End Boulevard
Wilkes-Barre, PA 18711

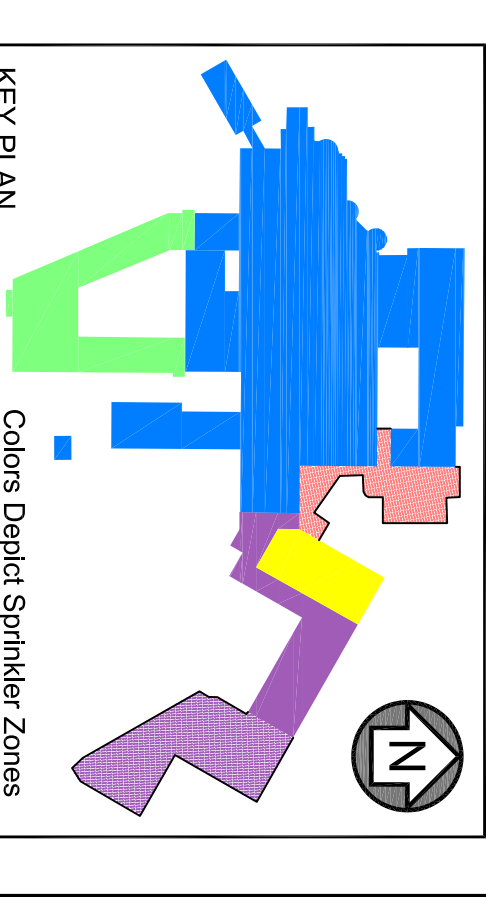


J003-01-08	JAN 14, 2011
KA PROJECT NO	SUBMITTAL DATE
AS NOTED	L. PEAKE
DRAWING SCALE	DESIGNED BY
S. GIL YEAT	A. KAHLER
REVIEWED BY	DRAWN BY

LIFE SAFETY PLAN
BUILDINGS 1 & 27
BASEMENT FLOOR
AREA A

DRAWING NUMBER

LS.1.B.1

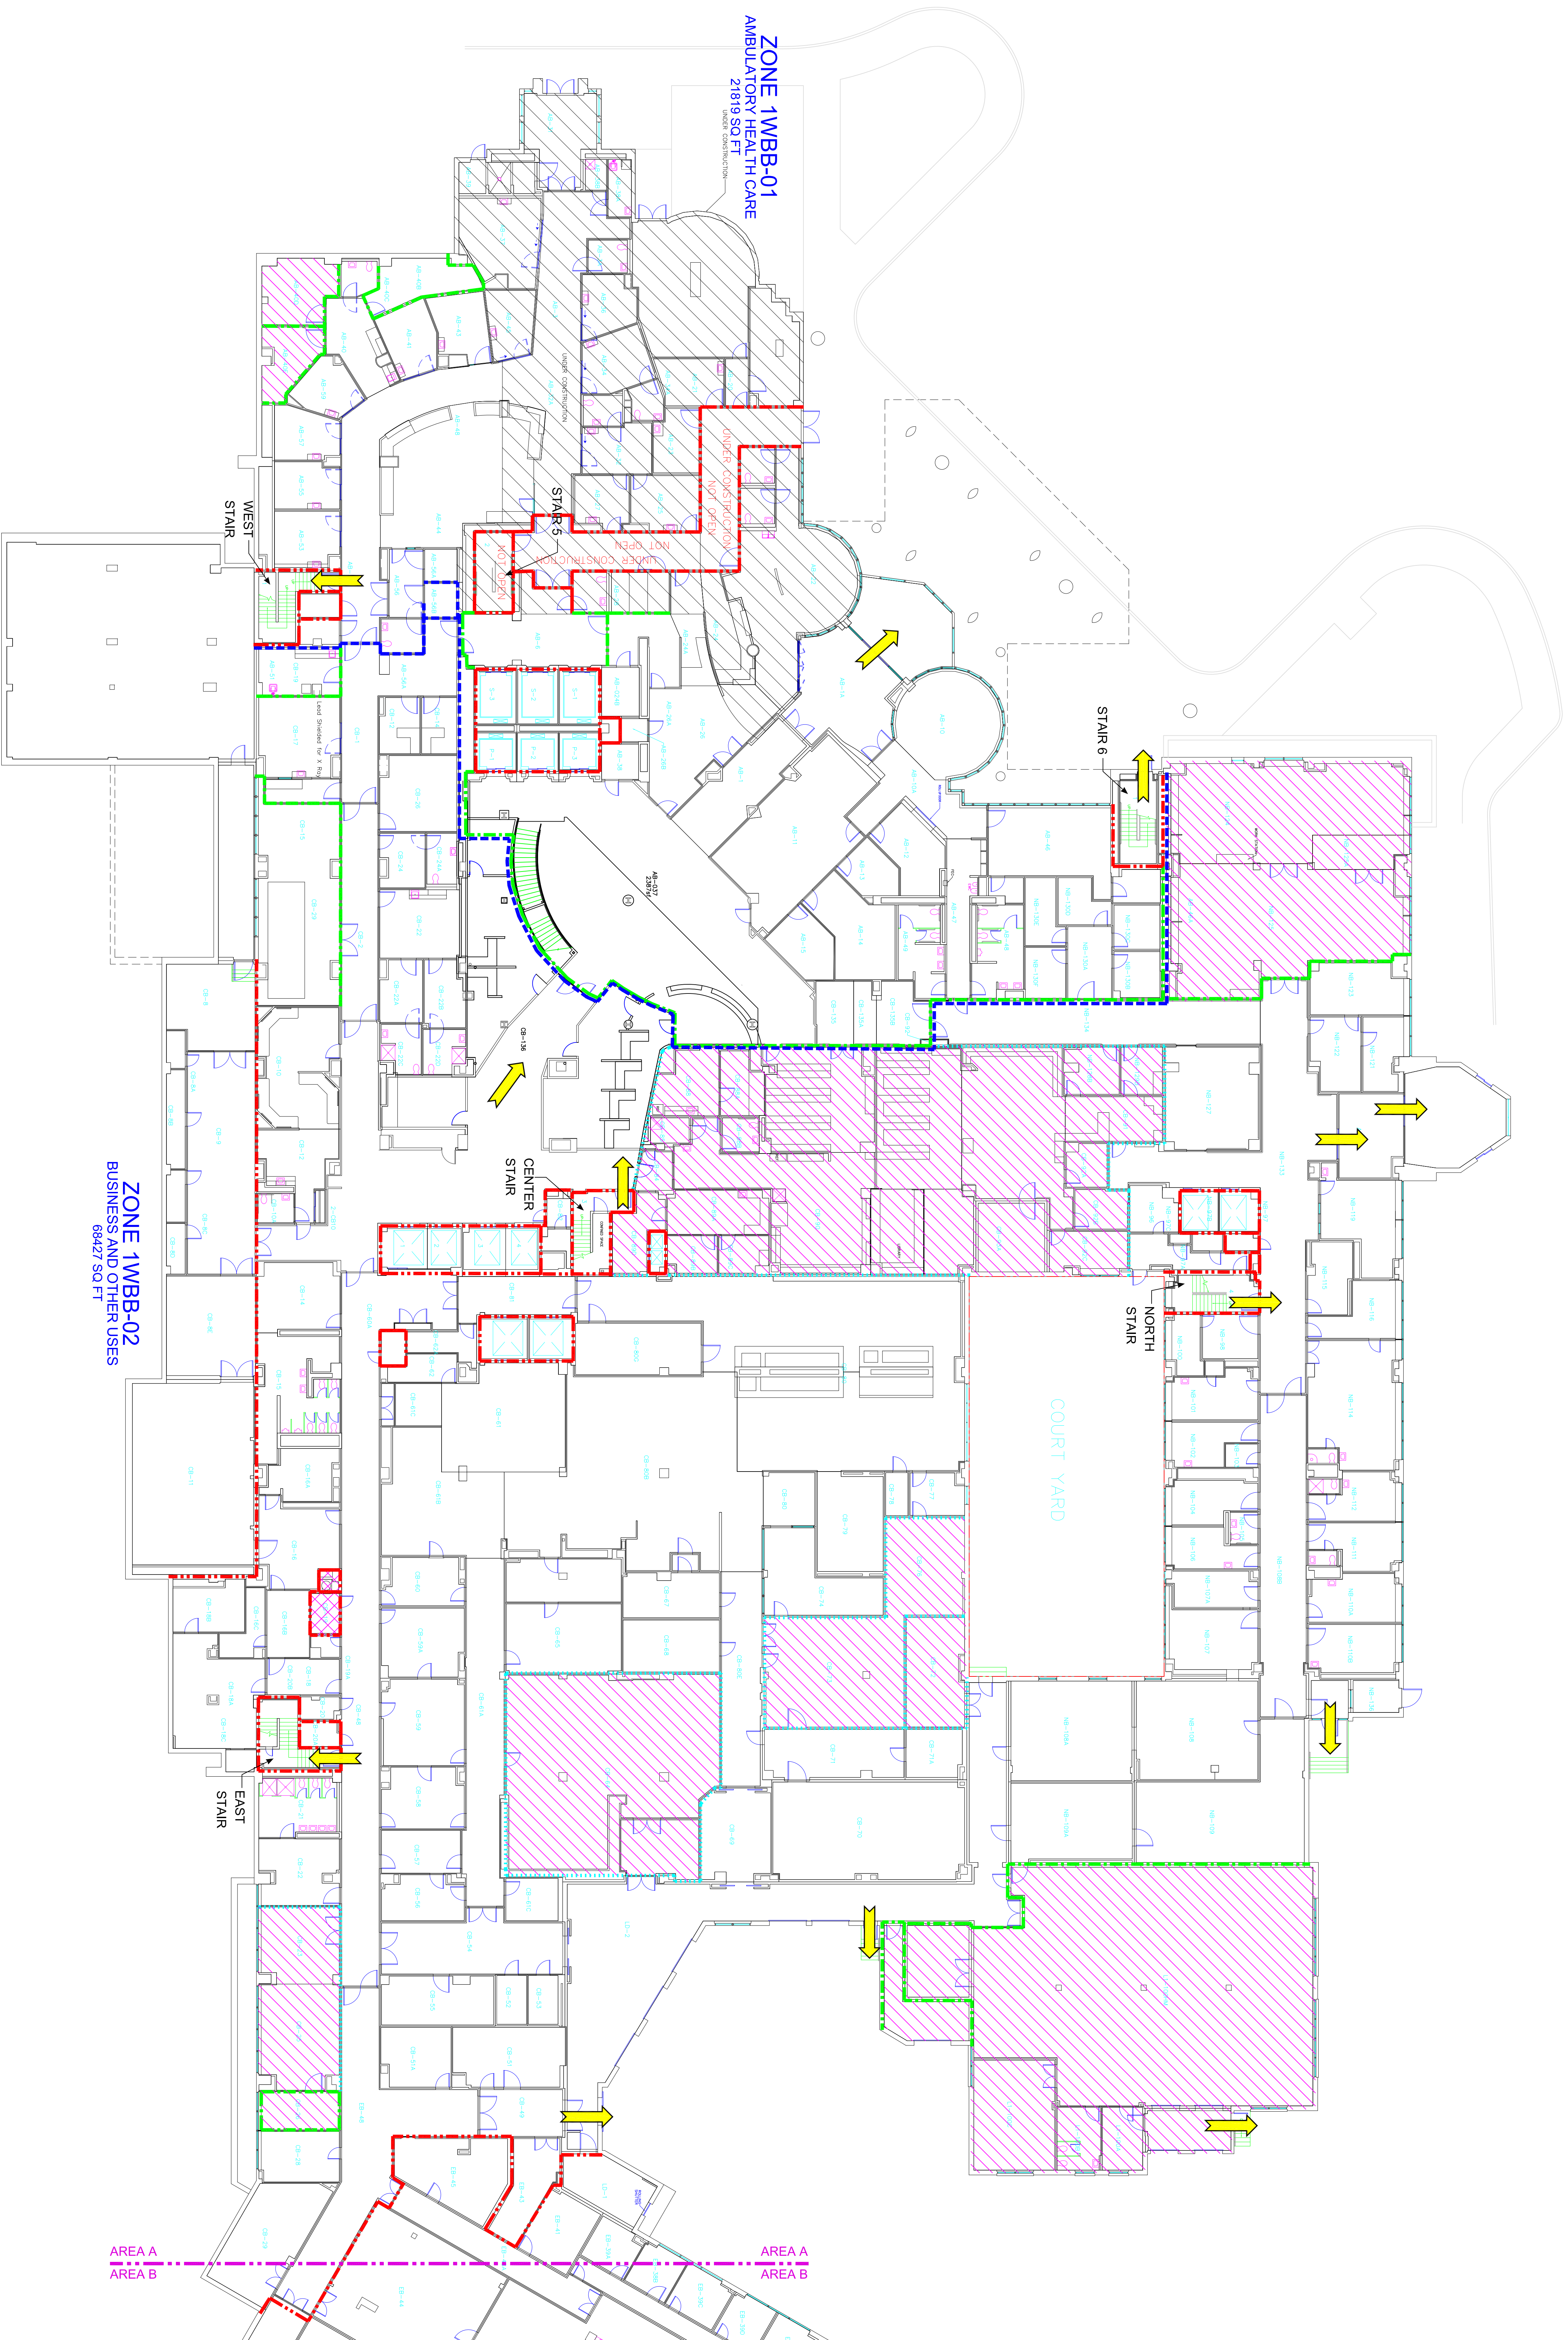

BASEMENT FLOOR - AREA A

SCALE: None

None