


Commonwealth Guardrail, Inc.
132 Apremont Way
Westfield, MA 01085

ALBANY V.A. Hospital

8/16/10

4 of 4

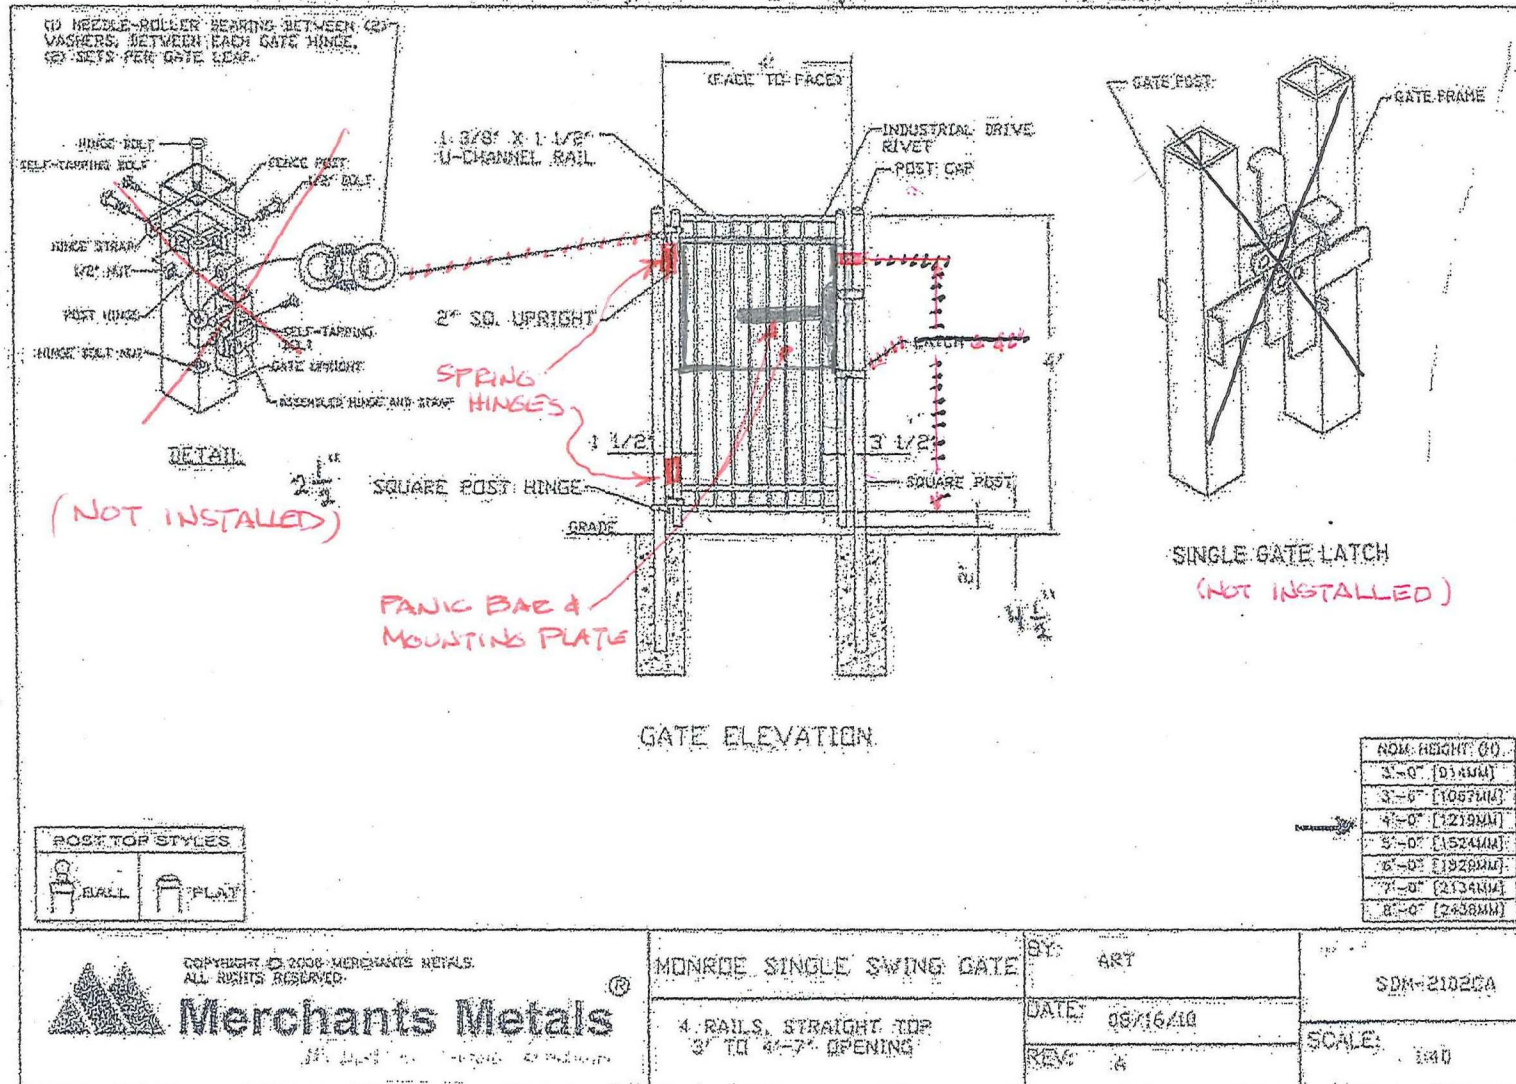


Commonwealth Guardrail, Inc.
132 Apramont Way
Westfield, MA 01085

Albany V.A. Hospital

8/10/10

1 of 4

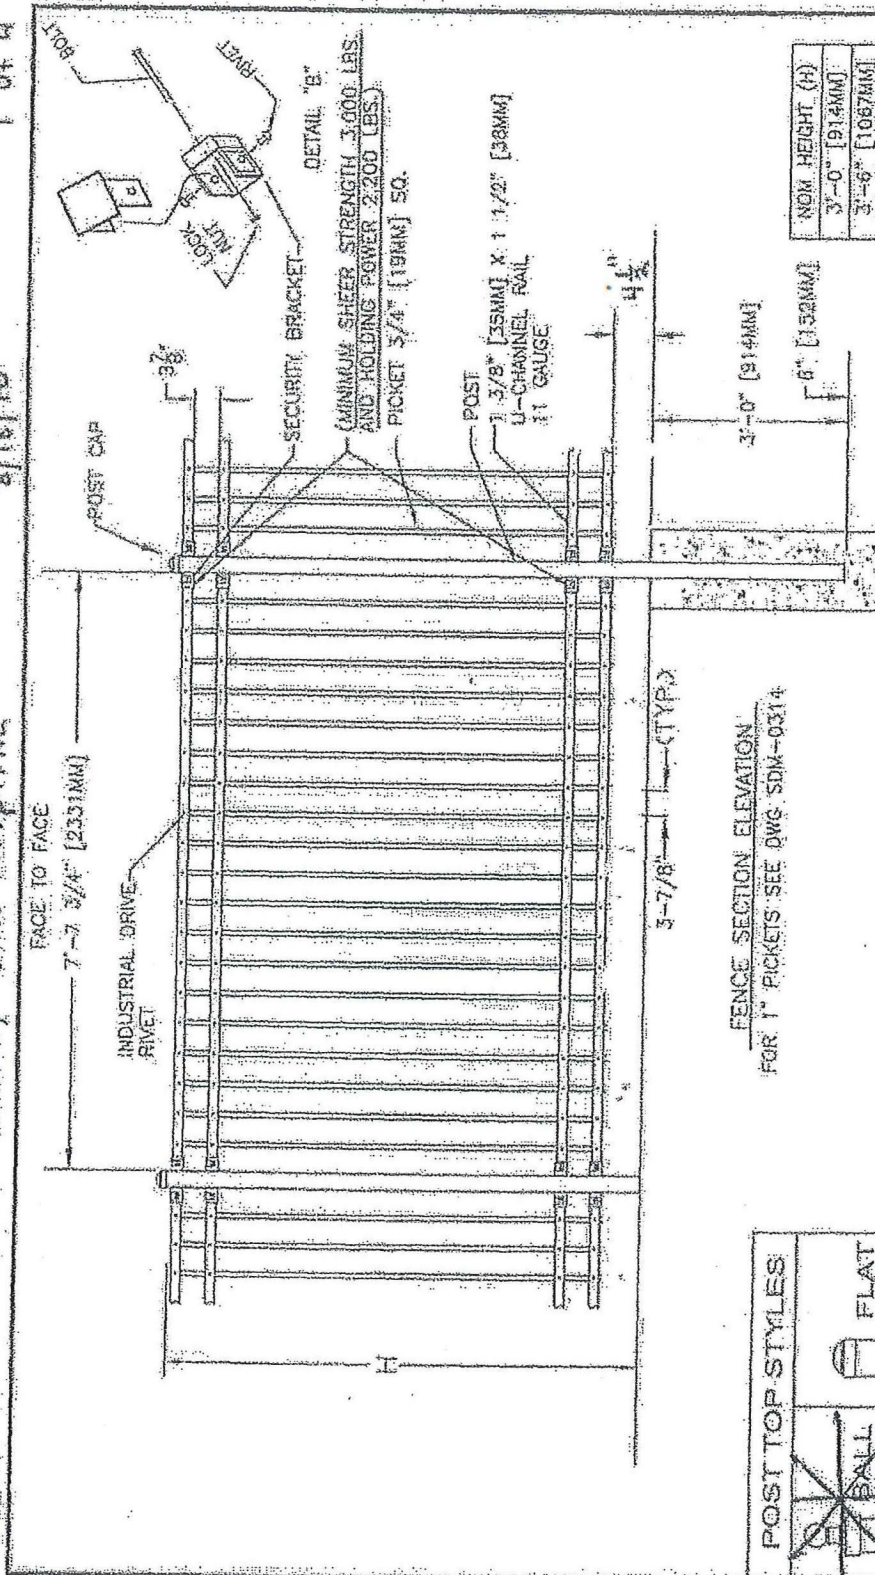

NOTES:

1. SPECIFICATIONS SHOWN CAN BE CHANGED BY THE MANUFACTURER ONLY.
2. FOOTING WIDTH TO BE (4)X POST WIDTH.

3) Three sections and Two Posts between Each Picket

ALL RIGHTS RESERVED



Merchants Metals
the first name in fence solutions

MONROE STYLE 4 RAILS

8' SECTION 3/4" PICKET
(Nom. Dimension)

DATE: 05-12-05

REV: A

QWG. NO.

SDM-0304

SCALE: 1/2" = 1'-0"