








- GENERAL NOTES:**
- A. IN NEWLY REMODELED FINISHED AREAS, ALL OUTLET BOXES SHALL BE FLUSH AND ALL NEW CONDUIT SHALL BE CONCEALED UNDER FLOOR FINISHES. ALL NEW CONDUIT SHALL BE INSTALLED IN ACCORDANCE WITH THE NATIONAL ELECTRICAL CODE METHODS USED TO ACHIEVE CONCEALED AND FLUSH EQUIPMENT INSTALLATION. USE THE RESPONSIBILITY OF THE ELECTRICAL CONTRACTOR, COORDINATE WITH GENERAL CONTRACTOR AND OTHER AFFECTED TRADES. SEE SPECIFICATIONS FOR CUTTING AND PATCHING.
- B. REMODELING, MODIFYING, PATCHING AND REPAIR OF EXISTING BUILDING COMPONENTS SHALL BE DONE AS REQUIRED TO PRODUCE FINISHED WORK EQUAL TO THE NEW WORK AS SPECIFIED AND DETAIL. CUTTING AND PATCHING SHALL BE THE RESPONSIBILITY OF THE TRADE WHOSE WORK RESULTS IN THE NEED FOR SUCH PATCHING. THE GENERAL CONTRACTOR AND CONTRACTORS IS CALLED OUT ON THE DRAWINGS. CONTRACTOR SHALL COMPLETE ALL WORK NECESSARY TO ACHIEVE THIS REQUIREMENT. EVEN THOUGH PROCEDURES ARE NOT DETAILD AND/OR SPECIFIED FOR EACH SPECIFIC CONDITION OR COMBINATION OF CONDITIONS, QUALITY OF WORKSMANSHIP, MATERIALS AND FINISH SHALL BE EQUAL TO THE LEVEL ESTABLISHED FOR SIMILAR NEW WORK, EXCEPT WHERE EXISTING APPEARANCE IS TO BE MATCH TO PROVIDE CONTINUITY.
- C. FIRE ALARM SYSTEMS IS SIEMENS PYROTRONICS, INTERCONNECT/ INTERSTAGE TO EXISTING SYSTEM.

SHEET NOTES:


① REFER TO SHEET EY100 AND MECHANICAL DRAWINGS FOR DUCT DETECTOR LOCATIONS.

ELECTRICAL SYMBOLS - POWER PLAN


-  RECEPTACLE, DUPLEX
-  RECEPTACLE, DUPLEX WITH GROUND FAULT INTERRUPTER
-  PULL BOX
-  CONDUIT UP
-  CONDUIT DOWN
-  DISCONNECT SWITCH, UNFUSED
-  VARIABLE FREQUENCY DRIVE

ELECTRICAL ABBREVIATIONS


PB PULL BOX

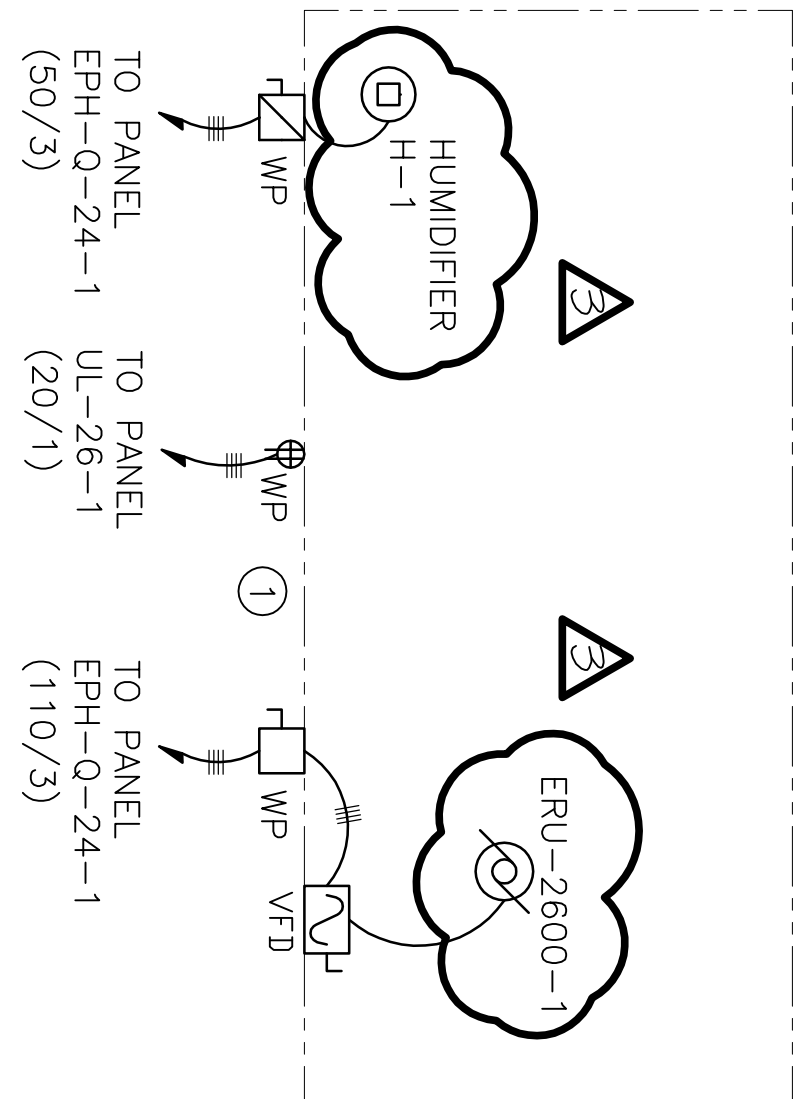

APPROXIMATE LOCATION OF ELECTRICAL ROOF PENETRATIONS

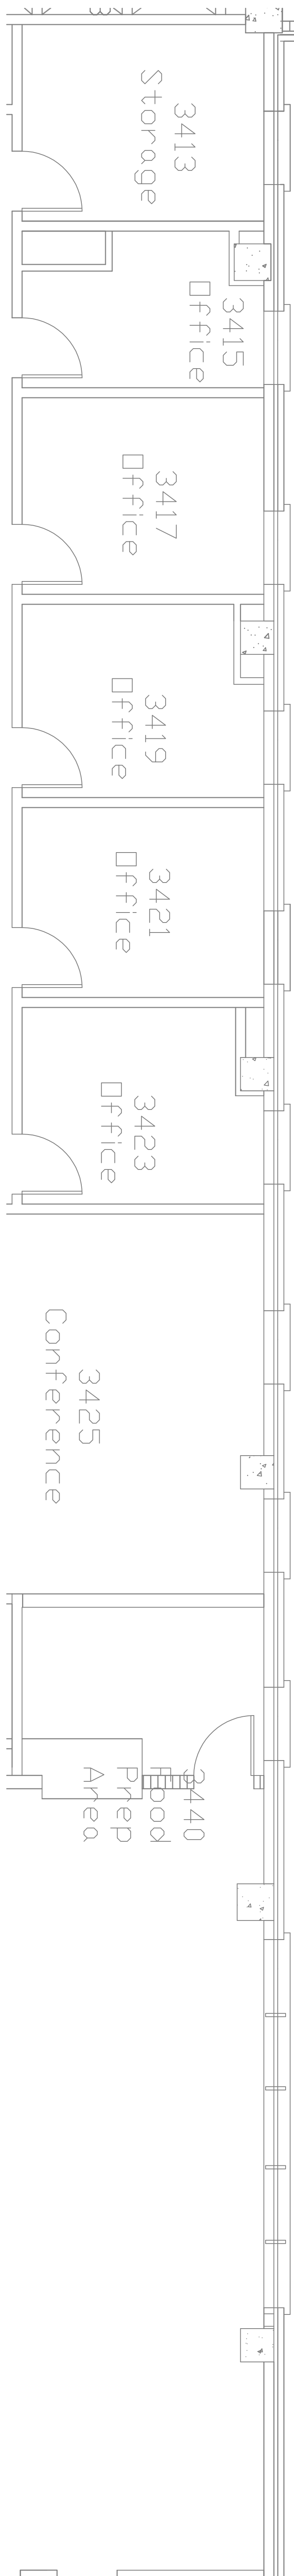

PARTIAL THIRD FLOOR PLAN - POWER

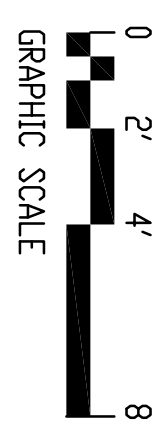

SCALE: 1/4" = 1'-0"

[illegible]