




1 6' HT. CHAIN-LINK FENCE W/ BARBED WIRE
SCALE: NTS

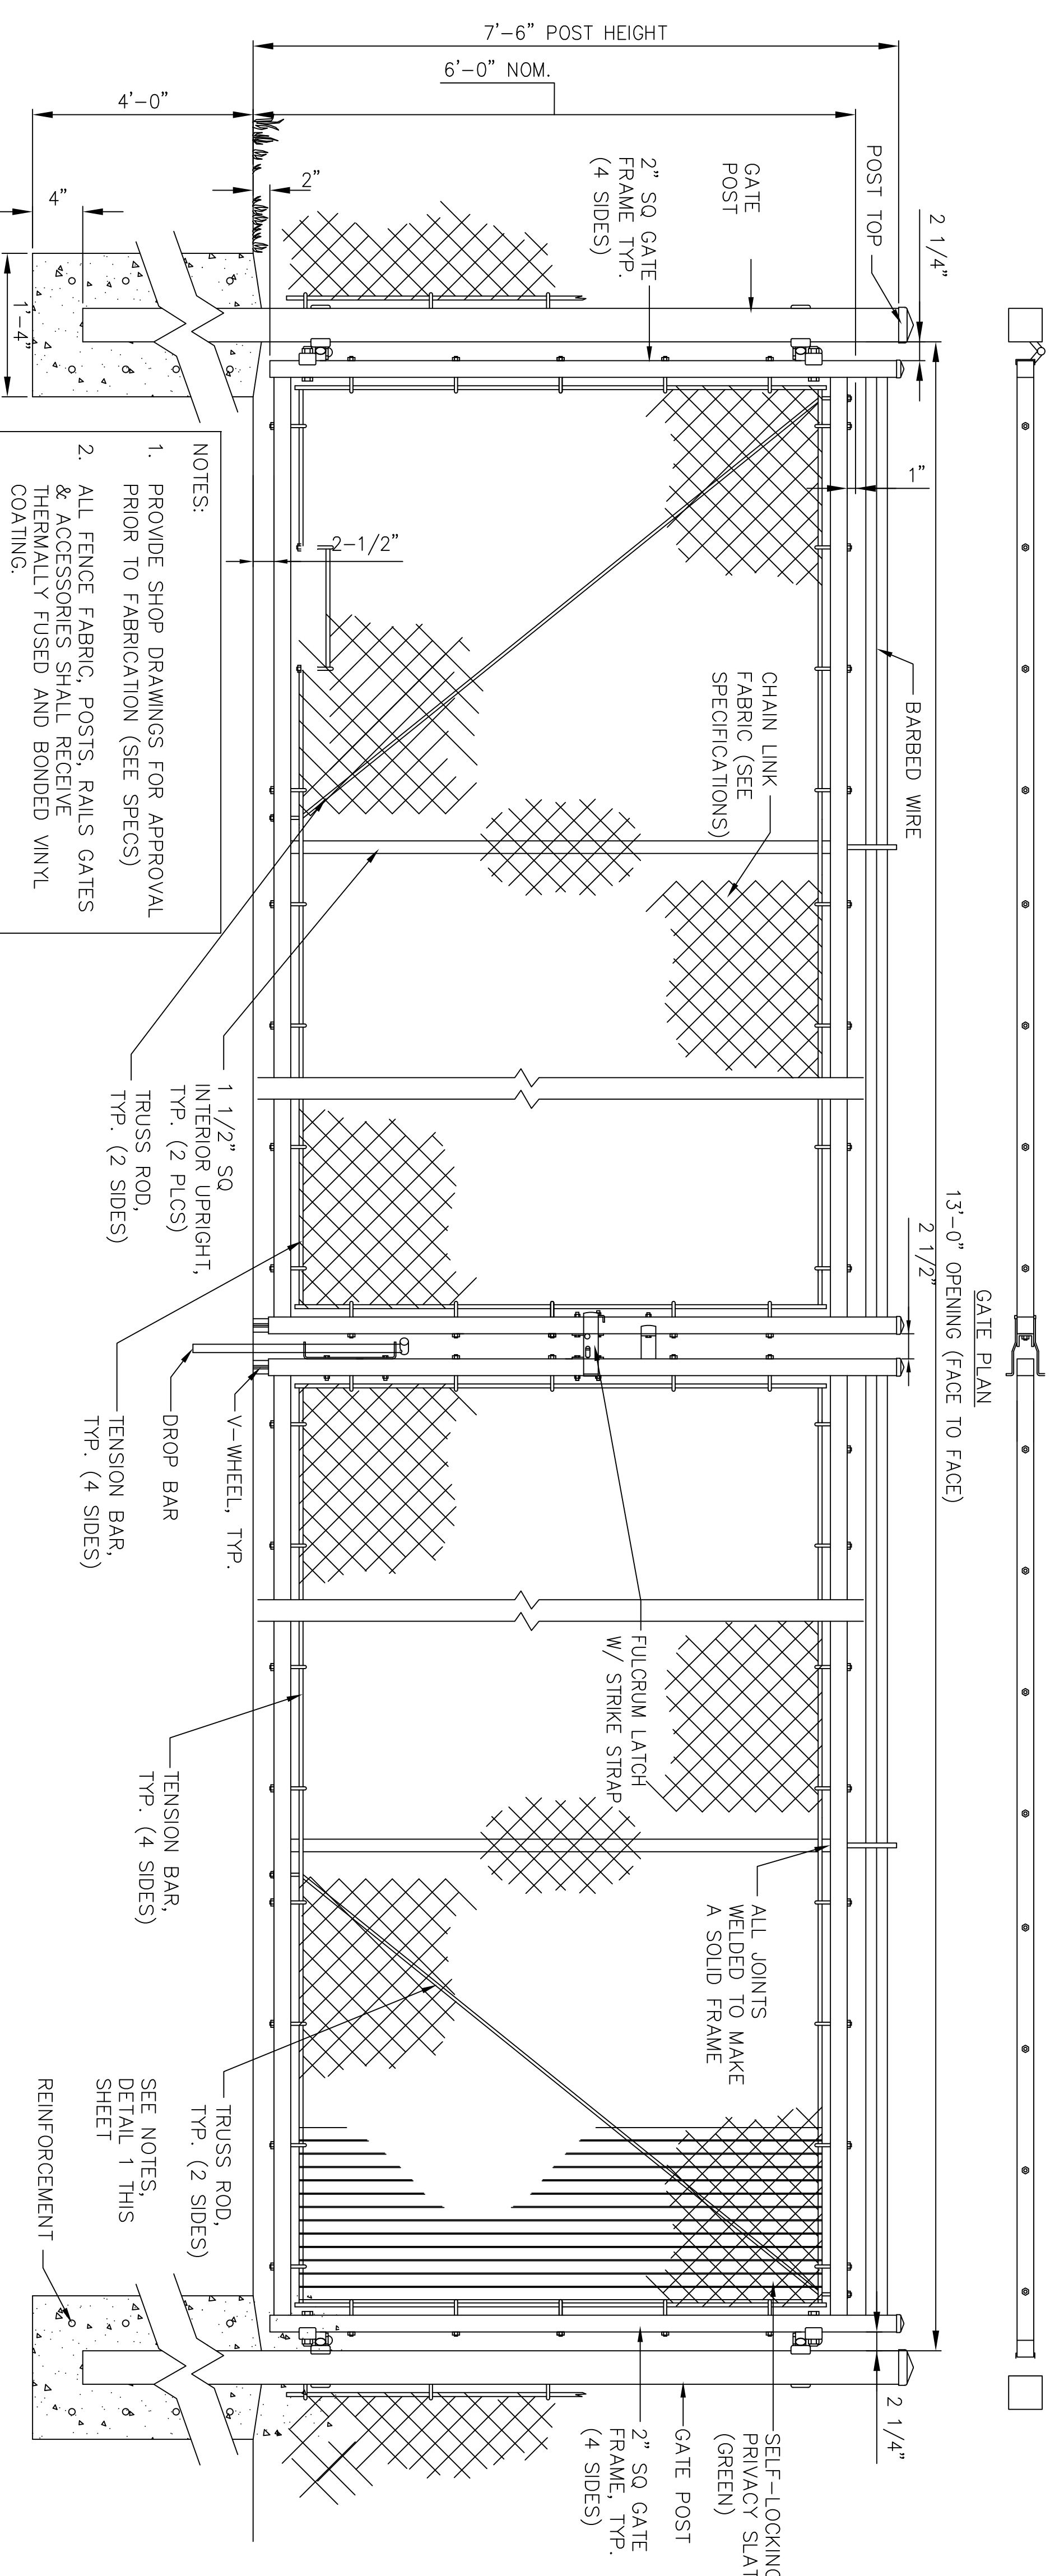


2 6' SWING GATE WITH BARB WIRE
SCALE: NTS

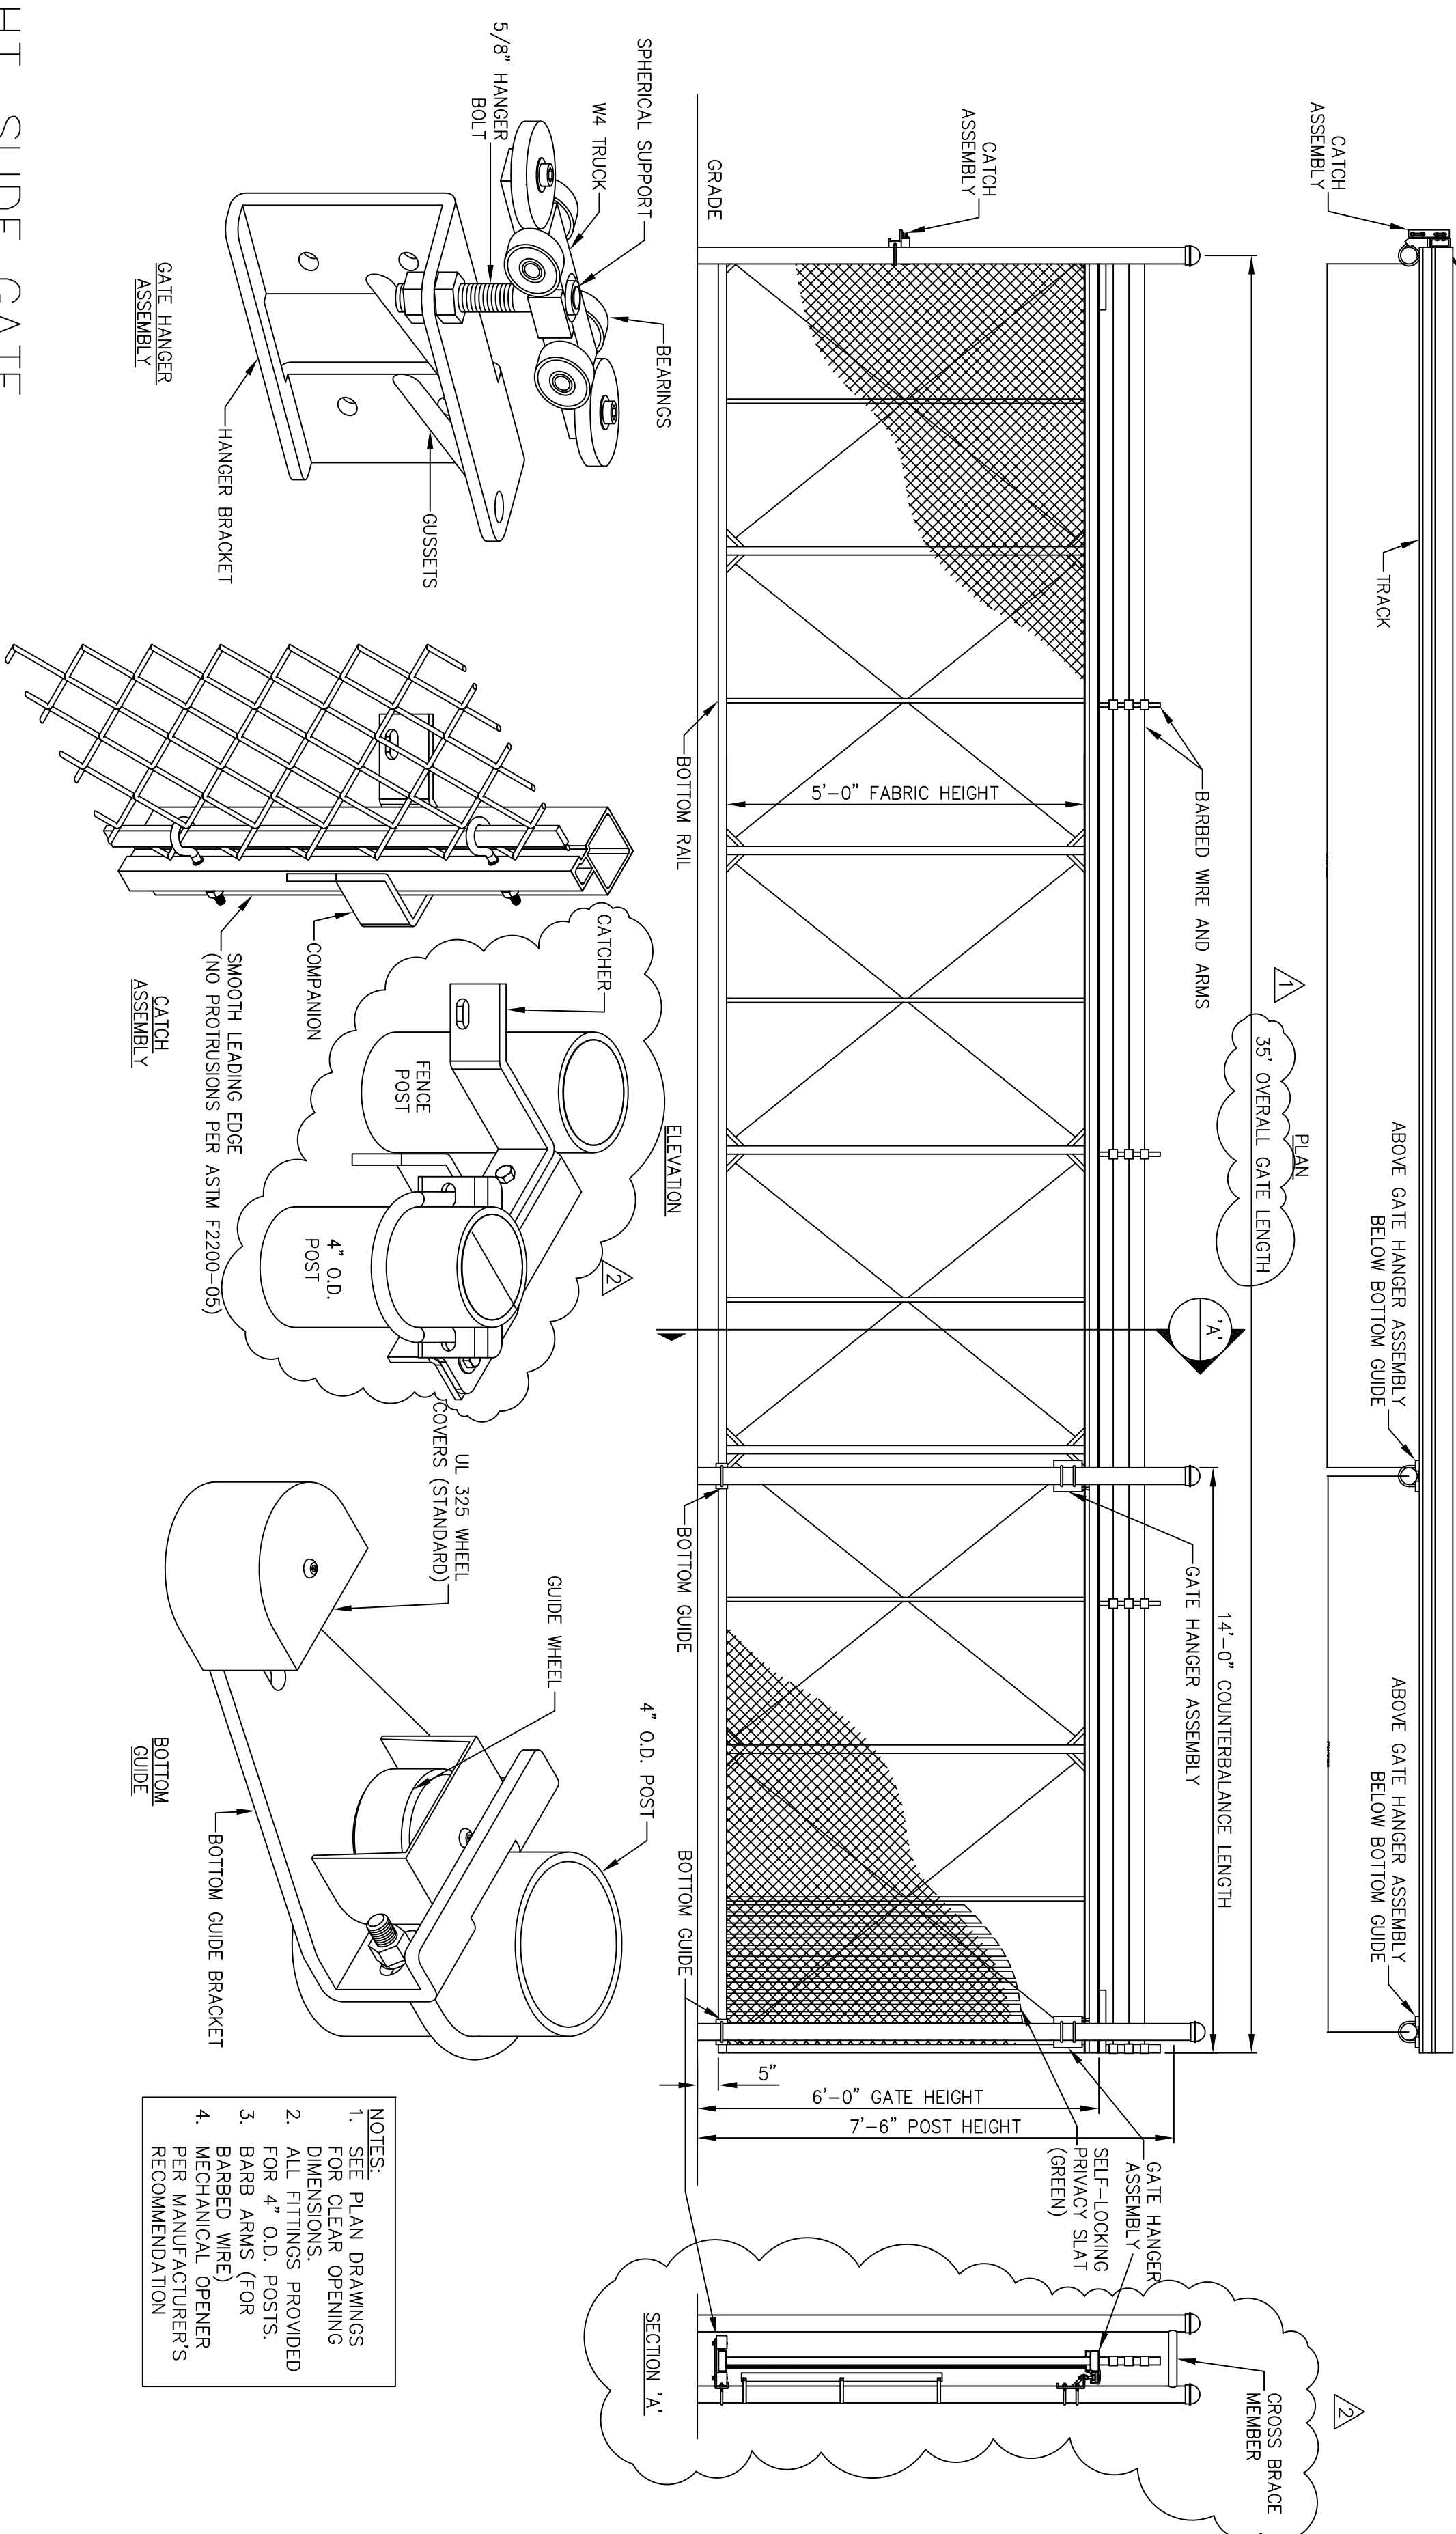

3 6' HT. SLIDE GATE
SCALE: NTS

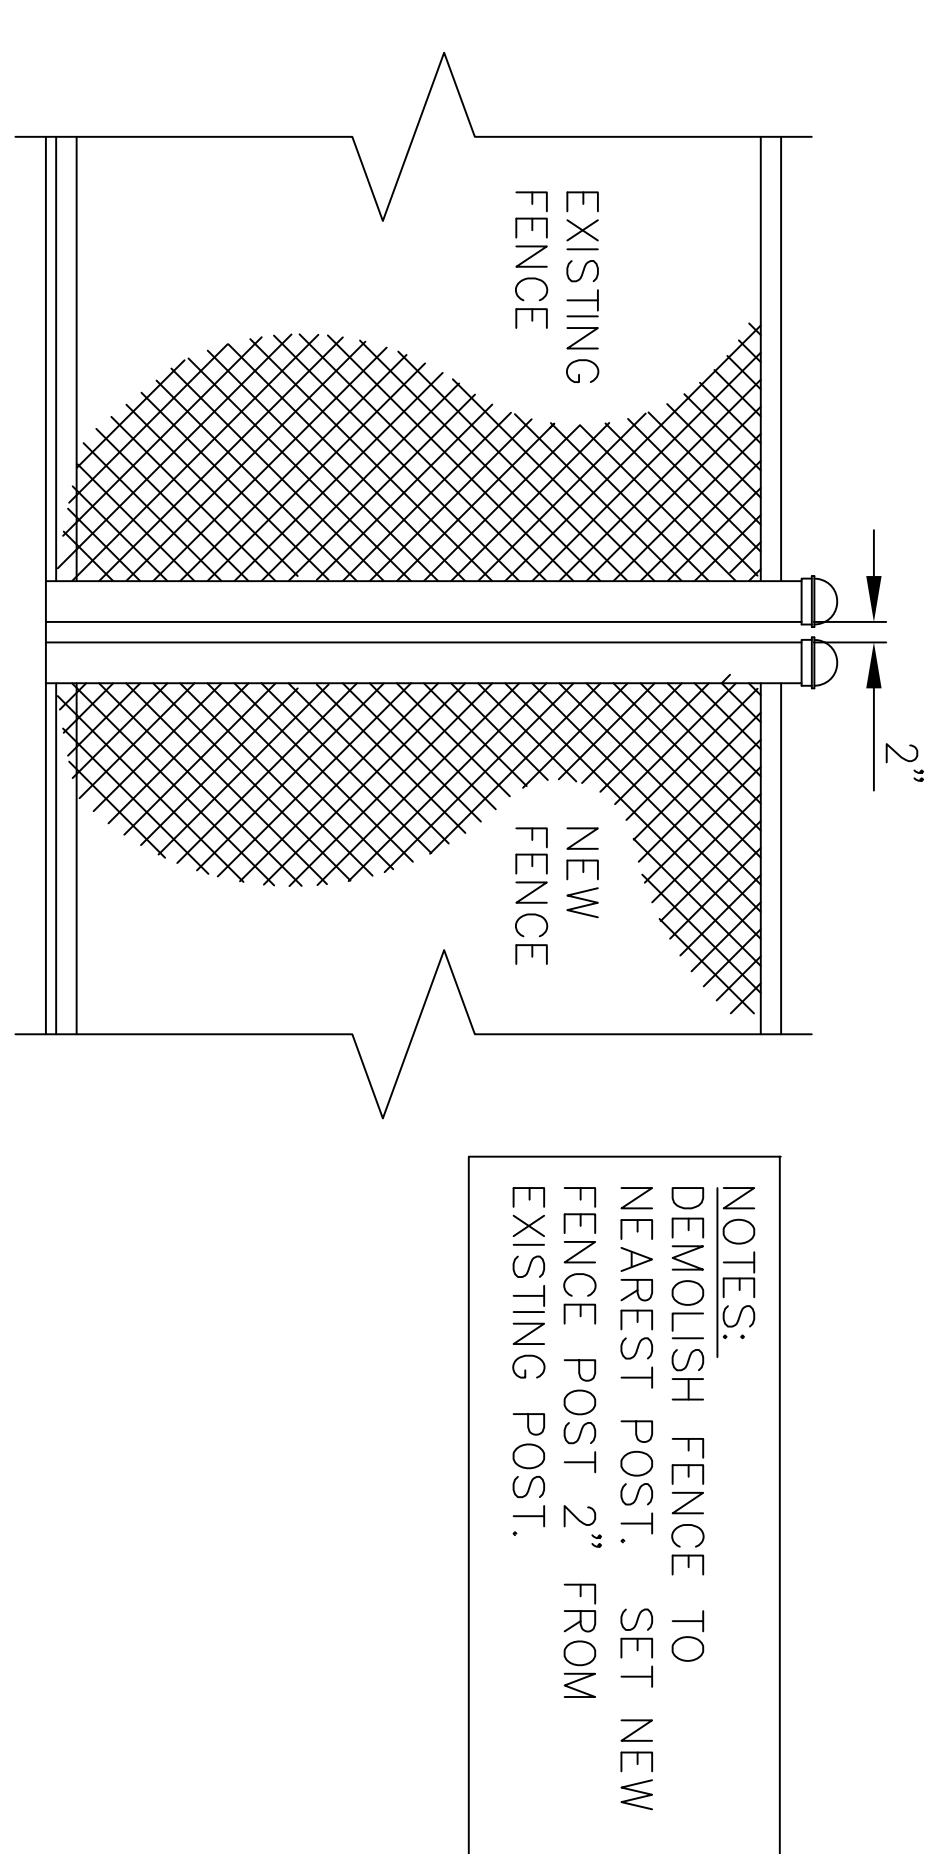

4 CONNECTION TO EXISTING FENCE
SCALE: NTS

1. Revised overall dimension of slide gate to 35'. 2. Display two-post assembly for catch and gate detail. 3. Deleted concrete mow strip.		5/1/17
Revisions		Date
<div><div><div><div>NATIONAL CEMETERY</div><div>ADMINISTRATION</div></div></div><div><div>Drawing Title</div><div>FENCE DETAILS</div></div><div><div>Project Title</div><div>REPAIR CHAIN LINK FENCE</div></div><div><div>Approved: Division Chief</div><div>Building Number</div><div>Checked</div><div>Drawn</div><div>Approved: Service Director</div><div>Location</div><div>HOUSTON NATIONAL CEMETERY</div></div><div><div>Date</div><div>02/13/2017</div></div><div><div>Project No.</div><div>851-17-202</div></div><div><div>Dwg. 4 Of 4</div><div>L-201</div></div></div>		