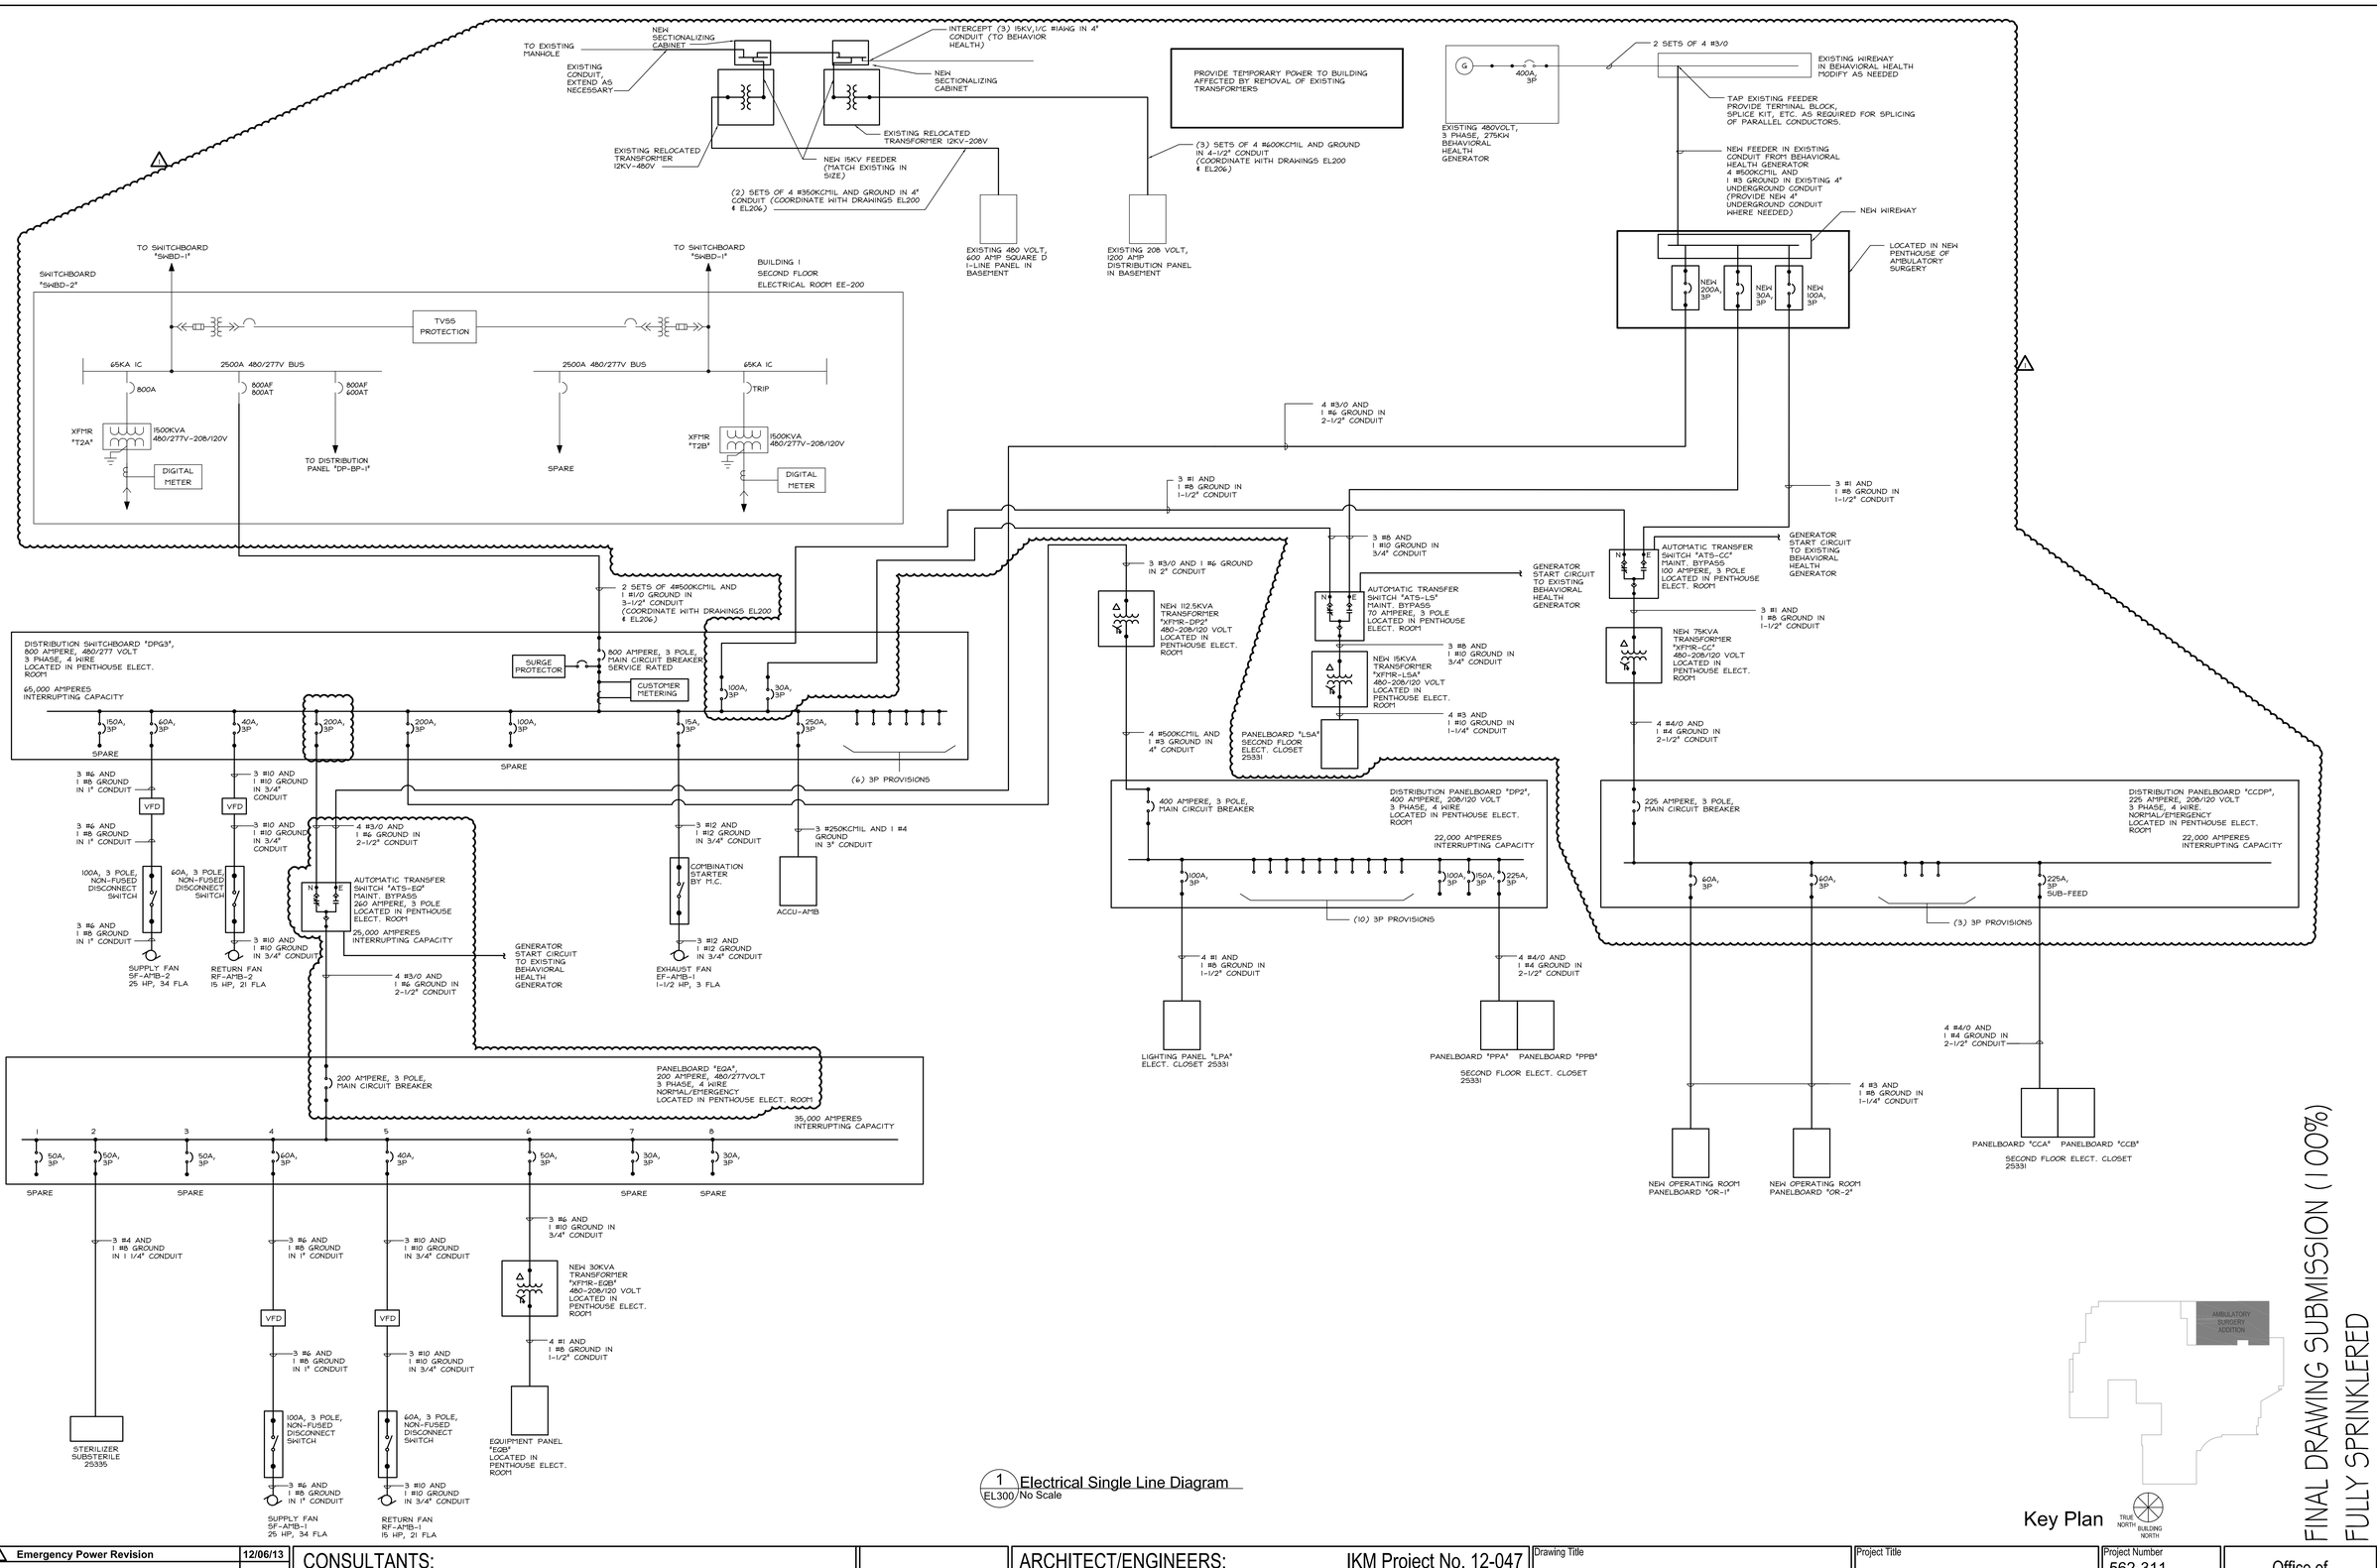

1 EL300 Electrical Single Line Diagram
No Scale

Key Plan

FINAL DRAWING SUBMISSION (100%)
FULLY SPRINKLERED

Emergency Power Revision	12/06/13
AS-BUILT	02-23-2016

CONSULTANTS:

Keystone Structural Solutions Consulting Engineers
8150 Perry Highway, Suite 302
Pittsburgh PA, 15237
Phone: 412-369-9020
Contact: Mark Sipos

GATEWAY Engineers, Inc. On Call. On Time. On Target.
The Gateway Engineering, Inc.
A Full Service Civil Engineering Firm
400 Holiday Drive, Suite 300
Pittsburgh PA, 15220
Phone: 412-921-4030
Contact: Sean Donnelly

FIRSCHING, MARSTILLER, RUSBARSKY AND WOLF ENGINEERING, INC.
1500 ARDMORE BOULEVARD, SUITE 200 PITTSBURGH, PA 15221
(412) 271-5090 PHONE (412) 271-5193 FAX FILE NO. 12080
Contact: Dave Rusbarsky

ARCHITECT/ENGINEERS: IKM Project No. 12-047

IKM
architecture
planning
interior design
IKM Incorporated
One PPG Place
Pittsburgh, PA 15222
Phone: 412-281-1337
Contact: Joe Obritz

Drawing Title	Electrical Single Line Diagram
Approved: Project Director	
Project Title	AMBULATORY SURGERY ADDITION REDESIGN
Location	VAMC 135 EAST 38th STREET, ERIE PENNSYLVANIA, 16504
Date	12 MAR 2013
Checked	CEM
Drawn	BMM
Project Number	562-311
Building Number	
Drawing Number	EL300
Dwg.	83 of 86

Office of Construction and Facilities Management
Department of Veterans Affairs

VA FORM 08-6231