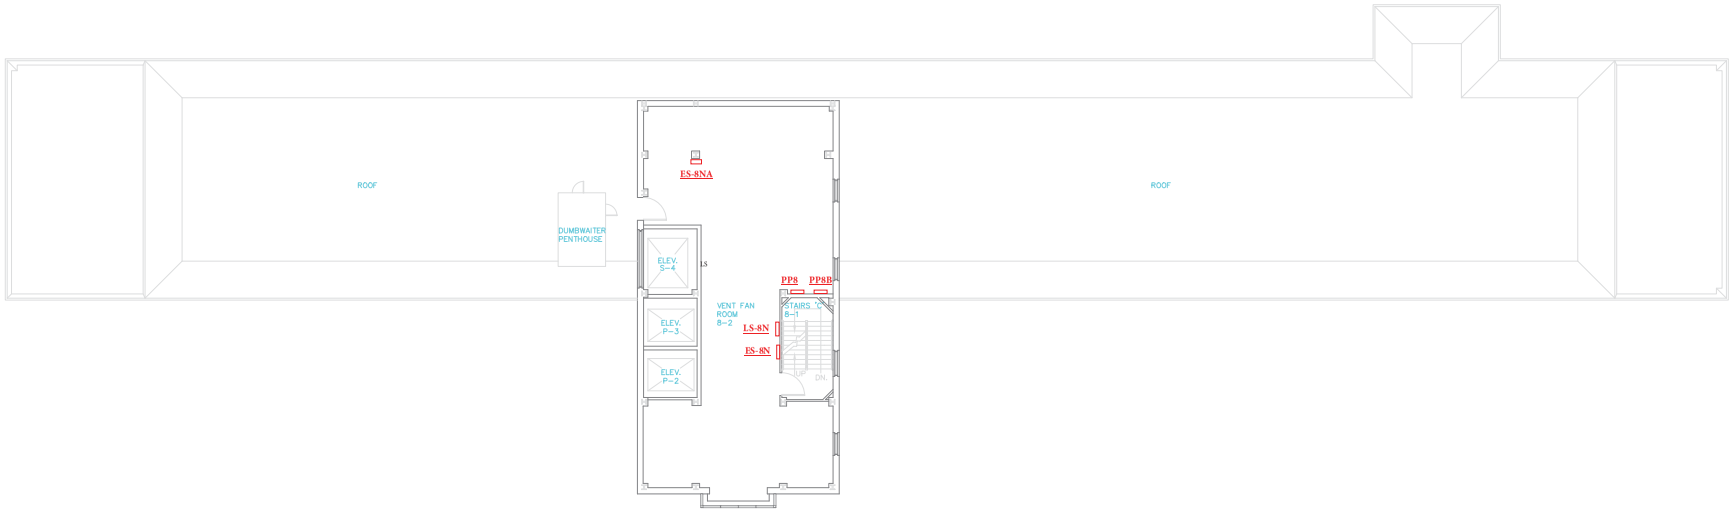

Revisions	Date

Professional Seal

Indus Systems, Inc.
2352, Main Street, Concord MA 01742
Tel: 978-461-0555
www.indus-systems.com

Drawing Title	Project Title	Date
EIGHTH FLOOR PLAN ARCHITECTURAL	AS-BUILT Drawings	10-15-2010
		Project No.
Approved:	Building Number 01 / Checked / Drawn	Drawing No.
Approved:	Location VAMC, ERIE PENNSYLVANIA	

VAMC, ERIE

VA Department of Veterans Affairs

VA FORM 08-6231, OCT 1978