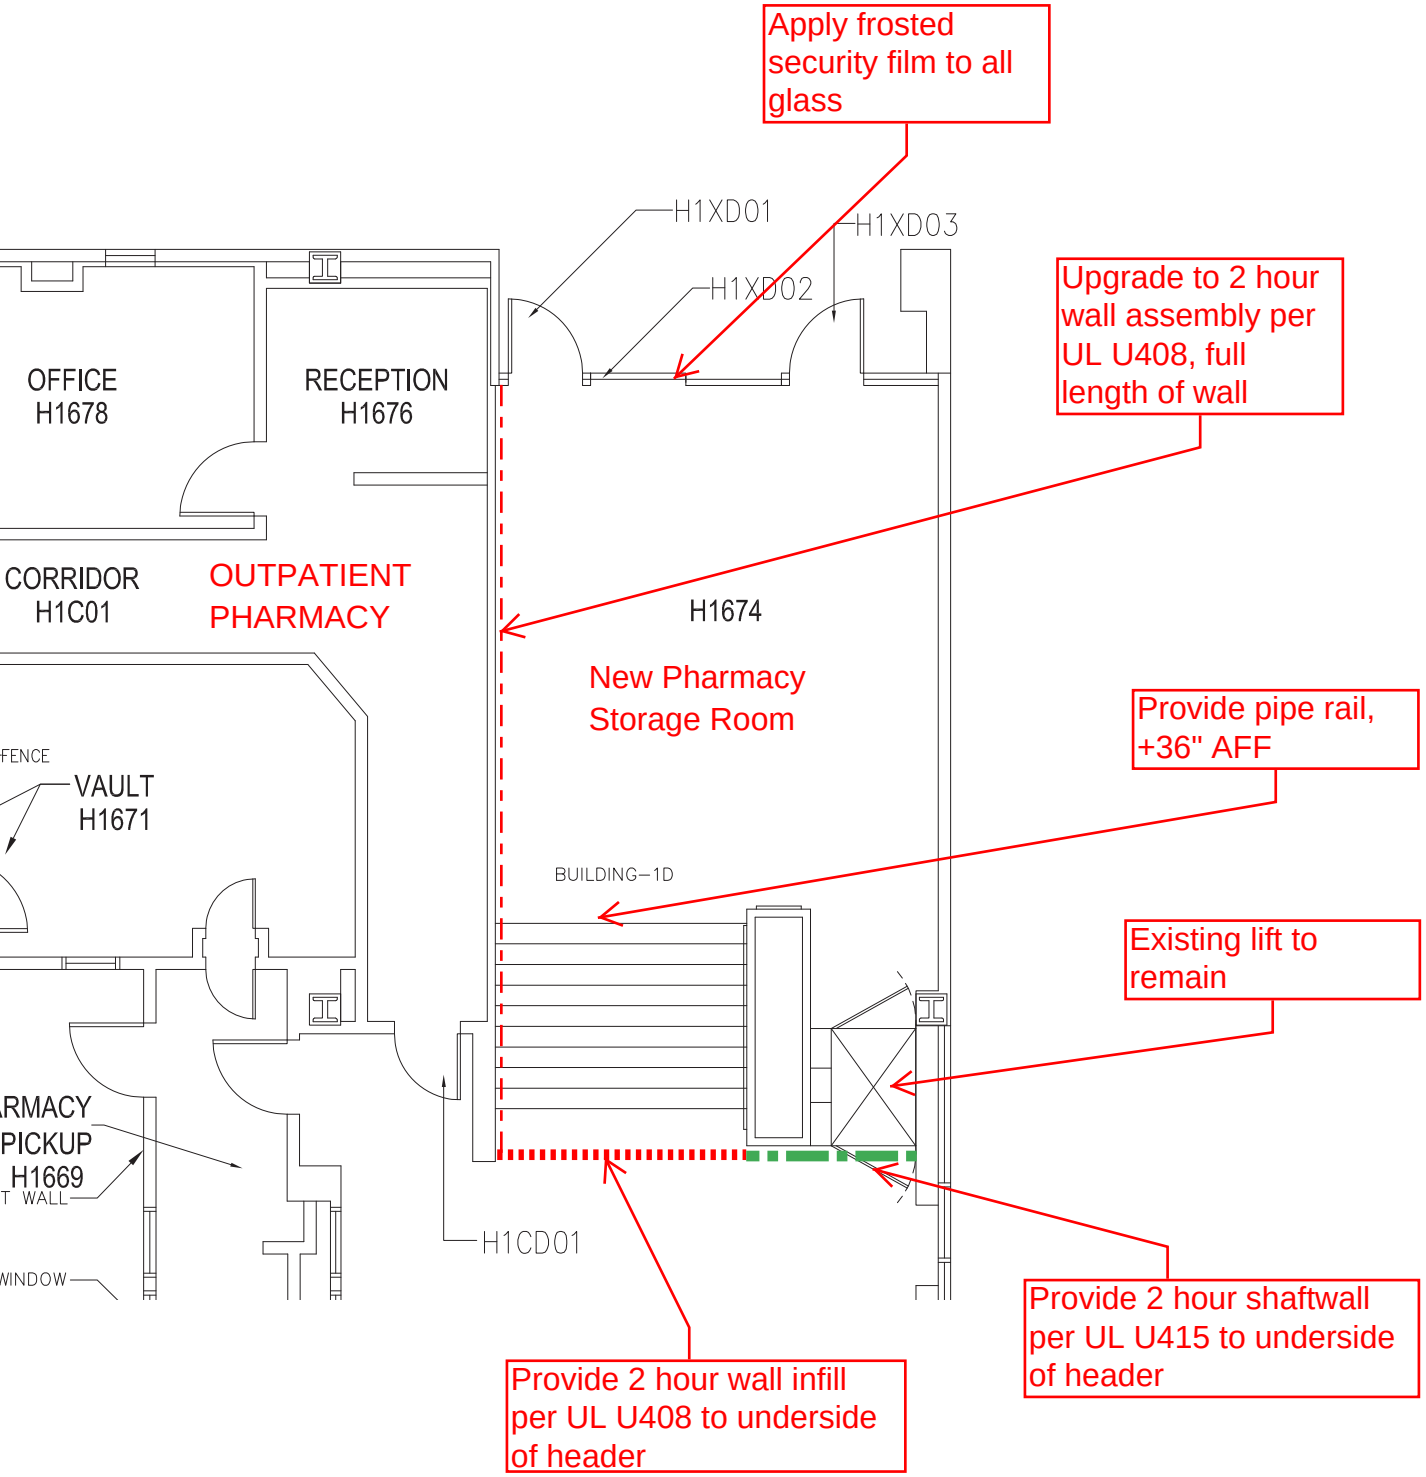

First Floor Plan