



one and one half inches = one foot  
one inch = one foot  
three quarters inch = one foot  
one half inch = one foot  
three eighths inch = one foot  
one quarter inch = one foot  
one eighth inch = one foot

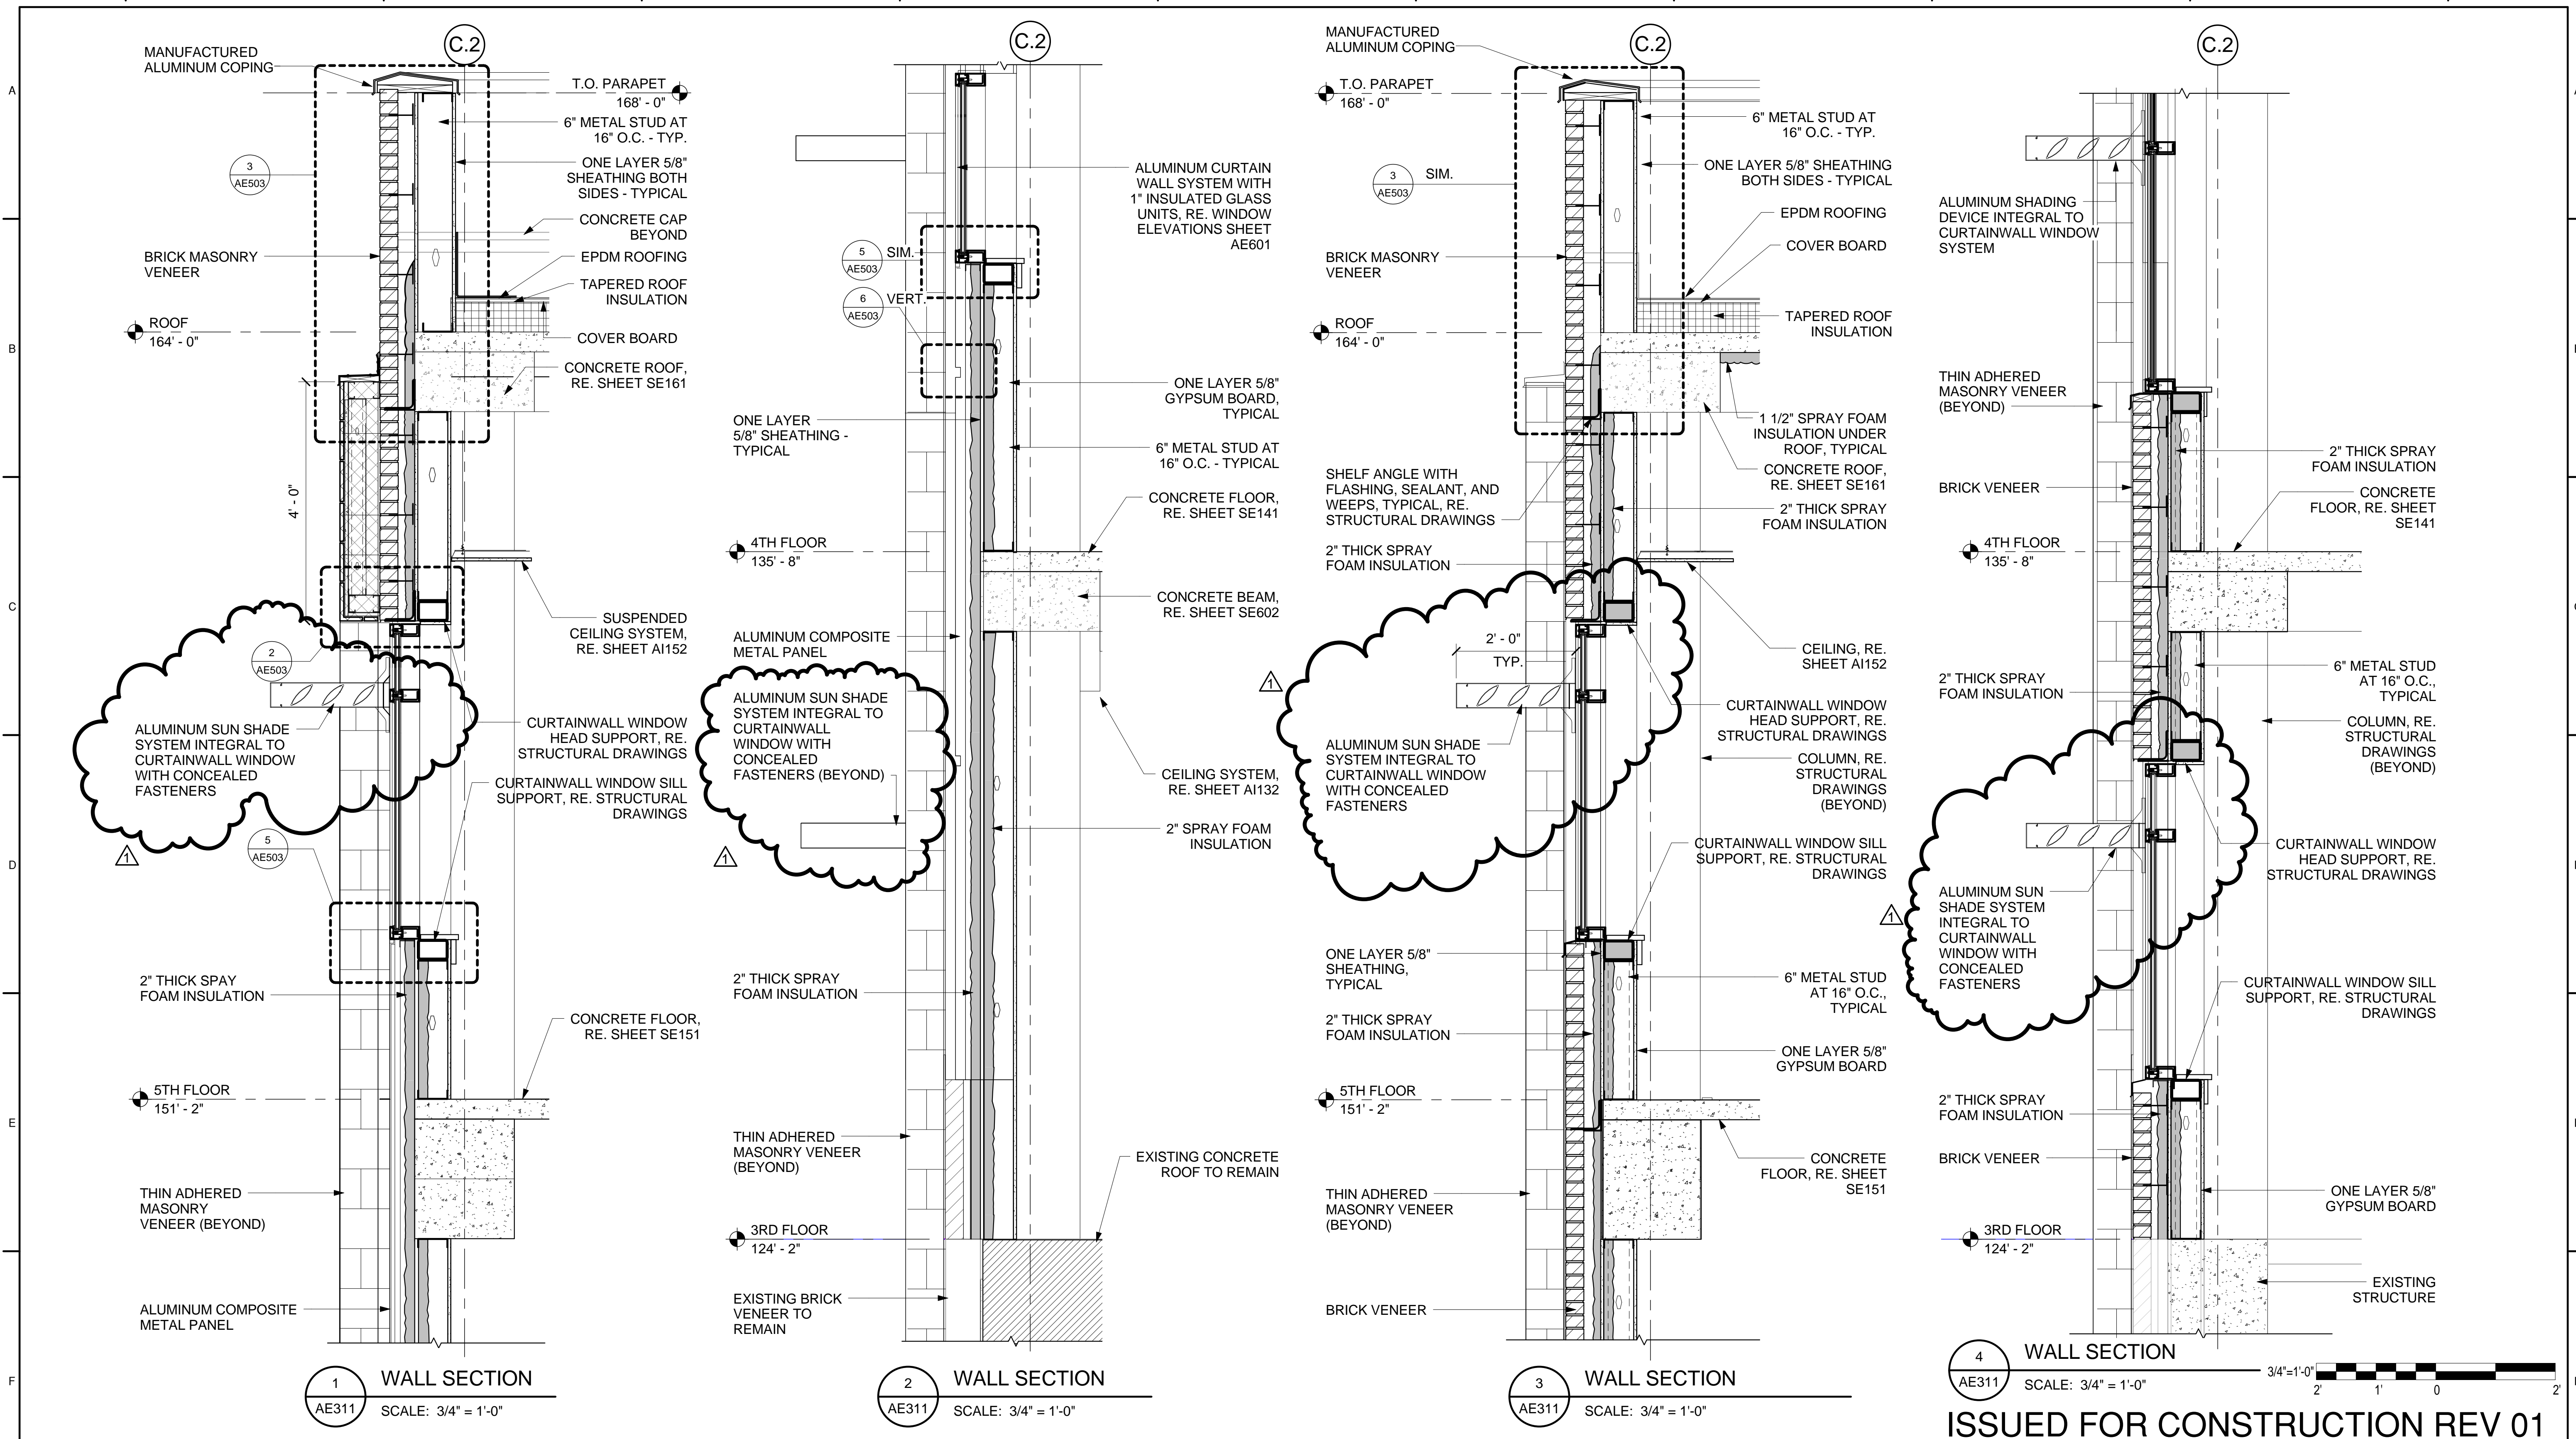

ISSUED FOR CONSTRUCTION REV 01


<div>Revisions:</div> <table border="1"><thead><tr><th>Revisions:</th><th>Date</th></tr></thead><tbody><tr><td>BIDDER INQUIRY RESPONSES</td><td>04.27.17</td></tr></tbody></table>	Revisions:	Date	BIDDER INQUIRY RESPONSES	04.27.17	<b>CONSULTANTS:</b> <div><div>PERKINS + WILL</div><div>1893 General George Patton Drive Franklin, Tennessee 37067 Phone: 615.376.3100 Website: www.mazzetti.com</div><div>MAZZETTI+GBA</div><div>1775 SHERMAN ST., SUITE 2000 DENVER, COLORADO 80203-4358 VOICE: (303) 860-9021 FAX: (303) 860-9537</div><div>J.R. HARRIS &amp; COMPANY</div><div>STRUCTURAL ENGINEERS</div></div>			<b>ARCHITECT/ENGINEERS:</b> <div><div>AES Group, Inc.</div><div>11031 SOUTH PINES PEAK DRIVE #202 PARKER, COLORADO 80138 PH: 303.841.3922 WWW.AES-GRP.COM</div><div>Seal: </div></div>		Drawing Title: WALL SECTIONS		Project Title: EXPAND OR SUITE & CLINICAL ADDITION D-WING		Project Number: 558-323		<b>Office of Construction and Facilities Management</b> <div>Department of Veterans Affairs</div>
	Revisions:	Date														
	BIDDER INQUIRY RESPONSES	04.27.17														
				Approved: Project Director NAME: PETER FAVRET/ALEXANDER SANTAGO PHONE: (919)286-0411 EXT.6444		Location: DURHAM VAMC HOSPITAL		Building Number: 1								
					Date: MARCH 24, 2017		Drawing Number: AE311									
					Checked: DHH		Dwg. 55 of 203									



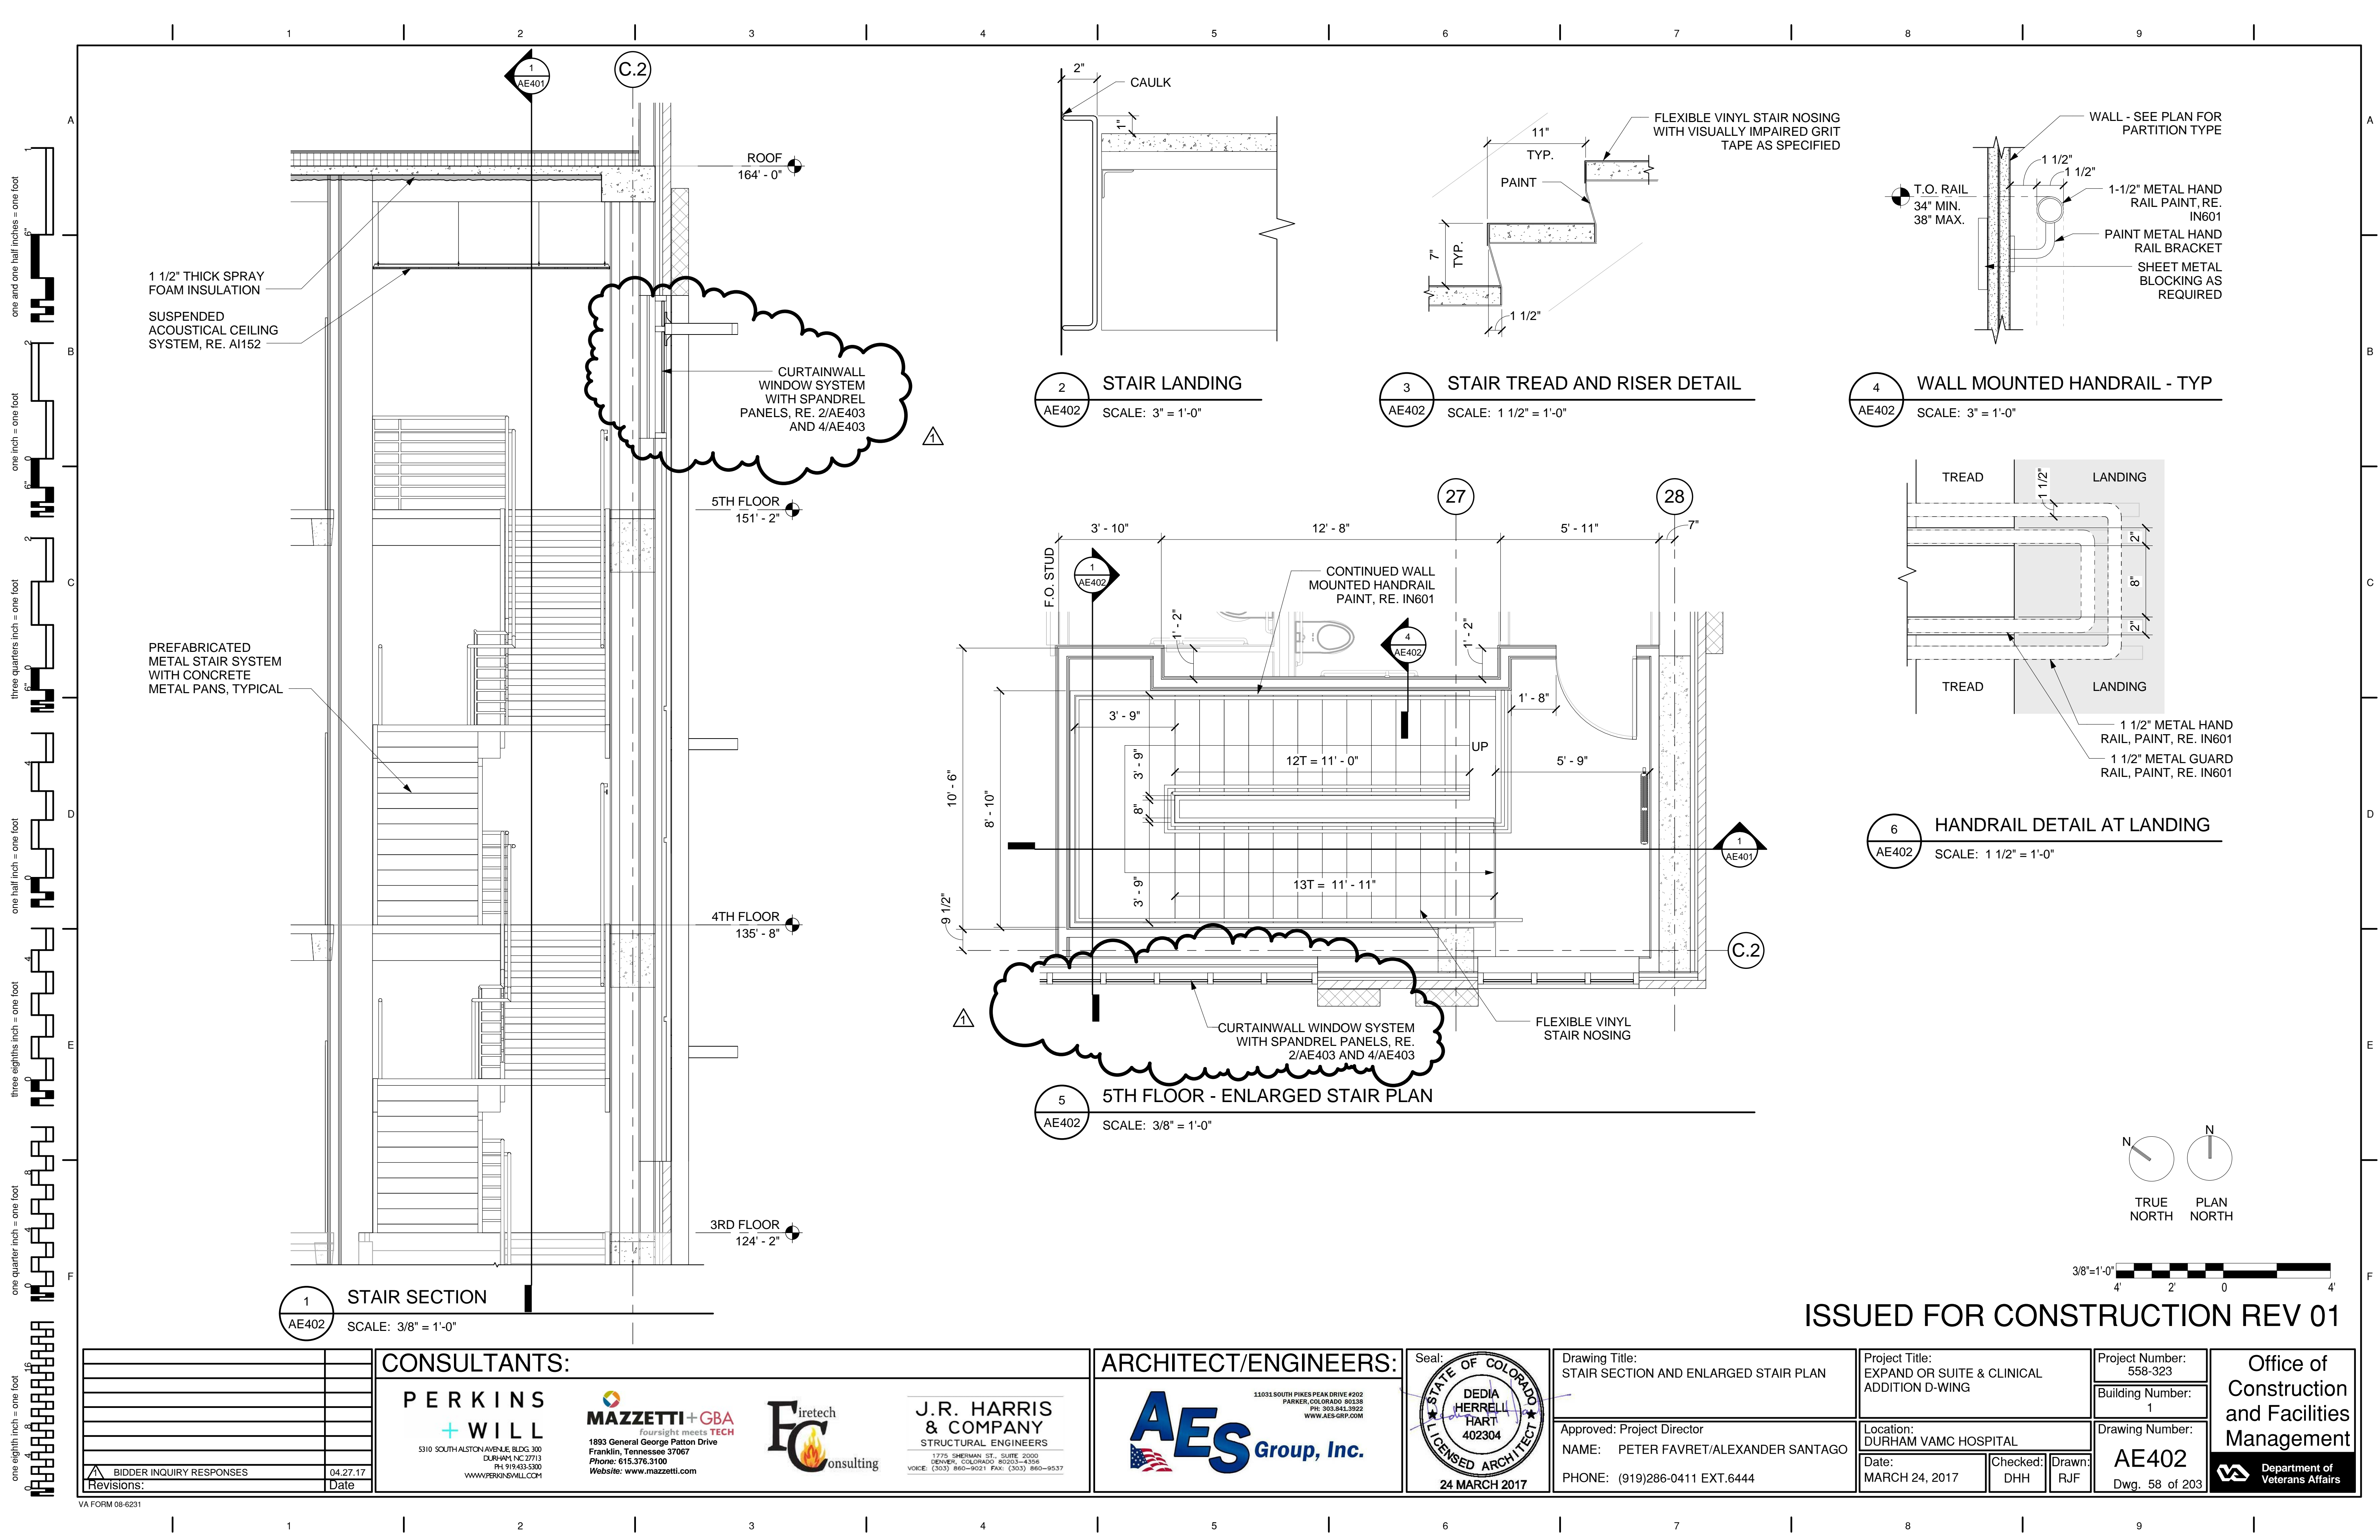





one and one half inches = one foot  
one inch = one foot  
three quarters inch = one foot  
one half inch = one foot  
one eighth inch = one foot  
one quarter inch = one foot  
one eighth inch = one foot

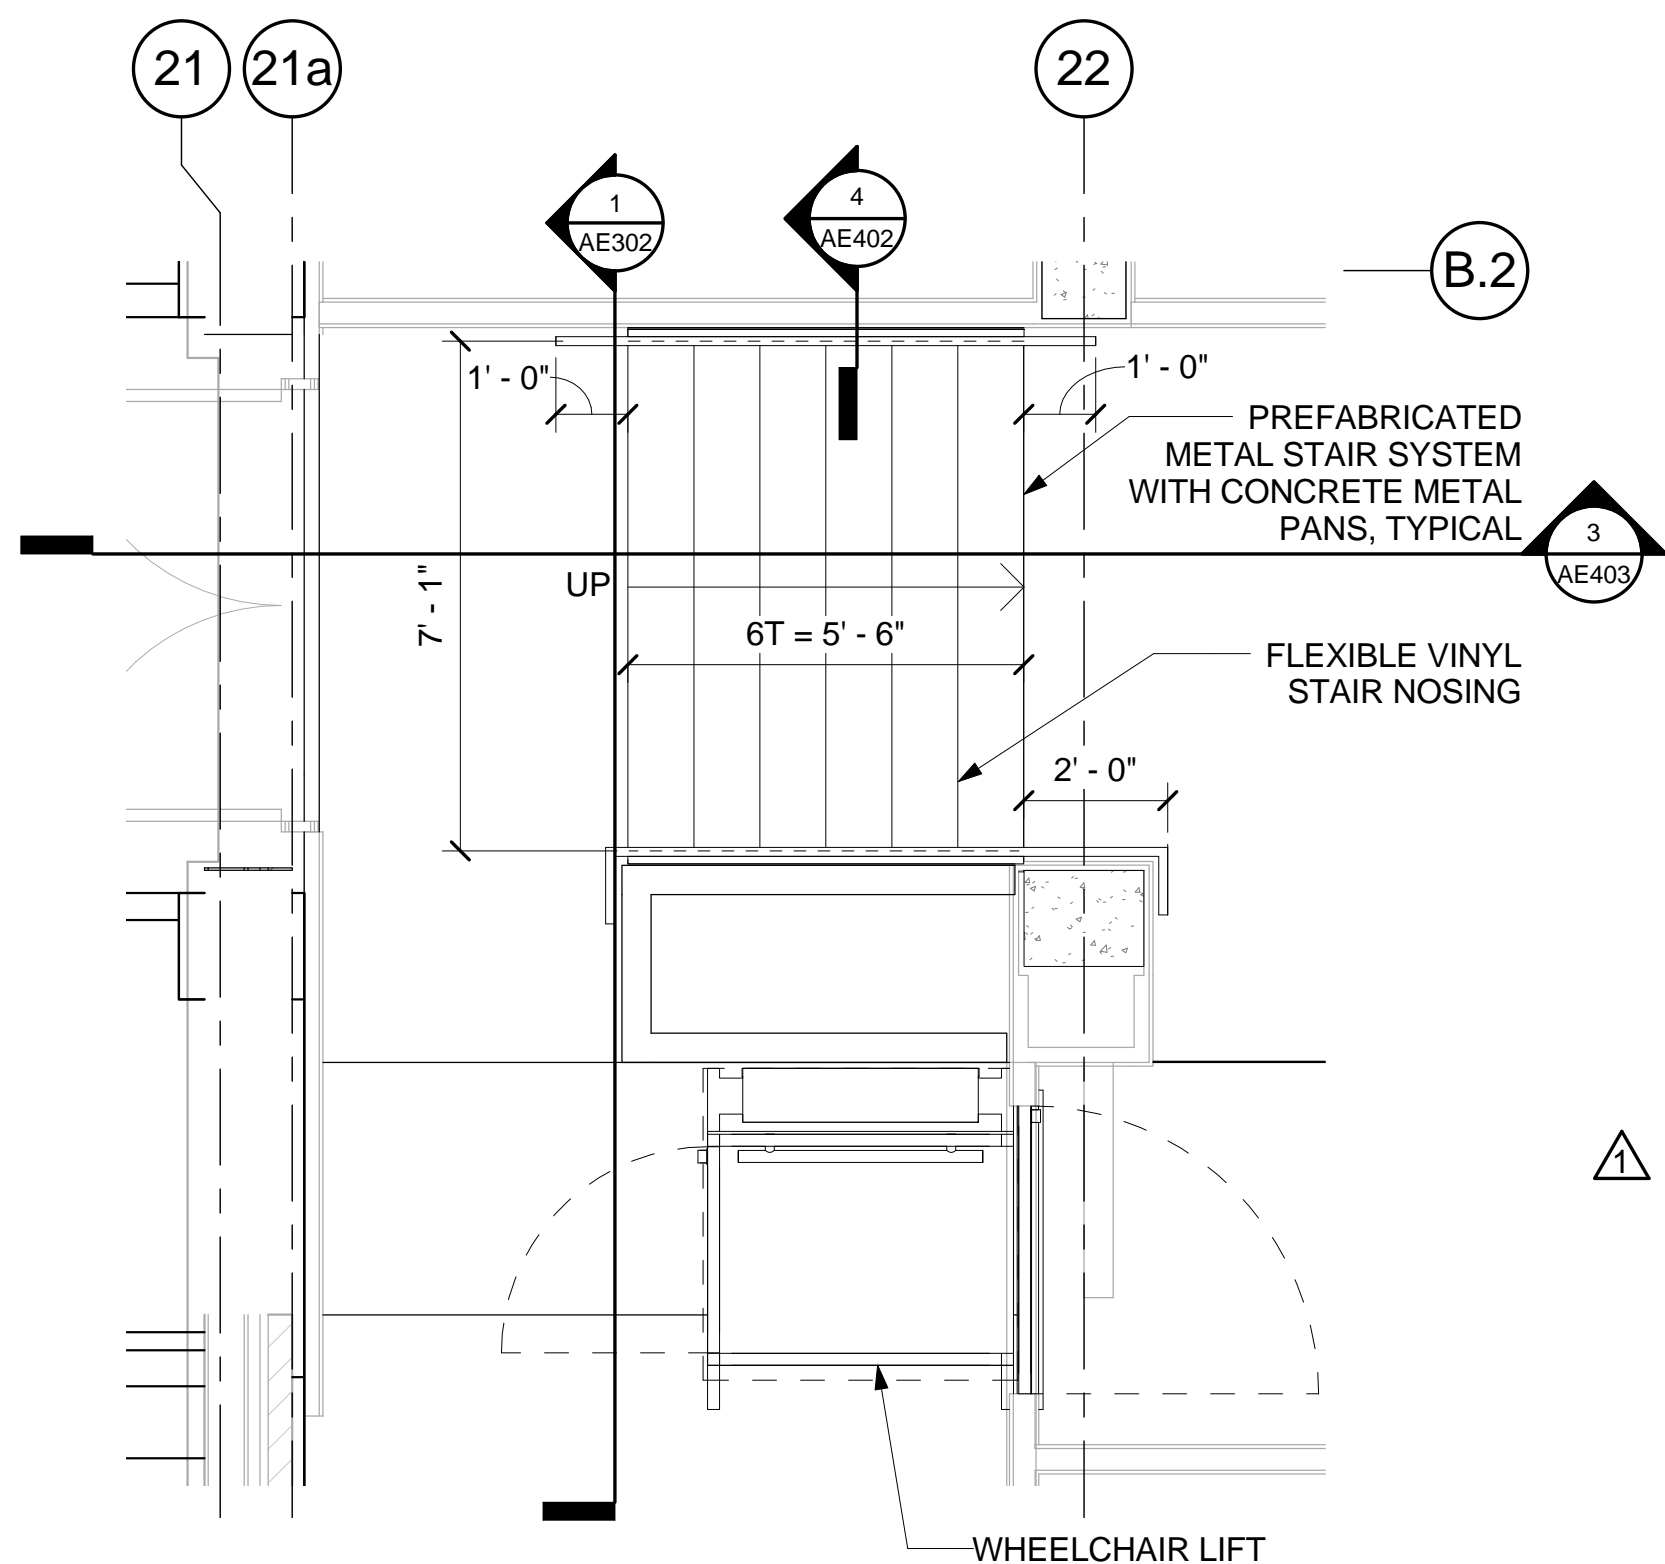


1 5TH FLOOR - STAIR PLAN AND WHEELCHAIR LIFT  
AE403 SCALE: 3/8" = 1'-0"

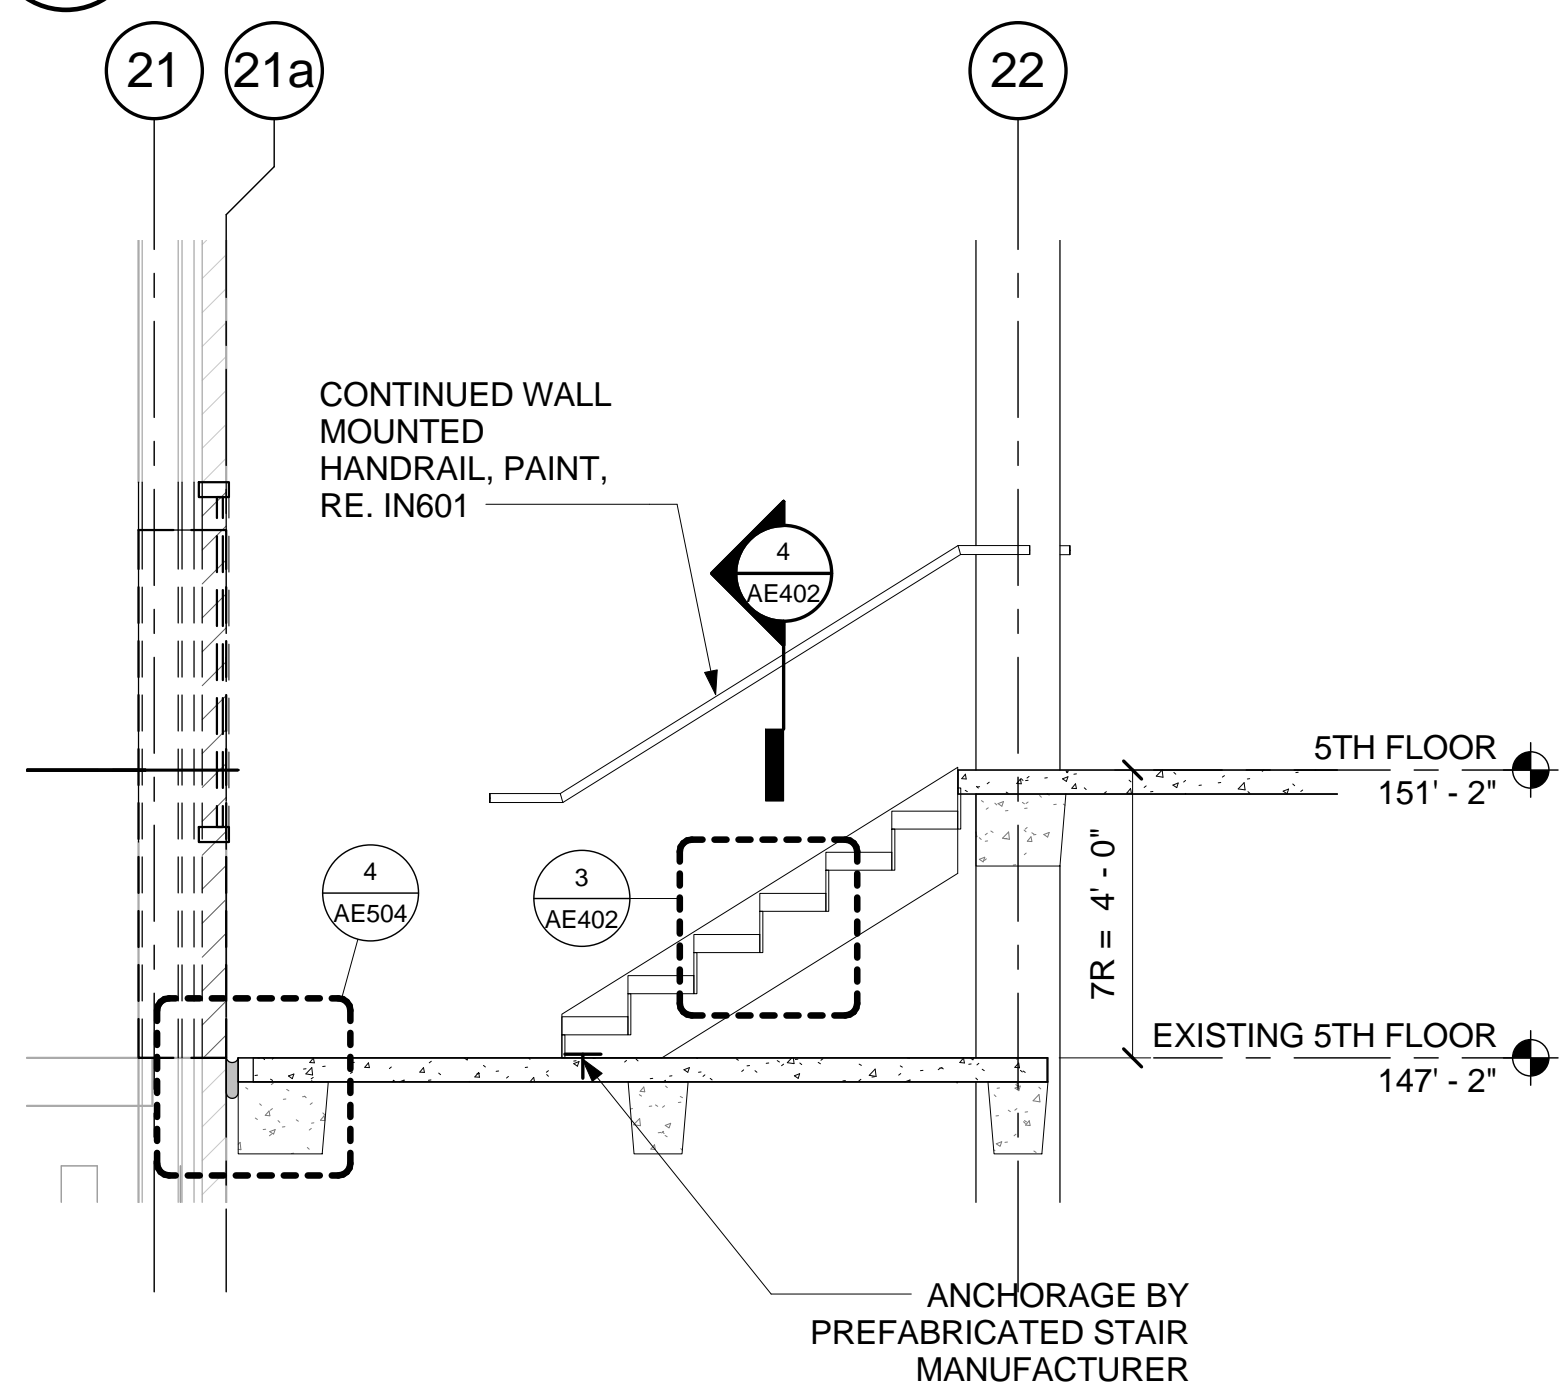


3 STAIR SECTION - EXIST 5TH FLOOR  
AE403 SCALE: 3/8" = 1'-0"

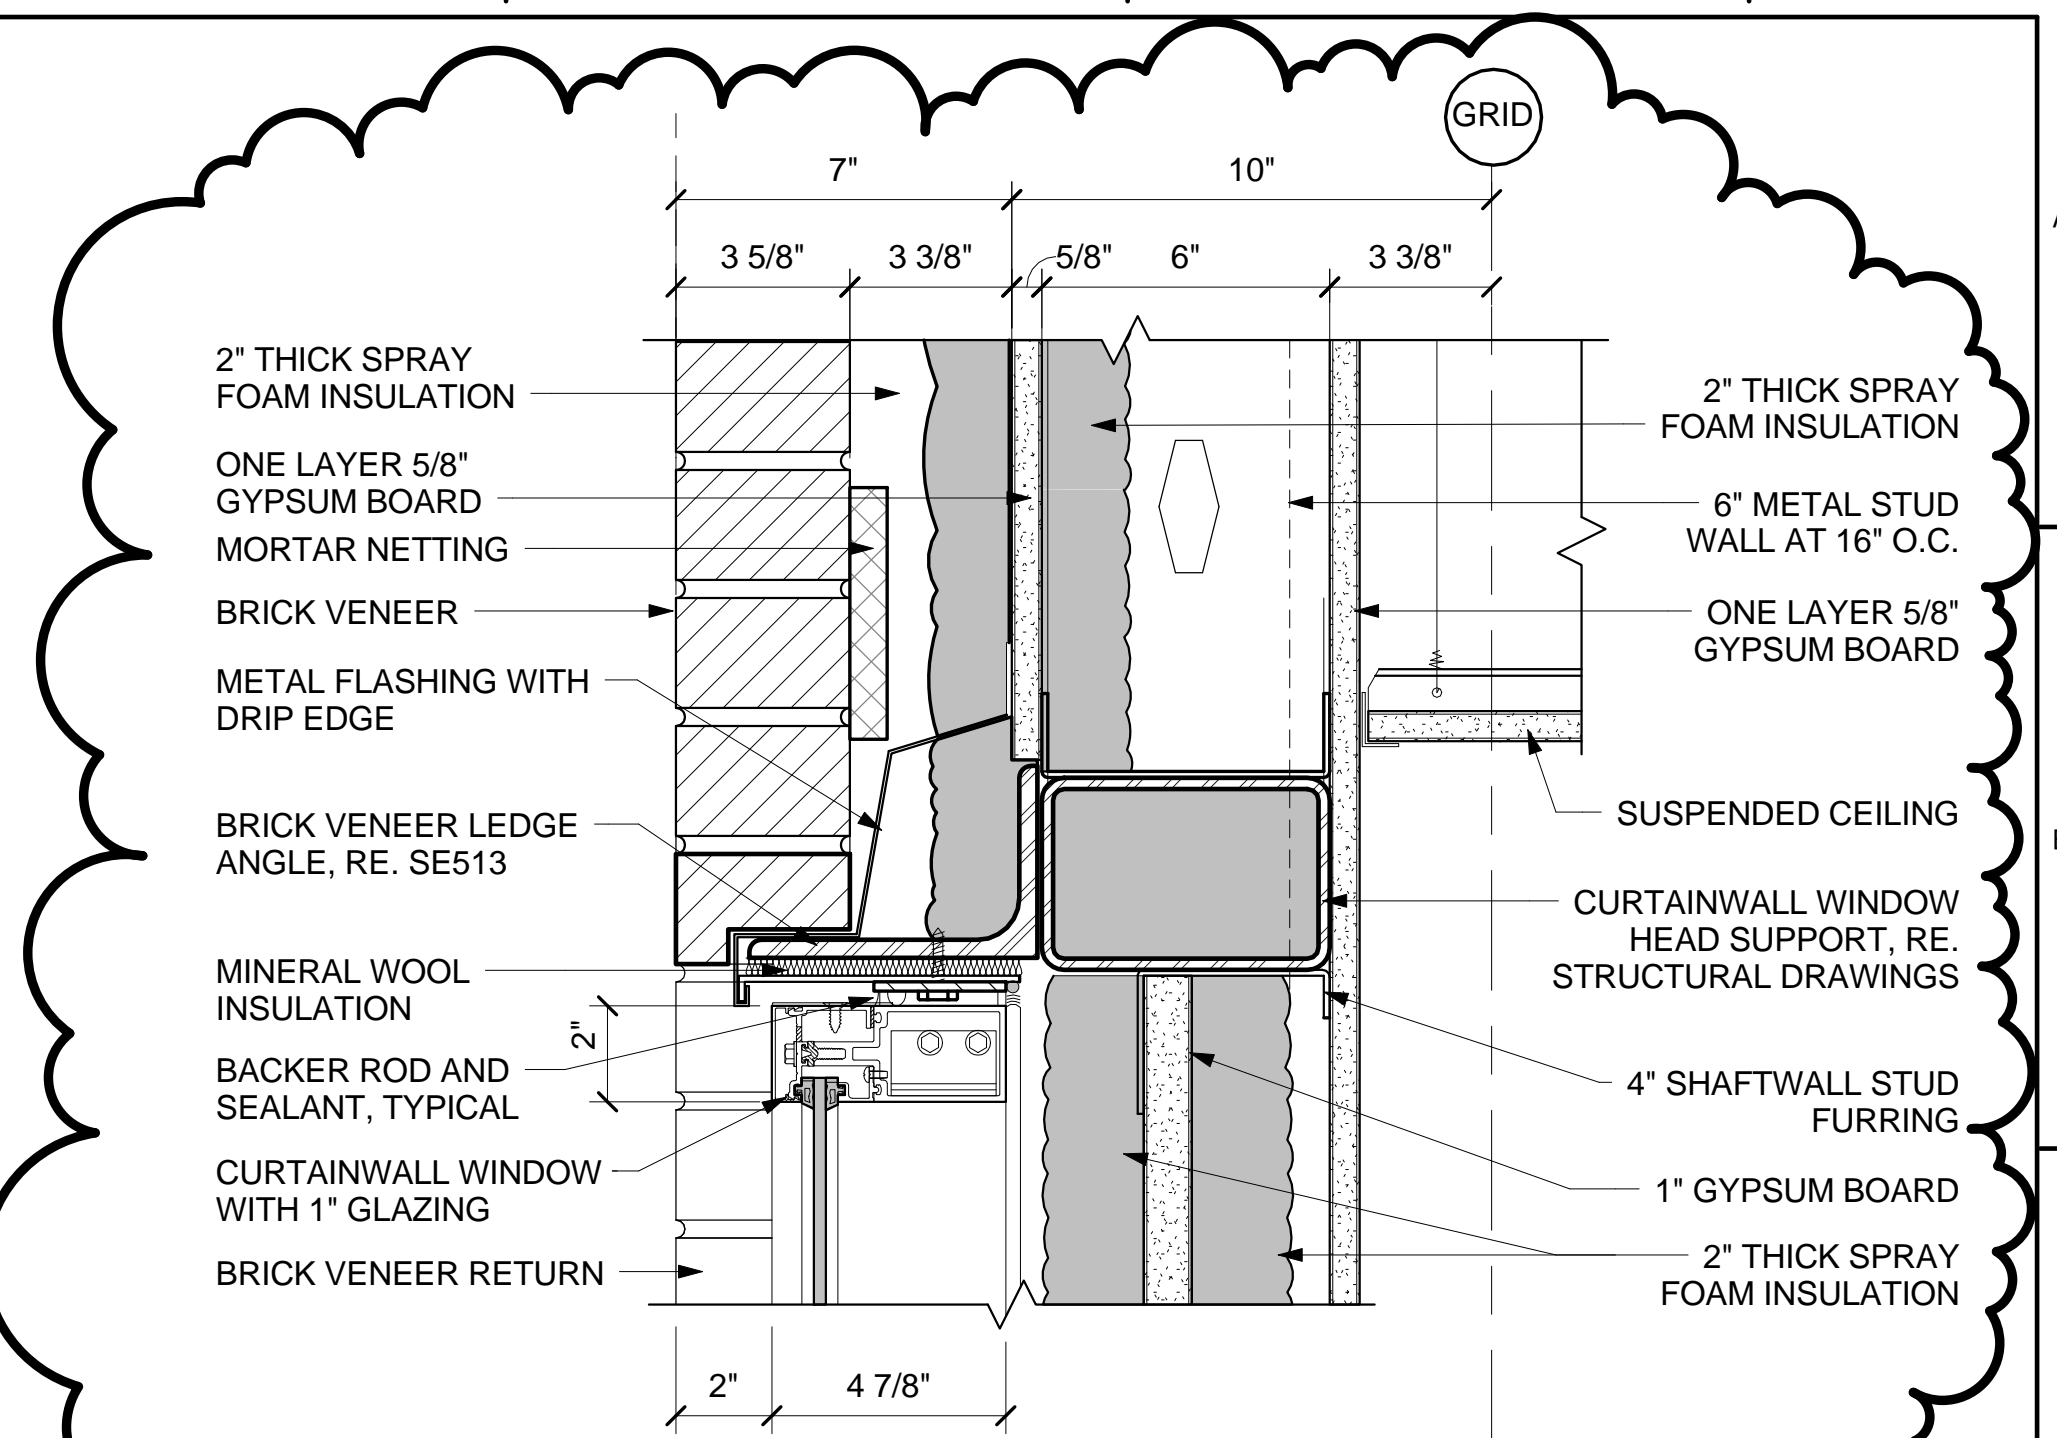

2 CURTAINWALL WINDOW WITH SPANDREL PANEL - HEAD  
AE403 SCALE: 3" = 1'-0"

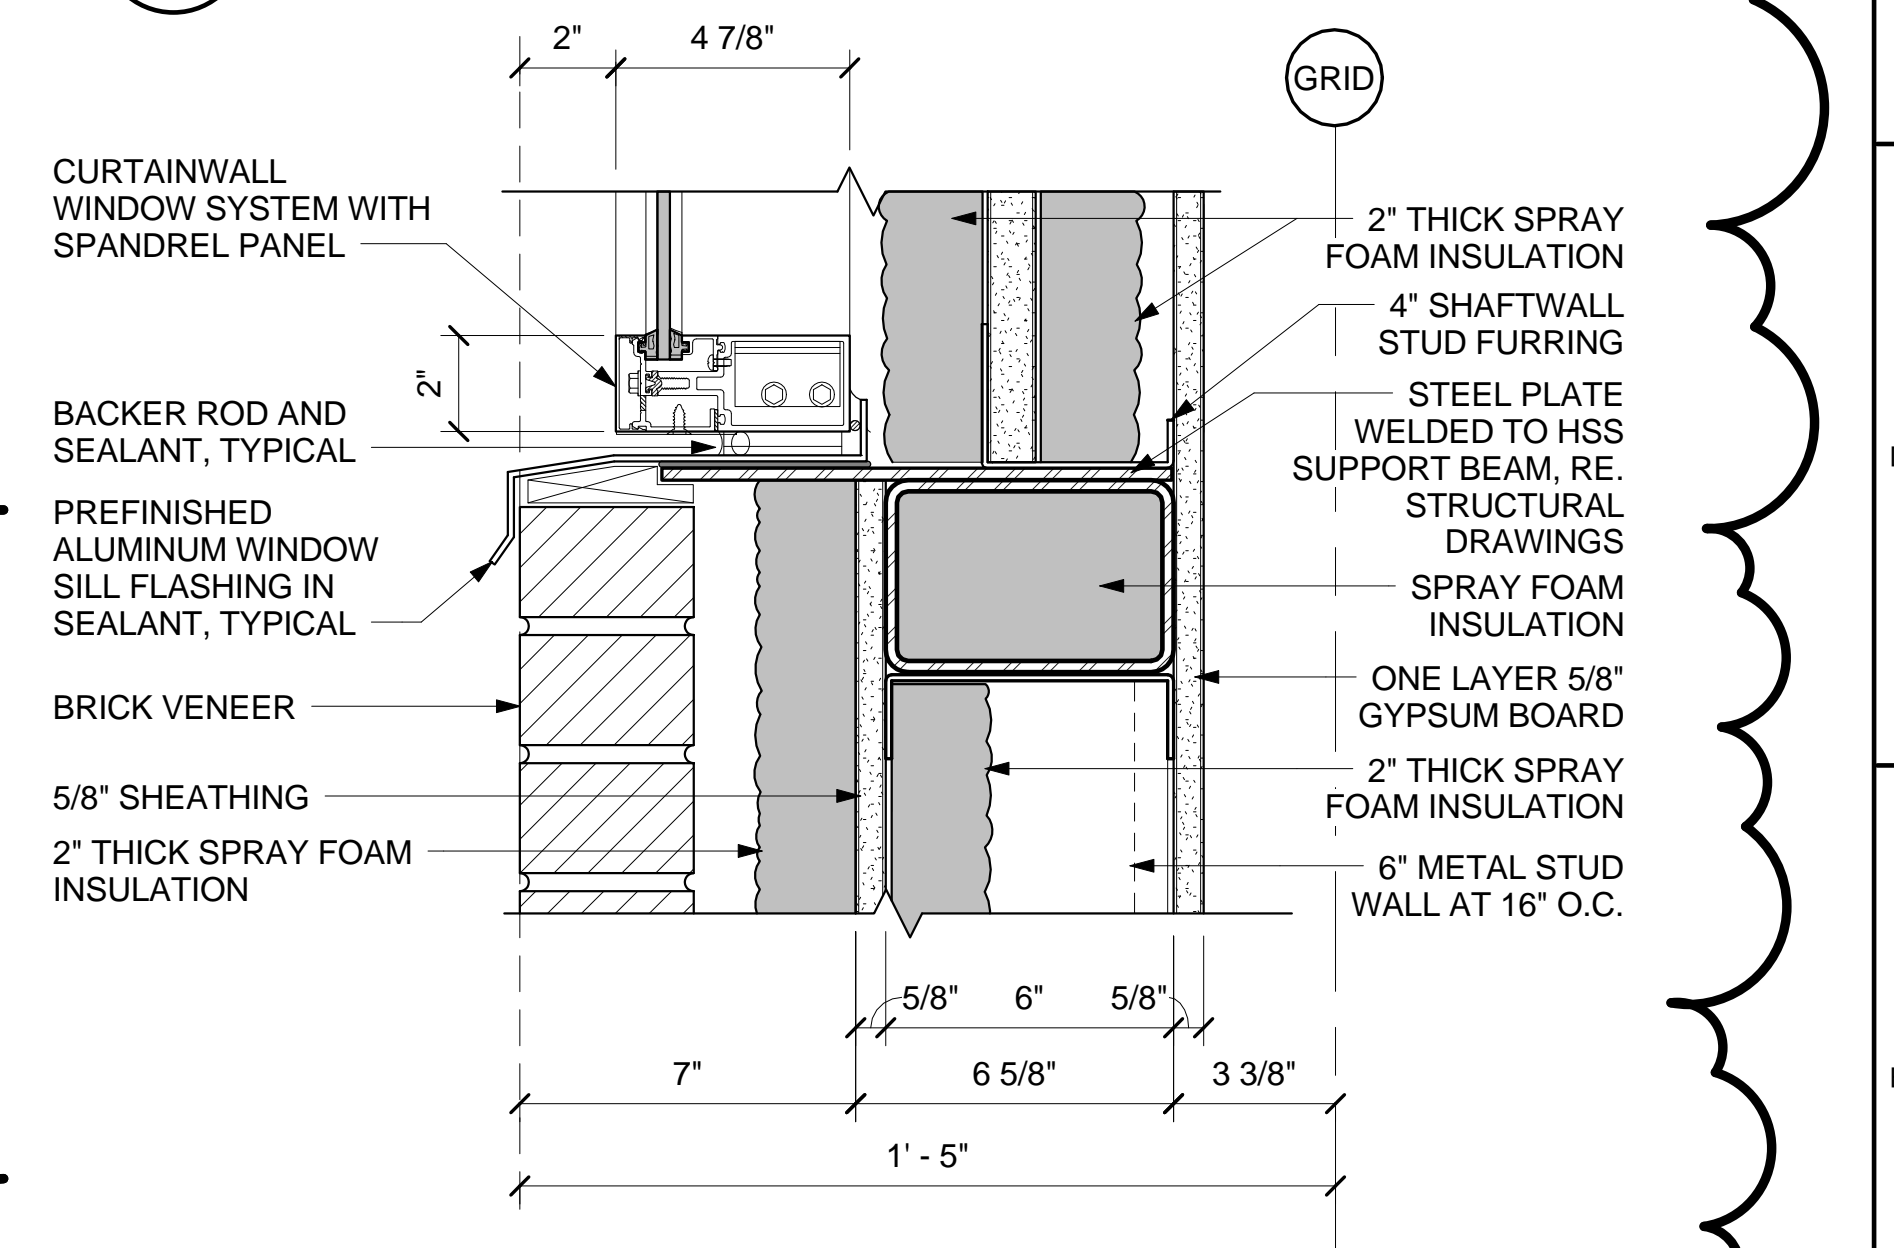

4 CURTAINWALL WINDOW WITH SPANDREL PANEL - SILL  
AE403 SCALE: 3" = 1'-0"

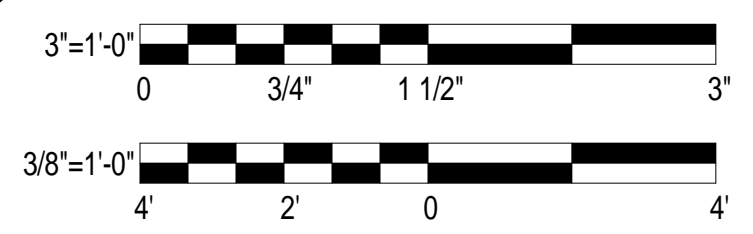


ISSUED FOR CONSTRUCTION REV 01


--	--	





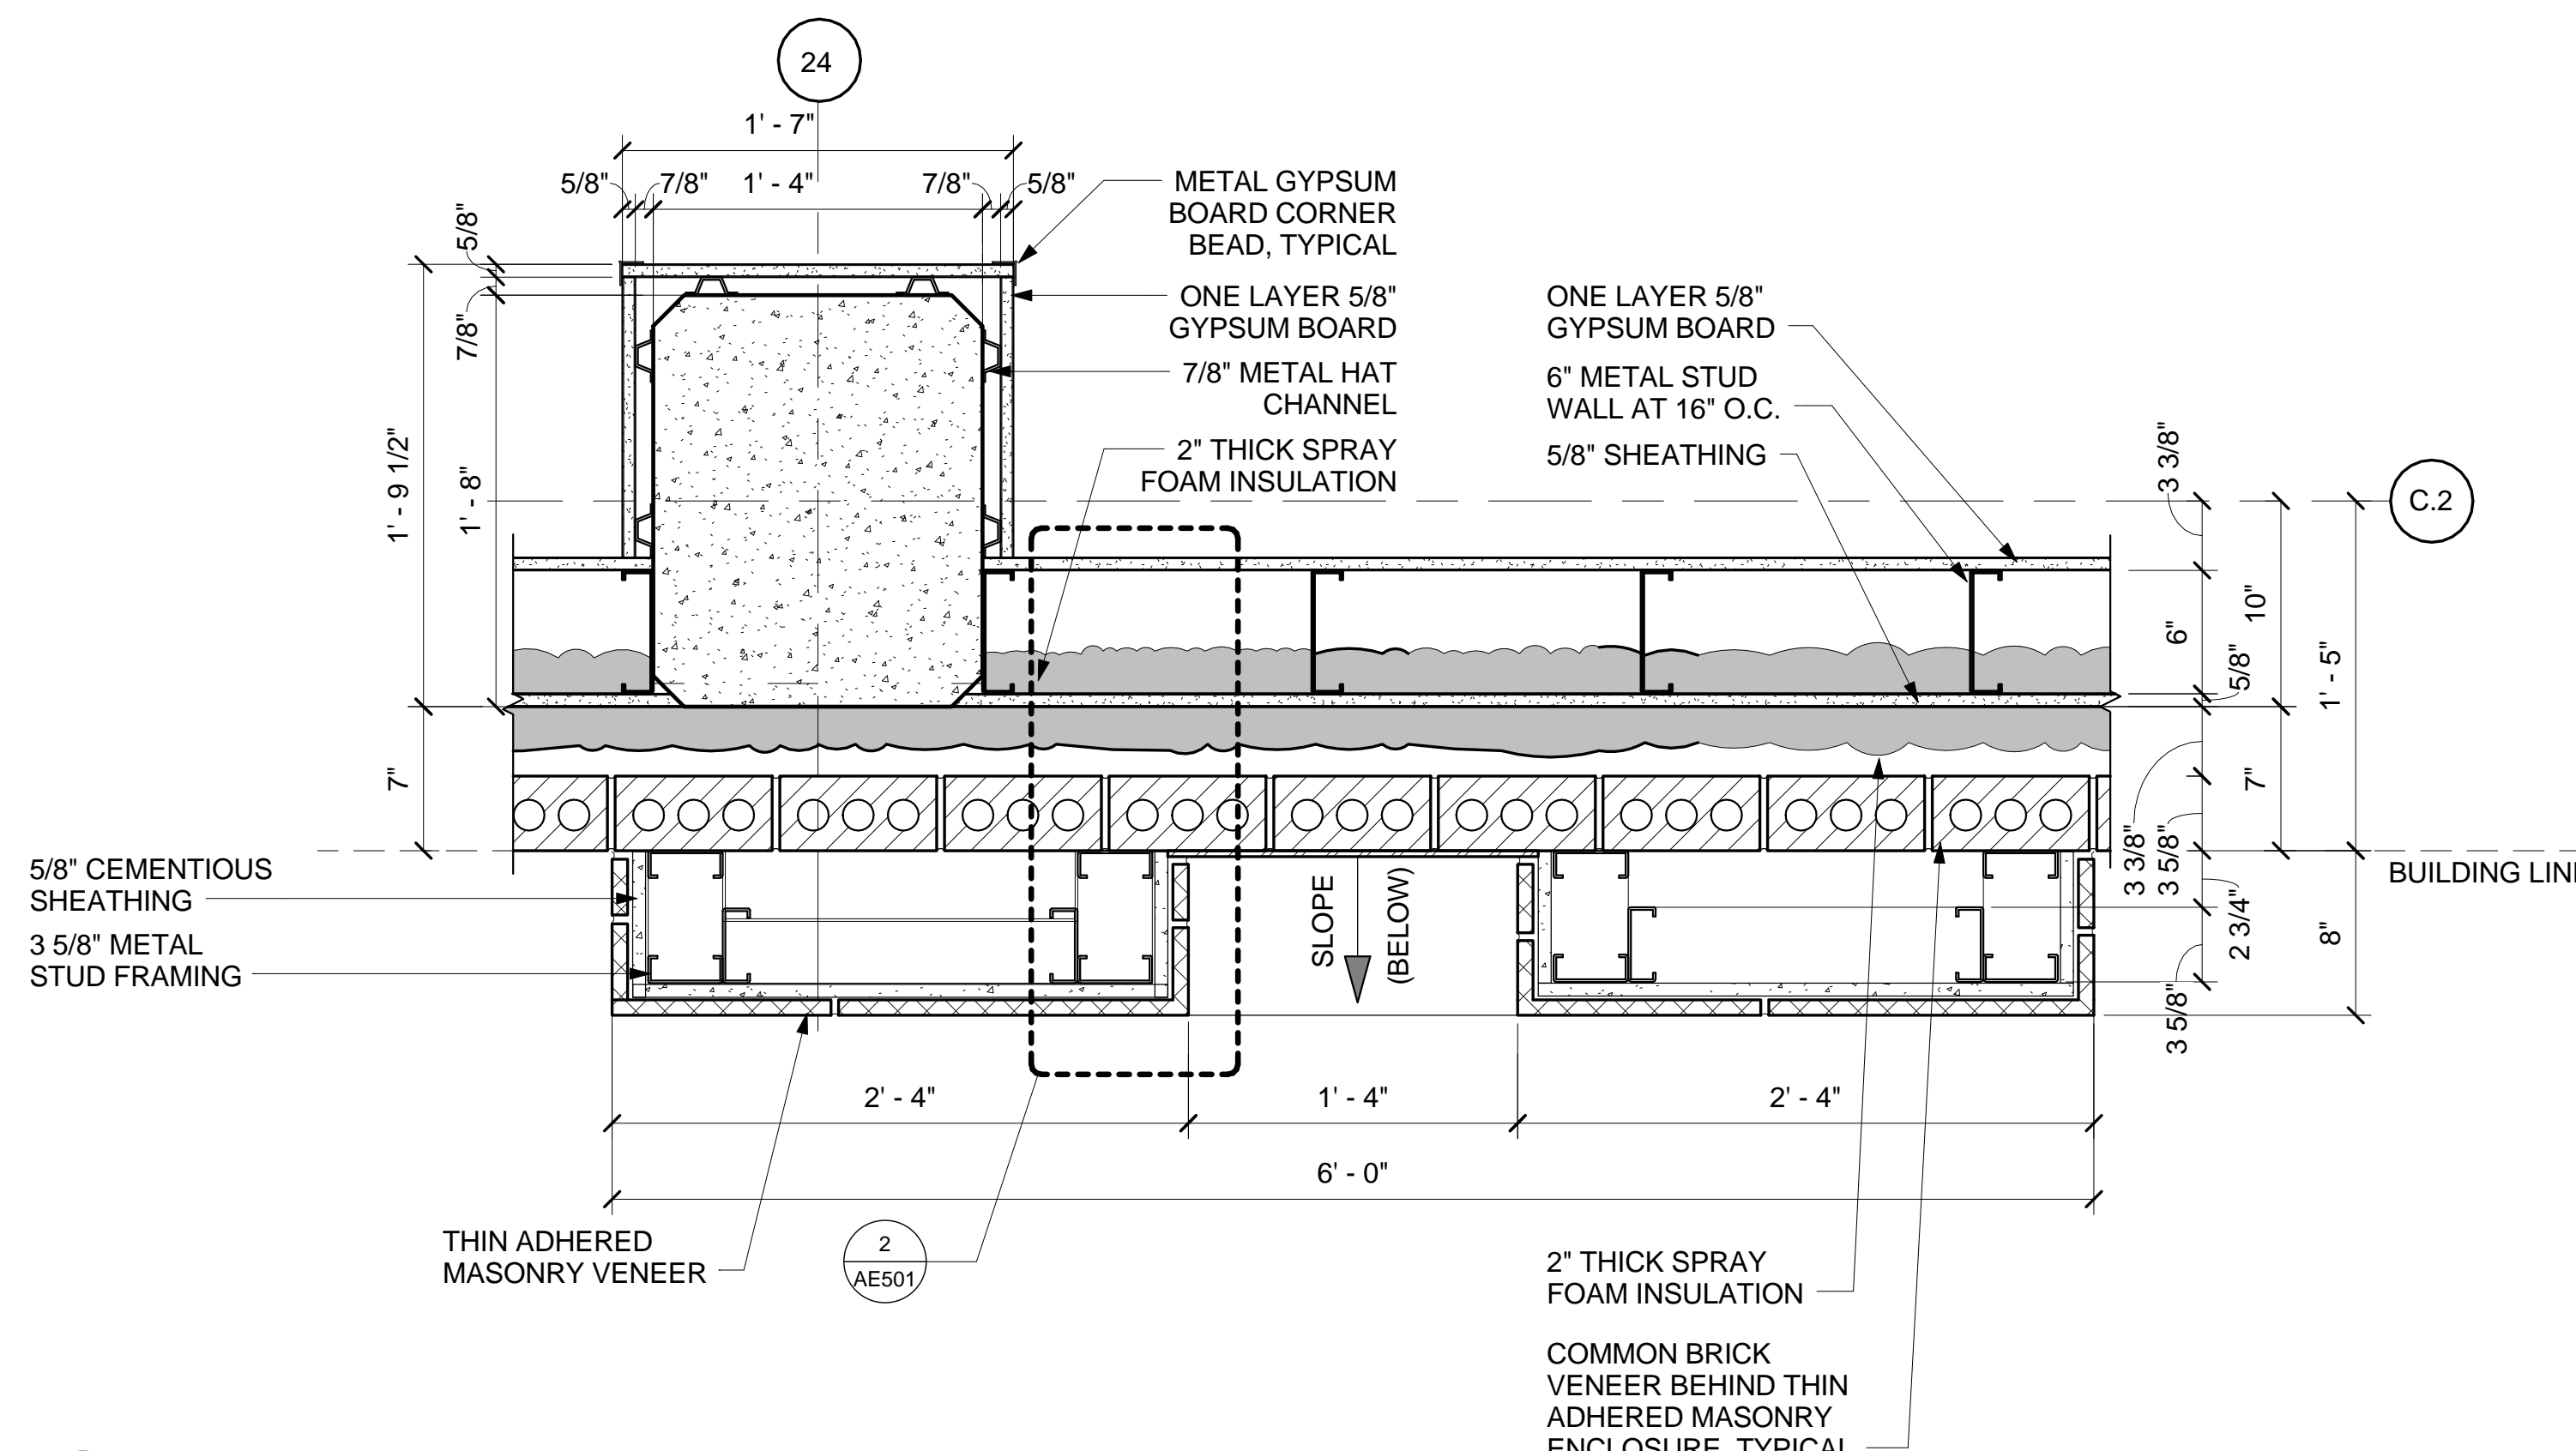


1 EXTERIOR COLUMN DETAIL AT THIN VENEER MASONRY  
AE501 SCALE: 1 1/2" = 1'-0"

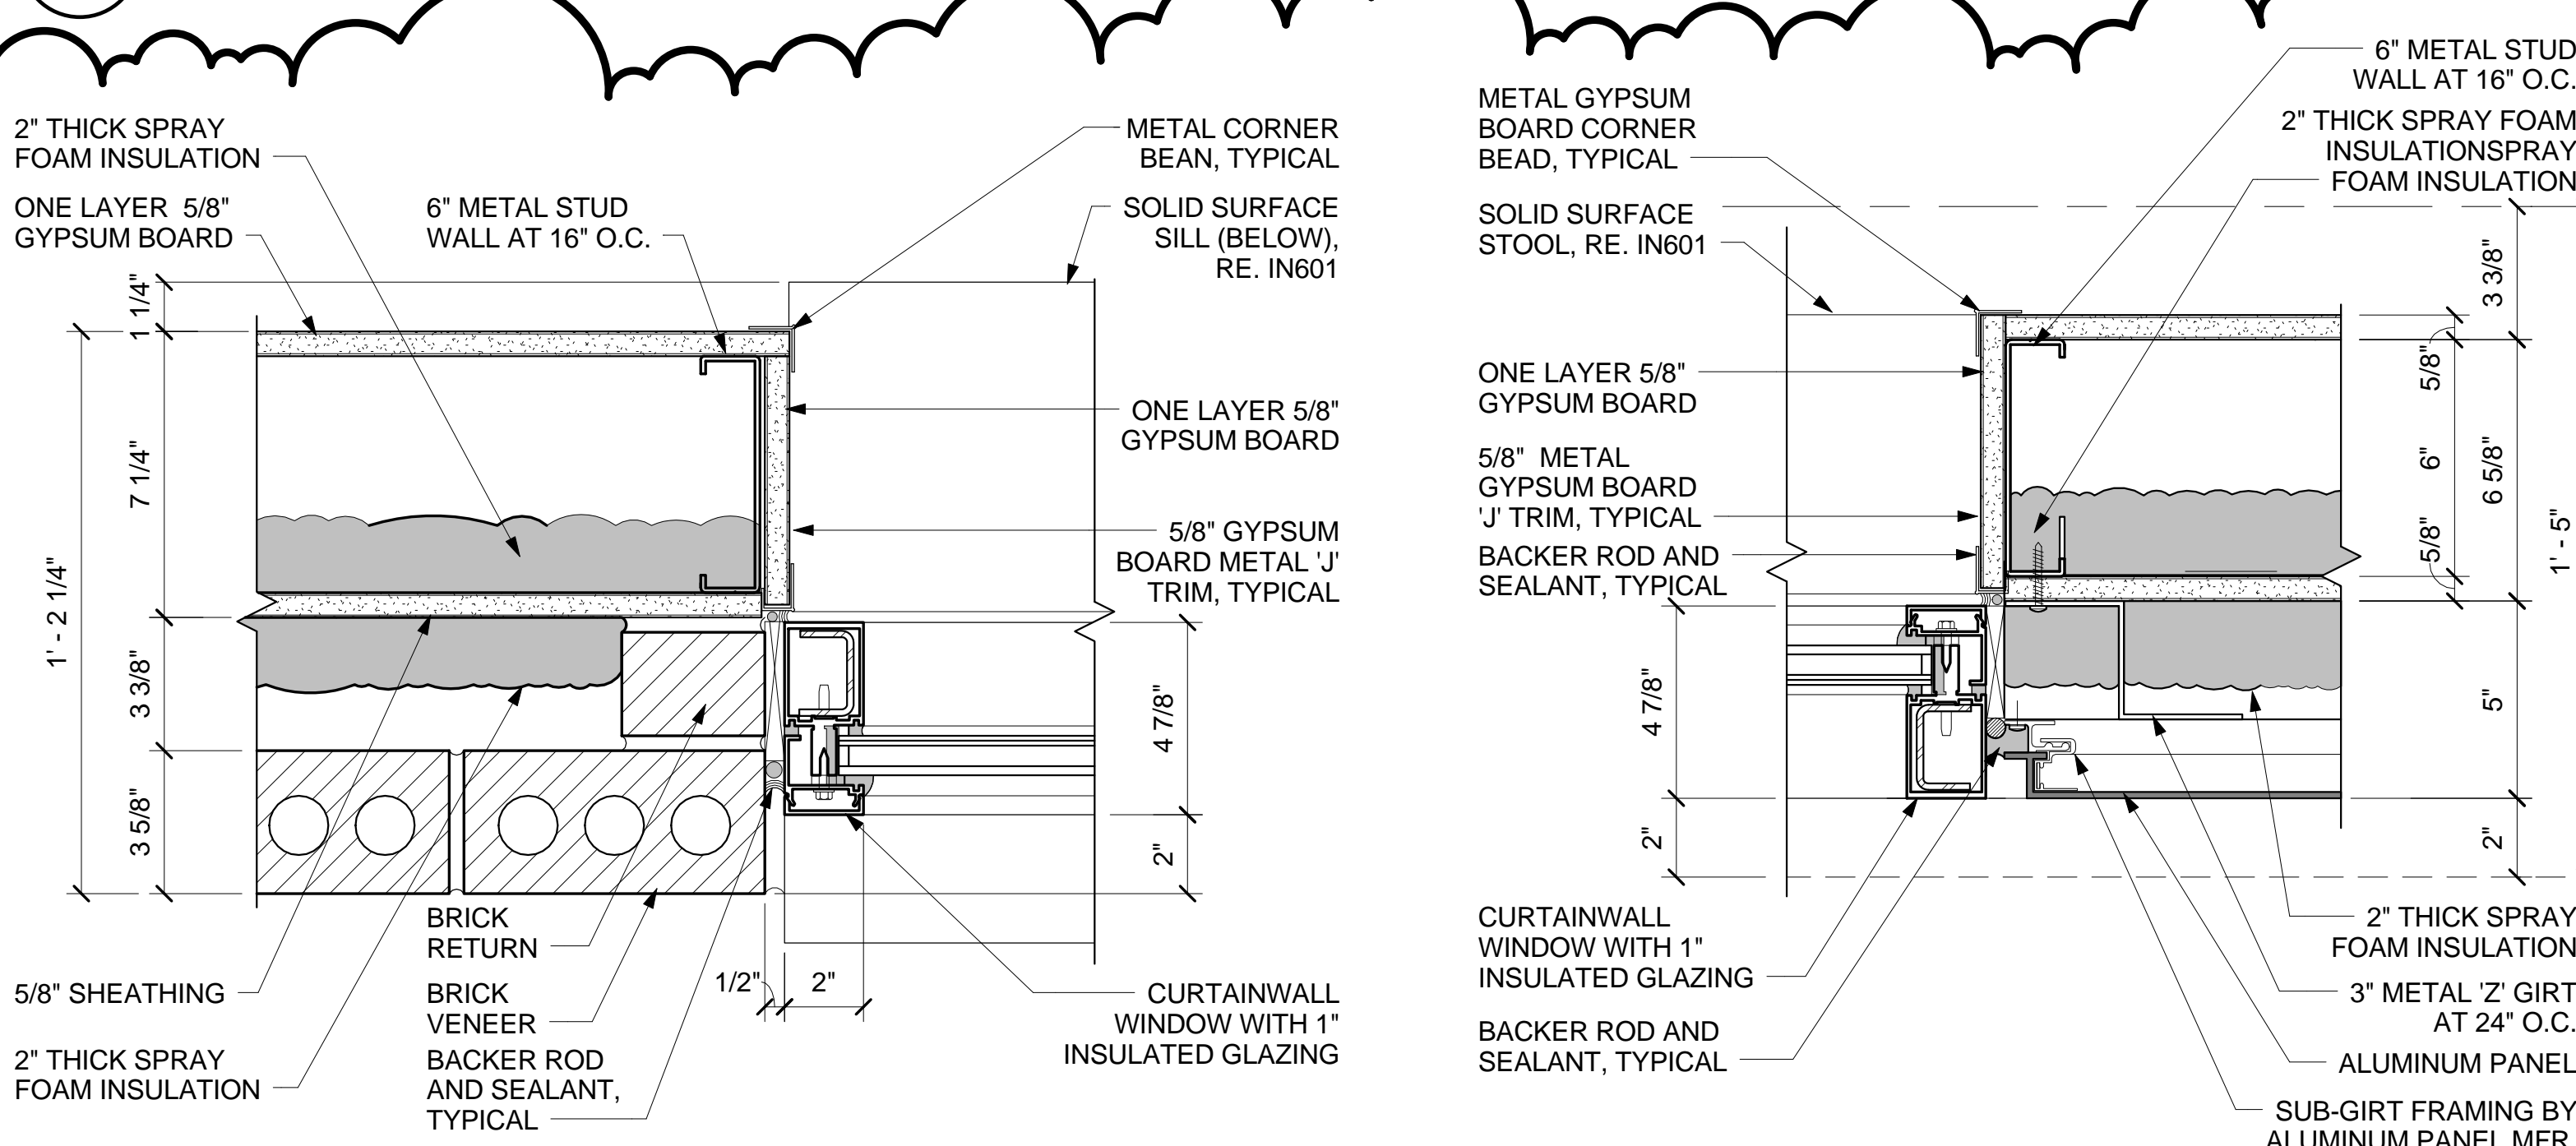


3 EXTERIOR WINDOW AT BRICK - JAMB  
AE501 SCALE: 3" = 1'-0"

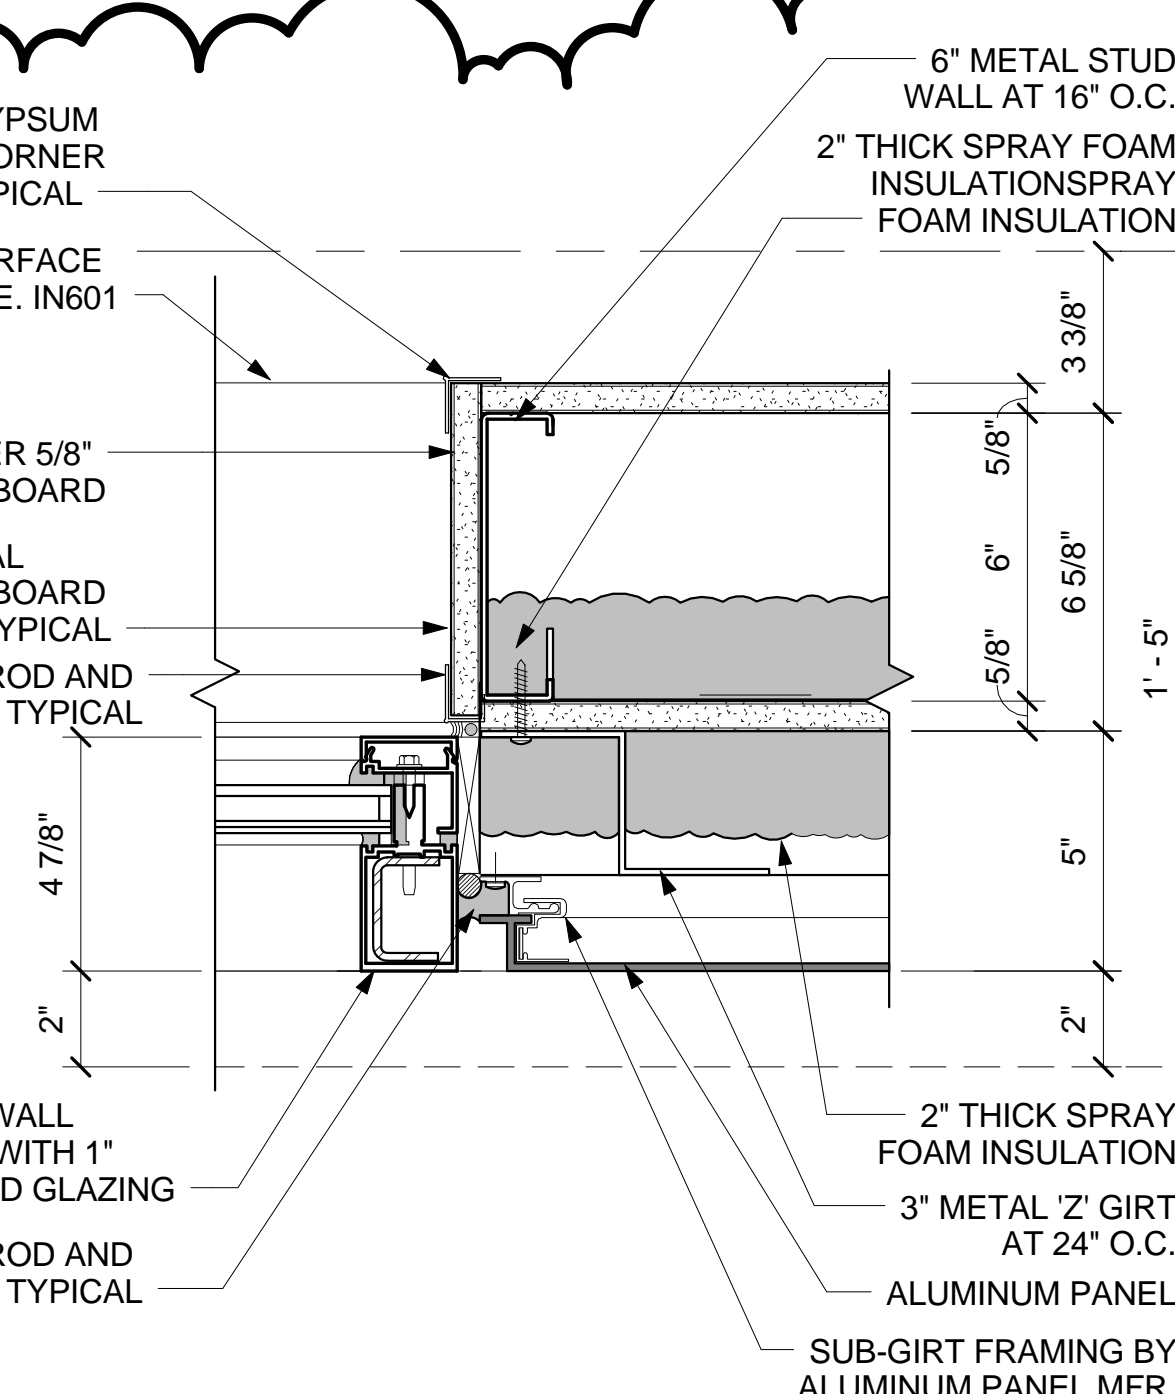

4 SILL DETAIL  
AE501 SCALE: 3" = 1'-0"

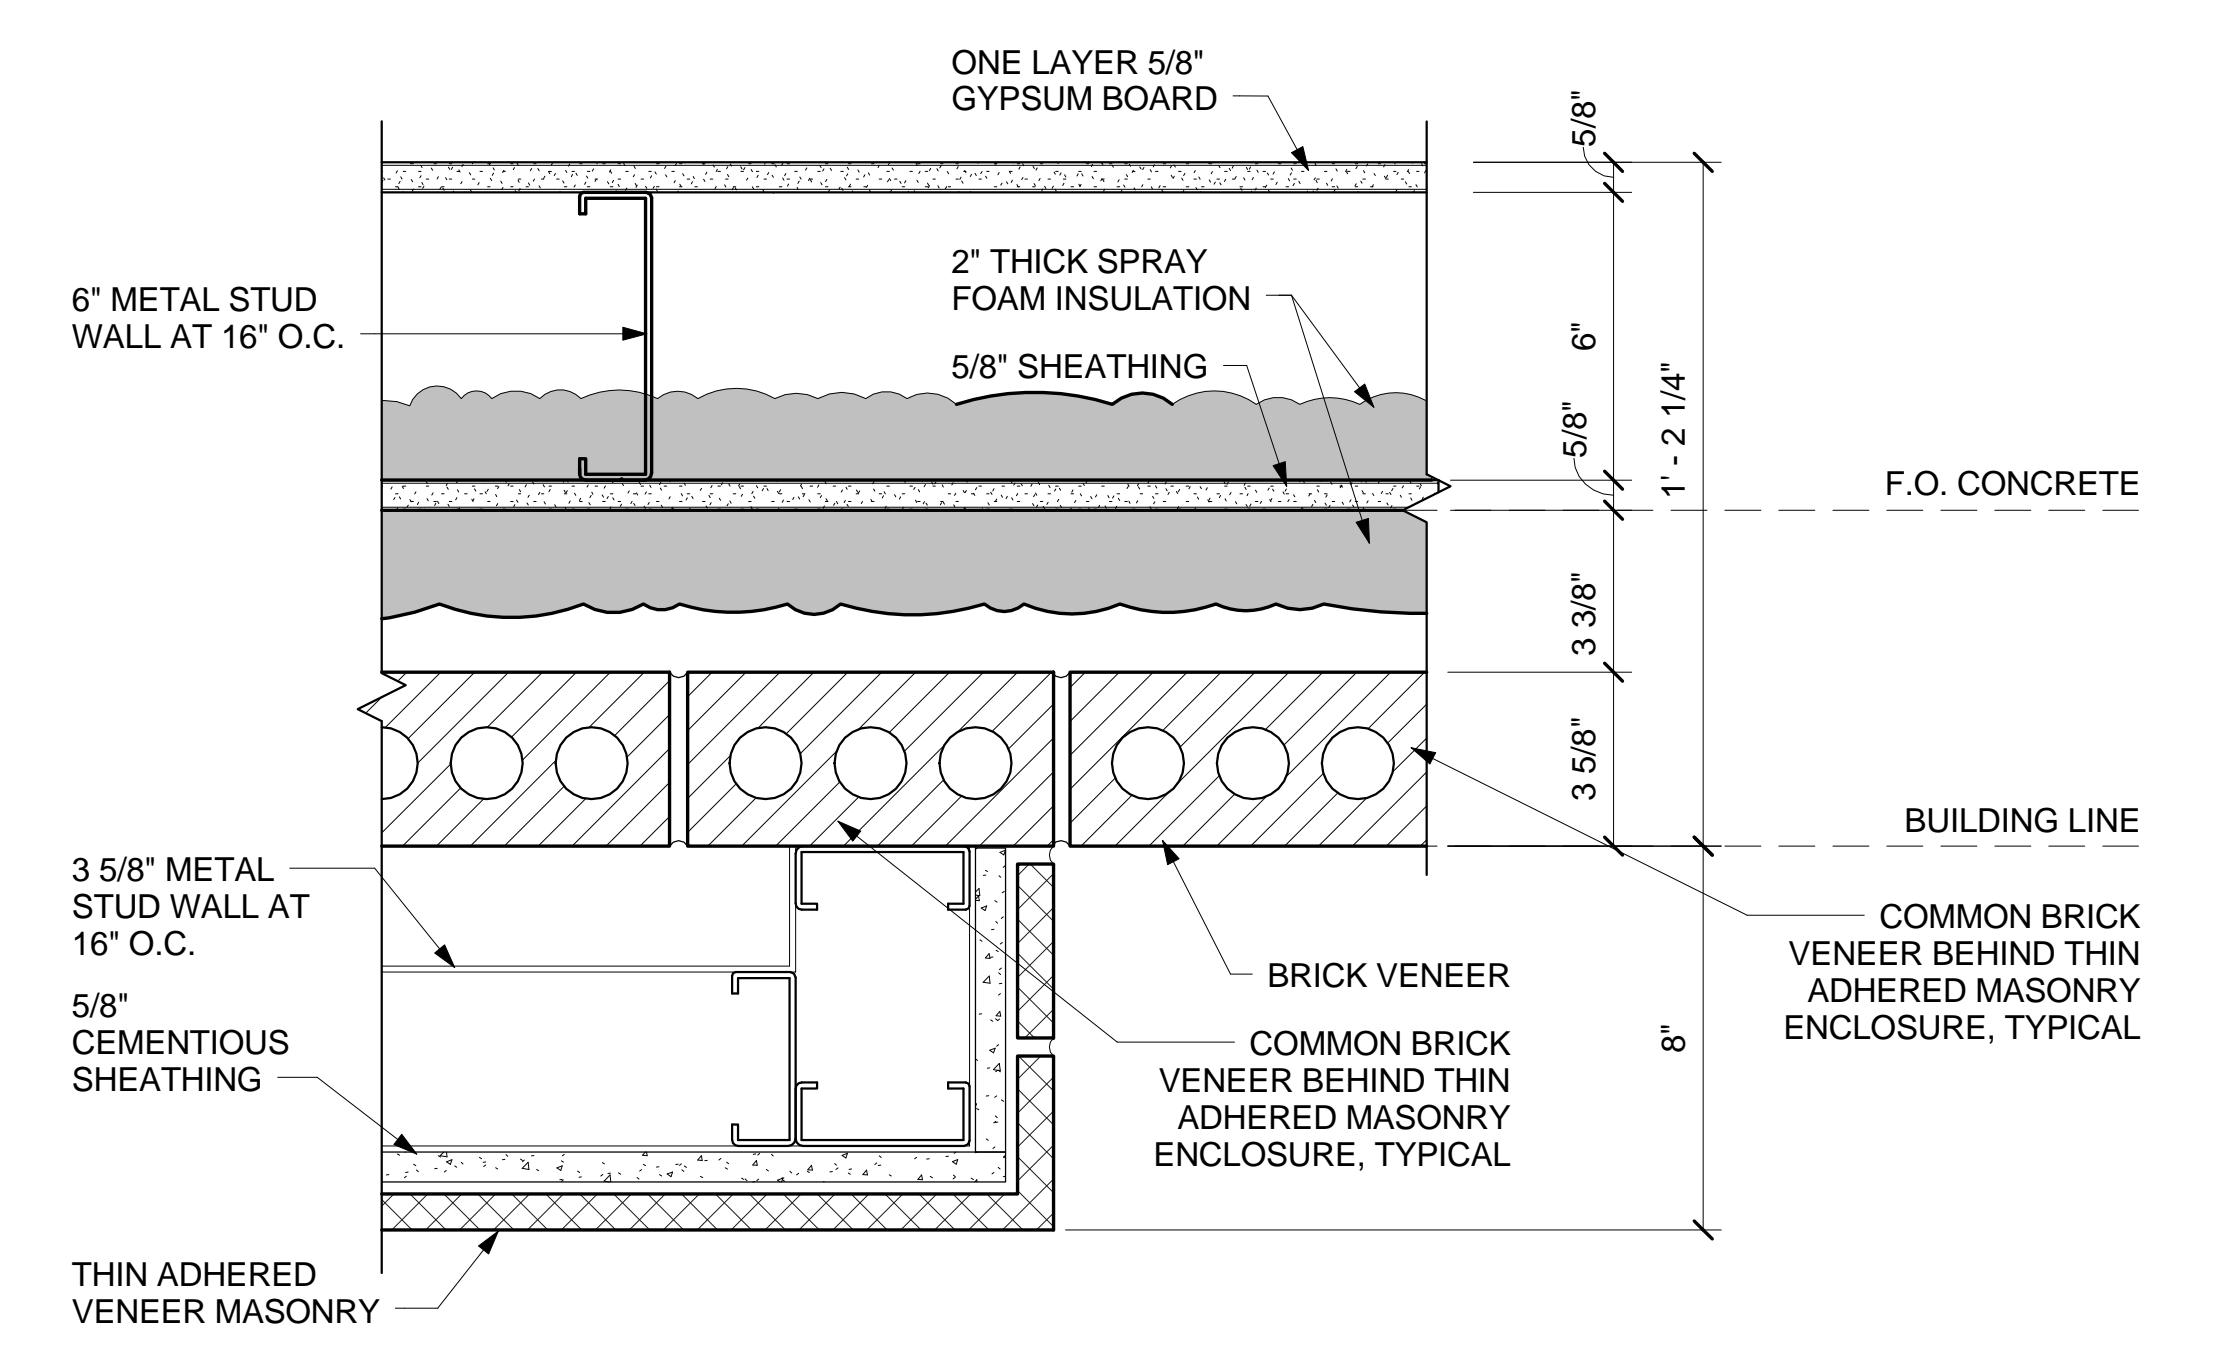

2 EXTERIOR WALL DETAIL AT THIN VENEER MASONRY CORNER  
AE501 SCALE: 3" = 1'-0"

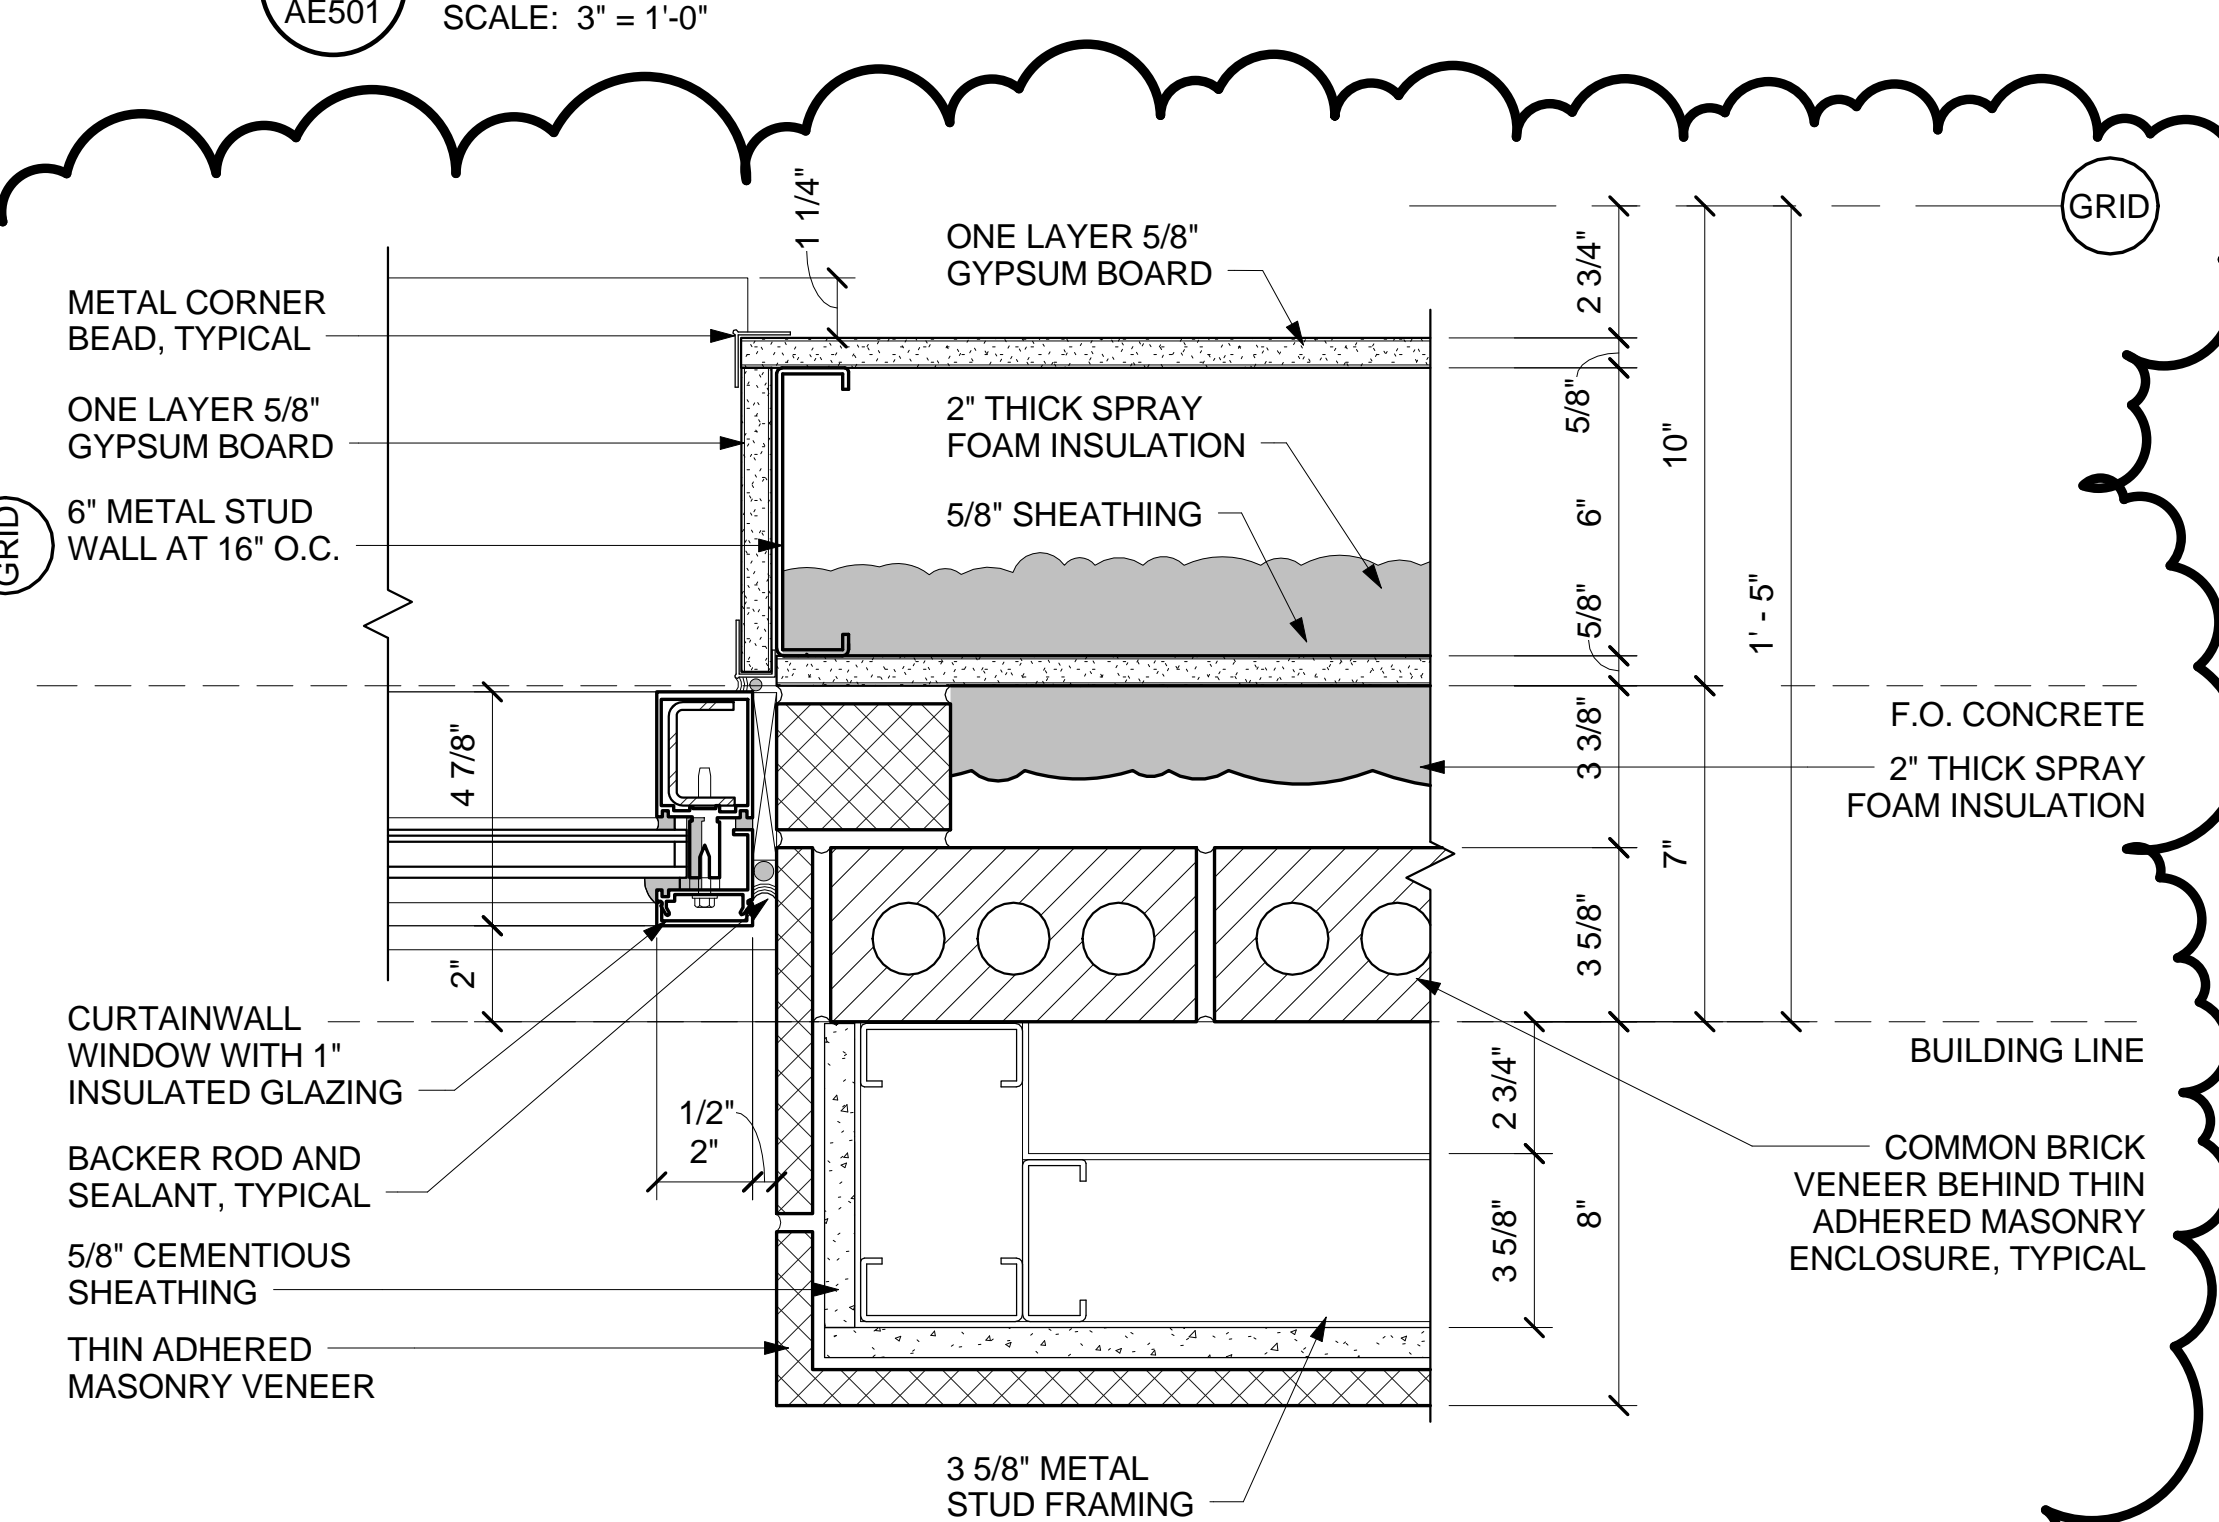


5 EXTERIOR WINDOW AT THIN VENEER MASONRY- JAMB  
AE501 SCALE: 3" = 1'-0"



ISSUED FOR CONSTRUCTION REV 01

<b>CONSULTANTS:</b> <b>PERKINS + WILL</b> 5310 SOUTH ALSTON AVENUE, BLDG. 300 DURHAM, NC 27713 PH: 919.433.3300 WWW.PERKINS+WILL.COM		<b>MAZZETTI + GBA</b> four sight meets TECH 1893 General George Patton Drive Franklin, Tennessee 37067 Phone: 615.376.3100 Website: www.mazzetti.com		<b>FC</b> iretech consulting		<b>J.R. HARRIS &amp; COMPANY</b> STRUCTURAL ENGINEERS 1775 SHERMAN ST., SUITE 2000 DENVER, COLORADO 80203-4358 VOICE: (303) 860-9021 FAX: (303) 860-9537		<b>ARCHITECT/ENGINEERS:</b> <b>AEs Group, Inc.</b> 11031 SOUTH PINES PEAK DRIVE #202 PARKER, COLORADO 80138 PH: 303.841.3922 WWW.AES-GRP.COM		Seal: <b>STATE OF COLORADO</b> <b>DEDIA HERRELL HART</b> 402304 <b>LICENSED ARCHITECT</b> 24 MARCH 2017		Drawing Title: DETAILS - EXTERIOR PLAN AND WINDOWS		Project Title: EXPAND OR SUITE & CLINICAL ADDITION D-WING		Project Number: 558-323		<b>Office of Construction and Facilities Management</b> <b>Department of Veterans Affairs</b>	
Approved: Project Director NAME: PETER FAVRET/ALEXANDER SANTAGO PHONE: (919)286-0411 EXT.6444		Location: DURHAM VAMC HOSPITAL		Date: MARCH 24, 2017		Checked: DHH		Drawn: R/JF		Building Number: 1		Drawing Number: <b>AE501</b>		Dwg. 60 of 203					
BIDDER INQUIRY RESPONSES Revisions:		04.27.17 Date																	




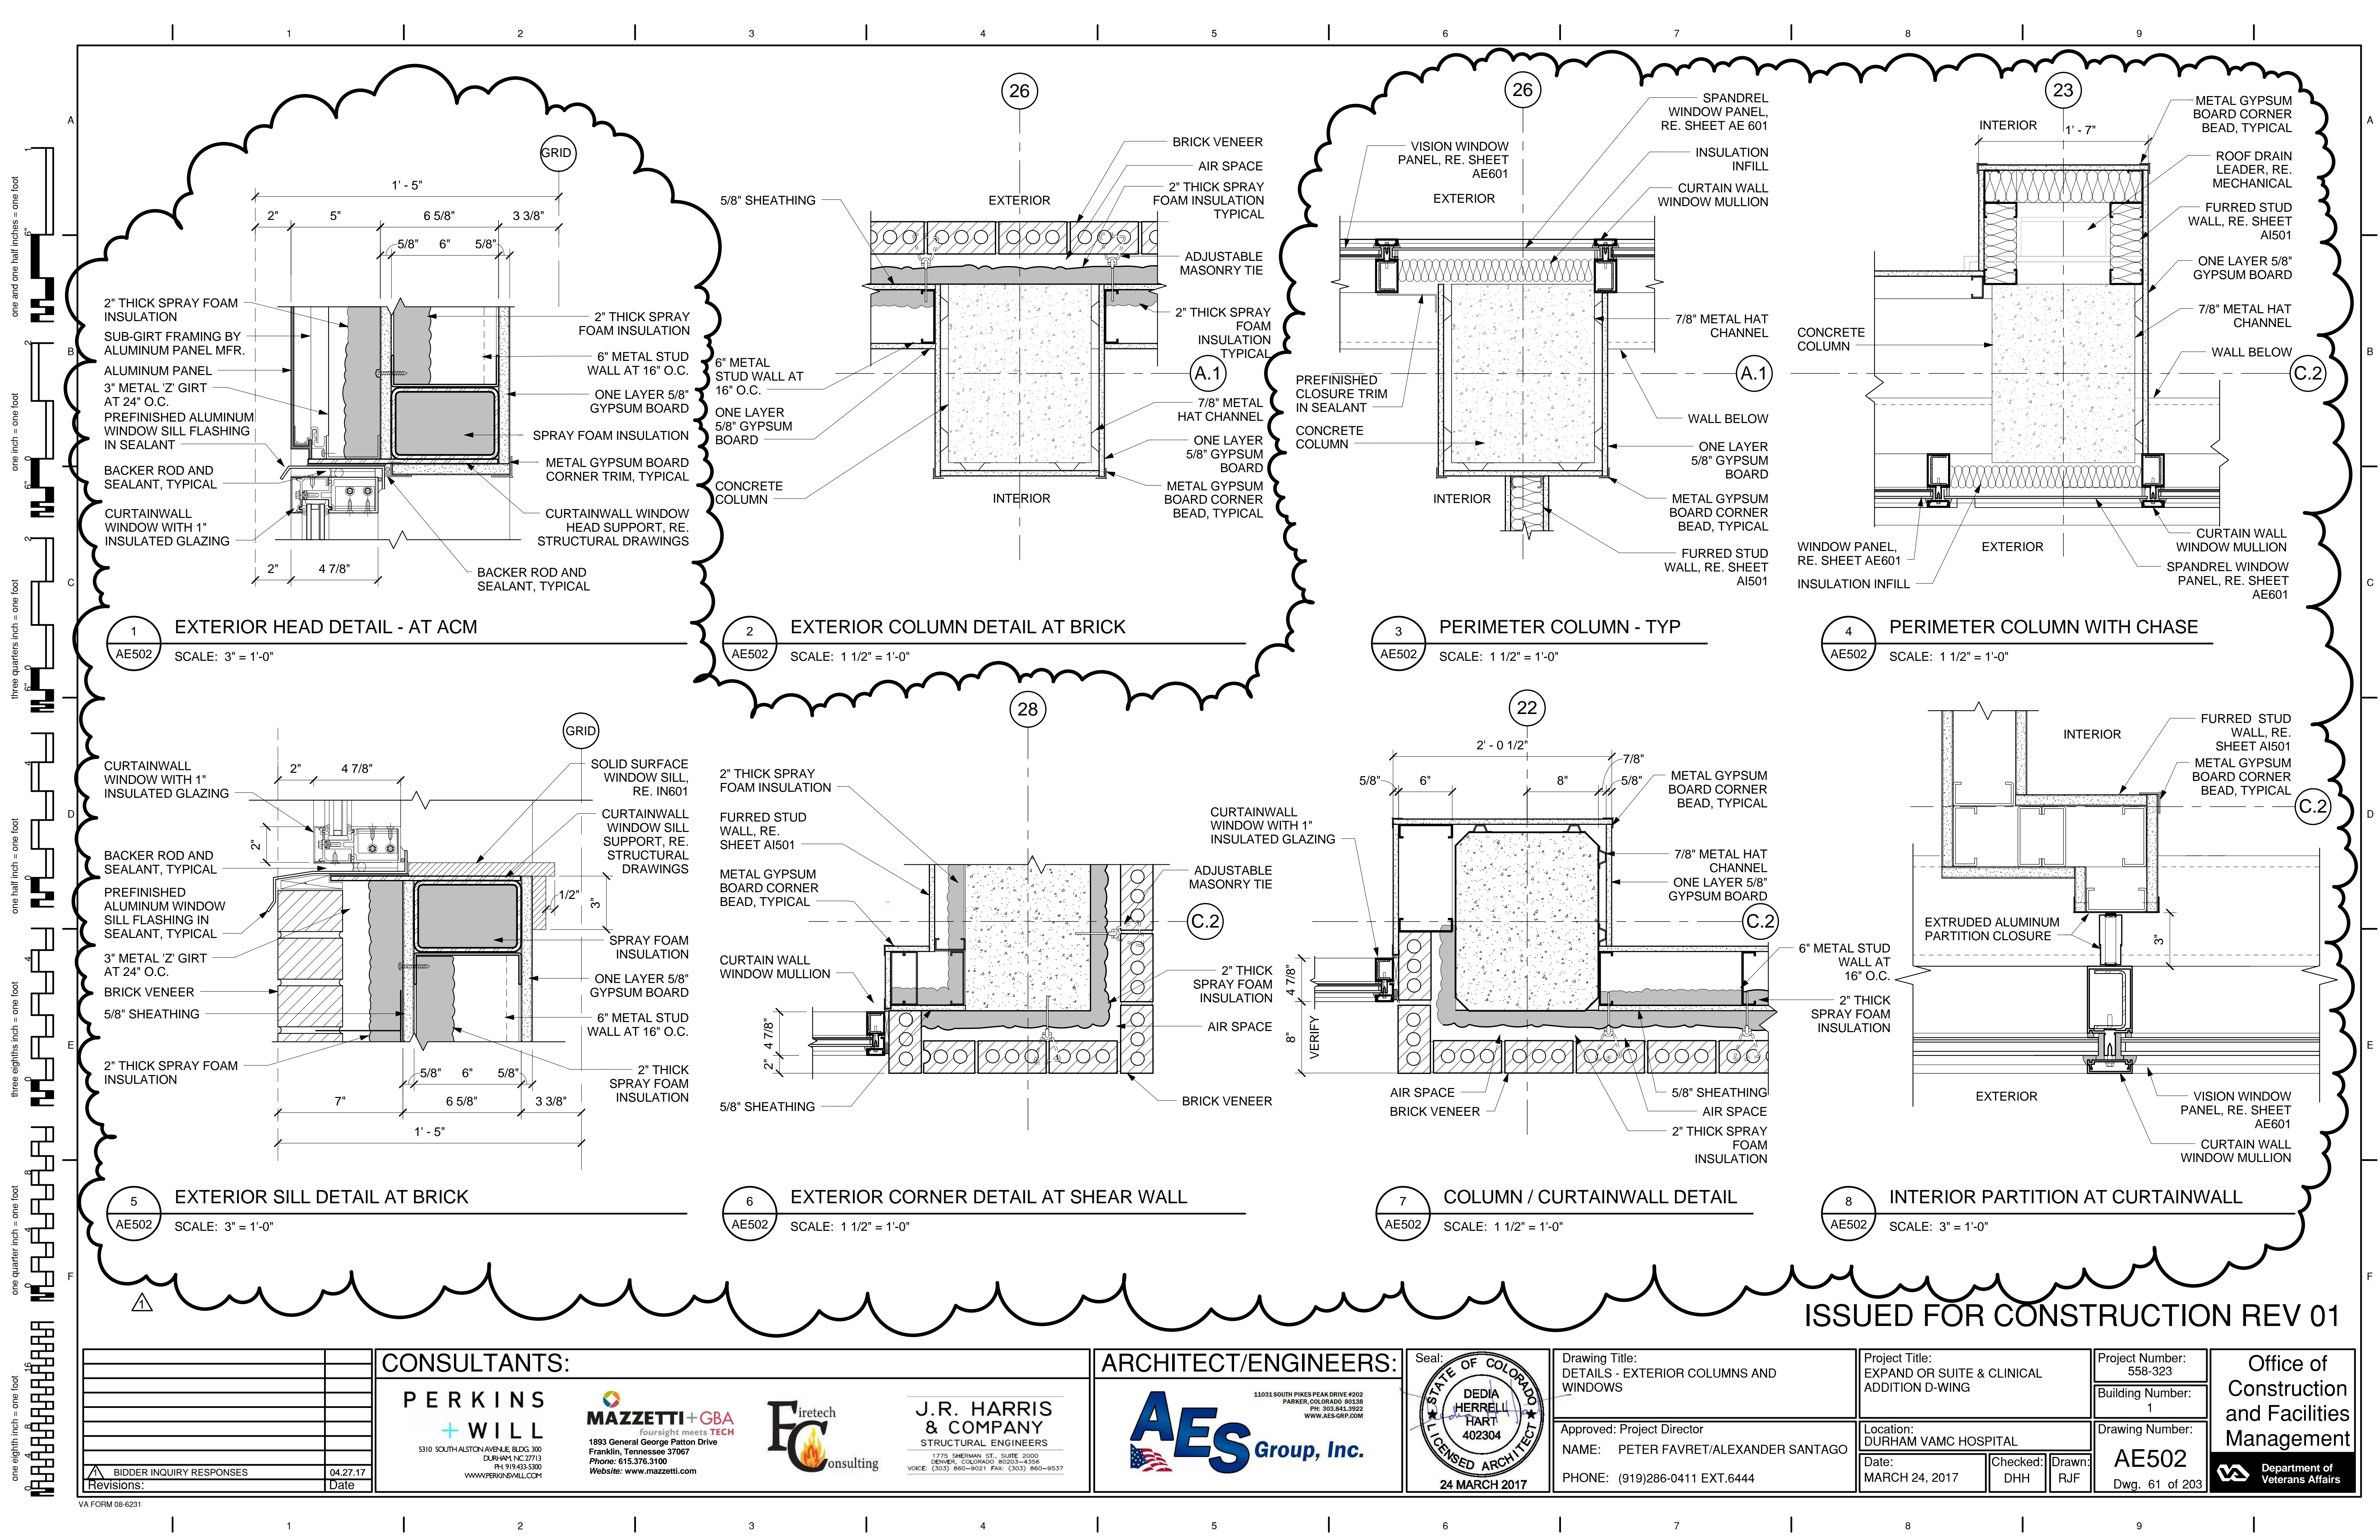

ISSUED FOR CONSTRUCTION REV 01

		<b>CONSULTANTS:</b>		<b>ARCHITECT/ENGINEERS:</b>		<div>Seal:<div><div>STATE OF COLORADO</div><div>DEDIA HERRELL HART 402304</div><div>LICENSED ARCHITECT</div><div>24 MARCH 2017</div></div></div>		<div>Drawing Title:<div>DETAILS - EXTERIOR COLUMNS AND WINDOWS</div></div> <div>Approved: Project Director</div> <div>NAME: PETER FAVRET/ALEXANDER SANTAGO</div> <div>PHONE: (919)286-0411 EXT.6444</div>		<div>Project Title:<div>EXPAND OR SUITE &amp; CLINICAL ADDITION D-WING</div></div> <div>Location:<div>DURHAM VAMC HOSPITAL</div></div> <div>Date:<div>MARCH 24, 2017</div></div> <div>Checked:<div>DHH</div></div> <div>Drawn:<div>RJF</div></div>		<div>Project Number:<div>558-323</div></div> <div>Building Number:<div>1</div></div> <div>Drawing Number:<div>AE502</div></div> <div>Dwg. 61 of 203</div>		<div>Office of Construction and Facilities Management</div> <div><div>VA</div>Department of Veterans Affairs</div>	
		<div><div>PERKINS + WILL</div><div>5310 SOUTH ALSTON AVENUE, BLDG. 300 DURHAM, NC 27713 PH: 919.433.3300 WWW.PERKINSWILL.COM</div></div> <div><div>MAZZETTI+GBA</div><div>fourright meets TECH</div><div>1893 General George Patton Drive Franklin, Tennessee 37067 Phone: 615.376.3100 Website: www.mazzetti.com</div></div> <div><div>FCiretech consulting</div></div> <div><div>J.R. HARRIS &amp; COMPANY</div><div>STRUCTURAL ENGINEERS</div><div>1775 SHERMAN ST., SUITE 2000 DENVER, COLORADO 80203-4358 VOICE: (303) 860-9021 FAX: (303) 860-9537</div></div>		<div><div>AESGroup, Inc.</div><div>11031 SOUTH PINES PEAK DRIVE #202 PARKER, COLORADO 80138 PH: 303.841.3522 WWW.AES-GRP.COM</div></div>											
<div><div>BIDDER INQUIRY RESPONSES</div><div>04.27.17</div><div>Revisions:</div><div>Date</div></div>															



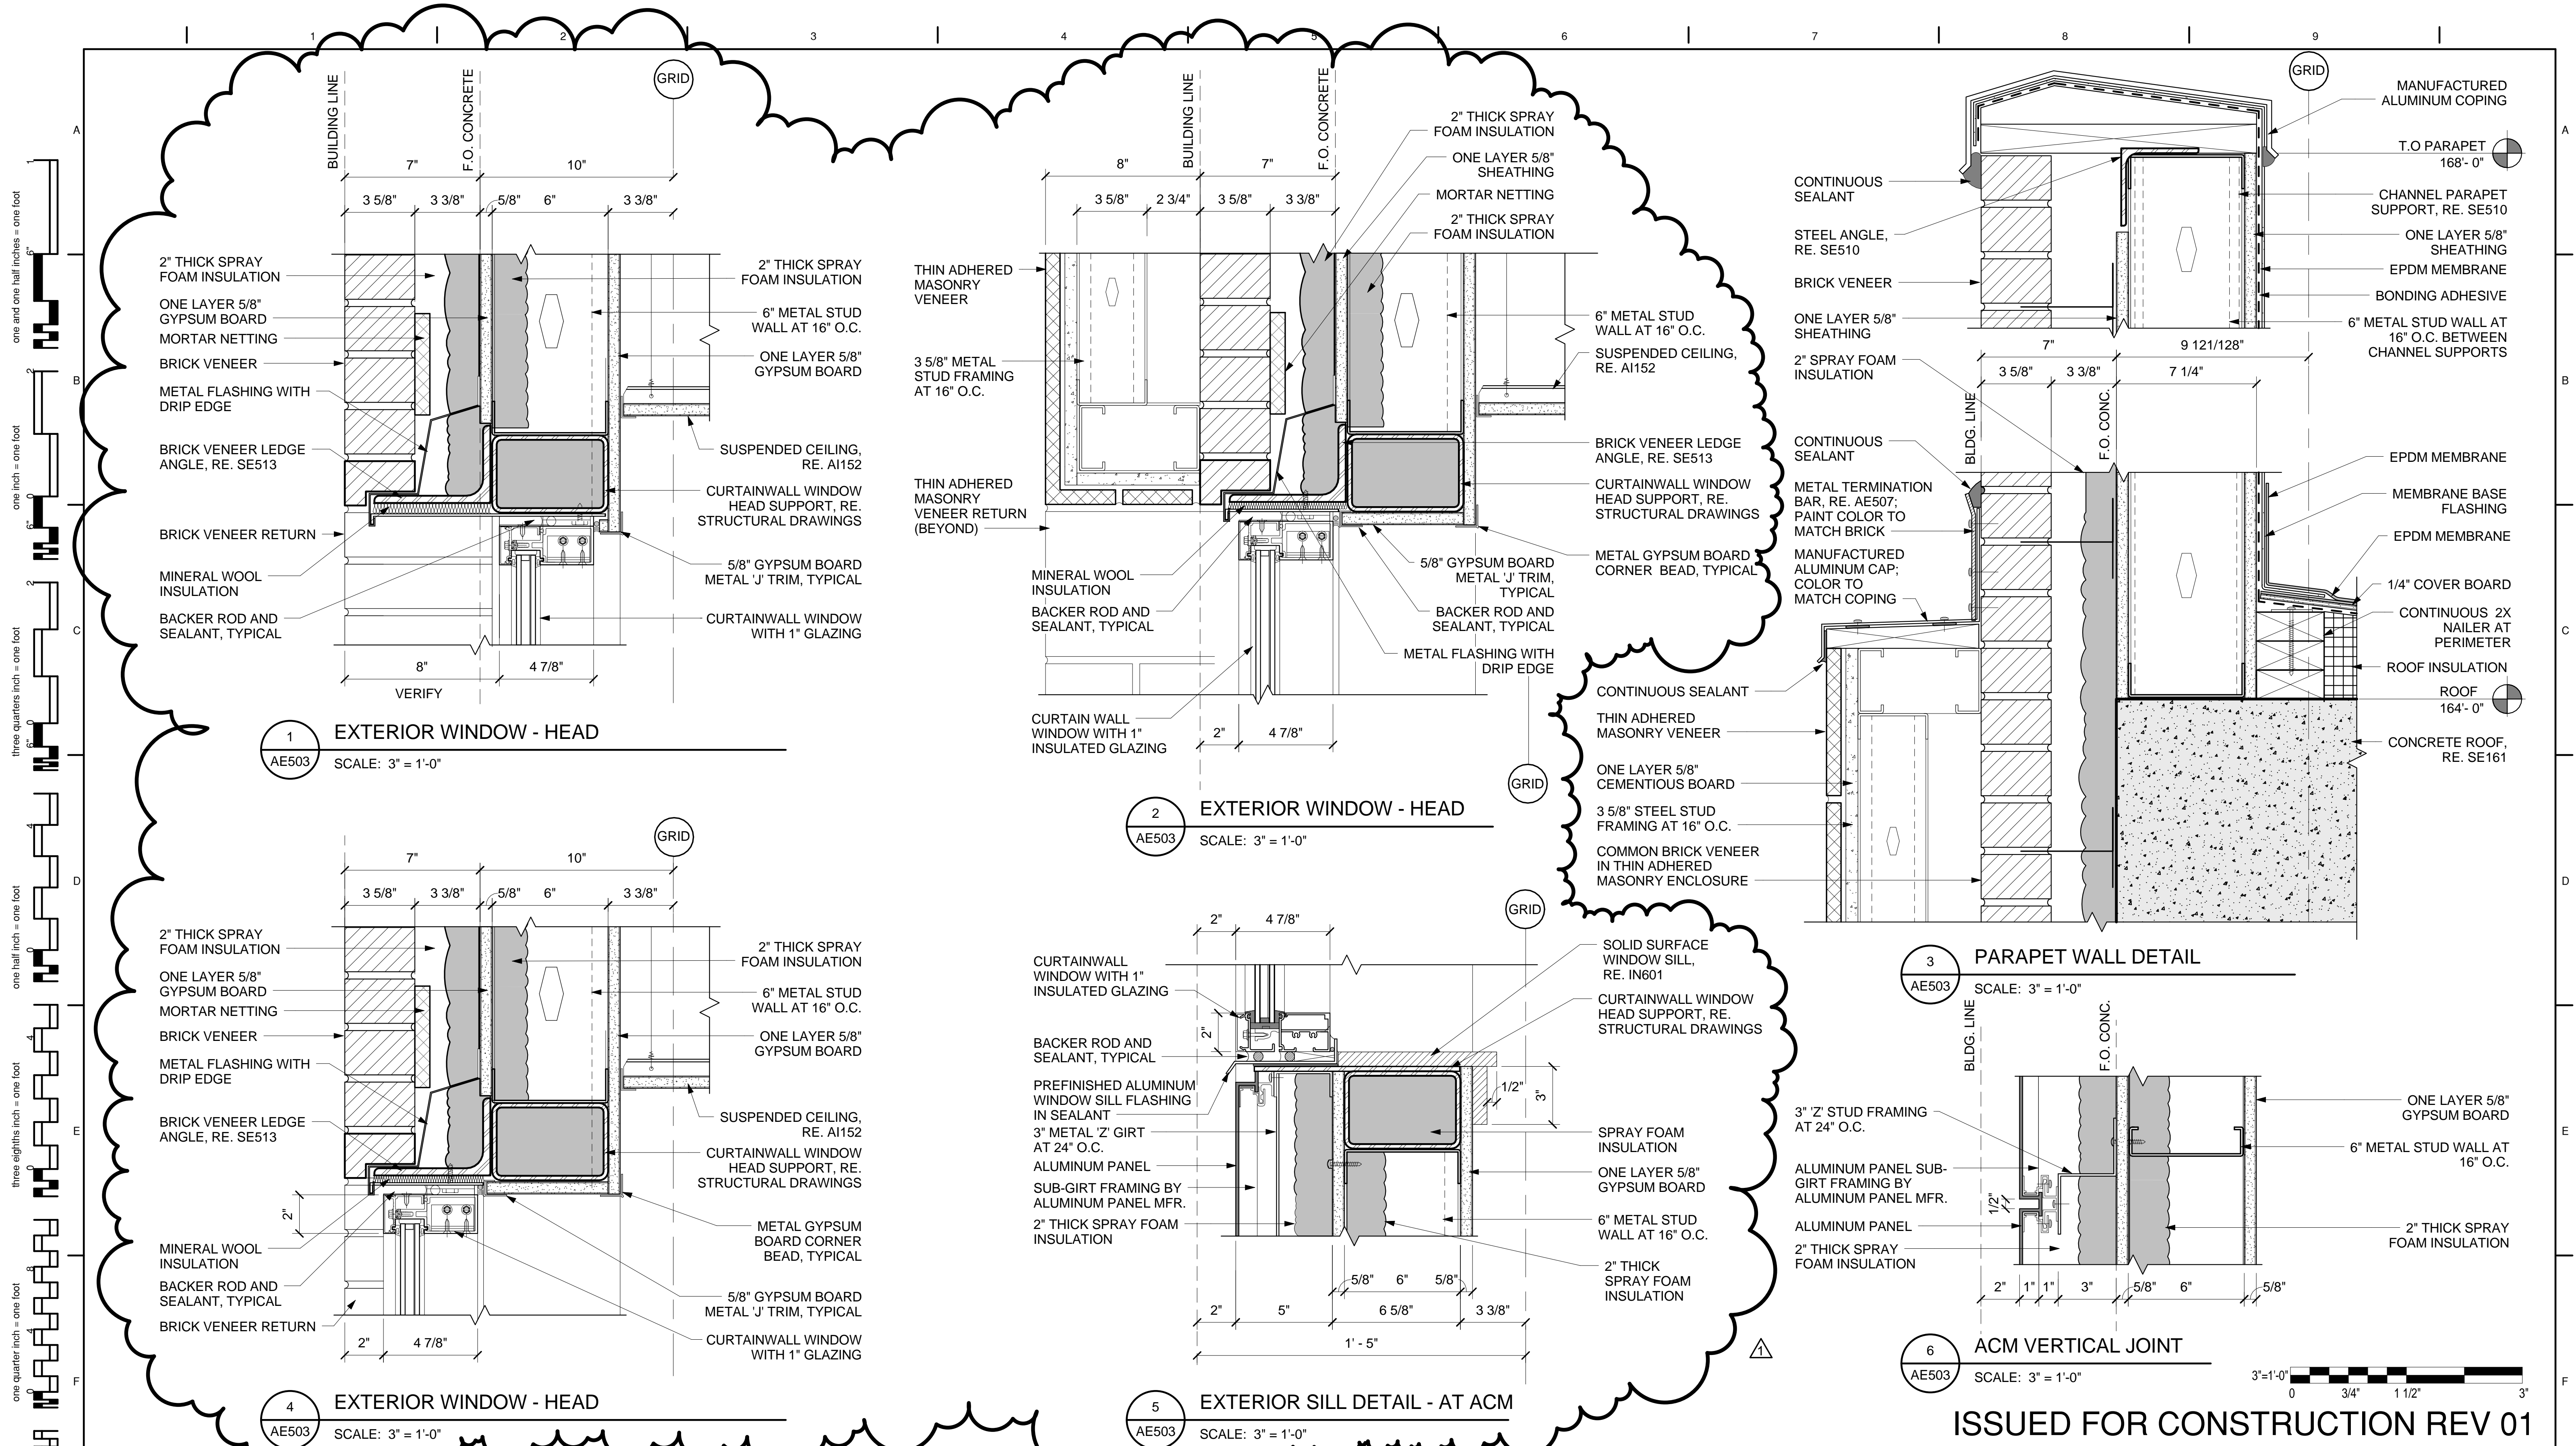


one and one half inches = one foot  
one inch = one foot  
three quarters inch = one foot  
one half inch = one foot  
three eighths inch = one foot  
one quarter inch = one foot  
one eighth inch = one foot

<b>CONSULTANTS:</b>		<b>ARCHITECT/ENGINEERS:</b>		Seal:		Drawing Title: DETAILS - EXTERIOR SECTION		Project Title: EXPAND OR SUITE & CLINICAL ADDITION D-WING		Project Number: 558-323		<b>Office of Construction and Facilities Management</b> 			
 1893 General George Patton Drive Franklin, Tennessee 37067 Phone: 615.376.3100 Website: www.mazzetti.com		 1775 SHERMAN ST., SUITE 2000 DENVER, COLORADO 80203-4358 VOICE: (303) 860-9021 FAX: (303) 860-9537		 STRUCTURAL ENGINEERS 1775 SHERMAN ST., SUITE 2000 DENVER, COLORADO 80203-4358 VOICE: (303) 860-9021 FAX: (303) 860-9537				Approved: Project Director NAME: PETER FAVRET/ALEXANDER SANTAGO PHONE: (919)286-0411 EXT.6444		Building Number: 1				Drawing Number: <b>AE503</b> Dwg. 62 of 203	
BIDDER INQUIRY RESPONSES Revisions: 04.27.17 Date								Location: DURHAM VAMC HOSPITAL		Date: MARCH 24, 2017				Checked: DHH	


ISSUED FOR CONSTRUCTION REV 01




one and one half inches = one foot  
one inch = one foot  
one inch = one foot  
three quarters inch = one foot  
one half inch = one foot  
one half inch = one foot  
three eighths inch = one foot  
one quarter inch = one foot  
one eighth inch = one foot  
one eighth inch = one foot

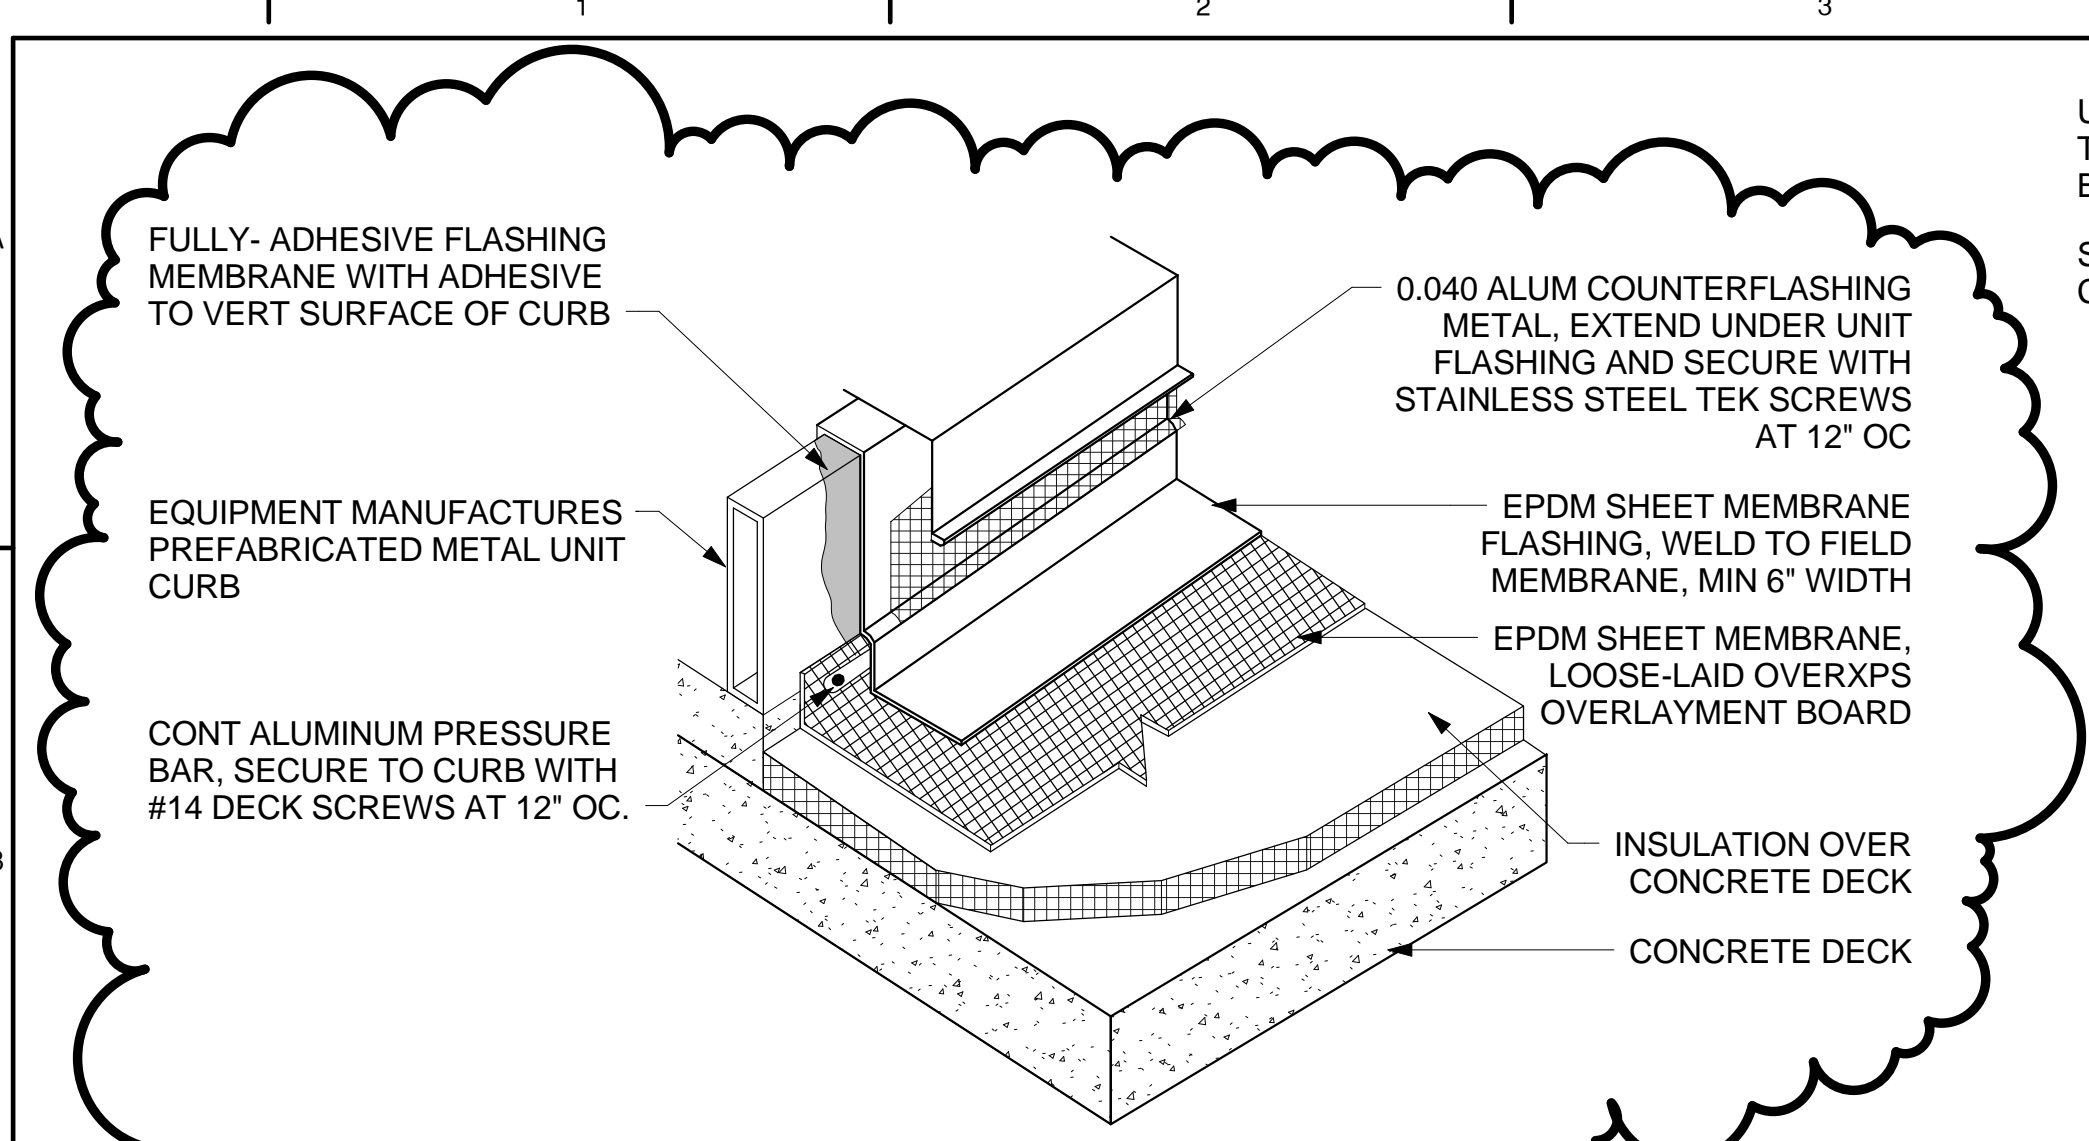


1 TYPICAL EQUIPMENT CURB FLASHING  
AE505 SCALE: NTS

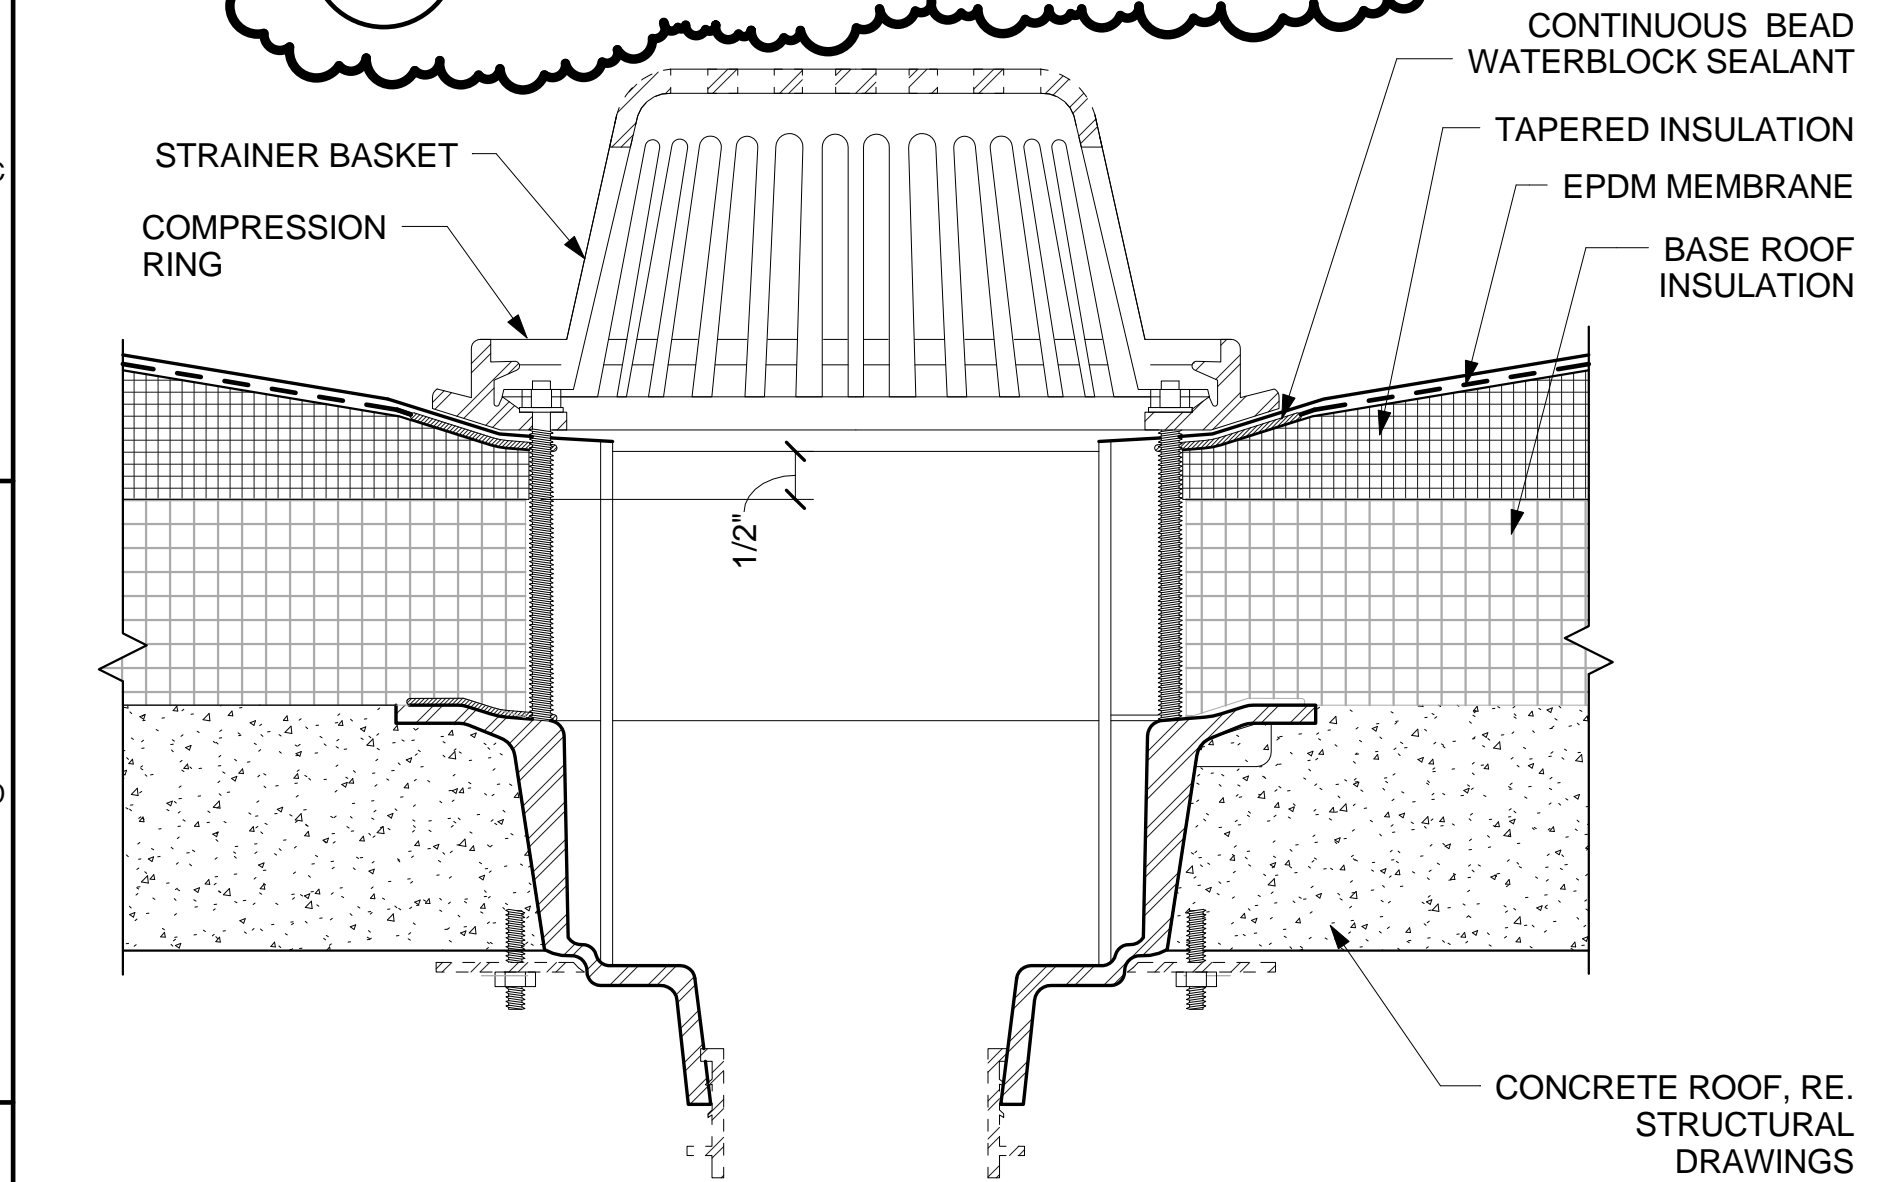


4 ROOF DRAIN DETAIL  
AE505 SCALE: NTS

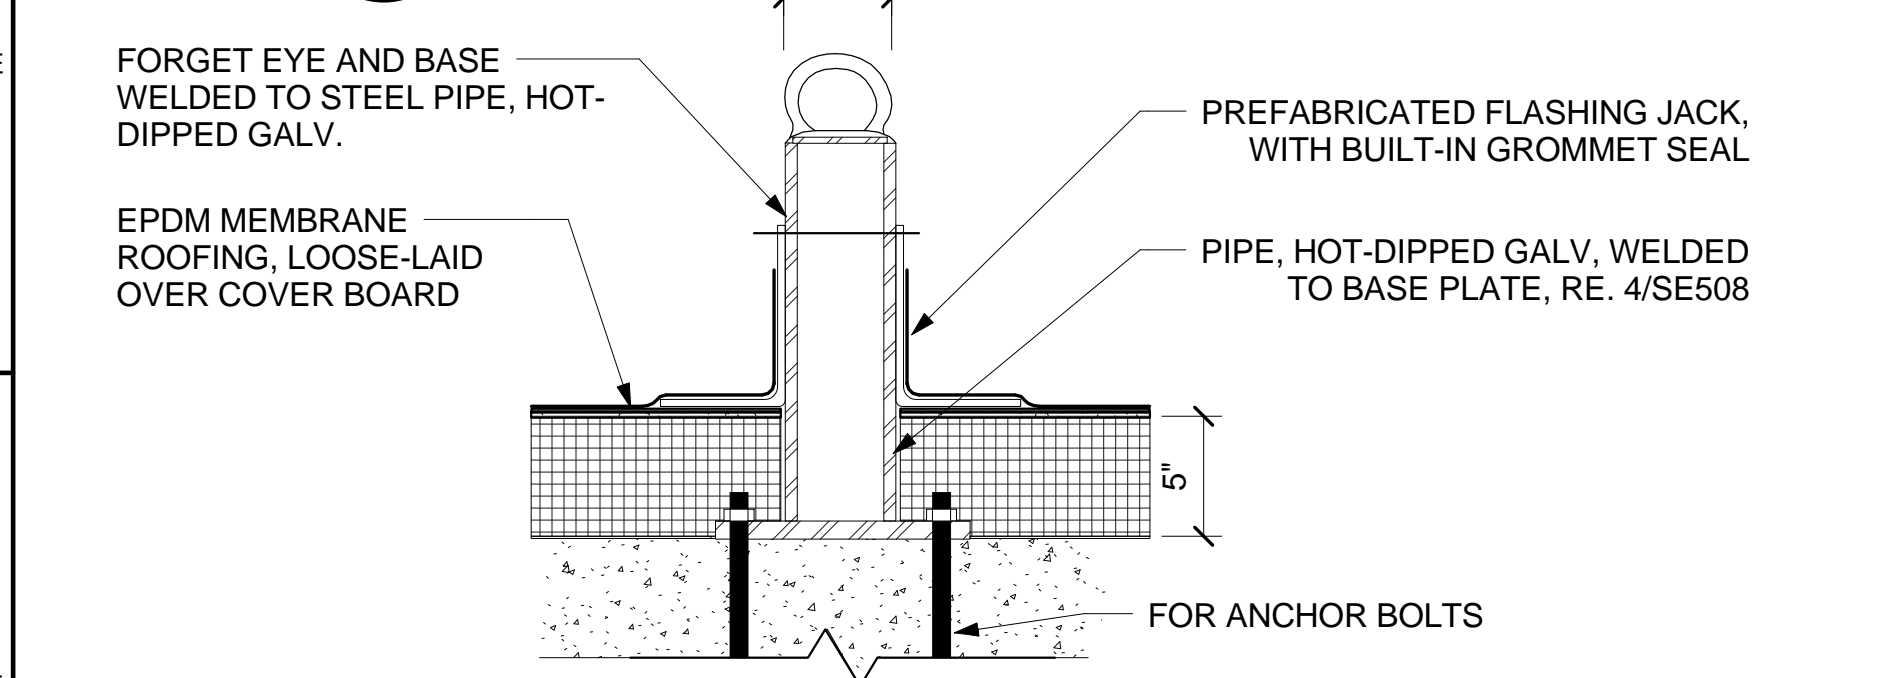


6 TYPICAL FALL-ARREST ROOF ANCHOR DETAIL  
AE505 SCALE: NTS

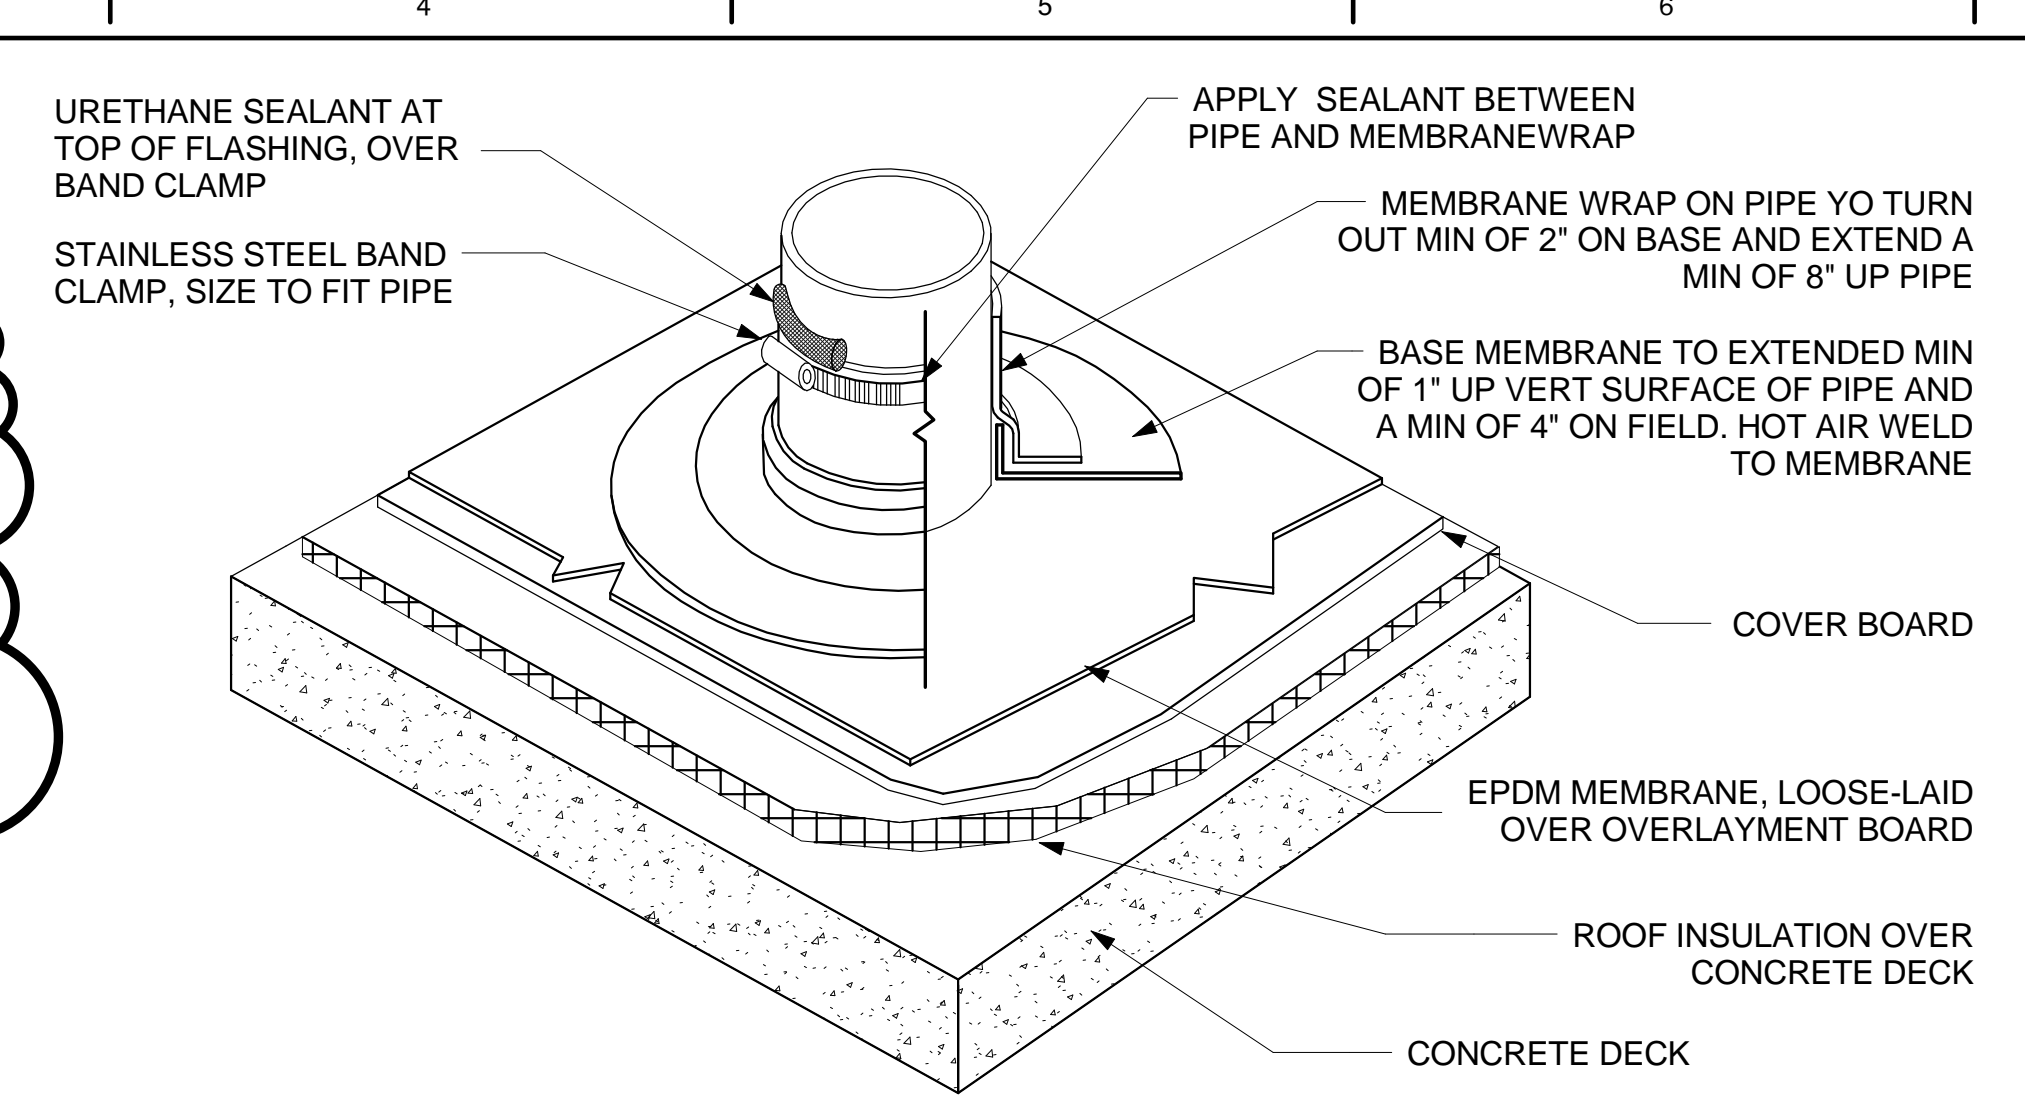


2 PIPE/DUCT FLASHING DETAIL  
AE505 SCALE: NTS

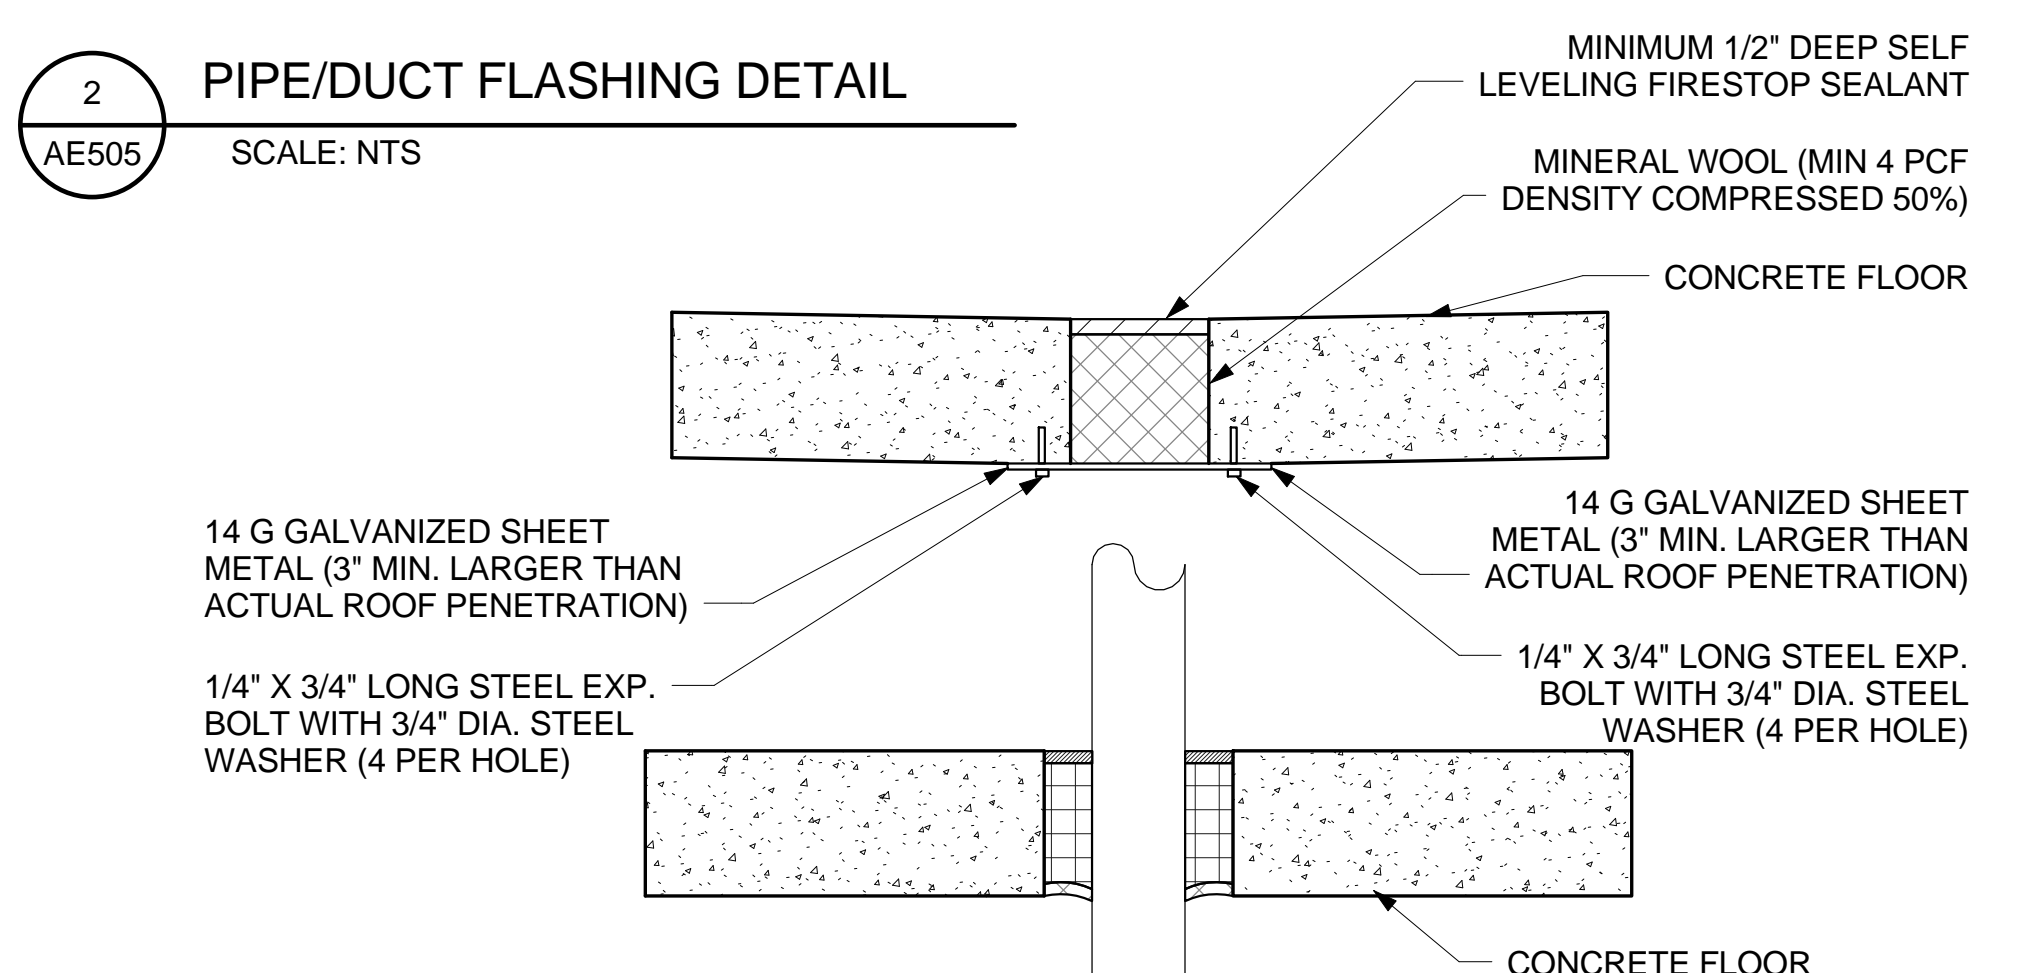


5 PENETRATION DUCT/ PIPE DETAIL  
AE505 SCALE: 1 1/2" = 1'-0"

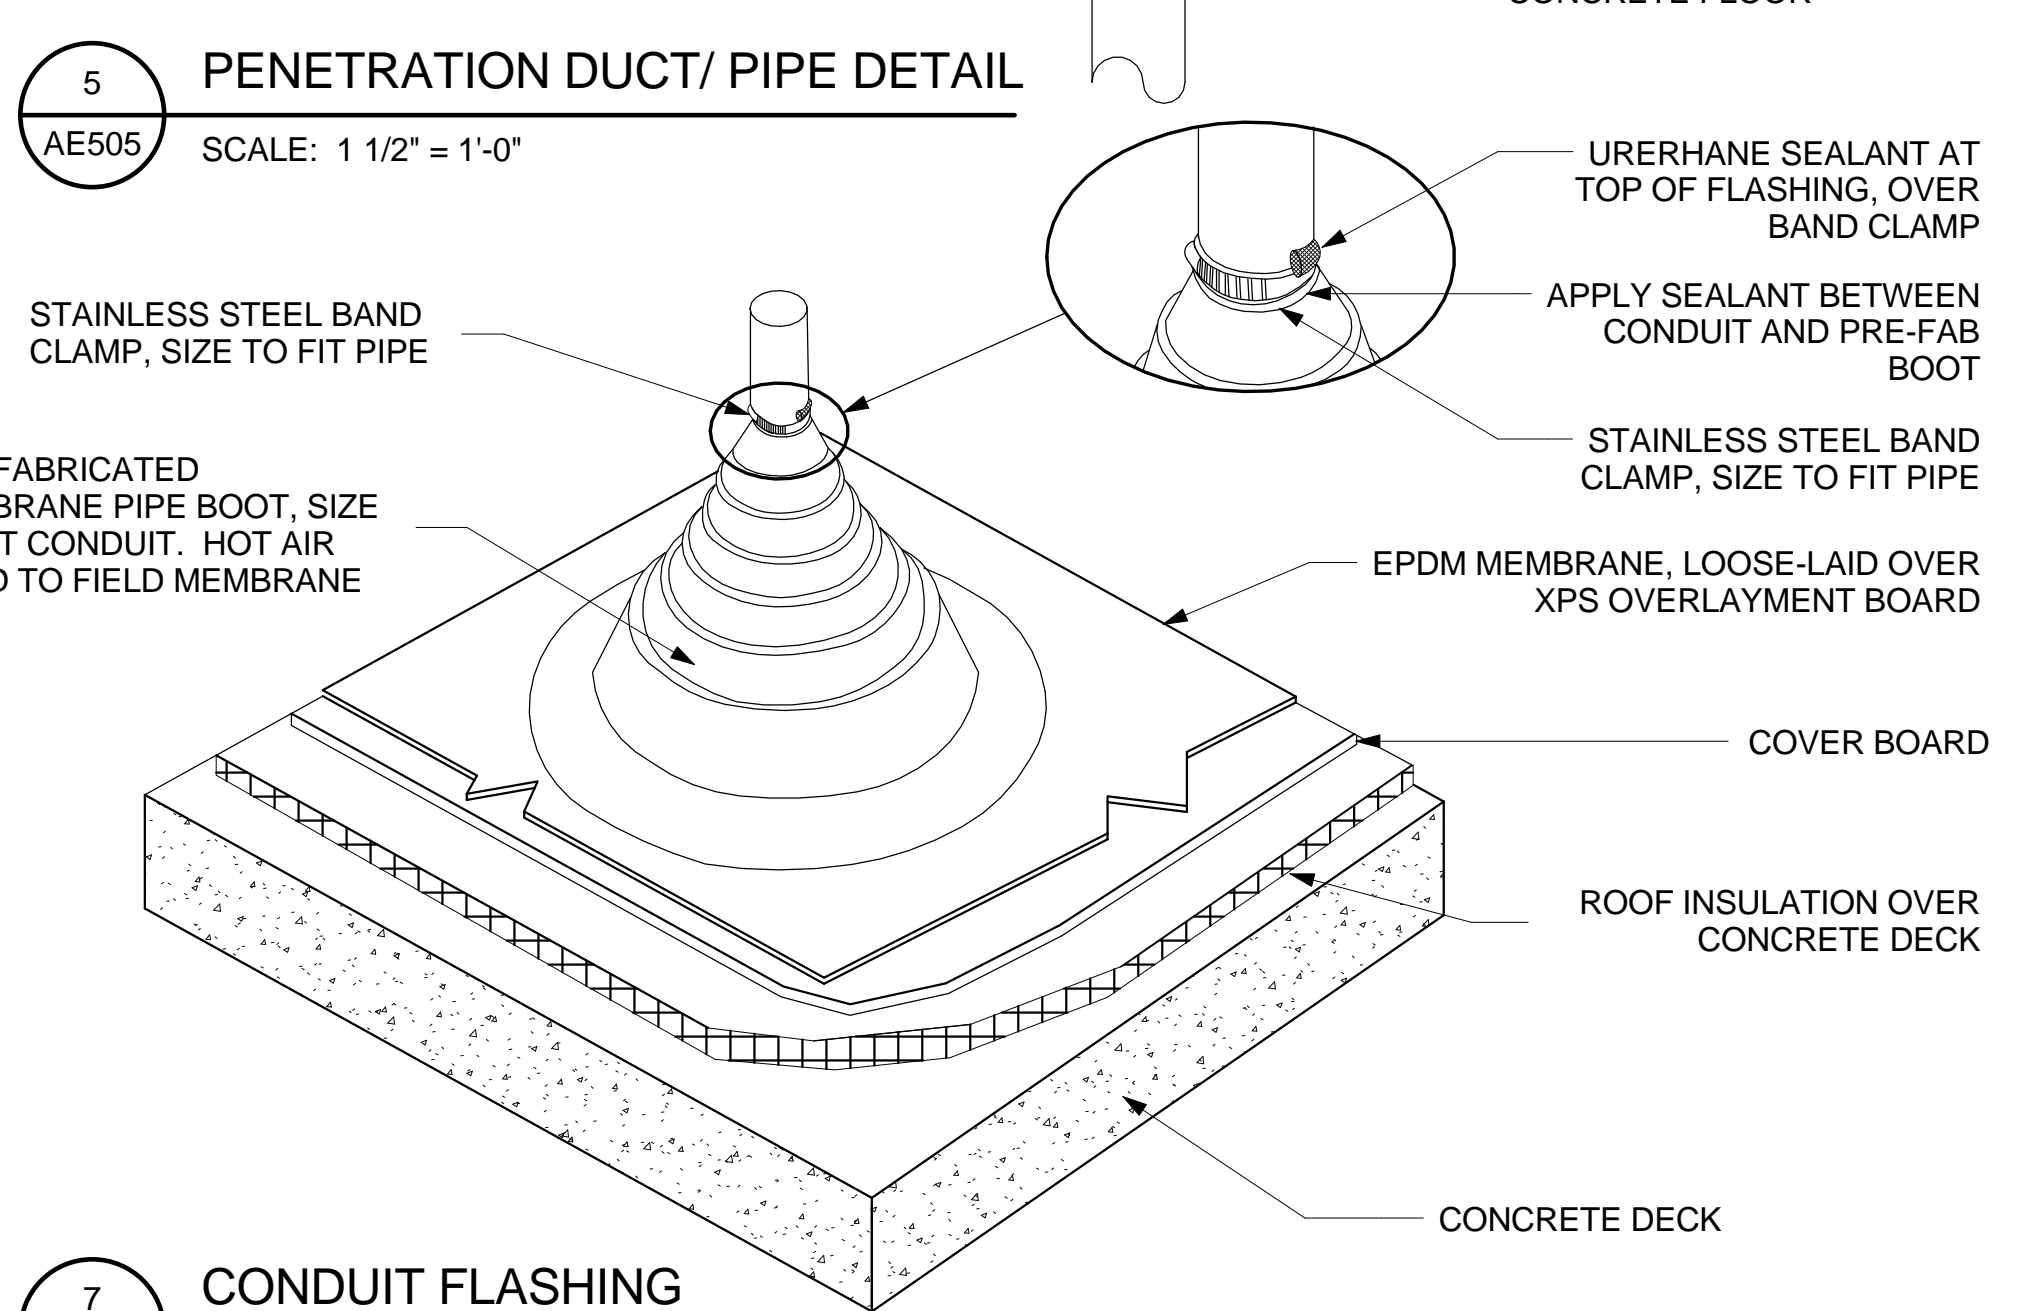

7 CONDUIT FLASHING  
AE505 SCALE: NTS

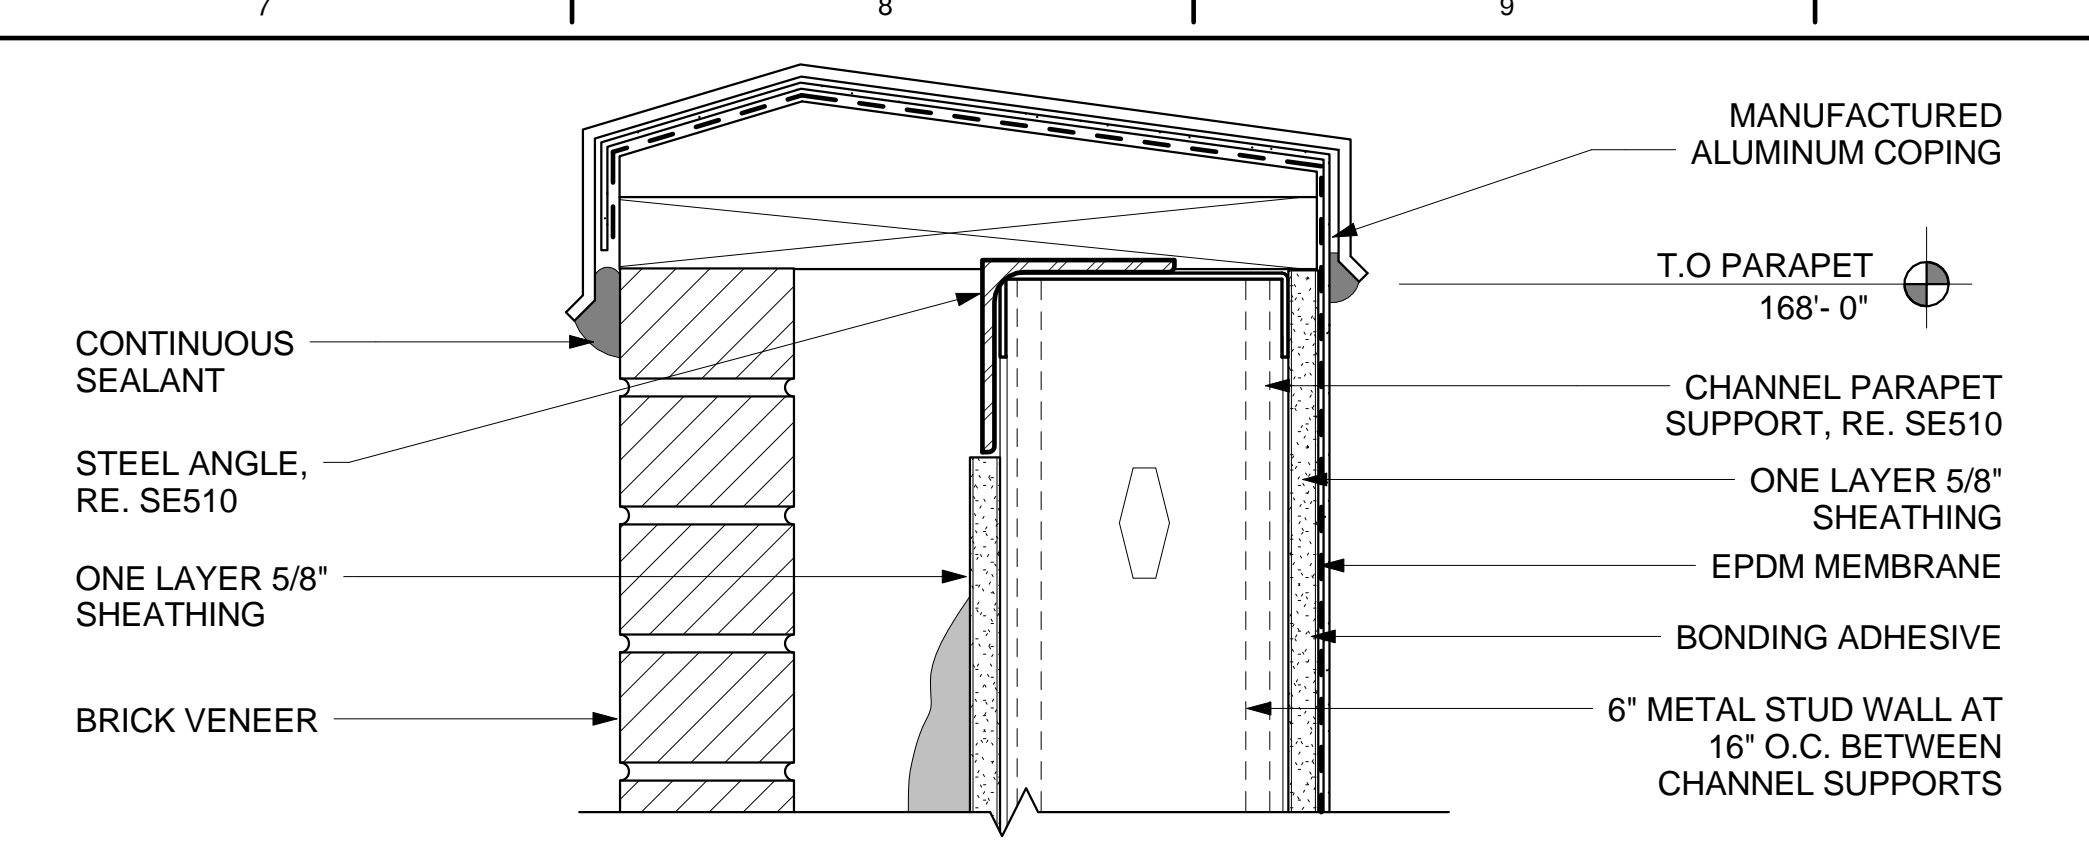

3 PARAPET WALL  
AE505 SCALE: 3" = 1'-0"

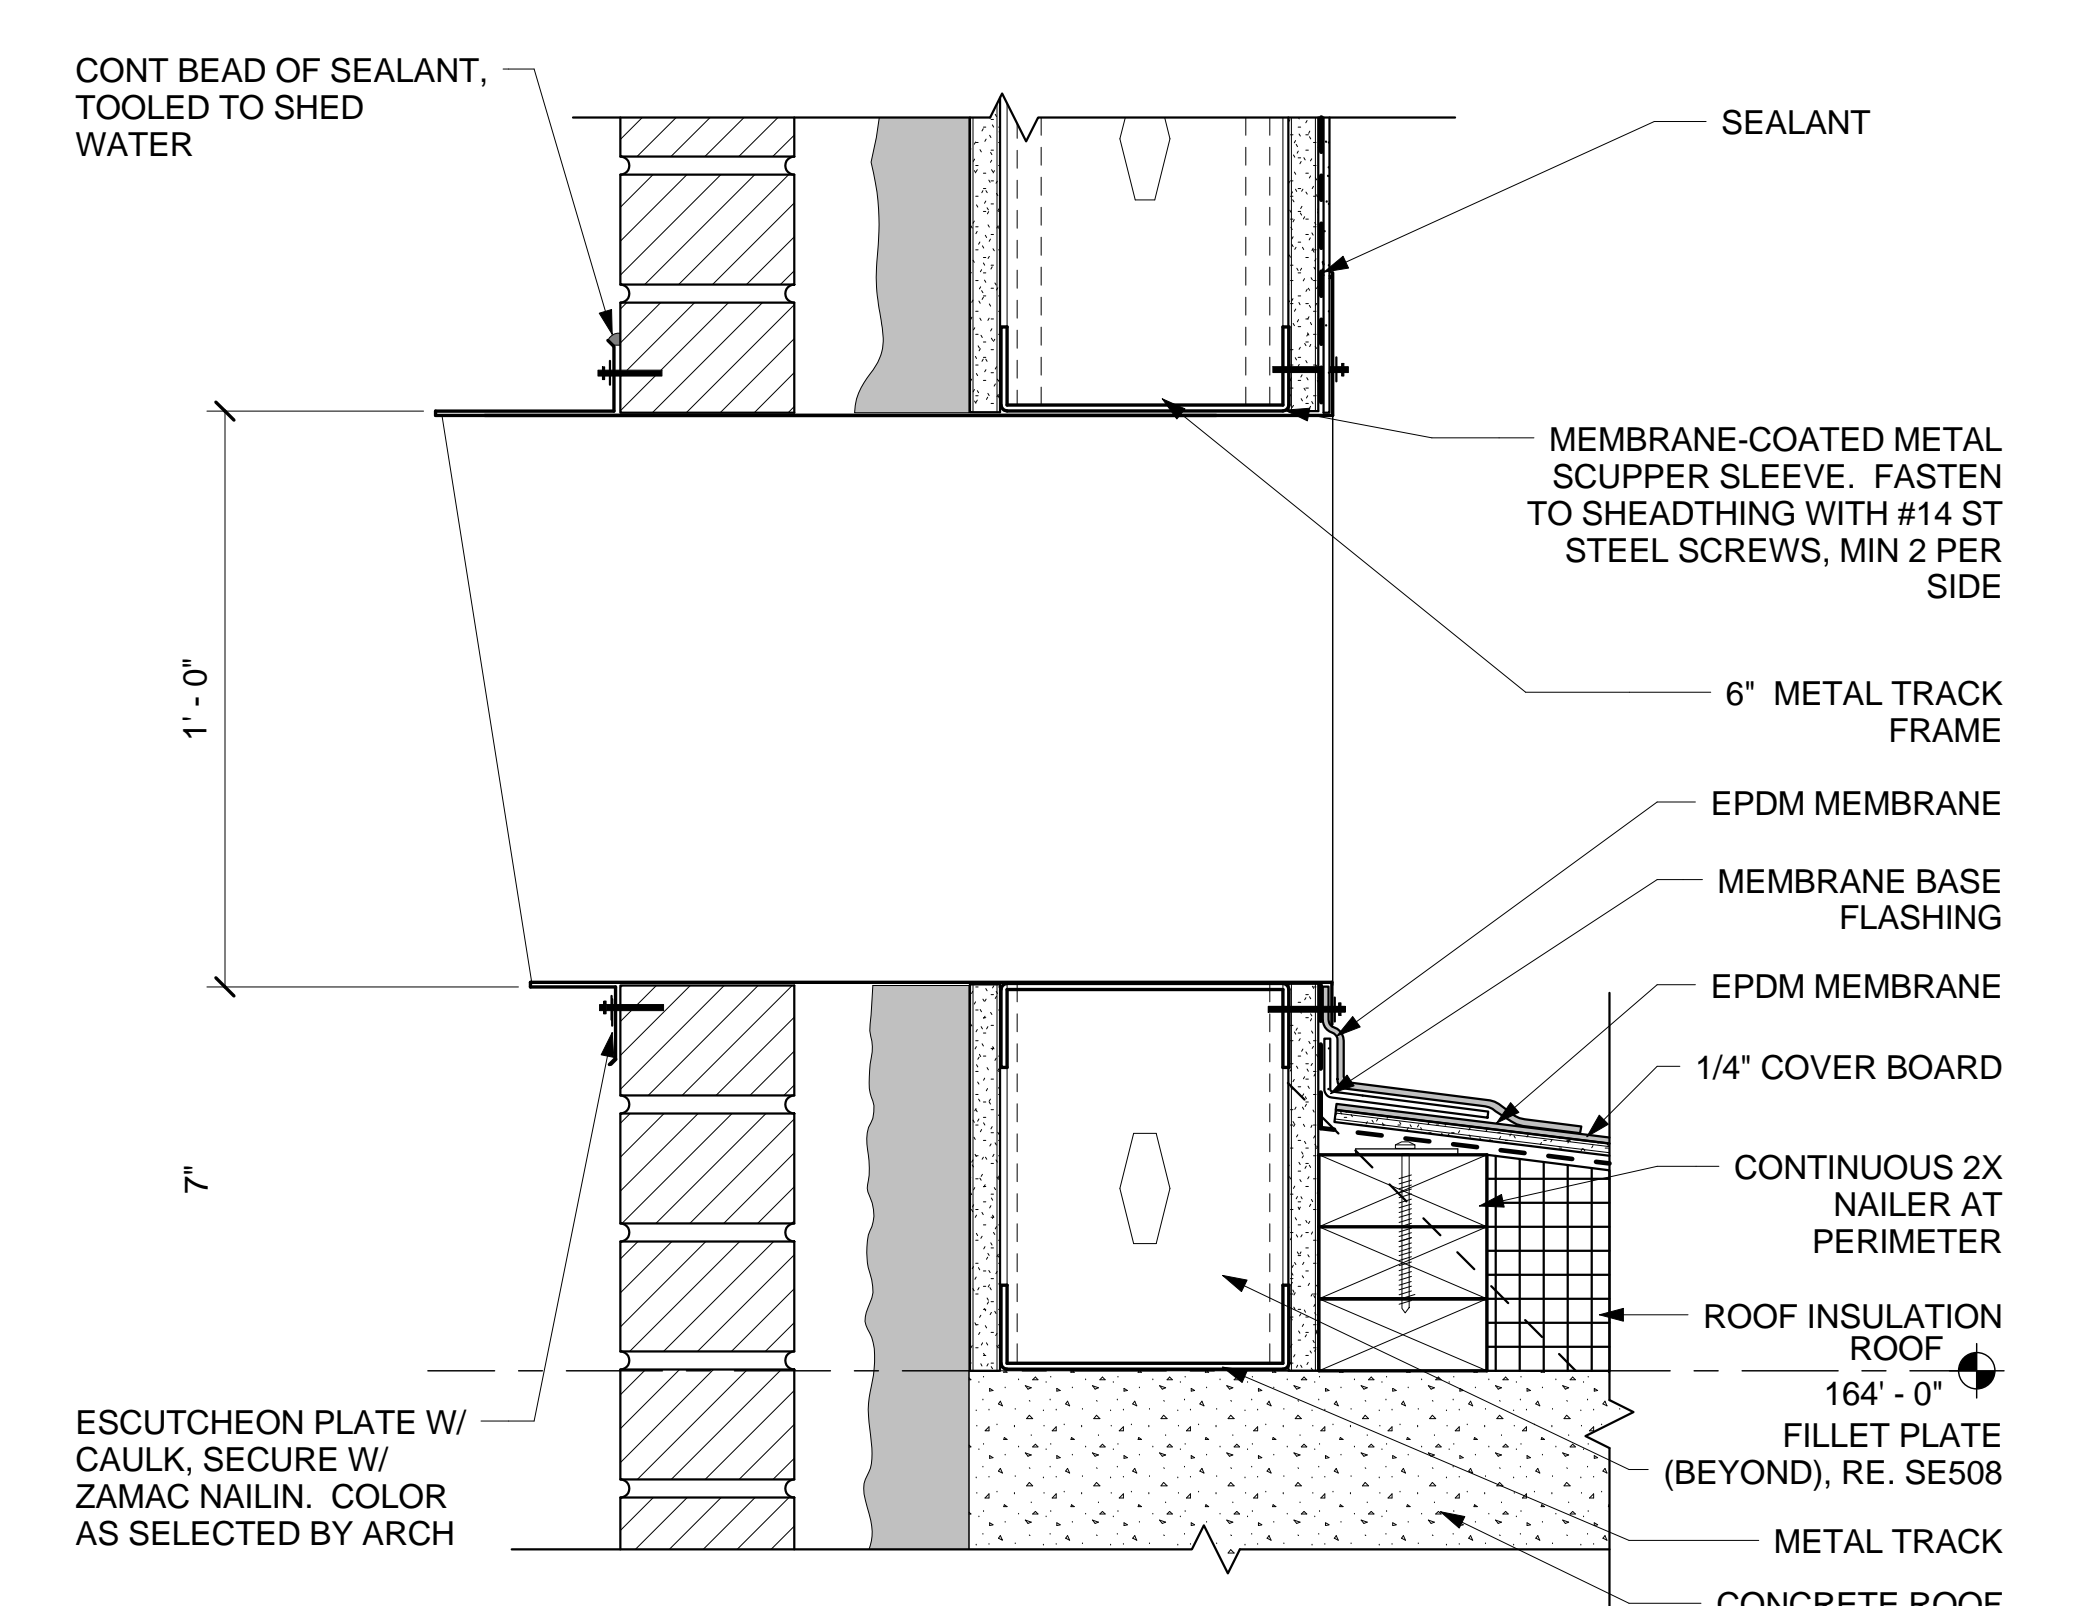


8 FLASHING TERMINATION DETAIL  
AE505 SCALE: NTS

ISSUED FOR CONSTRUCTION REV 01

<b>CONSULTANTS:</b> <b>PERKINS + WILL</b> 5310 SOUTH ALSTON AVENUE, BLDG. 300 DURHAM, NC 27713 PH: 919.433.3300 WWW.PERKINS+WILL.COM		<b>MAZZETTI + GBA</b> FOURTH MEETS TECH 1893 General George Patton Drive Franklin, Tennessee 37067 Phone: 615.376.3100 Website: www.mazzetti.com		<b>iretech</b> FC consulting		<b>J.R. HARRIS &amp; COMPANY</b> STRUCTURAL ENGINEERS 1775 SHERMAN ST., SUITE 2000 DENVER, COLORADO 80203-4358 VOICE: (303) 860-9021 FAX: (303) 860-9537		<b>ARCHITECT/ENGINEERS:</b> <b>AEs Group, Inc.</b> 11031 SOUTH PINES PEAK DRIVE #202 PARKER, COLORADO 80138 PH: 303.841.3922 WWW.AES-GRP.COM		Seal: <b>STATE OF COLORADO</b> <b>DEDIA HERRELL</b> HART 402304 LICENSED ARCHITECT 24 MARCH 2017		Drawing Title: DETAILS - ROOF Approved: Project Director NAME: PETER FAVRET/ALEXANDER SANTAGO PHONE: (919)286-0411 EXT.6444		Project Title: EXPAND OR SUITE & CLINICAL ADDITION D-WING Location: DURHAM VAMC HOSPITAL Date: MARCH 24, 2017 Checked: DHH Drawn: LFL		Project Number: 558-323 Building Number: 1 Drawing Number: AE505 Dwg. 64 of 203		<b>Office of Construction and Facilities Management</b> Department of Veterans Affairs	
---	--	---	--	---------------------------------	--	--	--	---	--	--	--	---	--	---	--	---	--	---	--



one and one half inches = one foot  
three quarters inch = one foot  
one half inch = one foot  
three eighths inch = one foot  
one quarter inch = one foot  
one eighth inch = one foot

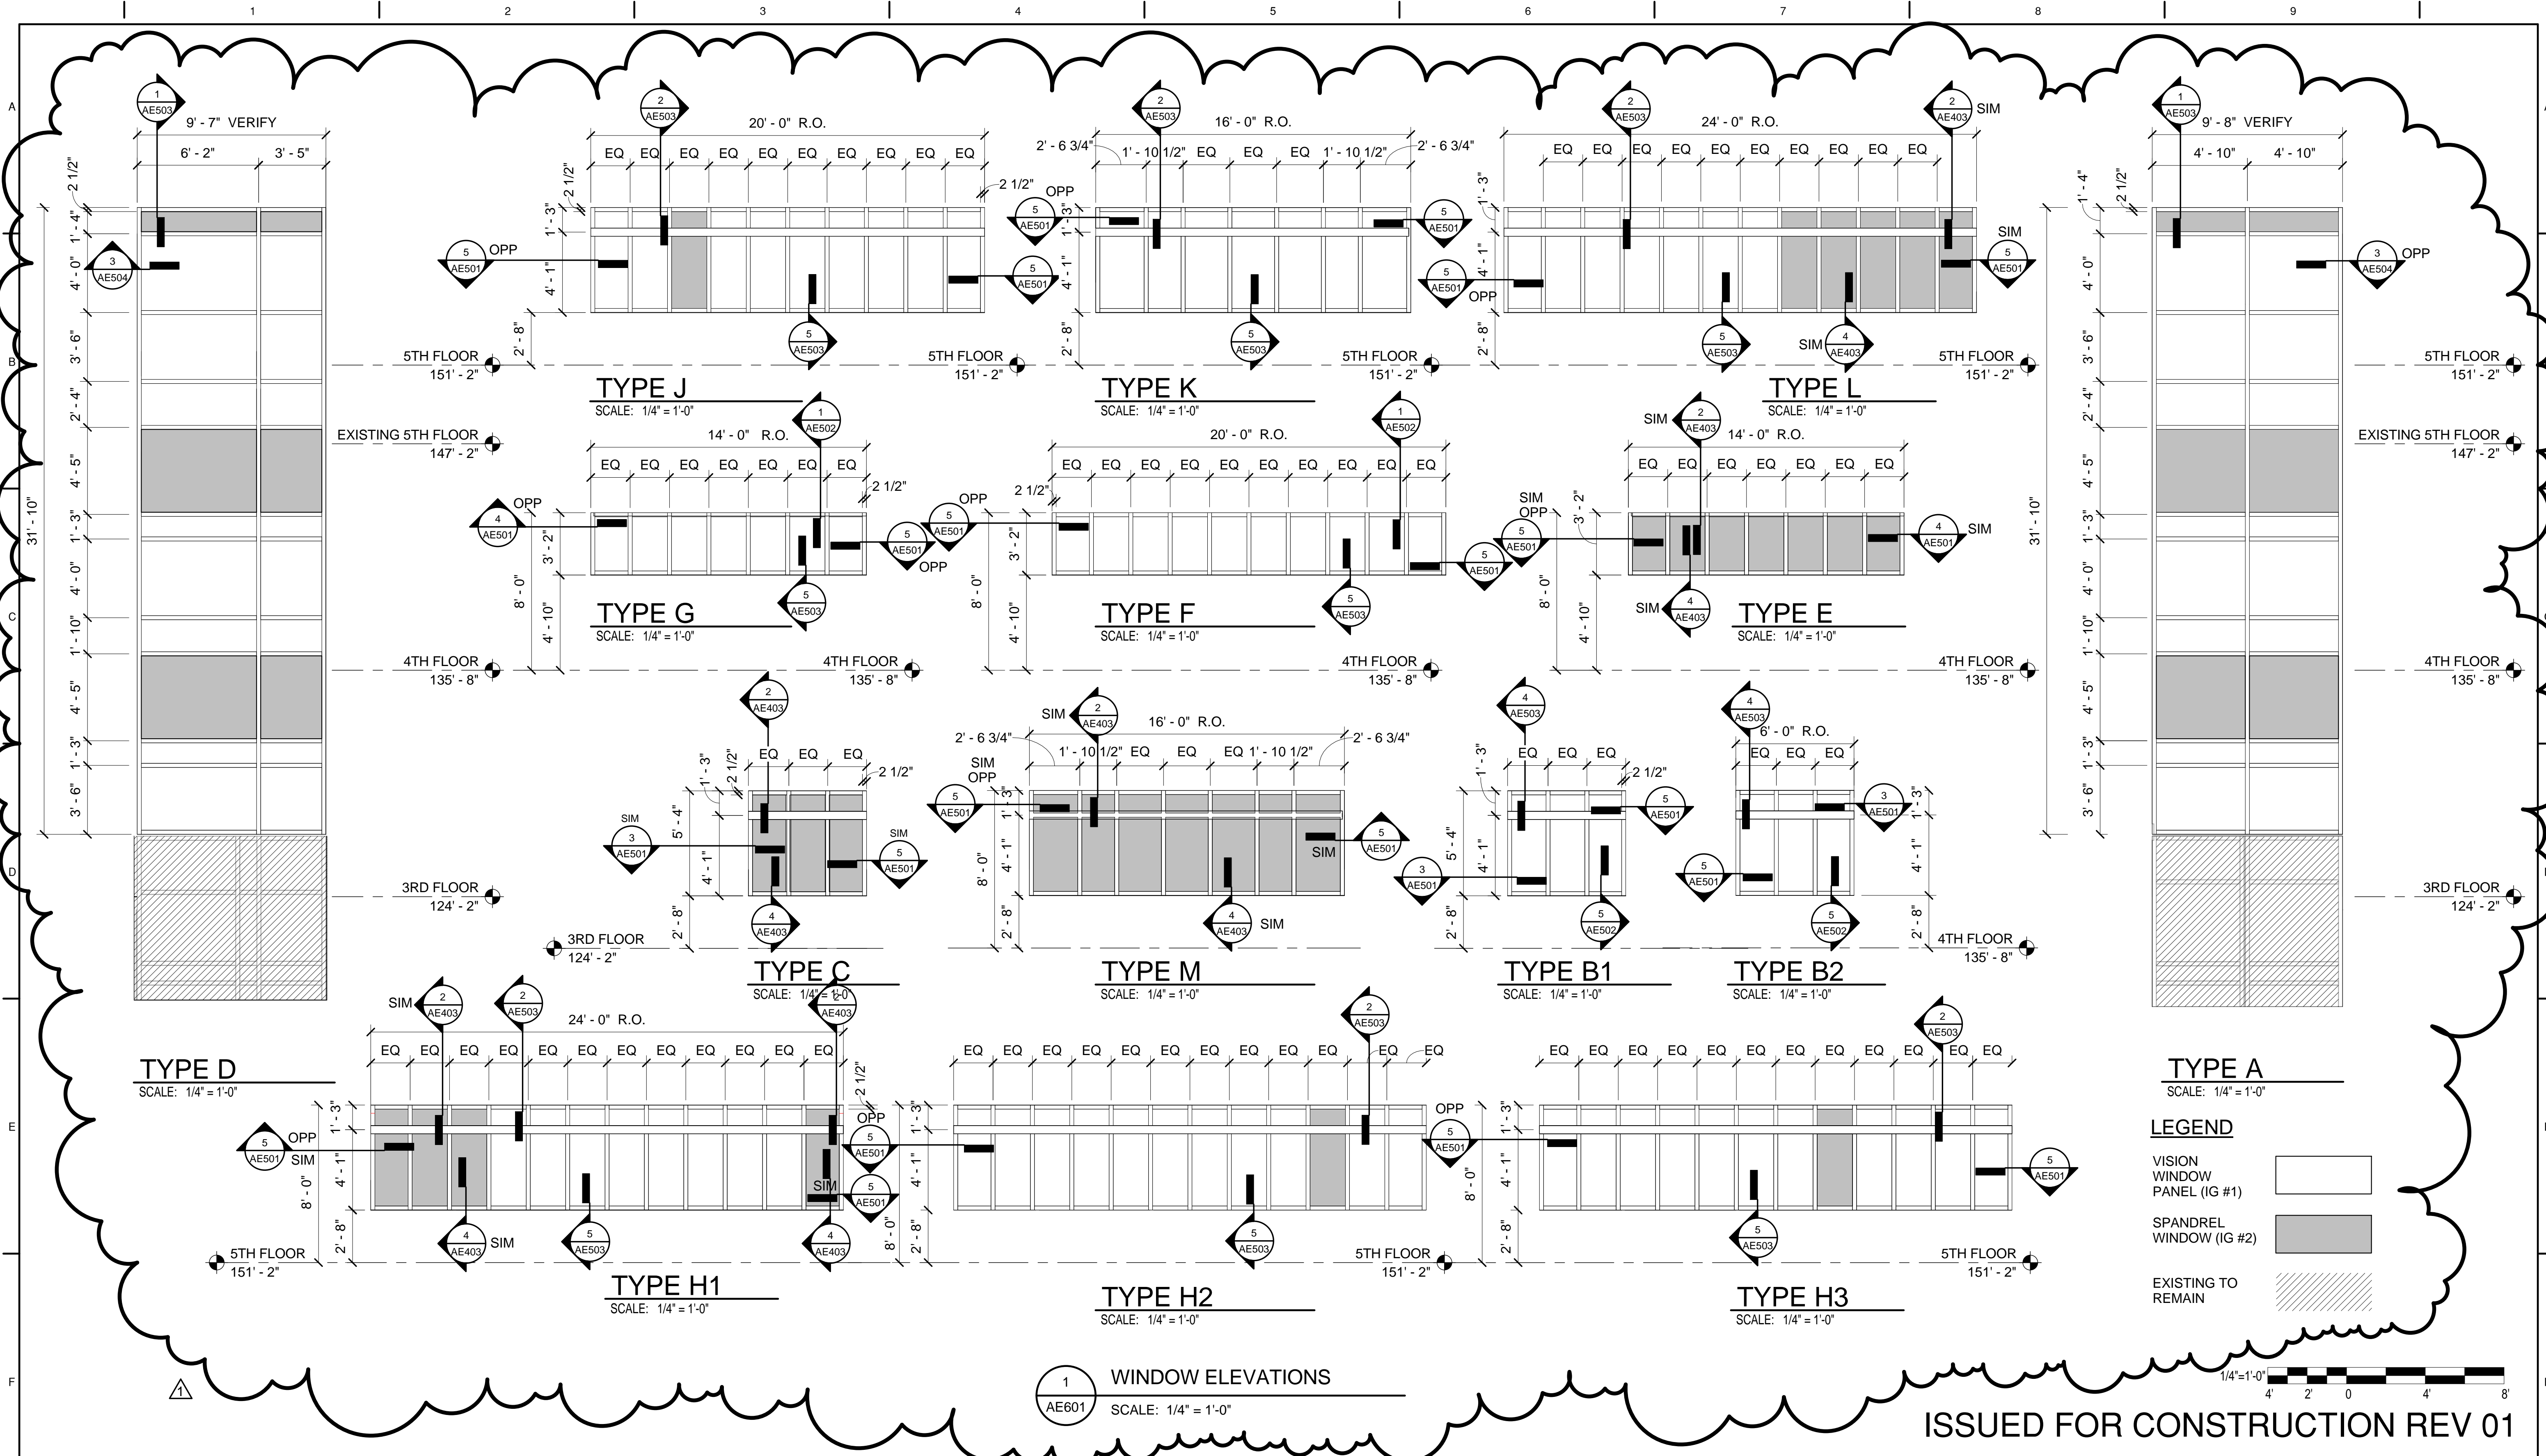

ISSUED FOR CONSTRUCTION REV 01

--	--	