REV	DESCRIPTION	BY	DATE	–	----	--	--/--/--	–	----	--	--/--/--
–	----	--	--/--/--	–	----	--	--/--/--	–	----	--	--/--/--

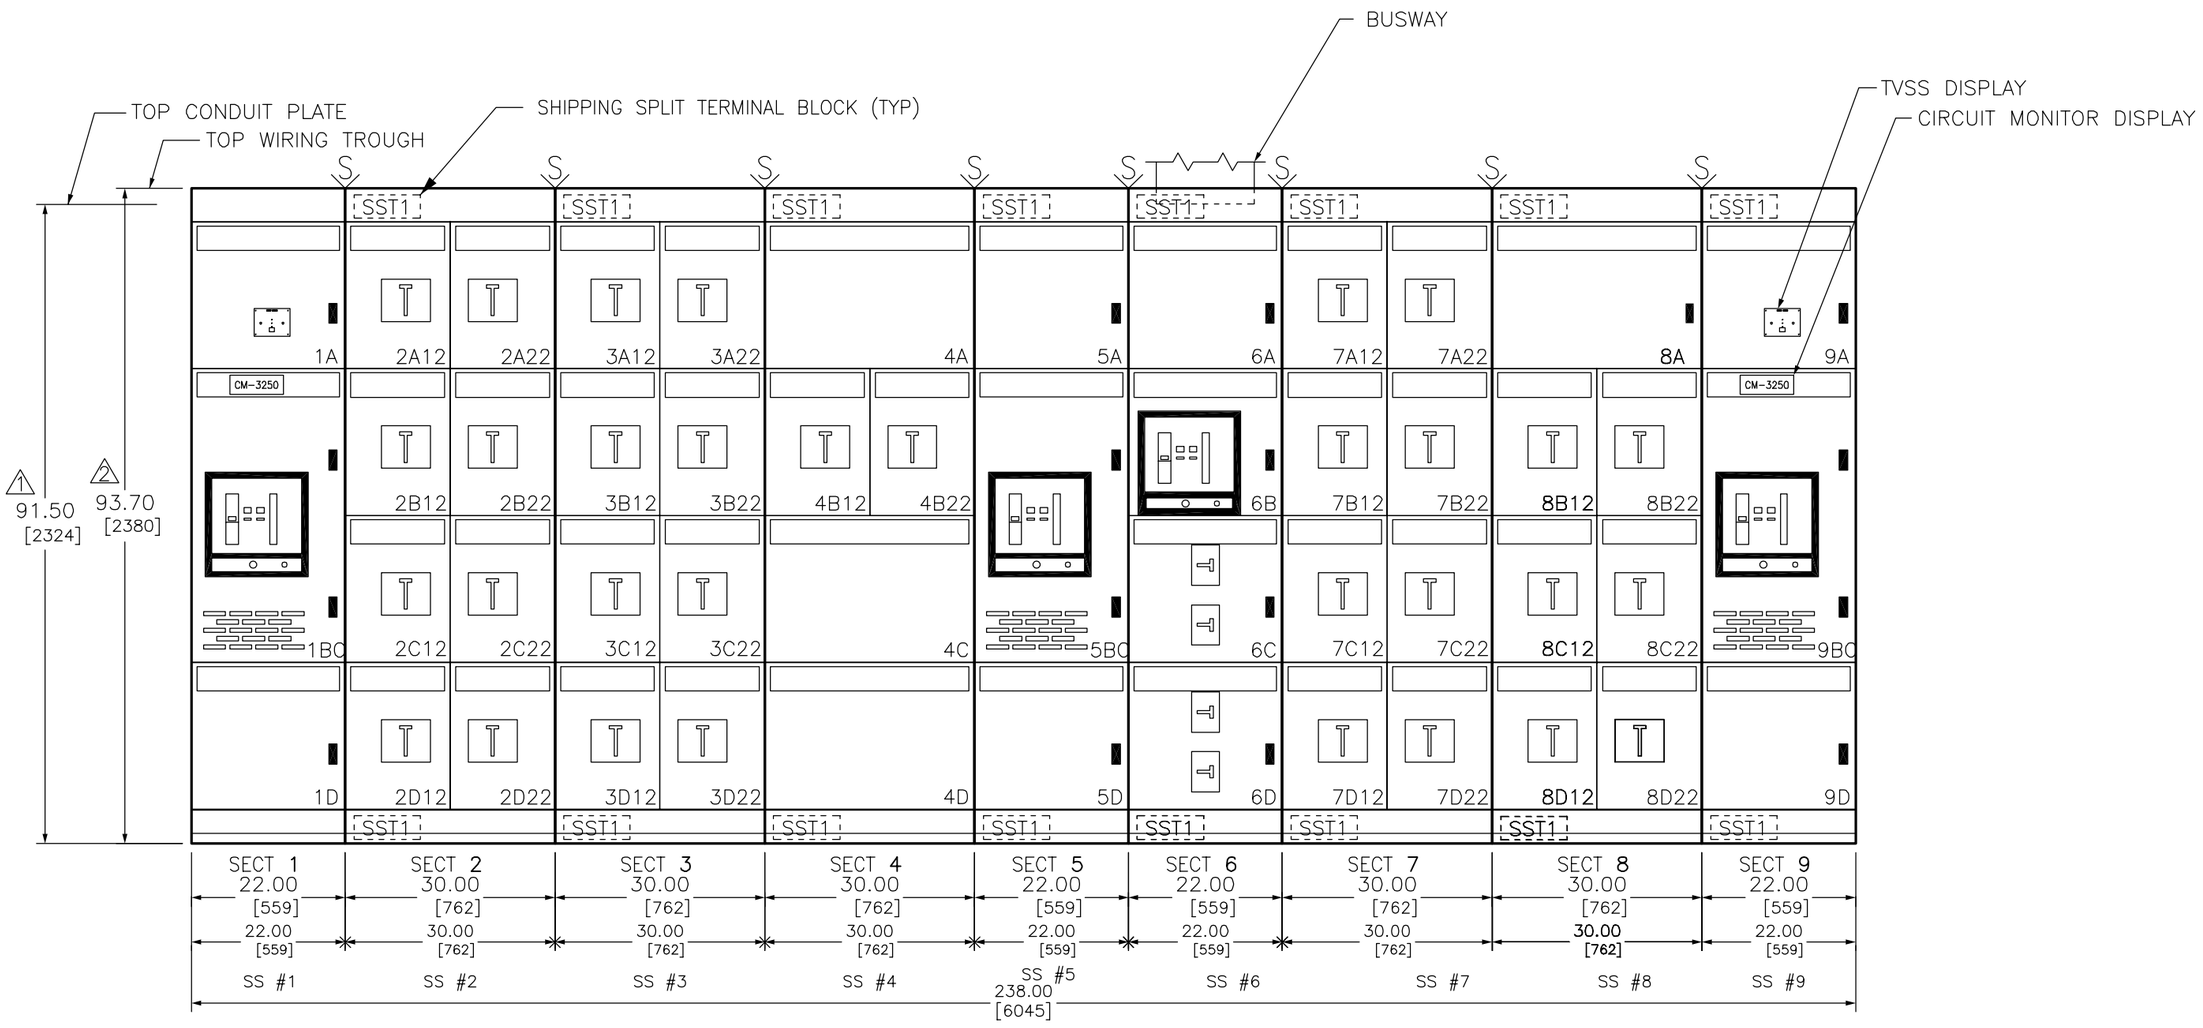

FRONT ELEVATION

S = SHIPPING SPLIT

DUAL DIMENSIONS: INCHES
MILLIMETERS

SST1 = SHIPPING SPLIT T.B. LOCATION

NOTES

1. 91.50 IS ELEVATION AT THE TOP OF THE GEAR.
2. 93.70 IS ELEVATION AT THE TOP OF THE WIREWAY.

DUAL DIMENSIONS: INCHES
MILLIMETERS

JOB NAME:	V.A. MEDICAL CENTER	EQUIPMENT DESIGNATION:	208V SUBSTATION
JOB LOCATION:	ST. LOUIS, MO.	EQUIPMENT TYPE:	QED6 SWITCHBOARD
DRAWN BY:	LES	DRAWING TYPE:	ELEVATION
ENGR:	LARRY E. SCHARFENBERGER		SQUARE D Schneider Electric
DATE:	DECEMBER 07, 2004		
DRAWING STATUS:	RECORD	DWG# F19250025-002-01	PG 1 OF 3 REV –